

LOCKPORT COMPANY CANAL BRIDGE

HAER No. LA-32

(Bridge Recall No. 000930)

Carries Louisiana Highway 1 (LA 1) over Lockport Company Canal

Lockport

Lafourche Parish

Louisiana

PHOTOGRAPHS

WRITTEN HISTORICAL AND DESCRIPTIVE DATA

REDUCED COPIES OF MEASURED & INTERPRETIVE DRAWINGS

FIELD RECORDS

HISTORIC AMERICAN ENGINEERING RECORD

National Park Service

U.S. Department of the Interior

1849 C Street, NW

Washington, DC 20240

HISTORIC AMERICAN ENGINEERING RECORD
LOCKPORT COMPANY CANAL BRIDGE
(Bridge Recall No. 000930)

HAER No. LA-32

Location: Carries Louisiana Highway 1 (LA 1) over Lockport Company Canal in Lockport, Lafourche Parish, Louisiana. At this location LA 1 is locally known as Crescent Avenue.

The Lockport Company Canal Bridge (Bridge Recall No. 000930) is located at latitude 29.644639 north, longitude -90.544389 west.¹ The coordinate represents the southeast corner of the bridge. It was obtained in 2016 by plotting its location in Google Earth. The location has no restriction on its release to the public.

Present Owner: State of Louisiana.

Present Use: Vehicular and pedestrian traffic. When in its open position, the bridge allows for marine traffic on the Lockport Company Canal.

Significance: The Lockport Company Canal Bridge is significant as an intact representative example of a tower-drive vertical lift bridge, a subtype within the vertical lift bridge subtype. The bridge's variation is demonstrated in the location of a separate motor and drive mechanism on each tower. The motor and drive mechanisms power the two sheaves on each tower. The Lockport Company Canal Bridge was determined eligible for listing in the National Register of Historic Places (National Register) in 2013 under *Criterion C: Design/Engineering* at the state level of significance.²

Historian: Timothy S. Smith, Cultural Resource Specialist; Mead & Hunt, Inc. (Mead & Hunt); 2017.

Project Information: This documentation was prepared to fulfill Stipulation IX.5 of the *Programmatic Agreement Among the Federal Highway Administration, the Louisiana Department of Transportation and Development, the Advisory Council on Historic Preservation, and the Louisiana State Historic Preservation Officer Regarding Management of Historic Bridges in Louisiana*, dated August 18, 2015 and executed September 21, 2015. The Louisiana Department of Transportation and Development (LADOTD) retained Mead & Hunt to prepare this document. It was prepared by cultural resource specialist Timothy S. Smith of Mead & Hunt. Dietrich Floeter completed the photography.

¹ The bridge is also known as Structure No. 02290640601401.

² Mead & Hunt, Inc., *National Register Eligibility Determination Report: Pre-1971 Louisiana Highway Bridges* (prepared for the Louisiana Department of Transportation and Development, September 2013).

Part I. Historical Information

A. Physical History:

1. **Date(s) of construction:** 1959.

2. **Engineer:** Bridge Design Section, State of Louisiana Department of Highways.

3. **Builder/Contractor/Supplier:** Available plans do not name a specific builder, contractor, or supplier for the construction of the bridge.

4. **Original plans and construction:** Plan sheets for the construction of the Lockport Company Canal Bridge are available in the General Files room at the LADOTD's Baton Rouge headquarters. State Project No. 64-06-16 consisted of constructing a 2.3-mile concrete-paved bypass roadway around the west side of Lockport, removing an existing bridge across the Company Canal, and building a new bridge over the Old Intracoastal at 5th Street (now Crescent Avenue). Plans for the new vertical lift span are dated May 3, 1957 (approved on November 7, 1957) and use the LDH's standard plan SL50-150-28 for a 150'-0" long vertical lift span and 28'-0" wide roadway. The SL50-150-28 standard plan included the general arrangement of the operating machinery.³ Plans for the vertical lift span also include spans 6 and 8, which are located beneath the lift towers. Plans for the eight approach spans (1, 2, 3, 4, 5, 9, 10, and 11) are dated February 12, 1957, and based on the latest LDH standard specifications and American Association of State Highway Officials 1953 standard specifications for highway bridges, as amended to December 31, 1955. The names of those that designed, traced, and approved the plans are illegible.

5. **Alterations and additions:** In 2011 the LADOTD replaced the electrical conductors and conduit throughout the bridge structure. This work included the removal and replacement of all navigation lights on the bridge and fender system.⁴ This work represents in-kind replacement of the bridge's original features. Unspecified repairs were made to the upper deck, tower structures, and the electrical and mechanical components in 2006 as a result of Hurricane Rita.⁵ Subsequent work on the bridge included reconfiguration of electrical service at the bridge for a trailer-mounted generator in 2007, replacement of wire ropes in 2008, replacement of the grid floor in 2009, and repairs to limit switches, gate operators, and span locks in 2010.⁶

³ State of Louisiana Department of Highways, *Plans of Proposed State Highway, S-253(3) State Project No. 64-06-16*, plans for Lockport Relocation, Lafourche Parish, LA 1, November 7, 1957.

⁴ "Drawbridge Operation Regulation; Company Canal, Lockport, LA, *The Federal Register*, April 15, 2011.

⁵ Louisiana Department of Transportation and Development, "Projects 064-06-0041 and 064-06-0042," *trns.Port Systems Database*, available at the Louisiana Department of Transportation and Development, Baton Rouge, La.; Louisiana Department of Transportation and Development, "Project 064-06-0042," *trns.Port Systems Database*.

⁶ Louisiana Department of Transportation and Development, "Project 064-06-0043," *trns.Port Systems Database*; Louisiana Department of Transportation and Development, "Project 064-06-0044," *trns.Port Systems Database*; Louisiana Department of Transportation and Development, "Project 064-06-0046," *trns.Port Systems Database*; Louisiana Department of Transportation and Development, "Project 064-06-0047," *trns.Port Systems Database*.

B. Historical Context:

Development of highways and bridges in Louisiana

Since the Louisiana Highway Commission's (LHC's) inception in 1921 (replacing the State Highway Department), the agency's Bridge Department was responsible for the design and construction of many of Louisiana's bridges, including some of the largest and most significant examples. The department originally operated within the agency's construction division. Projects with only bridges were handled by the Bridge Department and those with both roads and bridges were completed by the office engineer with assistance from the bridge engineer.⁷ The Bridge Department designed and often served a supervisory role in projects, eliminating the need for a general contractor during construction of State-owned bridges. As the Bureau of Public Roads (BPR) created design standards at the national level, the LHC also created Louisiana standard plans developed to assist in bridge design.⁸ The LHC was reorganized as the Louisiana Department of Highways (LDH) in the 1940s, which designed the Lockport Company Canal Bridge. LDH biennial reports from the 1950s and 1960s indicate that in the period following World War II economic growth and government funding combined to not only increase investment on a grand scale, but also improve and increase road and bridge construction statewide.⁹

Bridge engineering practices of the Bridge Department/Bridge Design Section in the 1950s and 1960s became an increasingly scientific discipline that stressed a calculated approach to the rapidly increasing demand for plentiful, affordable, and efficient bridge designs and construction methods. Standardization and cost analysis accompanied the use of early computer programs and automated work to aid engineers in new approaches and innovations.¹⁰

Making the work of the agency more complicated was the state's abundant waterways. Influenced by the need to create and facilitate a reliable transportation system, the agency looked to movable bridges to span these waterways while also allowing for marine navigation below. As a result, Louisiana has one of the largest collections of movable bridges in the nation. Few were constructed in the state prior to 1900; however, they gained popularity and a series of standard plans for movable bridges were developed by the LHC and LDH between 1924 and 1963. Standard plans were periodically revised with small adjustments to meet site-specific needs. Standard plans for tower-drive-with-independent-towers bridges such as the Lockport Company Canal Bridge were available by 1953. As of 2015 Louisiana had 31 vertical lift bridges constructed between 1914 and 1970 and only four known examples with the tower-drive-with-independent-tower structure design. In addition to the Lockport Company Canal Bridge,

⁷ Louisiana Highway Commission, *Biennial Report of the Louisiana Highway Commission of the State of Louisiana, 1922-1924* (Baton Rouge, La.: Louisiana Highway Commission, 1924), 93.

⁸ Louisiana Highway Commission, *Biennial Report of the Louisiana Highway Commission of the State of Louisiana, 1922-1924*, 93 and 95; Mead & Hunt, Inc., *Historic Context for Louisiana Bridges* (prepared for the Louisiana Department of Transportation, 2013), 17.

⁹ Mead & Hunt, Inc., *Historic Context for Louisiana Bridges*, 27.

¹⁰ Mead & Hunt, Inc., *Historic Context for Louisiana Bridges*, 97.

examples of this type are the Intracoastal Waterway Bridge at Larose in Lafourche Parish (Bridge Recall No. 000920), the Judge Seeber Bridge (Bridge Recall No. 020375) in Orleans Parish, and the Intracoastal Waterway/W-J. Perez Bridge (Bridge Recall No. 002500) in Plaquemines, all in the southeast corner of the state.¹¹

Construction of the Lockport Company Canal Bridge

A series of canals and locks constructed between approximately 1850 and 1880 in the vicinity of present-day Lockport facilitated shipping and steady economic growth. One of these was the Old Intracoastal Waterway (now known as Company Canal), which bisected Bayou Lafourche. Lockport was eventually established at the juncture of Bayou Lafourche and the Old Intracoastal Waterway and incorporated in 1899. Only two bridges are known to have been constructed at Lockport prior to the existing Lockport Company Canal Bridge: an iron bridge in 1900 across Bayou Lafourche, between Lockport and Rita, and a steel pontoon bridge across the Company Canal built ca. 1948.¹² Both of these bridges are nonextant.

By 1956 plans were underway to construct the existing Lockport Company Canal Bridge.¹³ Plans were drawn up in 1957 by the LDH for State Project No. 64-06-16, which consisted of constructing a 2.3-mile concrete-paved bypass around the west side of Lockport to carry LA 1; removing the ca. 1948 steel pontoon bridge (located at 8th Street across the Company Canal); and building a new vertical lift bridge at 5th Street (now Crescent Avenue) across the Company Canal to carry the relocated LA 1. Plans for the 11-span vertical lift bridge are dated May 3, 1957, and plans for eight of the approach spans are dated February 12, 1957. Plans for the entire project were approved on November 7, 1957. Fiscal records for the LDH indicate a total expenditure of \$1,087,566.64 for the project.¹⁴

Engineering background

The Lockport Company Canal Bridge is an example of a tower-drive-with-independent-towers vertical lift bridge. The oldest movable bridges in the U.S. date to the mid-to-late nineteenth century and most early examples were of the swing type. Small-scale vertical lift bridges consisting of girder spans of a maximum span length of 50 feet were first constructed across canals throughout Europe and the U.S. in the early nineteenth century. These early vertical lift bridges had very short lifts and included such

¹¹ Mead & Hunt, Inc., *National Register Eligibility Determination Report: Pre-1971 Louisiana Highway Bridges*, 36, 44.

¹² Town of Lockport, Louisiana, *History, June 6, 2016*, http://townoflockport.com/?page_id=20 (accessed July 13, 2016); LaFourche Parish Game and Fish Commission, *Historic Habitat Changes*, June 16, 2016, <http://www.lafourchegfc.org/habitathistory1.html> (accessed July 12, 2016); Louisiana Department of Highways, "Highway Contracts Reach \$4,653,274 Month of December: Year's Total is Over 24 Million," *Louisiana Highways II*, no. 1 (January 1948): 6.

¹³ "Legislative Digest," *The Times-Picayune*, July 20, 1956, 14.

¹⁴ State of Louisiana Department of Highways, *Financial & Statistical Report, Fiscal Year Ending June 30, 1958* (Baton Rouge, La.: State of Louisiana Department of Highways, 1958); State of Louisiana Department of Highways, *Financial & Statistical Report, Fiscal Year Ending June 30, 1959* (Baton Rouge, La.: State of Louisiana Department of Highways, 1959); State of Louisiana Department of Highways, *Plans of Proposed State Highway, S-253(3) State Project No. 64-06-16*.

features as cast-iron towers and hydraulically operated movable spans. In the U.S., movable bridges were constructed over the Erie Canal in the early nineteenth century. Toward the end of the nineteenth century a series of other movable bridge types were rapidly developed and brought into common use, including bascule variations and vertical lift examples.¹⁵

The design of modern vertical lift bridges can be attributed to John Alexander Low Waddell's 1894 South Halsted Street Bridge in Chicago. In vertical lift bridges, the main span consists of steel girders or a truss that is raised and lowered via cables. The cables are carried over large, grooved pulleys or wheels (termed sheaves) at the tops of the bridge towers and attached to the movable span at one end and large counterweights at the other end. The cables and counterweights balance the weight of the lift span so very little effort or power is required to move it up or down. The up and down movement is accomplished through a second and separate set of cables called up-haul and down-haul ropes.

The design of vertical lift bridges can vary slightly based on the location of the motor(s) and drive mechanisms that move the span up and down by controlling the up-haul and down-haul ropes. The three basic variations include span drive, tower drive with independent towers, and tower drive with connected towers.¹⁶ Tower-drive vertical lift bridges have a series of operating ropes (typically two up-haul and two down-haul ropes at each corner of the span) attached to geared operating drums. To lift the span, the drum winds the up-haul ropes and simultaneously unwinds the down-haul ropes. The sheaves at the top of each tower carry the counterweight ropes and are free-spinning with no direct control over the movement of the span. Tower drive vertical lift bridges with independent towers are powered by a separate set of drive machinery located at the top of each lift tower. The movable span is raised and lowered by rotating the motorized sheaves by means of interconnected shafts and gears. A single motor operates two sheaves that enable the span to move.¹⁷

Part II. Structural/Design Information

A. General Statement:

1. Character: The Lockport Company Canal Bridge is a tower-drive-with-independent-towers vertical lift bridge with a steel plate girder movable span. It is a representative example of this uncommon vertical lift bridge subtype.

2. Condition of fabric: Good.

B. Description: The Lockport Company Canal Bridge is located in the Town of Lockport, Louisiana, and carries LA 1 (locally known as Crescent Avenue) over the Lockport Company Canal. The Town of

¹⁵ Terry L. Coglin, *Movable Bridge Engineering* (Hoboken, N.J.: John Wiley & Sons, Inc., 2003), 55.

¹⁶ Coglin, *Movable Bridge Engineering*, 6, 55; Mead & Hunt, Inc., *Crossing the Bayou: Louisiana's Historic Bridges* (prepared for the Louisiana Department of Transportation and Development, 2015), 14.

¹⁷ Mead & Hunt, Inc., *Crossing the Bayou: Louisiana's Historic Bridges*, 14-17.

Lockport is located in Lafourche Parish, east of Houma, Louisiana. LA 1 extends north from Grand Isle, located along the Gulf of Mexico, for approximately 146 miles to Interstate Highway 190 in Baton Rouge.

The bridge is aligned on a nominal southeast-northwest axis. It has an overall structure length of 370'-0" and an out-to-out width of 33'-0". The 11-span structure has a 150'-0" steel vertical lift span (span 7) with a 125'-0" horizontal clearance over the waterway, plus 5'-0" on each side from centerline of the column to the centerline of the live load bearing for each lift span; eight concrete slab approach spans each with an individual length of 20'-0" (spans 1-5 and 9-11); two spans beneath the towers (spans 6 and 8), each with a 25'-0" length; an operator's house mounted within the southernmost tower above the roadway; and machinery houses located at the tops of the two towers that shelter the sheaves and lift machinery.

Main vertical lift span

The vertical lift span of the Lockport Company Canal Bridge is a movable steel plate girder span with welded connections and stiffeners. The vertical-lift span generally has a roadway width of 28'-0" accommodating a two-lane roadway. Across both sides of its entire length the vertical lift span has a raised metal 5'-0" sidewalk with a pipe handrail mounted on a single reinforced-concrete rail, which is integrated with concrete posts. Each railing is integral with railings on approach spans that terminate at a stepped concrete endpost that features a design with rounded, protruding parallel panels and lettering with "1959" and "Company Canal." The majority of the deck consists of a steel grid; portions under the towers within spans 6 and 8 have a concrete deck with asphalt overlay. The substructure for the vertical lift span consists of concrete pile bents that support two massive concrete platforms under each of the lift towers.

Lift towers

The vertical lift span is situated between two cross-braced, independent, steel I-beam lift towers and has a maximum vertical lift of 50'-0". Each tower is approximately 90' tall and comprised of three, vertically oriented outer panels with an approximate dimension of 25' by 25'. The steel cross-bracing in each tower and panel has a combination of riveted and bolted connections. Metal staircases mounted on the exterior of the tower structure provide access to the machinery houses located at the top of each tower. Portals integrated with the lift tower structure are located at either end of the movable span above the roadway. Adjacent to the portals, at the edge of the outermost panels of the lift tower structure, are vertical drop-bar traffic barriers that extend the full width of the roadway. These traffic barriers are raised and lowered via an electrically controlled shaft that rotates two grooved wheels, which carry metal chains attached to the barrier at one end and a concrete counterweight at the other. These original traffic barriers are still extant but may no longer operate.

Machinery

This bridge has a tower-drive-with-independent-towers configuration, meaning the electrically powered drive machinery used to raise and lower the main span is located at the top of each independent lift tower. Many of the movable components that enable the movement of the span are also housed within each independent tower structure. Components of the drive machinery include an electric motor, speed reducer, coupling, shafts, and sheaves (grooved steel wheels at the corner of each tower, two within each machinery house). The electric motor provides the power for simultaneously rotating the sheaves and the

speed reducer adjusts the torque of the motor based on rotations per minute. Two shafts extend from the motor to the sheaves. The coupling is a device that connects the ends of the two independent shafts for the purposes of transmitting power to the sheaves. Based on review of plans and field inspection, the machinery at the top of each lift tower generally retains its original configuration and components.

Each of the sheaves carries a heavy steel cable that moves up and down within the lift tower structure. One end is attached to the movable span below and the other end is attached to a large counterweight that consists of a steel beam encased in concrete and balance chains that are suspended within each tower structure. The combined weight of the two counterweights is equal to the weight of the lift span, thus giving the movable span minimal weight for ease of movement; the drive machinery needs to provide only enough force to overcome friction and wind resistance to operate the cables in the corresponding direction.

Each machinery house has an irregular form with small extensions to account for the rounded protrusion of the sheaves at the top of each corner of the lift tower. The metal-frame structures are clad in corrugated sheet metal and have small, metal, louvered vents on each end. A band of five, metal-frame, awning windows opens from the interior elevation (facing the movable span) for air circulation.

Other mechanical features on the vertical lift span include span locks that secure the span in place when in closed position as well as guide rollers at the end of the span for the purposes of proper span alignment.

Operator's house

The operator's house is mounted above the roadway within the south lift tower structure and is accessed by a metal stairway on the west side of the tower. The operator's house is important as the location of the switchboard or operator's console that controls the electrical and mechanical components of the movable span. Aerial electrical cables strung between the two lift towers provide electricity from the operator's house to the motors and machinery at the top of each lift tower.

The concrete-walled, box-like building features pairs of horizontal grooves beneath the flat roofline that gives the building a restrained Streamline Moderne appearance. Paired sets of aluminum-frame windows with louvered horizontal glass panels are located on the northwest and southeast facades; the windows on the northwest side of the operator's house wrap around the building corners. A round stylized emblem of a pelican is set into the wall between the windows on the northwest and southeast elevations. The house interior consists of a large rectangular room with a control desk and switchboard under the northwest-facing windows and small bathroom at the eastern end of the building.

Approach spans

The bridge has 10 total approach spans that are reinforced-concrete slab spans. Spans 1-5 are located on the southeast approach and are each 20'-0" long, spans 9-11 are on the northwest approach and are also each 20'-0" long, and spans 6 and 8 are located beneath the lift towers and are each 25'-0" long. The approach spans generally have a roadway width of 28'-0" accommodating two traffic lanes. The approach spans have a concrete deck and two 5'-0" concrete sidewalks with raised curb. Pipe handrails

mounted on single reinforced-concrete rails, which are integrated with concrete posts, extend along both sides of the approaches. The substructure consists of concrete pile bents with concrete bent caps. The end bents are concrete with small wingwalls that serve as bases for the ornamental endposts that feature raised parallel rounded panels. A single roadway approach slab is located at each end of the bridge structure and measures approximately 20' long. Metal drop-arm traffic barriers are located adjacent to the outermost approach span on each end of the bridge structure; a metal two-light signal is paired with each barrier.

Other features around the bridge include two concrete flood control structures under the south approach spans and timber fenders are located under both sides of the bridge to protect those portions of the bridge that are exposed to potential damage by marine traffic should there be a collision.

C. Site Information: The Lockport Company Canal Bridge spans the Lockport Company Canal in Lockport, Louisiana. The canal runs in a northeast-southwest direction, connecting Bayou Lafourche with Lake Fields. The landscape immediately surrounding the bridge and canal consists of mostly narrow banks of landscaped grass as the area is primarily commercial development. The bridge carries two lanes of vehicular traffic, one in each direction.

Part III. Sources of Information

A. Primary Sources:

Bridge Inspection Report, February 20, 2013. Available in Bridge Maintenance and Inspection Division, Louisiana Department of Transportation and Development, Baton Rouge, Louisiana.

"Drawbridge Operation Regulation; Company Canal, Lockport, LA." *The Federal Register*, April 15, 2011.

"Legislative Digest." *The Times-Picayune*, July 20, 1956, 14.

Louisiana Department of Highways. "Highway Contracts Reach \$4,653,274 Month of December: Year's Total is Over 24 Million." *Louisiana Highways II*, no. 1 (January 1948): 6.

Louisiana Department of Transportation and Development. "Project 064-06-0041." *trns.Port Systems Database*. Available at the Louisiana Department of Transportation and Development, Baton Rouge, La.

Louisiana Department of Transportation and Development. "Project 064-06-0042." *trns.Port Systems Database*. Available at the Louisiana Department of Transportation and Development, Baton Rouge, La.

Louisiana Department of Transportation and Development. "Project 064-06-0043." *trns.Port Systems Database*. Available at the Louisiana Department of Transportation and Development, Baton Rouge, La.

Louisiana Department of Transportation and Development. "Project 064-06-0044." *trns.Port Systems Database*. Available at the Louisiana Department of Transportation and Development, Baton Rouge, La.

Louisiana Department of Transportation and Development. "Project 064-06-0046." *trns.Port Systems Database*. Available at the Louisiana Department of Transportation and Development, Baton Rouge, La.

Louisiana Department of Transportation and Development. "Project 064-06-0047." *trns.Port Systems Database*. Available at the Louisiana Department of Transportation and Development, Baton Rouge, La.

State of Louisiana Department of Highways. *Plans of Proposed State Highway, S-253(3) State Project No. 64-06-16*. Plans for Lockport Relocation, Lafourche Parish, LA 1. November 7, 1957.

State of Louisiana Department of Highways. *Financial & Statistical Report, Fiscal Year Ending June 30, 1958*. Baton Rouge, La.: State of Louisiana Department of Highways, 1958.

State of Louisiana Department of Highways. *Financial & Statistical Report, Fiscal Year Ending June 30, 1959*. Baton Rouge, La.: State of Louisiana Department of Highways, 1959.

B. Secondary Sources:

Coglin, Terry L. *Movable Bridge Engineering*. Hoboken, N.J.: John Wiley & Sons, Inc., 2003.

LaFourche Parish Game and Fish Commission. *Historic Habitat Changes*, June 16, 2016.

Mead & Hunt, Inc. *Crossing the Bayou: Louisiana's Historic Bridges*. Prepared for the Louisiana Department of Transportation and Development, 2015.

Mead & Hunt, Inc. *Historic Context for Louisiana Bridges*. Prepared for the Louisiana Department of Transportation and Development, December 2013.

Mead & Hunt, Inc. *National Register Eligibility Determination Report: Pre-1971 Louisiana Highway Bridges*. Prepared for the Louisiana Department of Transportation and Development, September 2013.

Town of Lockport, Louisiana. *History, June 6, 2016*. http://townoflockport.com/?page_id=20 (accessed July 13, 2016).

HISTORIC AMERICAN ENGINEERING RECORD

INDEX TO PHOTOGRAPHS

LOCKPORT COMPANY CANAL BRIDGE

HAER No. LA-32

(Bridge Recall No. 000930)

Carries Louisiana Highway 1 (LA 1) over Lockport Company Canal

Lockport

Lafourche Parish

Louisiana

INDEX TO BLACK AND WHITE PHOTOGRAPHS

Dietrich G. Floeter, photographer, February and March 2016

Scale Device 8 Feet Long

- | | |
|----------|--|
| LA-32-1 | Northeast elevation, from east |
| LA-32-2 | Southwest elevation, from southwest |
| LA-32-3 | Northwest approach, from northwest |
| LA-32-4 | Northwest approach showing traffic light and gate, from west |
| LA-32-5 | Setting view, from east |
| LA-32-6 | Wider setting view, from east |
| LA-32-7 | General view of bridge, from east |
| LA-32-8 | Northwest approach, from northwest |
| LA-32-9 | Setting view of bridge, from southeast |
| LA-32-10 | Setting view to east from northwest tower, from southwest |
| LA-32-11 | Detail view of underside of southeast fixed span, from southwest |
| LA-32-12 | Detail of rail on fixed span, from southwest |
| LA-32-13 | Detail view of operator's house interior, from south |
| LA-32-14 | Detail view of southeast abutment, from west |


LOCKPORT COMPANY CANAL BRIDGE
HAER No. LA-32
INDEX TO PHOTOGRAPHS

- LA-32-15 Detail view of northwest abutment, from east
- LA-32-16 Detail view of southeast approach showing gate and signal, from southeast
- LA-32-17 Detail view of northwest tower, from south
- LA-32-18 Detail view of southeast tower base, from west
- LA-32-19 Detail view of bridge deck, from east
- LA-32-20 Detail view of lifted bridge deck showing counterweight chain and underside, from northwest
- LA-32-21 Detail view of lifting motor and drive train inside machinery house, from southwest
- LA-32-22 Detail view of sheave and primary lifting gear in southeast tower, from southwest


LOCKPORT COMPANY CANAL BRIDGE

HAER No. LA-32

INDEX TO PHOTOGRAPHS

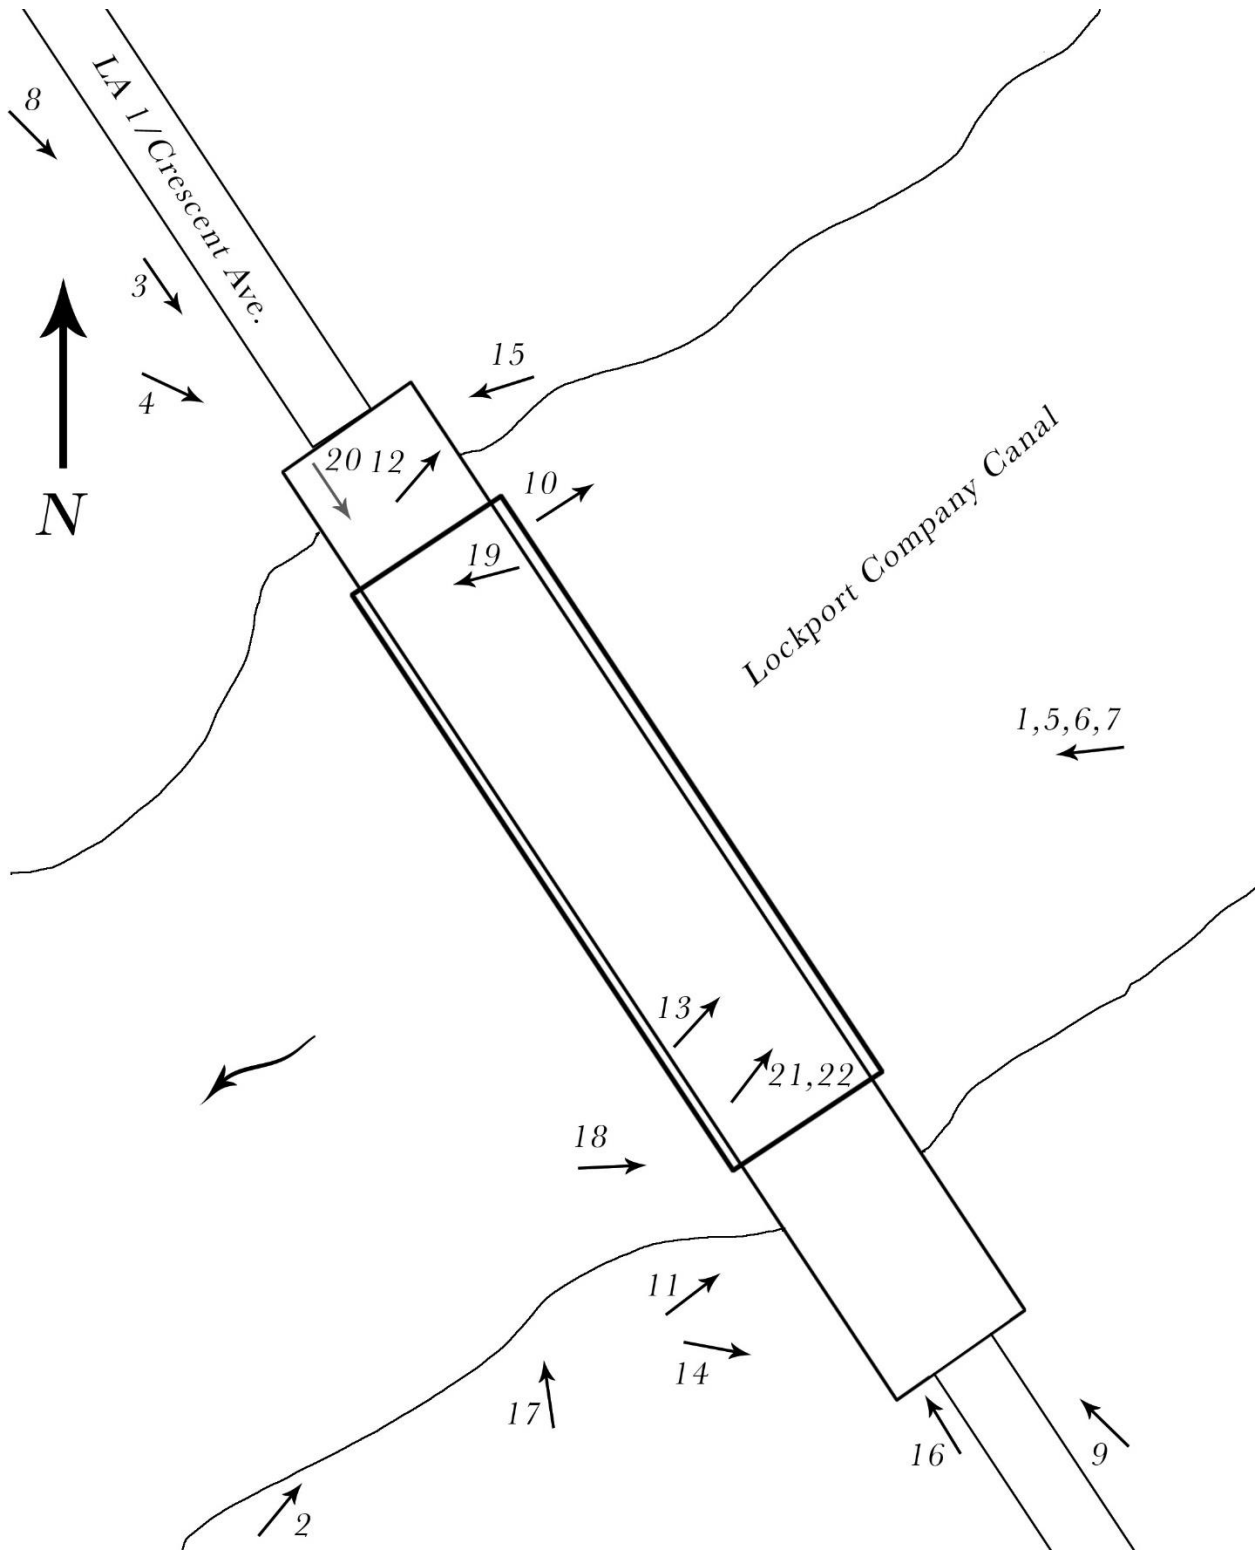

HISTORIC AMERICAN ENGINEERING RECORD
See Index to Photographs for Caption
HAER NO. LA-32-1

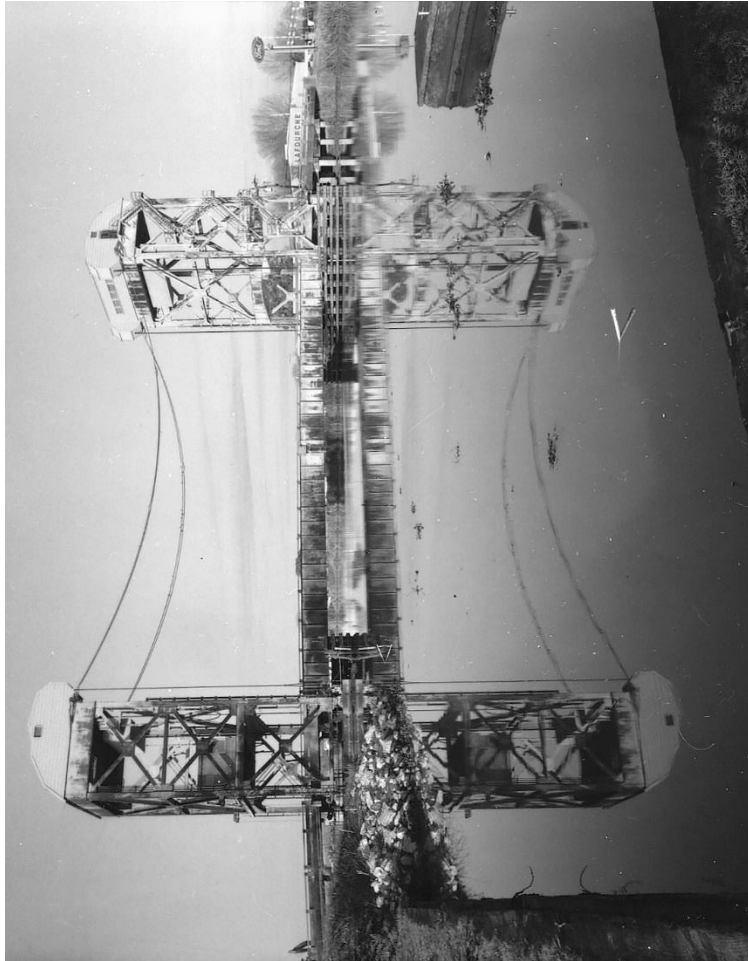

HISTORIC AMERICAN ENGINEERING RECORD
See Index to Photographs for Caption
HAER NO. LA-32-2




HISTORIC AMERICAN ENGINEERING RECORD
See Index to Photographs for Caption
HAER NO. LA-32-3



HISTORIC AMERICAN ENGINEERING RECORD
See Index to Photographs for Caption
HAER NO. LA-32-4



HISTORIC AMERICAN ENGINEERING RECORD
See Index to Photographs for Caption
HAER NO. LA-32-5

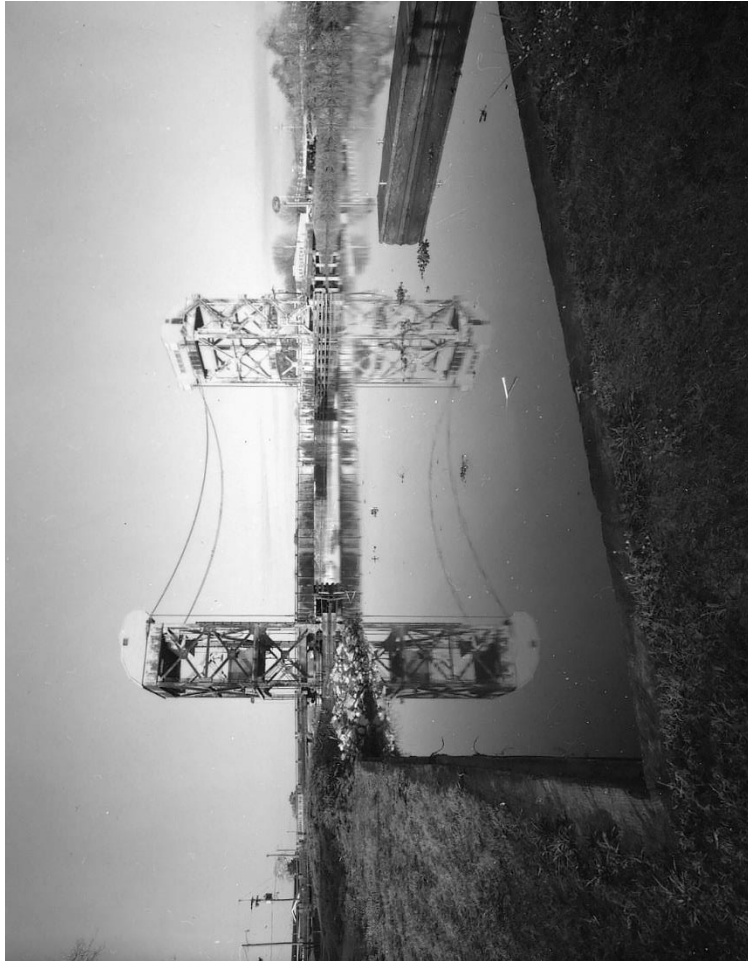

HISTORIC AMERICAN ENGINEERING RECORD
See Index to Photographs for Caption
HAER NO. LA-32-6



HISTORIC AMERICAN ENGINEERING RECORD
See Index to Photographs for Caption
HAER NO. LA-32-7



HISTORIC AMERICAN ENGINEERING RECORD
See Index to Photographs for Caption
HAER NO. LA-32-8



HISTORIC AMERICAN ENGINEERING RECORD
See Index to Photographs for Caption
HAER NO. LA-32-9



HISTORIC AMERICAN ENGINEERING RECORD
See Index to Photographs for Caption
HAER NO. LA-32-10



HISTORIC AMERICAN ENGINEERING RECORD
See Index to Photographs for Caption
See Index to Photographs for Caption
HAER NO. LA-32-20




HISTORIC AMERICAN ENGINEERING RECORD
See Index to Photographs for Caption
HAER NO. LA-32-21



HISTORIC AMERICAN ENGINEERING RECORD
See Index to Photographs for Caption
HAER NO. LA-32-22



LOCKPORT COMPANY CANAL BRIDGE

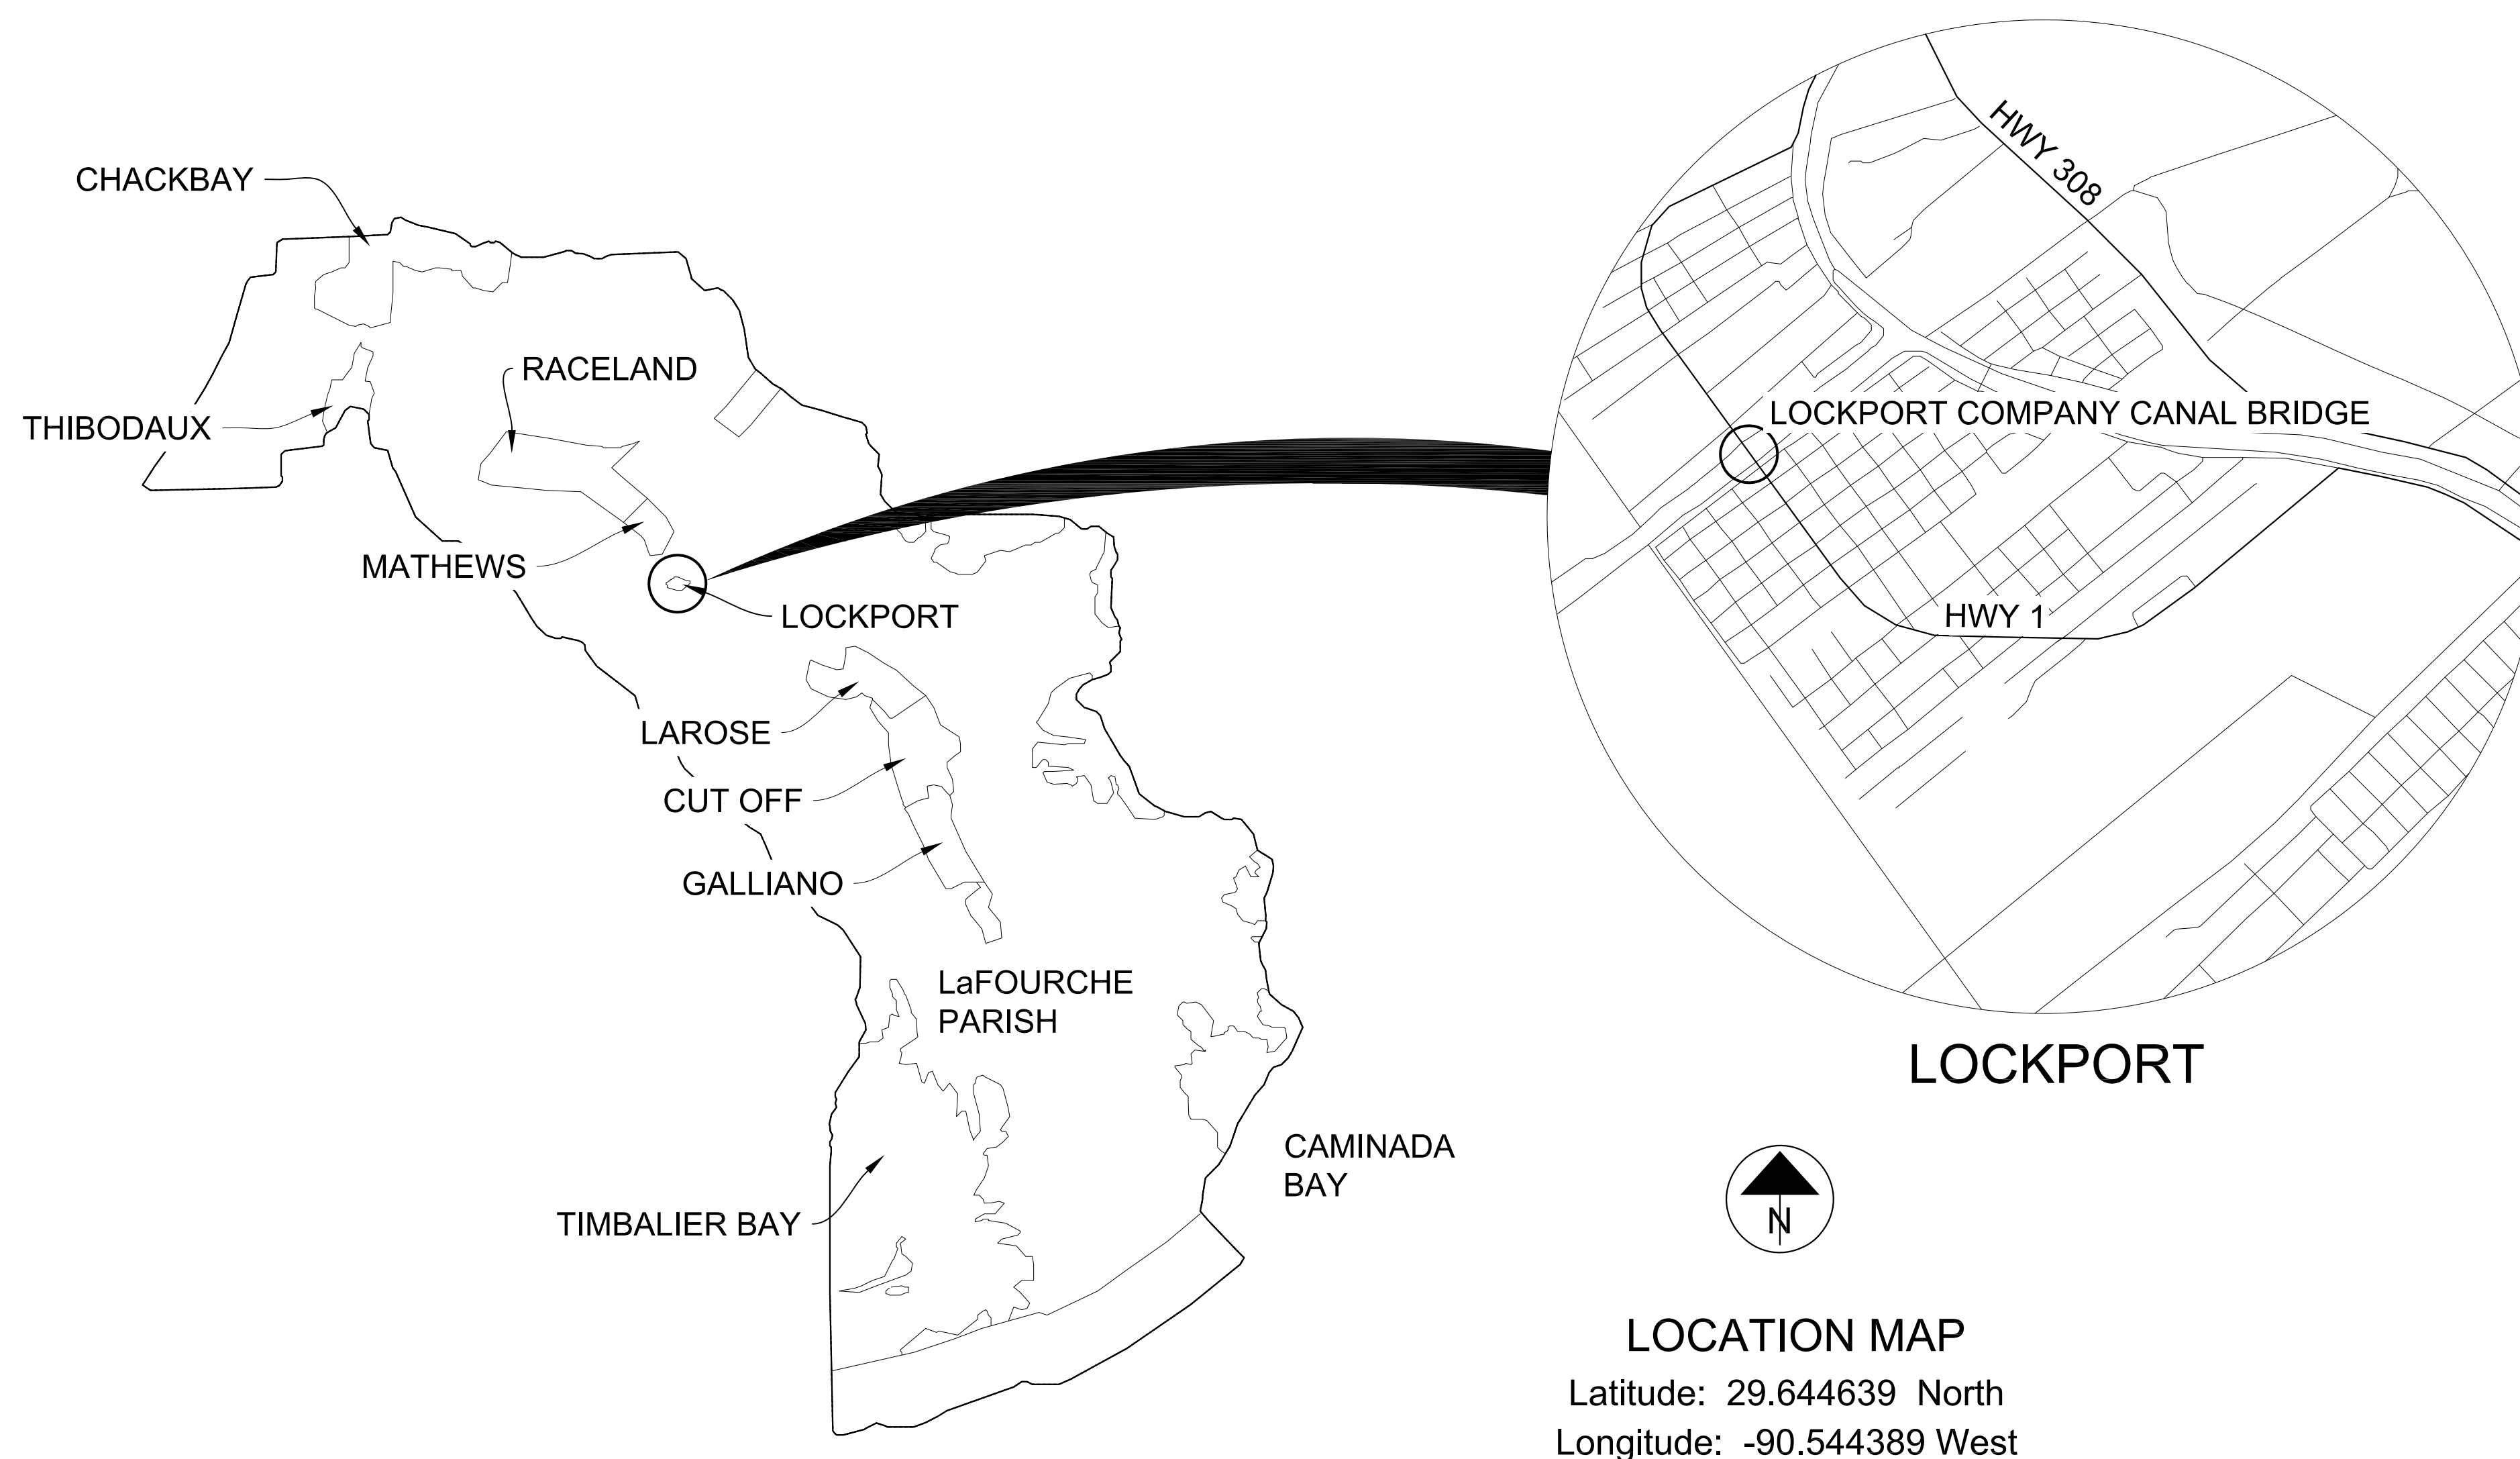

The Lockport Company Canal Bridge (Bridge Recall No. 000930), designed by the Louisiana Department of Highways and constructed in 1959, is significant as an intact representative example of a tower-drive vertical lift bridge, a subtype within the vertical lift bridge subtype. The bridge's variation is demonstrated in the location of a separate motor and drive mechanism on each tower. The motor and drive mechanisms power the two sheaves on each tower. The Lockport Company Canal Bridge was determined eligible for listing in the National Register of Historic Places in 2013 under *Criterion C: Design/Engineering* at the state level of significance.


This documentation was prepared to fulfill Stipulation IX.5 of the Programmatic Agreement Among the Federal Highway Administration, the Louisiana Department of Transportation and Development, the Advisory Council on Historic Preservation, and the Louisiana State Historic Preservation Officer Regarding Management of Historic Bridges in Louisiana, dated August 18, 2015 and executed September 21, 2015. The Louisiana Department of Transportation and Development (LADOTD) retained Mead & Hunt to prepare this document. It was prepared by Timothy S. Smith, Cultural Resource Specialist, and Justin Duffie, Design Technician, of Mead & Hunt. Dietrich Floeter completed the photography.

The measured drawings were prepared based on a site visit to the bridge to confirm as-built plans and perform selective hand measuring in the field to verify measurements.

DELINEATED BY: J. DUFFIE, MEAD & HUNT, INC., 2017

LOUISIANA HISTORIC BRIDGE INVENTORY NATIONAL PARK SERVICE UNITED STATES DEPARTMENT OF THE INTERIOR
LOCKPORT COMPANY CANAL BRIDGE CARRIES LOUISIANA HIGHWAY 1 (LA 1) OVER LOCKPORT CANAL LaFOURCHE PARISH
LOUISIANA
HISTORIC AMERICAN ENGINEERING RECORD
LA-32
SHEET 1 OF 4
LIBRARY OF CONGRESS
INDEX NUMBER

IF REPRODUCED, PLEASE CREDIT THE HISTORIC AMERICAN ENGINEERING RECORD, NATIONAL PARK SERVICE, NAME OF DELINEATOR, DATE OF DRAWING

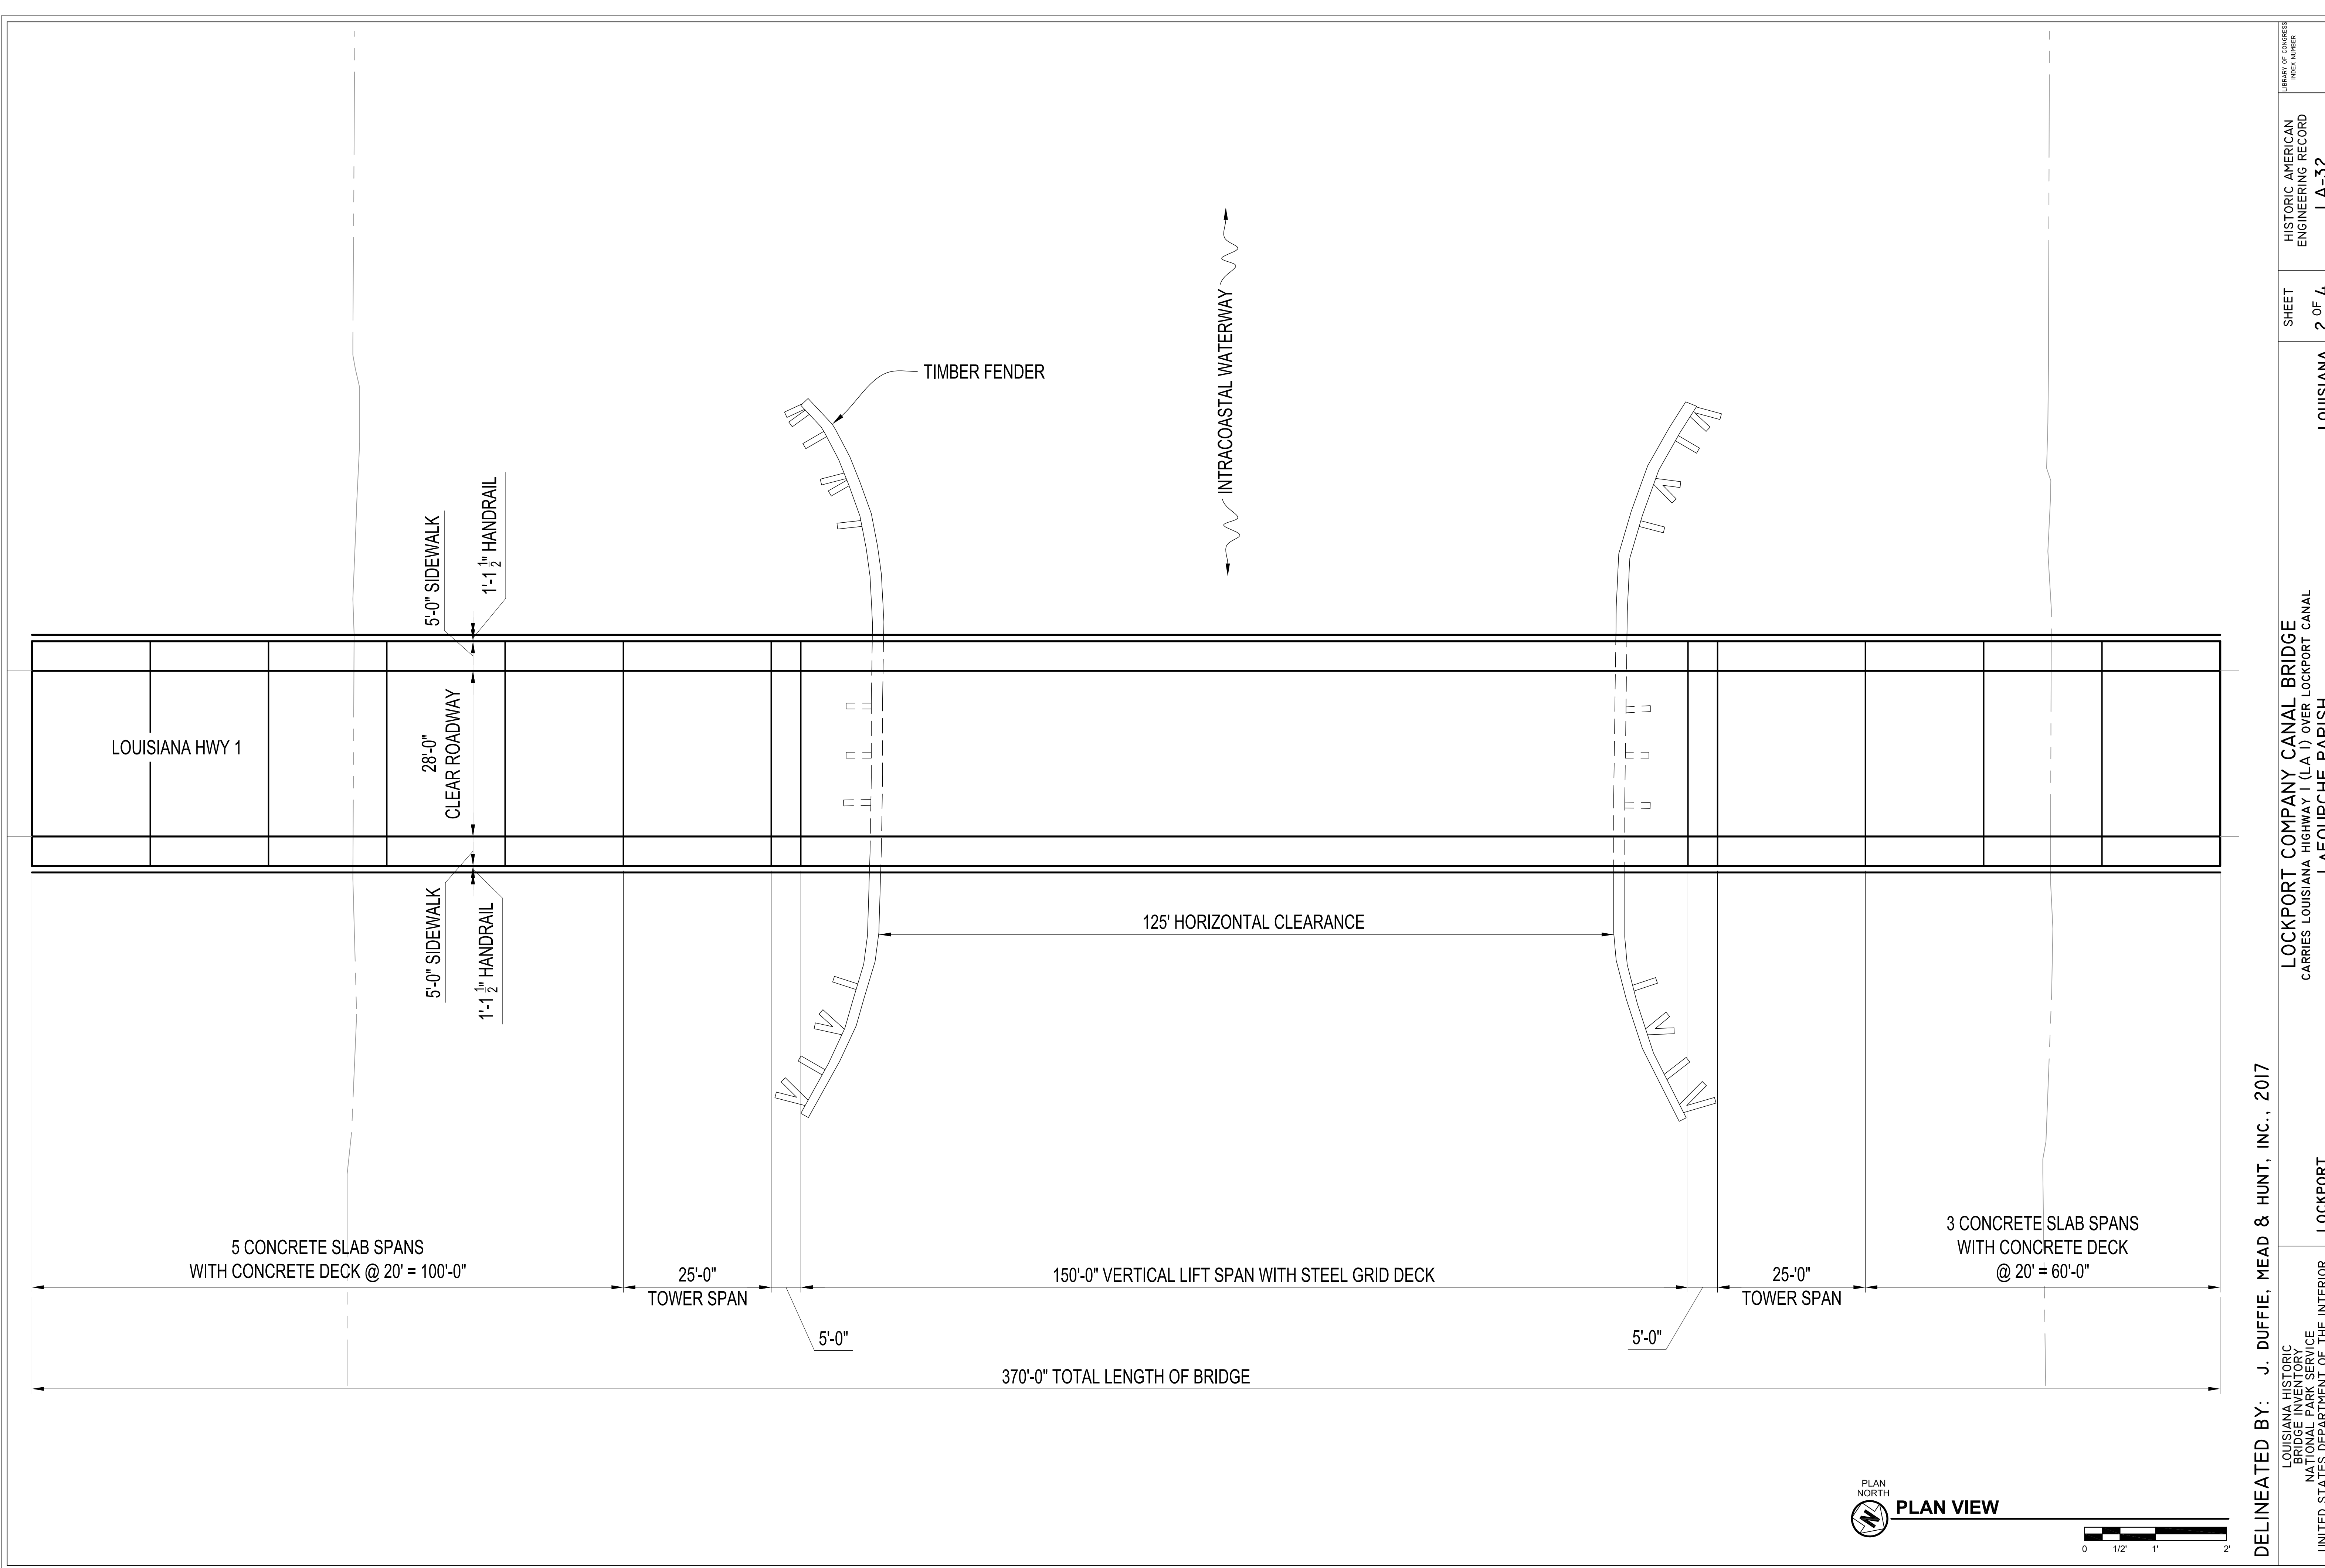

DELINEATED BY: J. DUFFIE, MEAD & HUNT, INC., 2017

LOUISIANA HISTORIC
BRIDGE INVENTORY
NATIONAL PARK SERVICE
UNITED STATES DEPARTMENT OF THE INTERIOR

LOCKPORT

LOCKPORT COMPANY CANAL BRIDGE
CARRIES LOUISIANA HIGHWAY 1 (LA 1) OVER LOCKPORT CANAL
LAFOURCHE PARISH


LOUISIANA

SHEET
2 OF 4

HISTORIC AMERICAN
ENGINEERING RECORD
LA-32

LIBRARY OF CONGRESS
INDEX NUMBER

IF REPRODUCED, PLEASE CREDIT THE HISTORIC AMERICAN ENGINEERING RECORD, NATIONAL PARK SERVICE, NAME OF DELINEATOR, DATE OF DRAWING

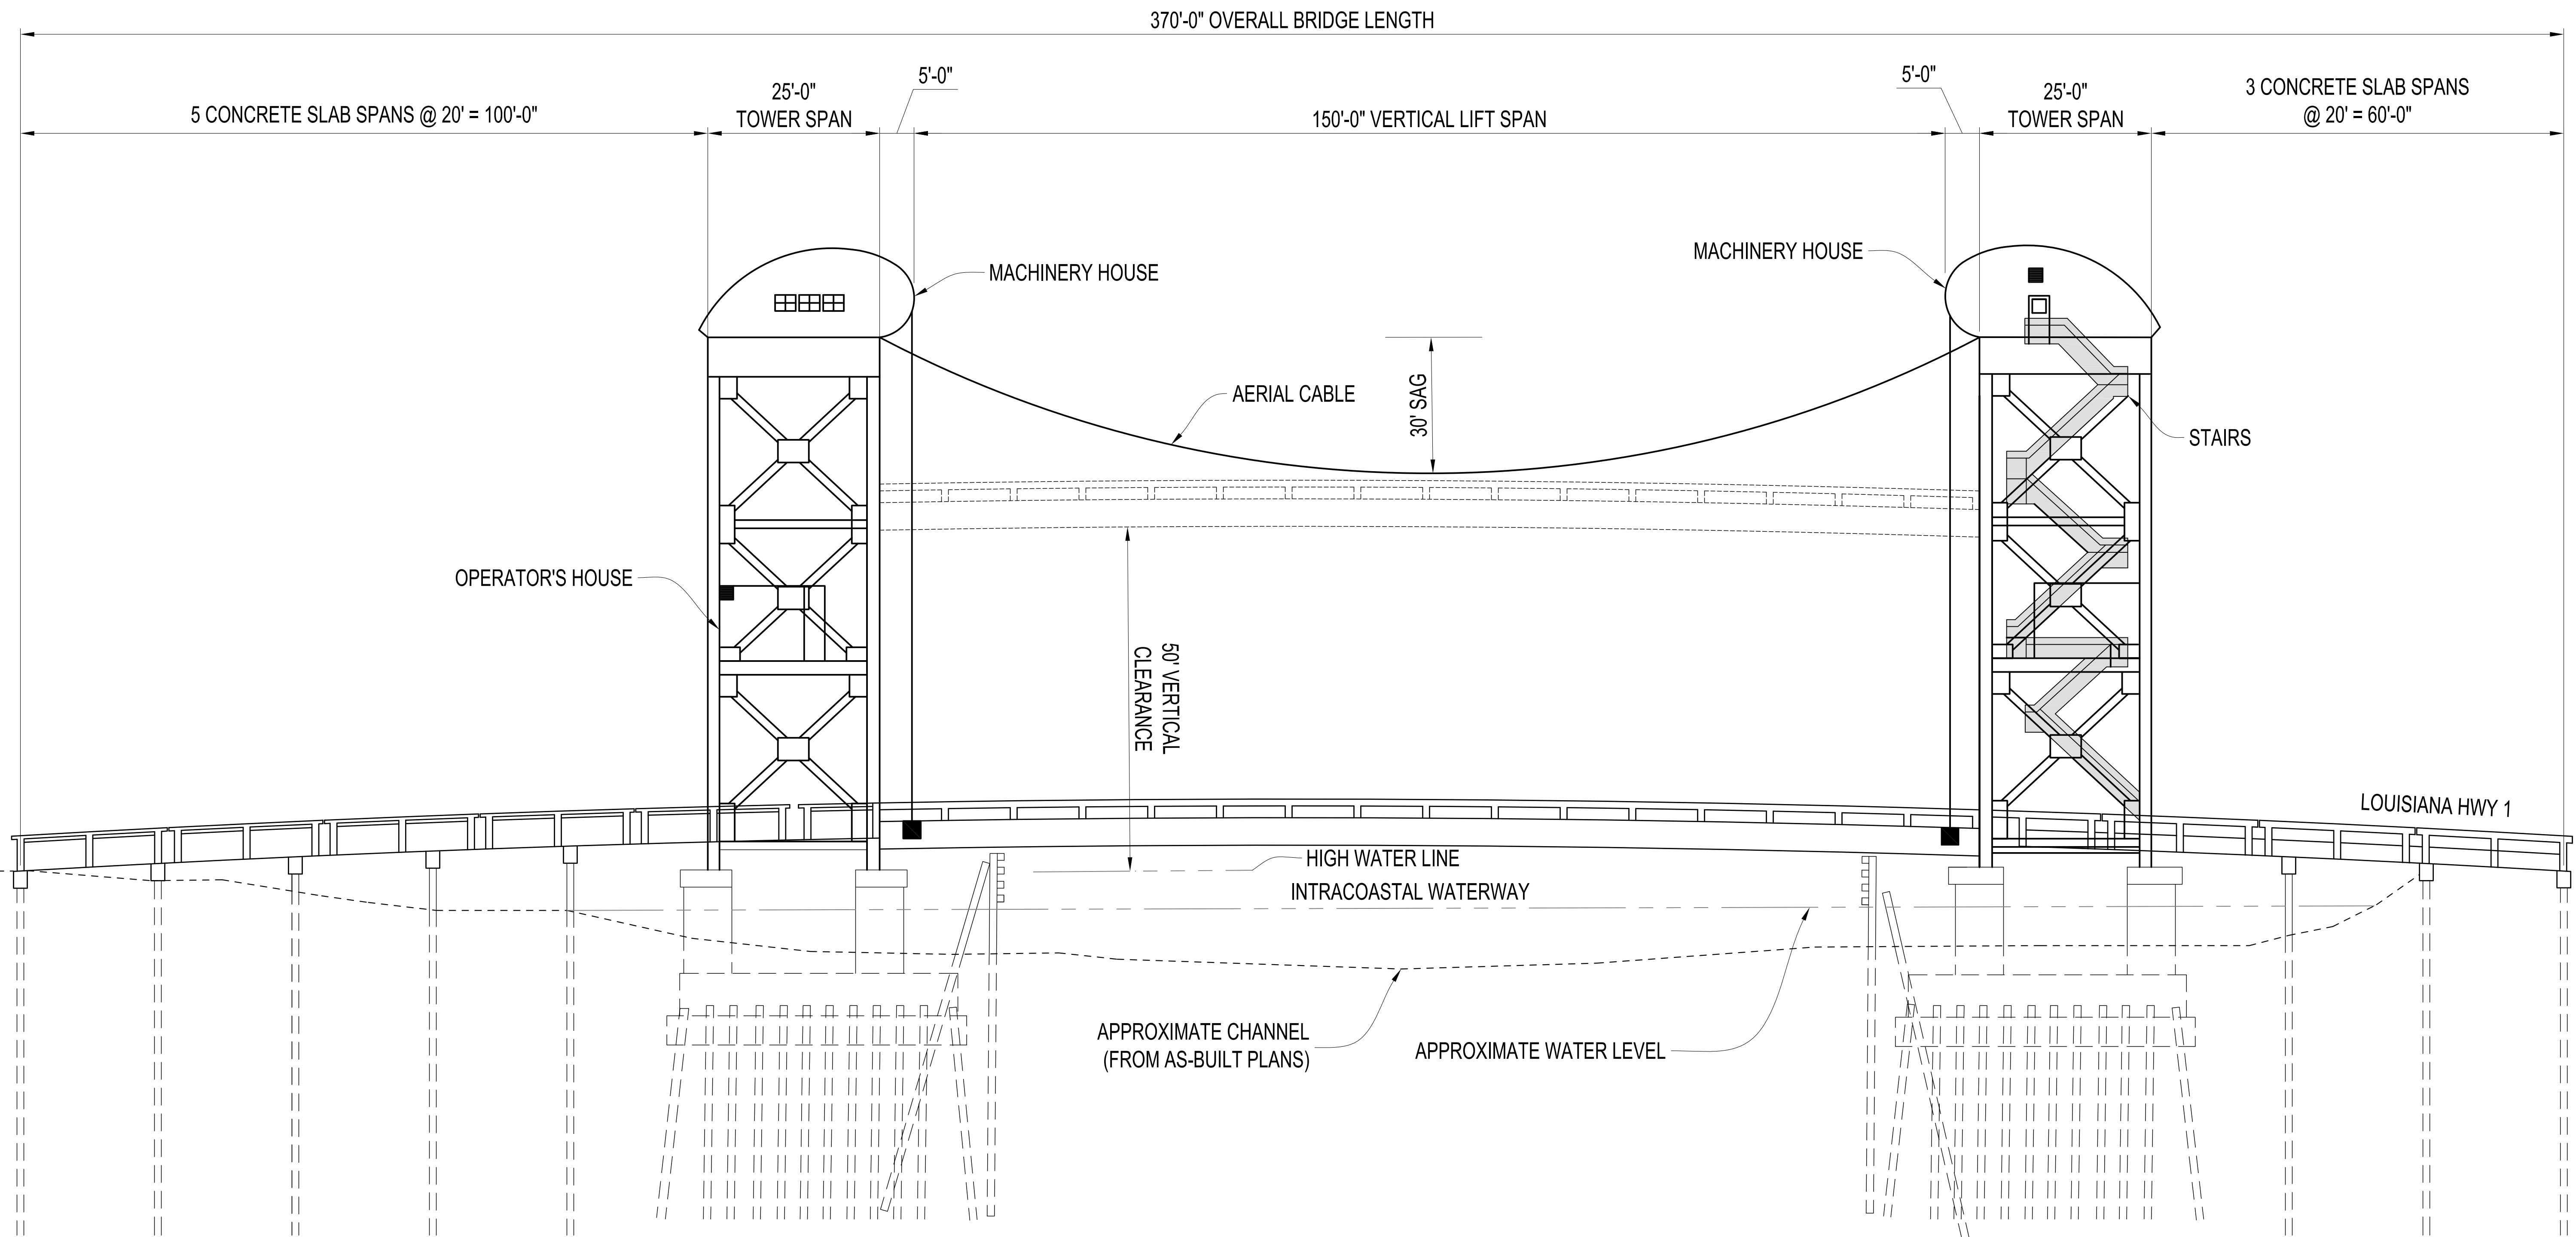

DELINEATED BY: J. DUFFIE, MEAD & HUNT, INC., 2017

LOUISIANA HISTORIC
BRIDGE INVENTORY
NATIONAL PARK SERVICE
UNITED STATES DEPARTMENT OF THE INTERIOR

LOCKPORT

LOCKPORT COMPANY CANAL BRIDGE
CARRIES LOUISIANA HIGHWAY 1 (LA 1) OVER LOCKPORT CANAL
LAFOURCHE PARISH



LOUISIANA

SHEET
3 OF 4

HISTORIC AMERICAN
ENGINEERING RECORD
LA-32

LIBRARY OF CONGRESS
INDEX NUMBER

IF REPRODUCED, PLEASE CREDIT THE HISTORIC AMERICAN ENGINEERING RECORD, NATIONAL PARK SERVICE, NAME OF DELINEATOR, DATE OF DRAWING

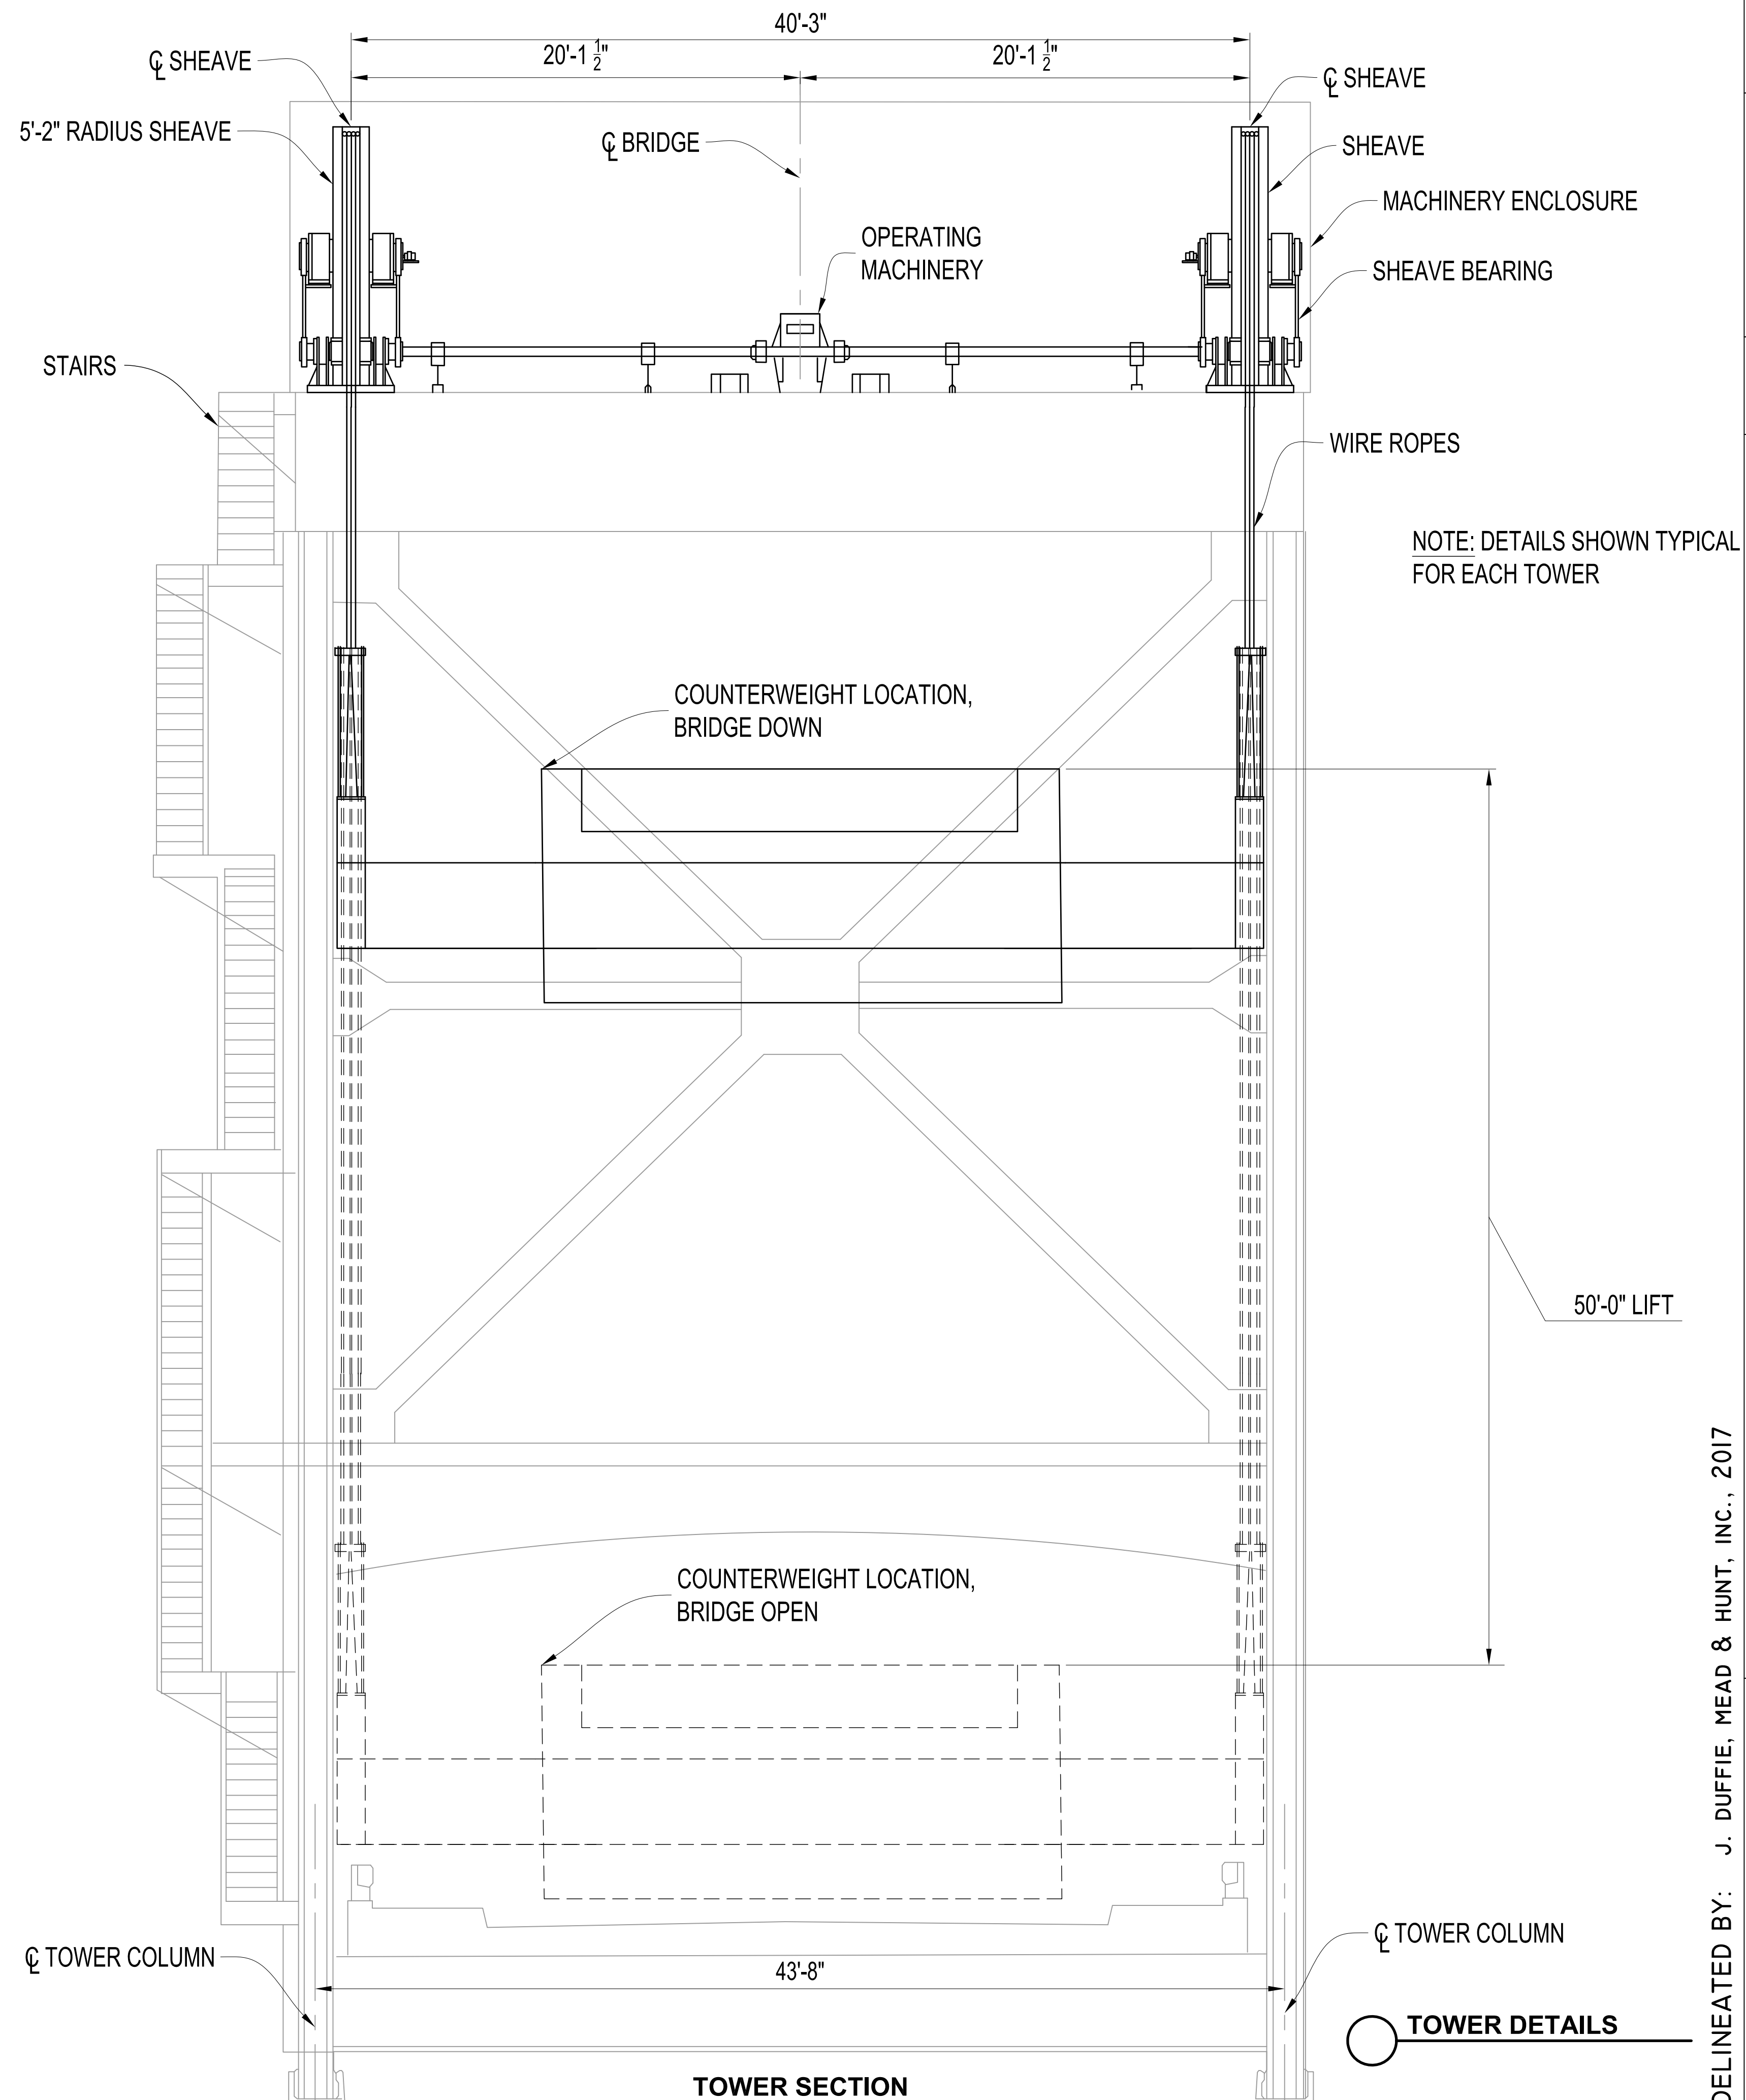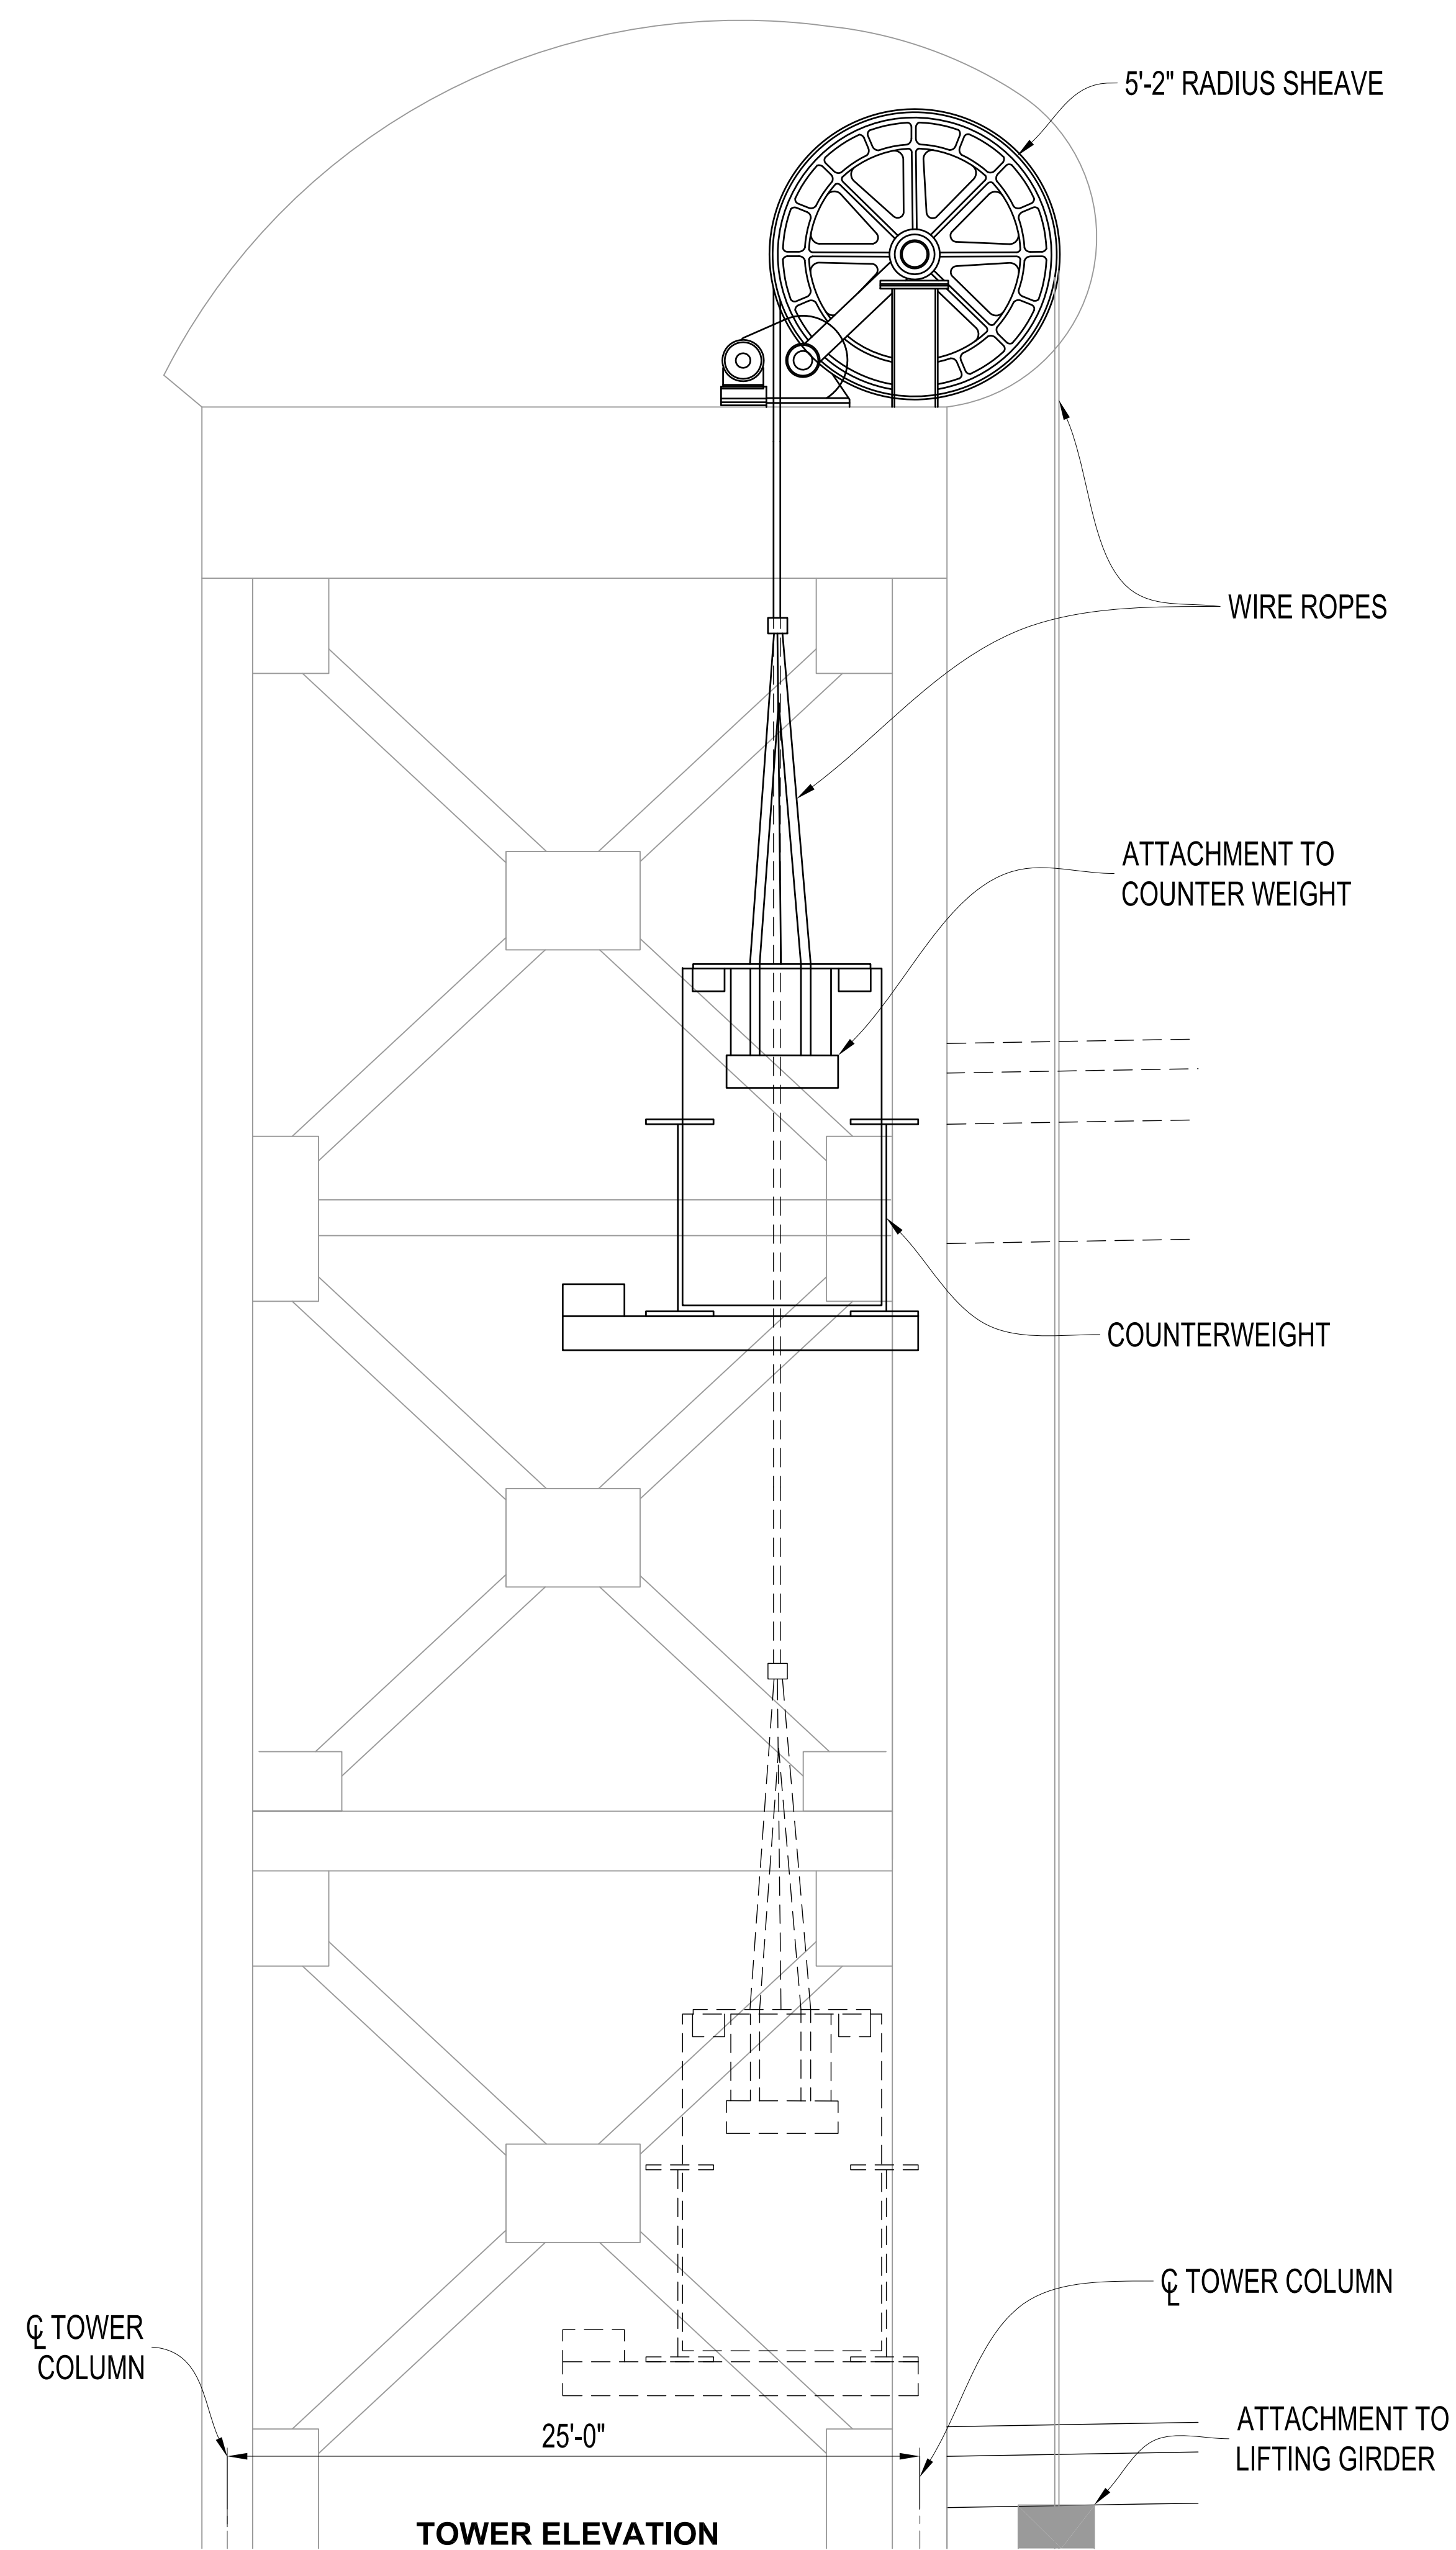

○ **TOWER DETAILS**

DELINEATED BY: J. DUFFIE, MEAD & HUNT, INC., 2017
 LOUISIANA HISTORIC BRIDGE INVENTORY
 NATIONAL PARK SERVICE
 UNITED STATES DEPARTMENT OF THE INTERIOR

LOCKPORT COMPANY CANAL BRIDGE
 CARRIES LOUISIANA HIGHWAY 1 (LA 1) OVER LOCKPORT CANAL
 LAFOURCHE PARISH

LOUISIANA 4 OF 4

HISTORIC AMERICAN ENGINEERING RECORD
 LA-32



REPRODUCED PLEASE CREDIT THE HISTORIC AMERICAN ENGINEERING RECORD, NATIONAL PARK SERVICE, NAME OF DELINEATOR, DATE OF DRAWING

94

STATE PROJECT	PARISH	SHEET NO.
1-00-1	LAFAYETTE	9



PLAN	DATE
APPROVED	7-55
NOTED	7-55
BY	

PROF.	DATE
APPROVED	7-55
NOTED	7-55
BY	

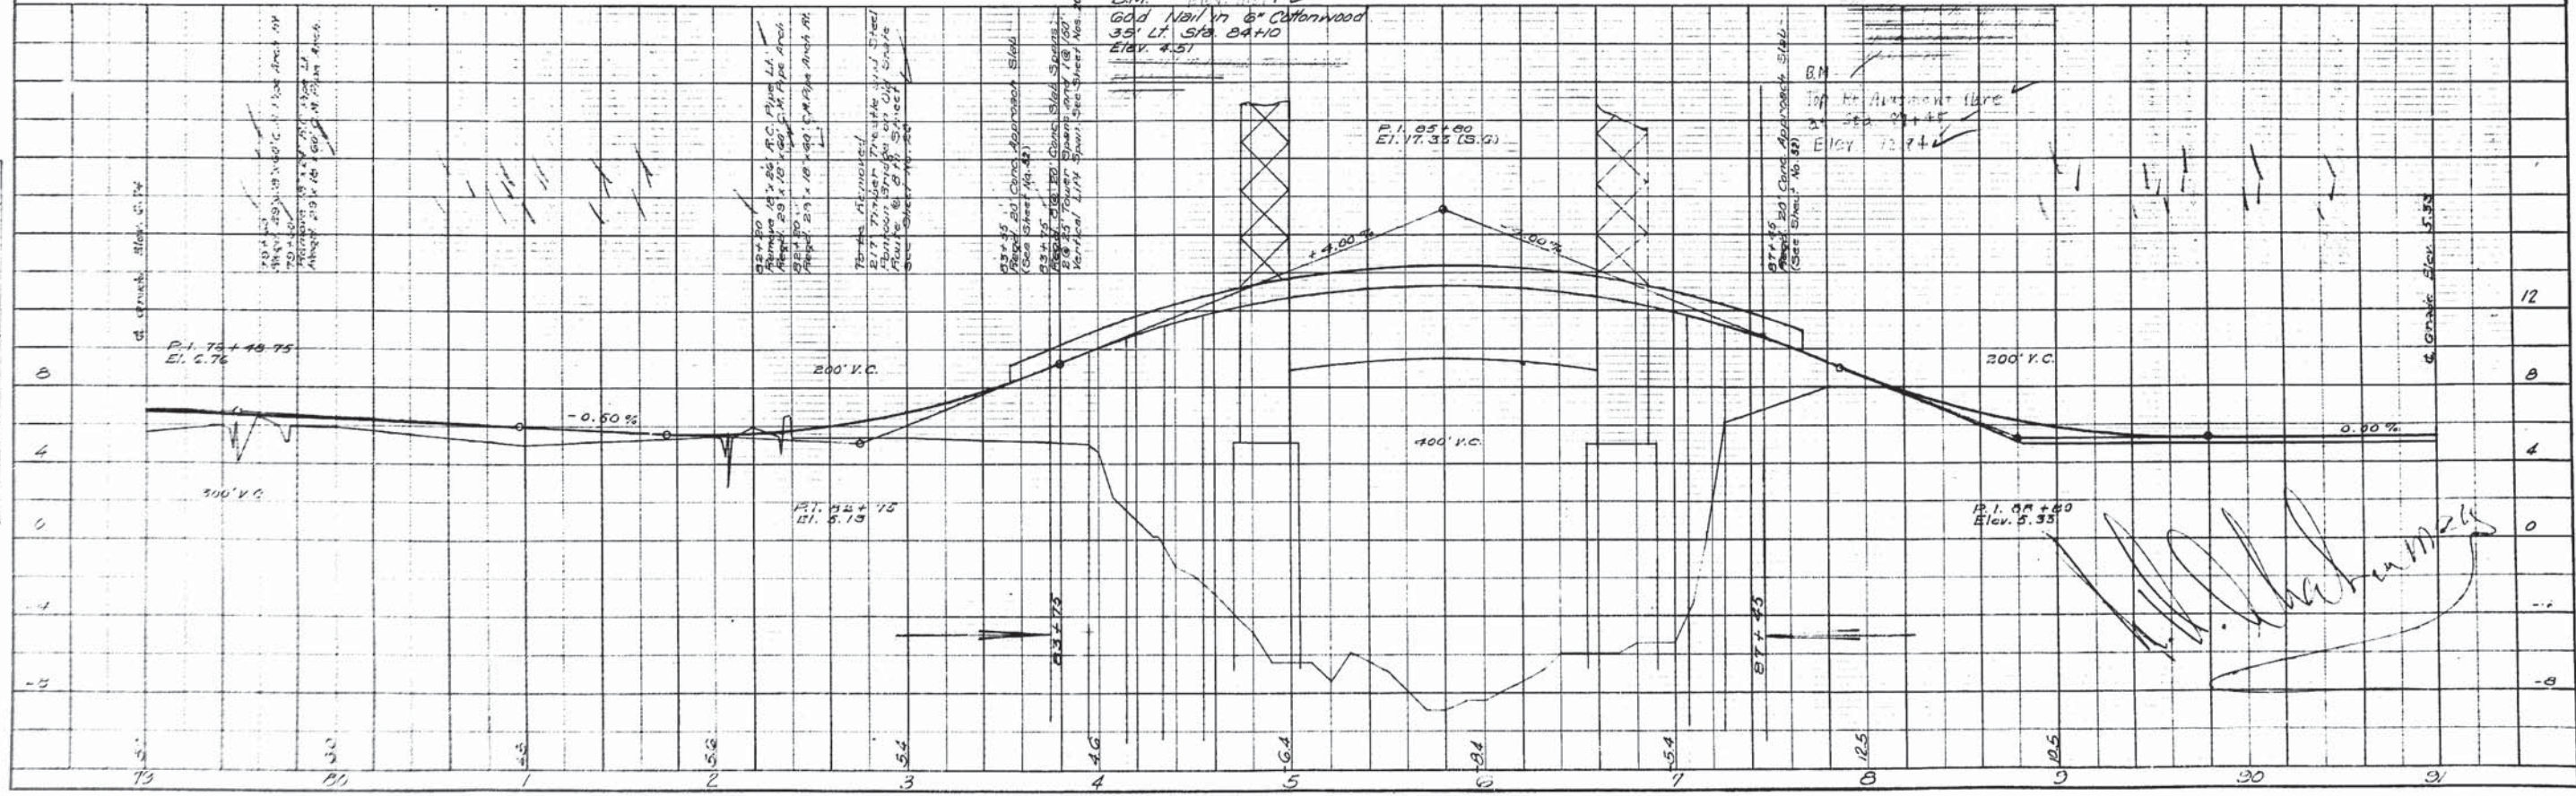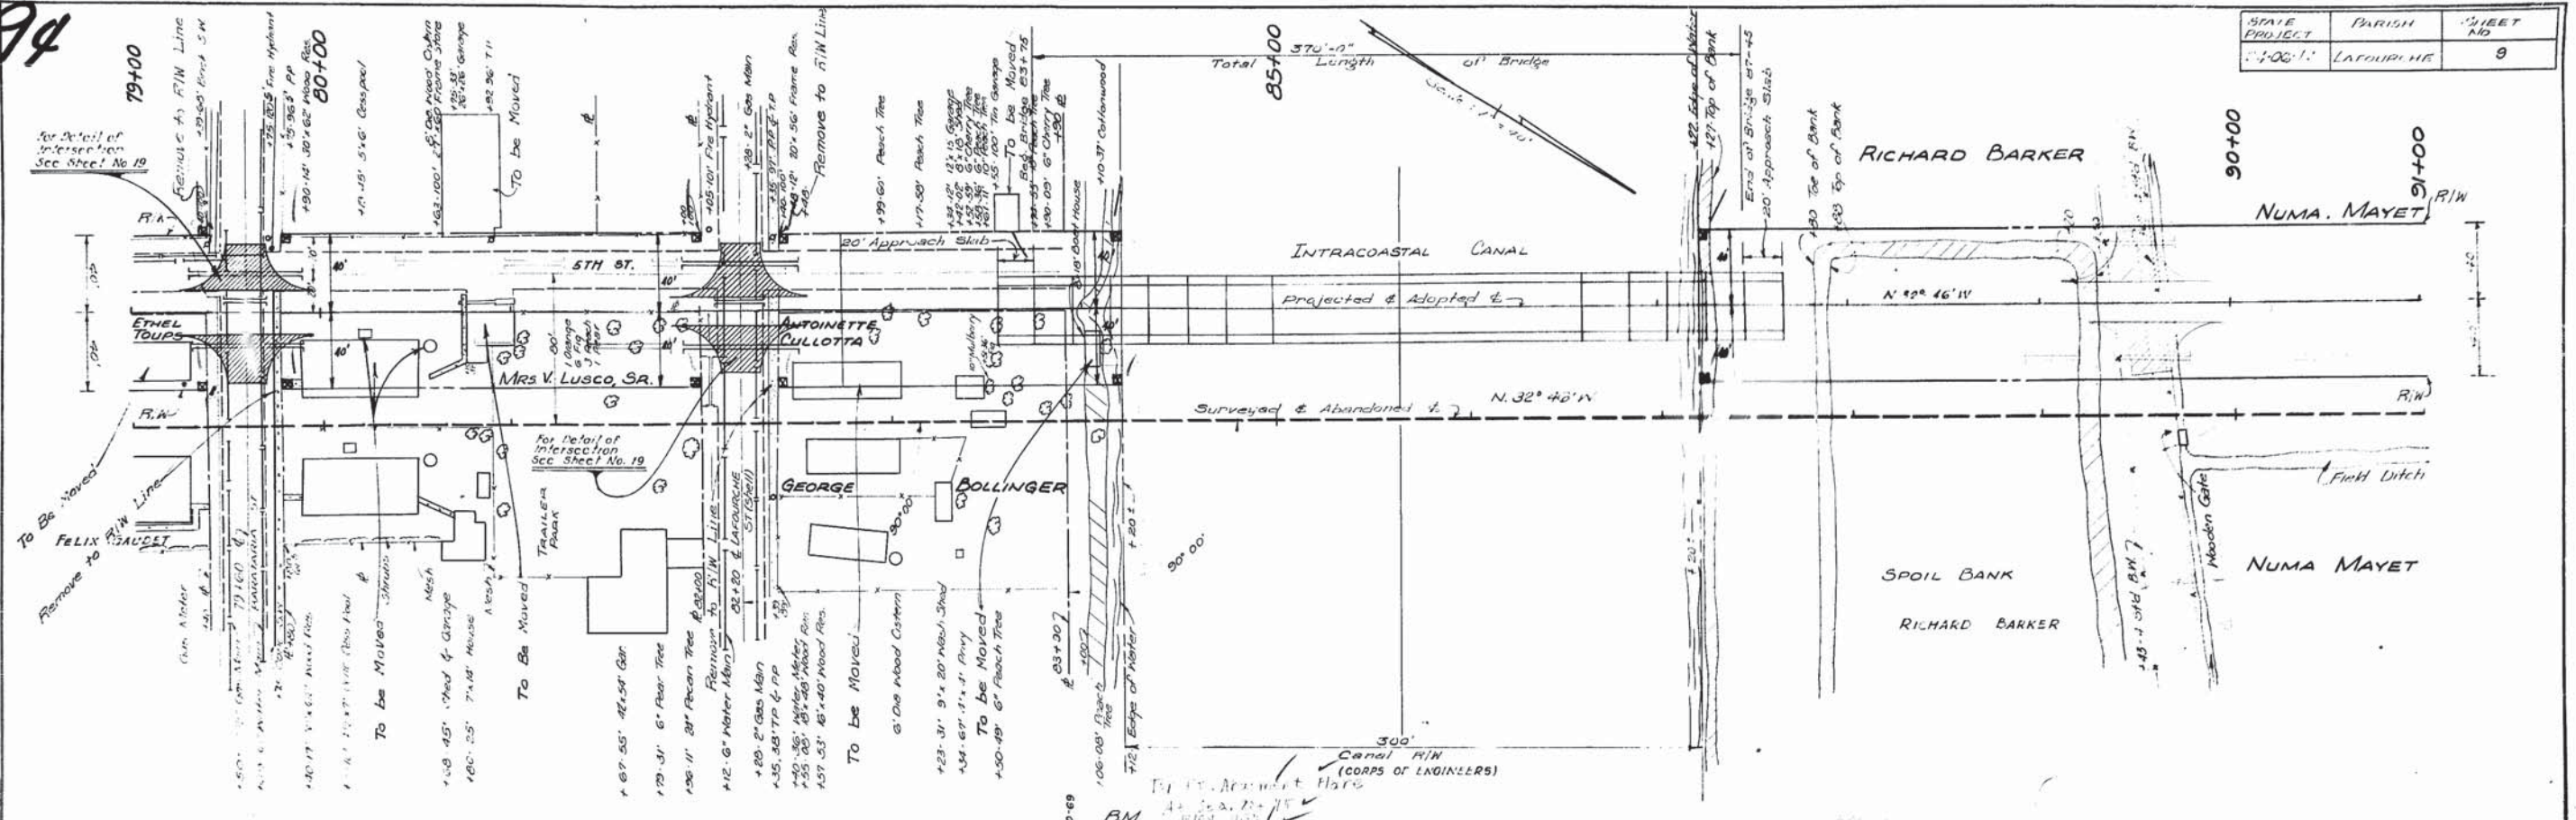

109

State Project	Ar-14	Sheet No.
64-00-12	Lockport	20

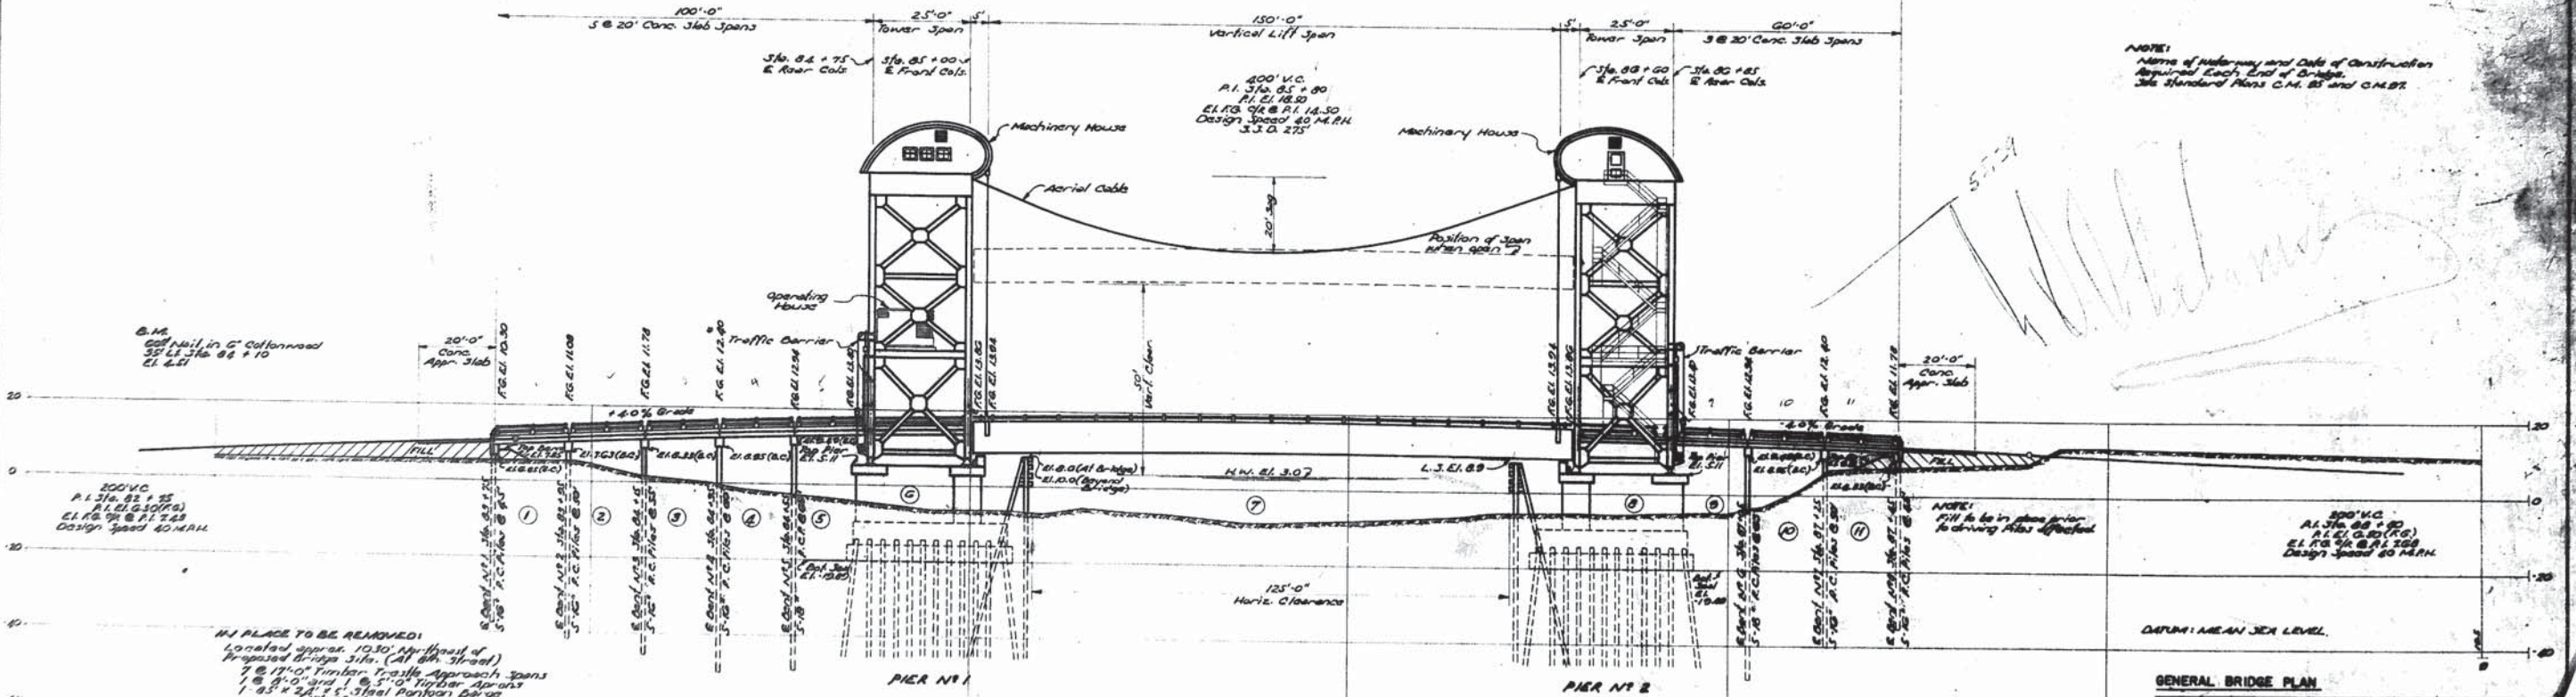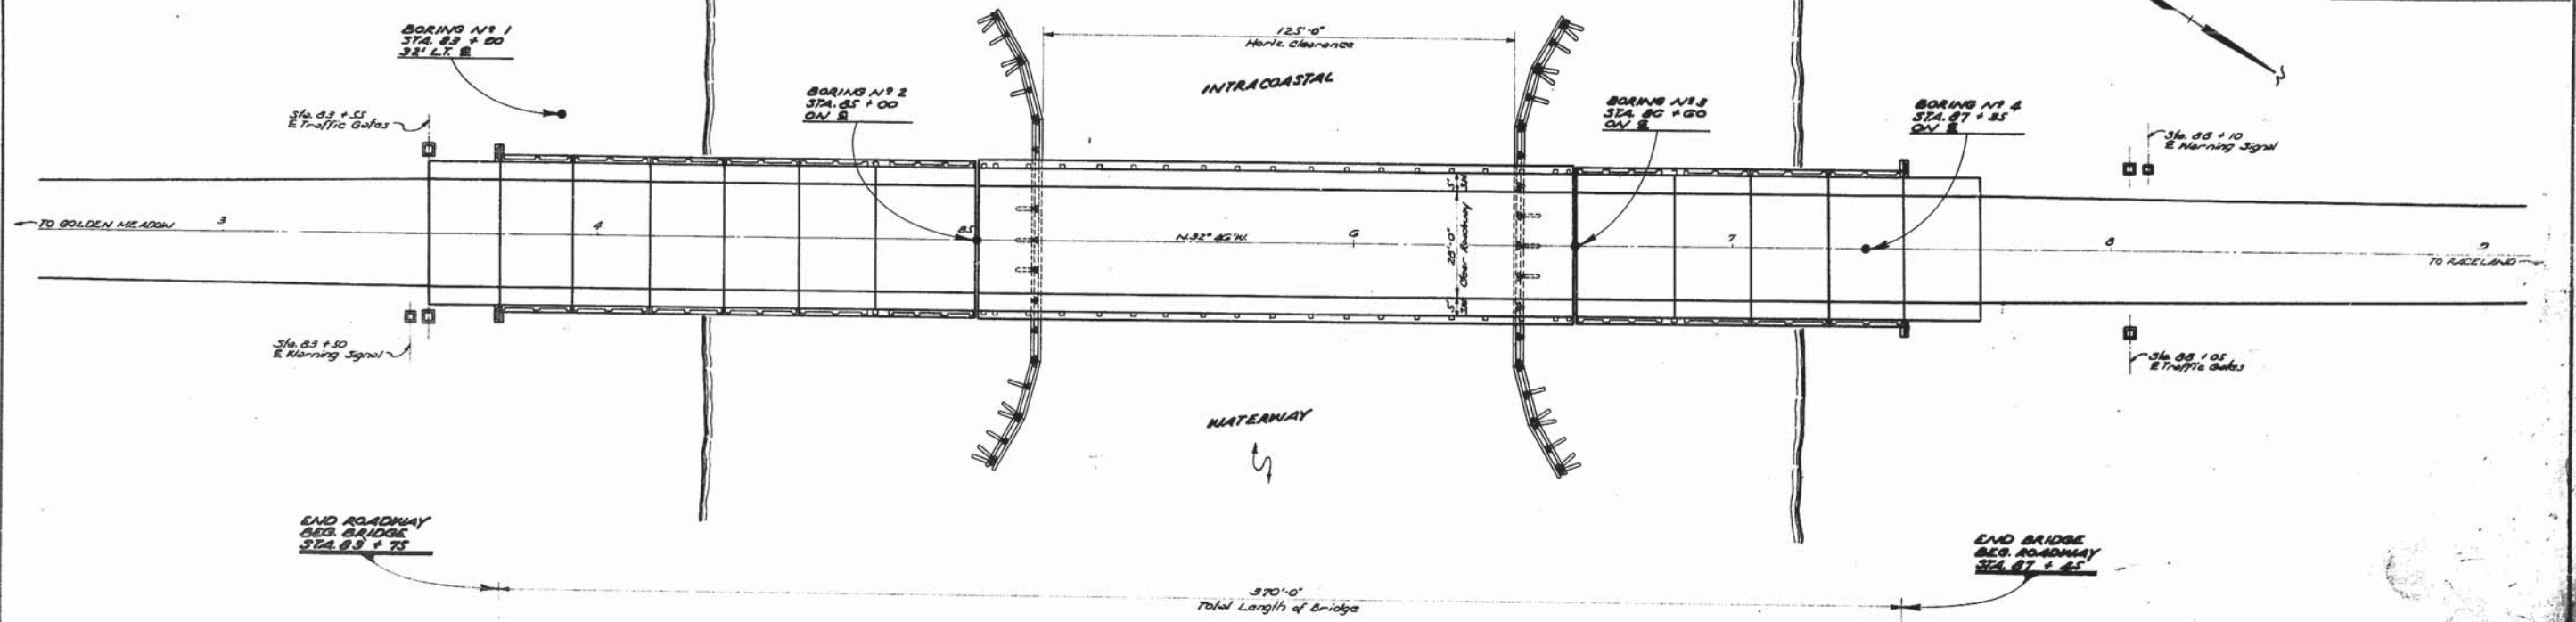

NO PLACE TO BE REMOVED!
 Located approx. 10:30 N. of Head of Proposed Bridge Site. (At 6th Street)
 7 @ 17'-0" Finish, Castile Approach Spans
 7 @ 4'-0" and 1 @ 5'-0" Tower Spans
 1 @ 5' x 2 1/2' Steel Parapet Parapet
 (14'-3" Clear Roadway)
 Salvageable Material and Steel Parapet Cargos to be delivered to the Lake Maintenance Headquarters at Lakeport.
 Removal of existing bridge to be paid for under Item 5-227 and hauling of Salvaged Material to be included in Item 3-4.

GENERAL BRIDGE PLAN


INTRACOASTAL WATERWAY BRIDGE
LOCKPORT
L.A. ROUTE NO. 1

DATED: JULY 3, 1957

STATE OF LOUISIANA
 DEPARTMENT OF HIGHWAYS


DESIGNED	DETAILER	TRACER
CHECKED	CHECKED	CHECKED
BRIDGE DESIGN SECTION		



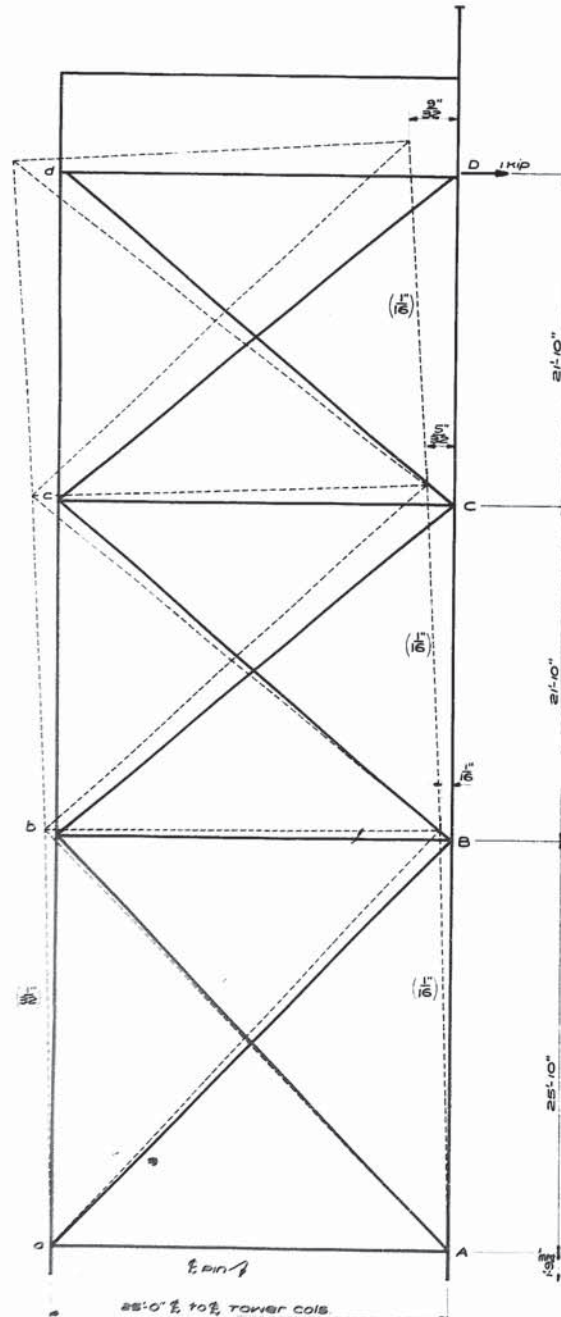



MEMBER	DL STRESS KIPS	LENGTH INS.	AREA SQ. INS.	SL CALCULATED INS.	SL ACTUAL INS.	"U" STRESS IKIP LD @ D	$\Delta H = \frac{SUL}{AE}$
DC	253.1	252	42.60	0.0516"	0.0625"	-0.8400	+0.0525
CB	269.1	252	42.60	0.0549"	0.0625"	-1.6800	+0.1050
BA	307.2	310	42.60	0.0771"	0.0625"	-2.7133	+0.1696
dc	29.3	252	42.60	0.0060"	0.0000"	0.0000	0.0000
cb	42.7	252	42.60	0.0087"	0.0000"	+0.8400	0.0000
ba	90.0	310	42.60	0.0226"	0.0313"	+1.6800	-0.0525

$\Sigma \frac{SUL}{AE} = \Delta H = +0.2746$

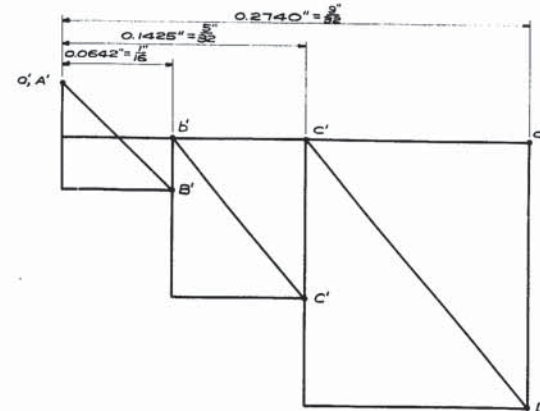

GENERAL NOTES:

CONSTRUCTION SPECS: LA. DEPT OF HIGHWAYS STD. SPECS. FOR ROADS AND BRIDGES, DATED JULY, 1955
 DESIGN SPECS: A. A. S. H. O. STD. SPECS. FOR HIGHWAY BRIDGES, 1953, AS AMENDED TO DEC., 1955
 WELDING SPECS: STD. SPECS. FOR WELDED HIGHWAY AND RAILWAY BRIDGES, 1956, AND LA. DEPT. OF HWYS. SPECIAL PROVISIONS.
 LIVE LOAD: H20-516-44.
 REINFORCING BARS SHALL BE INTERMEDIATE OR HARD GRADE A. S. T. M. A15, OR RAIL STEEL, A. S. T. M. A16, AND SHALL CONFORM TO A. S. T. M. A-305.
 DIMENSIONS TO REINFORCING STEEL ARE TO BAR CENTERS. EXPOSED CONCRETE CORNERS TO BE CHAMFERED UNLESS OTHERWISE NOTED. HANDRAIL AND HANDRAIL POSTS TO BE POURED IN ONE OPERATION. HANDRAIL POSTS TO BE CONSTRUCTED NORMAL TO GRADE. CONCRETE AND REINFORCING STEEL IN H. R. ABOVE TOP OF 4" SIDEWALK CURB TO BE PAID FOR PER LIN. FT. OF CONCRETE H. R., INCLUDING BARS L1, L2 AND L3 THAT PROJECT INTO SAID 4" CURB. PIPE HANDRAIL AND BRACKETS, INCLUDING ANCHOR BOLTS FOR SAME, ON TOWER SPAN, ARE TO BE PAID FOR PER LIN. FT. OF PIPE HANDRAIL. NO DEDUCTION IN QUANTITY OF CLASS "A" CONCRETE WILL BE MADE FOR 3" X 3" DRAIN OPENINGS. SURFACE FINISHES, WHERE INDICATED, SHALL CONFORM TO THE AMERICAN STANDARDS FOR SURFACE ROUGHNESS, FINENESS AND LAY, PART 1 A. S. A. 846.1-1947. SHOP CONNECTIONS OF RIVETS, OPEN HOLES UNLESS OTHERWISE NOTED. ALL RIVETS SHALL CONFORM TO A. S. T. M. A141. THE CONTRACTOR MAY SUBSTITUTE HIGH STRENGTH BOLTS FOR RIVETS FOR ALL FIELD CONNECTIONS. WELDED PLATE GIRDERS ARE TO BE CAMBERED FOR DEAD LOAD AND VERTICAL CURVATURE AS SHOWN ON PLANS. FLOORBEAMS AND STRINGERS NEED NOT BE CAMBERED BUT ARE TO BE FABRICATED WITH CONVEX FLANGE UP. MATERIAL MARKED "L.A." SHALL BE STRUCTURAL LOW ALLOY STEEL, A. S. T. M. DESIGNATION A242. THE CONTRACTOR'S ATTENTION IS CALLED TO THE ALTERNATE SPLICES, AND NOTE THEREON, FOR THE WELDED GIRDERS OF THE VERTICAL LIFT SPAN TOWERS. SHALL BE CAMBERED SO THAT FRONT LEGS WILL BE VERTICAL UNDER DEAD LOAD.
 TOWER COLUMNS AND LONGITUDINAL BRACING SHALL BE SHOP ASSEMBLED, AND THE HOLES IN THE FIELD CONNECTIONS OF THE LONGITUDINAL BRACING MEMBERS AND COLUMN SPLICES SHALL BE REAMED AT ASSEMBLY. SHOP ASSEMBLY WILL NOT BE REQUIRED FOR THE TRANSVERSE BRACING, AND THE HOLES FOR THE FIELD CONNECTIONS OF THE TRANSVERSE BRACING MAY BE PUNCHED OR DRILLED FULL SIZE.

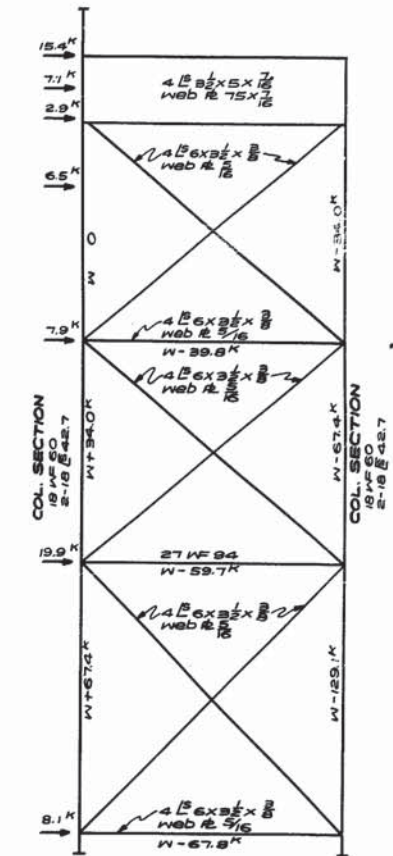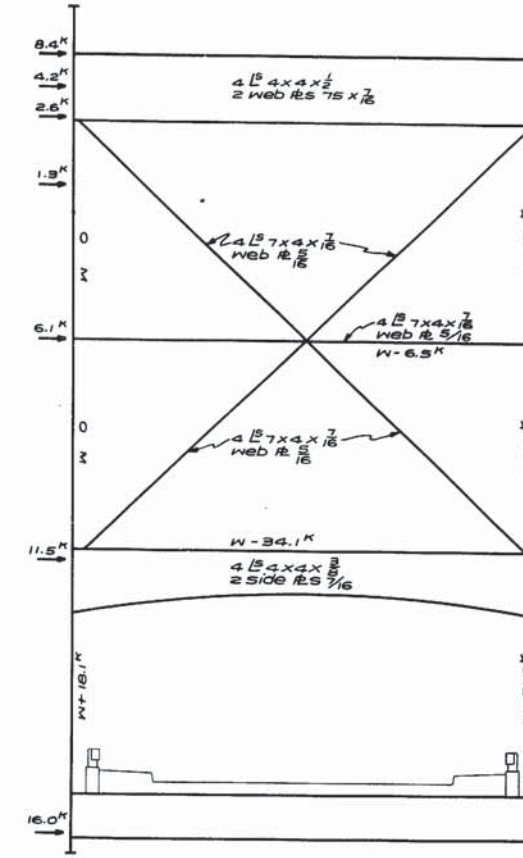

BASIS OF DESIGN FOR LATERAL STRESSES
 SPAN LOWERED: 50 MPH WIND @ 125% OF BASIC STRESSES
 SPAN RAISED: 50 MPH WIND @ 150% OF BASIC STRESSES
 15 MPH WIND @ 125% OF BASIC STRESSES

MAXIMUM REACTION PER SHOE

	FRONT COL.	REAR COL.
D.L.	375 K	182 K
D.L.I.	75 K	36 K
L.L.	91 K	44 K
L.L.I.	18 K	13 K
S.W.L.L.	25 K	10 K

TABLE OF ESTIMATED QUANTITIES

	2 TOWERS	2 COUNTERWEIGHTS
CLASS "A" CONCRETE	98.40 CU. YDS.	
BAR CARBON STEEL	58,700 LBS.	41,440 LBS.
DEF. REINFR. STEEL	17,872 LBS.	8460 LBS.
CONCRETE HANDRAIL	91.00 LIN. FT.	
PIPE HANDRAIL	91.00 LIN. FT.	
CLASS "A" CONCRETE IN COUNTERWEIGHTS		89.48 CU. YDS.
STRUCTURAL LOW ALLOY STEEL	36,600 LBS.	
BALANCE CHAINS		LUMP


TOWER DESIGN DATA

STANDARD PLAN
 150' VERTICAL LIFT SPAN
 LIVE LOAD H20-516-44
 28'-0" ROADWAY 5'-0" SIDEWALKS
 4'-0" LIFT OPEN STEEL GRID FLOOR
 DAILY MAY 9 1957




STATE OF LOUISIANA
 DEPARTMENT OF HIGHWAYS

DESIGNED BY: [Signature] CHECKED BY: [Signature] TRACED BY: [Signature]
 DATE: [] DESCRIPTION: [] REVISIONS: []
 BRIDGE DESIGN SECTION



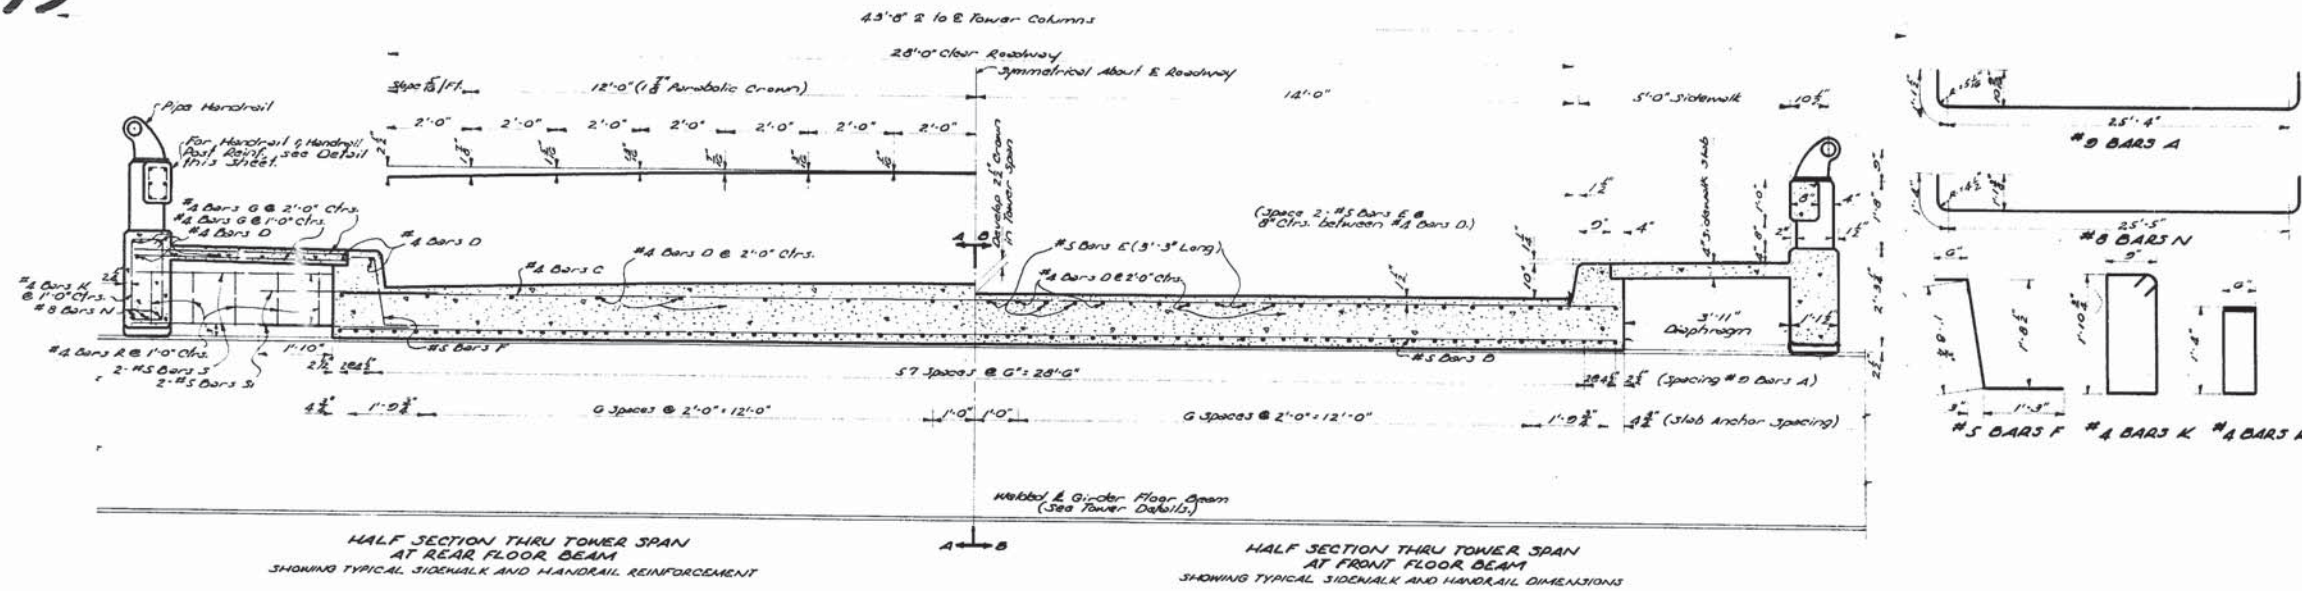

BILL OF MATERIAL (ONE SPAN)					
BAR	SIZE	NO	LENGTH	TOTAL LENGTH	LOCATION
A	#5	32	27'-4"	1008'-8"	Longit. in slab
TOTAL #5 BARS = 1008'-8" = 5702 LBS.					
N	#5	0	28'-1"	108'-0"	Longit. in S.W. Beam
TOTAL #5 BARS = 108'-0" = 450 LBS.					
O	#5	20	30'-0"	600'-0"	Transv. Ball of Slab
E	#5	30	3'-3"	97'-0"	Top of Slab @ Curb End
F	#5	58	3'-0"	203'-0"	Curb
S	#5	8	4'-10"	98'-8"	Diaphragm
3	#5	8	3'-8"	20'-4"	Diaph. to Slab Down
TOTAL #5 BARS = 1238'-0" = 1802 LBS.					
C	#4	14	30'-0"	420'-0"	Transv. in Top of Slab
D	#4	34	20'-2"	687'-0"	Longit. Top Slab @ S.W.
G	#4	72	3'-2"	372'-0"	Top of Slab Transv. in SW
K	#4	34	0'-3"	337'-0"	Stirrups in S.W. Beam
R	#4	30	4'-2"	125'-0"	Stirrups in Diaph.
TOTAL #4 BARS = 2144'-2" = 1432 LBS.					
TOTAL REINFORCING STEEL = 8036 LBS.					
TOTAL CLASS "A" CONCRETE = 40.2 CU. YDS.					
FABRICATED CARBON STEEL = 577 LBS.					
CONCRETE HANDRAIL = 45.50 LIN. FT.					
PIPE HANDRAIL = 45.50 LIN. FT.					

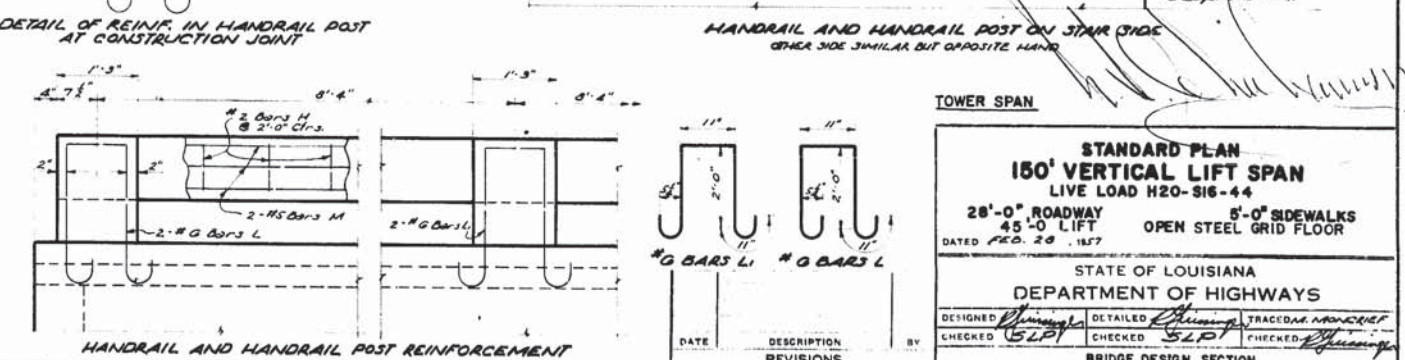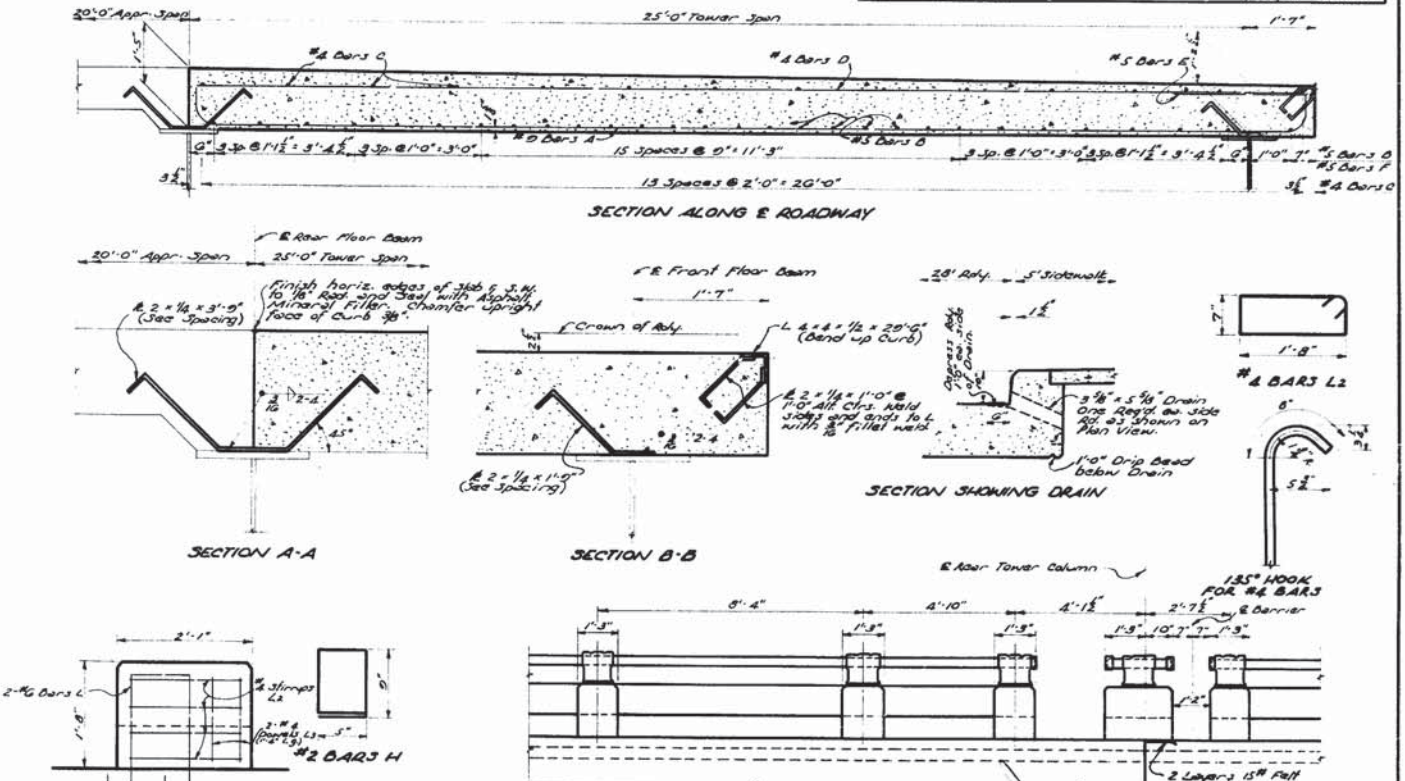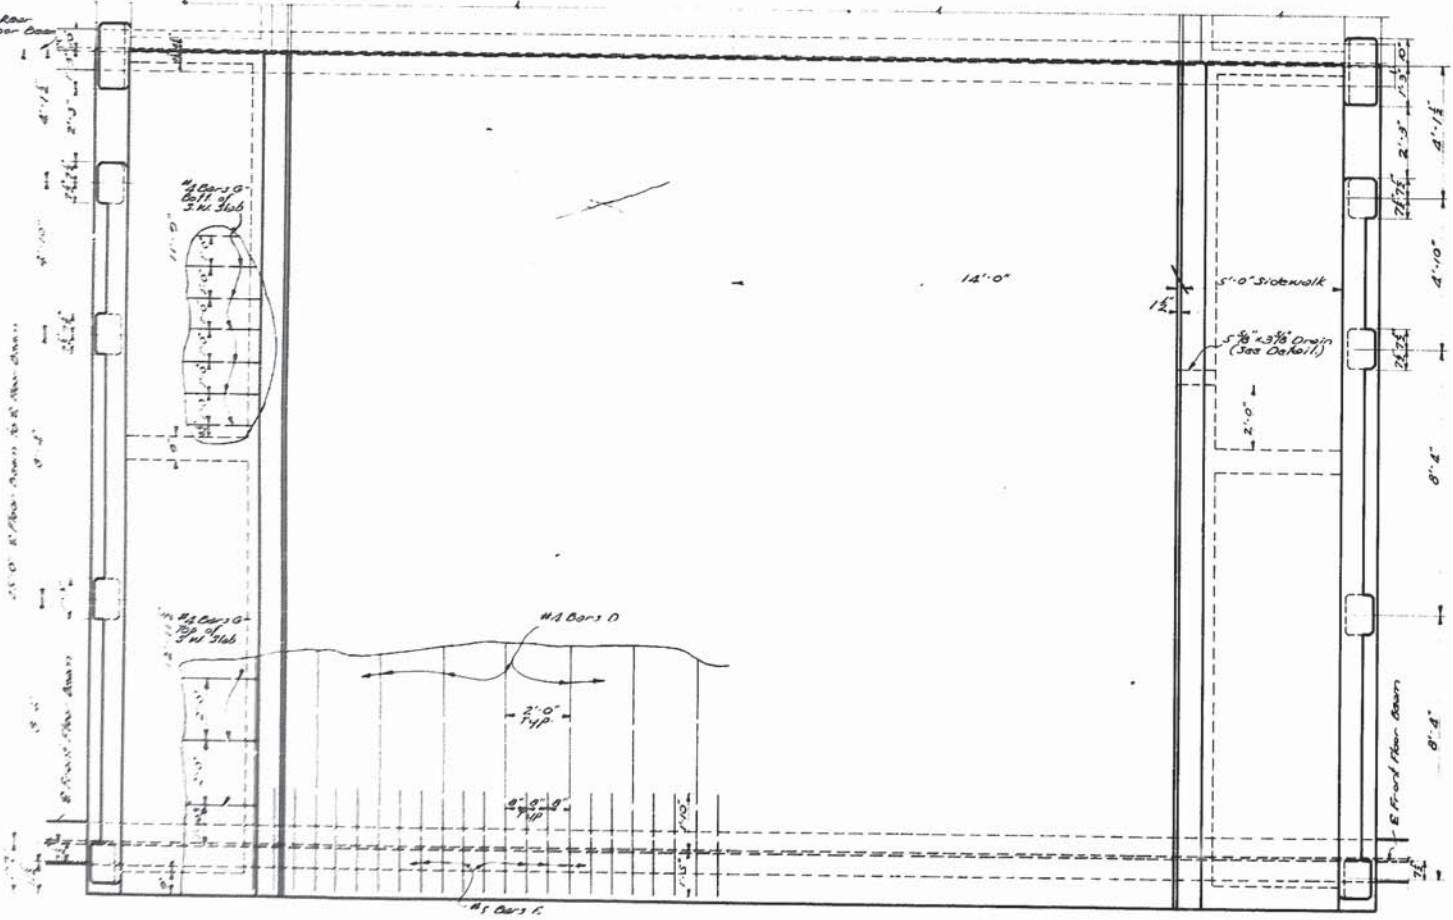


STANDARD PLAN		
150' VERTICAL LIFT SPAN		
LIVE LOAD H20-S16-44		
28'-0" ROADWAY	45'-0" LIFT	5'-0" SIDEWALKS
OPEN STEEL GRID FLOOR		
DATED FEB. 20, 1957		
STATE OF LOUISIANA		
DEPARTMENT OF HIGHWAYS		
DESIGNED	DETAILED	TRACED AND CHECKED
CHECKED	CHECKED	CHECKED
BRIDGE DESIGN SECTION		




119

STATE PROJECT	PARISH	SHEET
G.A. 00-16	Lafourche	30

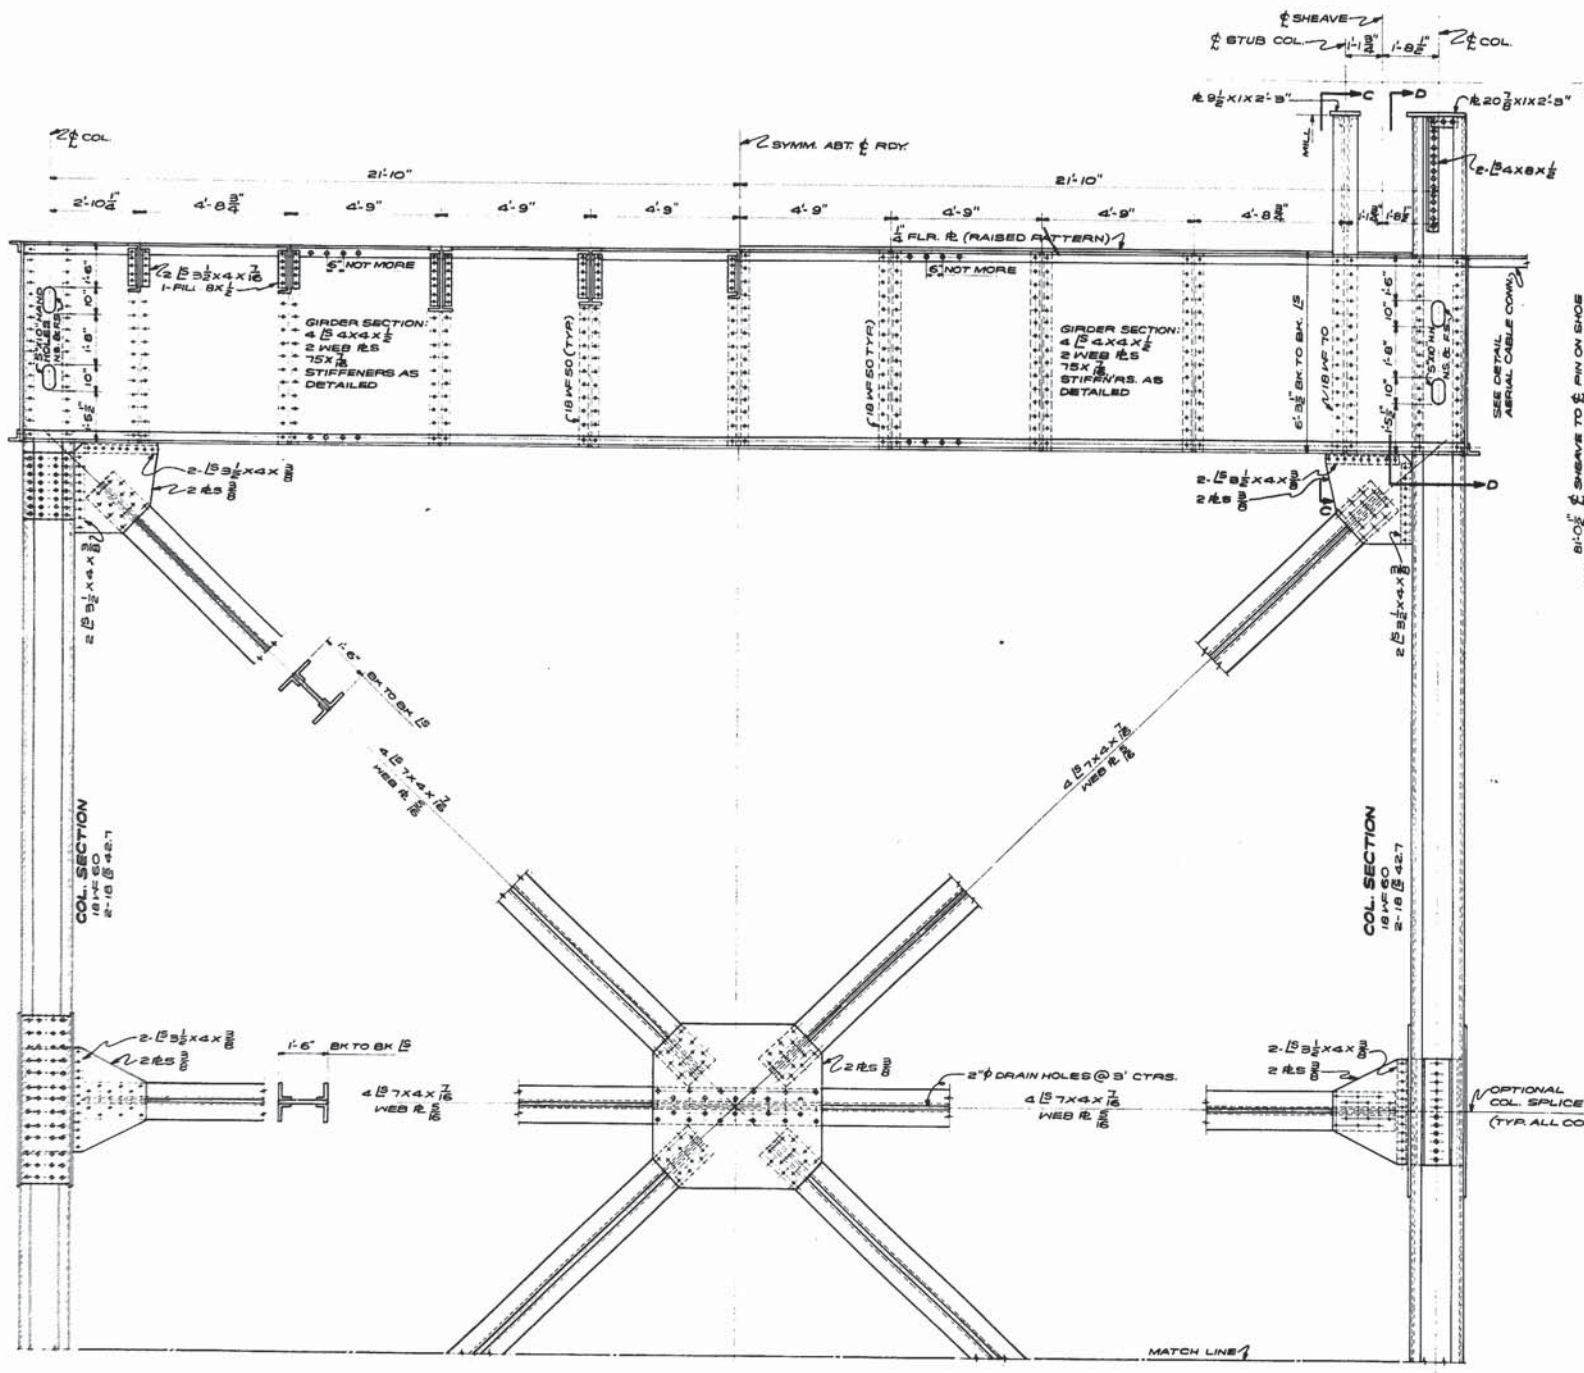


HALF ELEVATION AT REAR OF TOWER

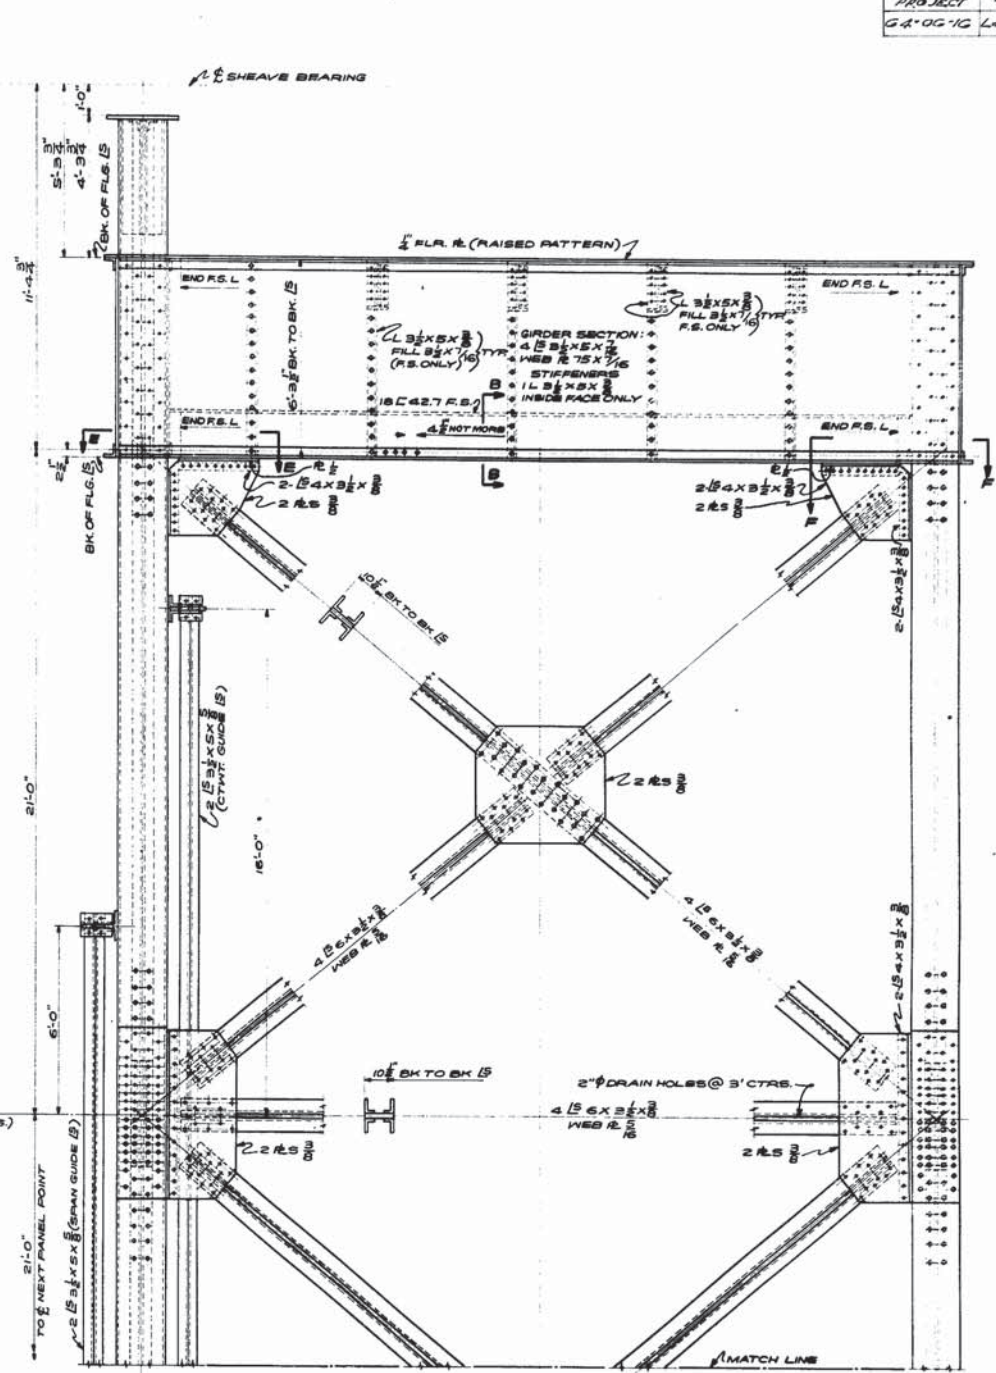

HALF ELEVATION AT FRONT OF TOWER

SIDE ELEVATION

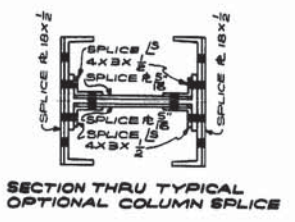

SECTION THRU TYPICAL OPTIONAL COLUMN SPLICE

NOTE: SEE SHEET N° 7 OF 26 FOR SECTION B-B, C-C, D-D, E-E AND F-F

TOWER DETAILS

STANDARD PLAN
150' VERTICAL LIFT SPAN
 LIVE LOAD H20-S16-44
 28'-0" ROADWAY 5'-0" SIDEWALKS
 45'-0" LIFT OPEN STEEL GRID FLOOR
 APRIL 28 57


STATE OF LOUISIANA
 DEPARTMENT OF HIGHWAYS

[Signatures]
 BRIDGE DESIGN SECTION



20

STATE PROJECT	PARISH	SHEET
01-001G	Lafayette	31

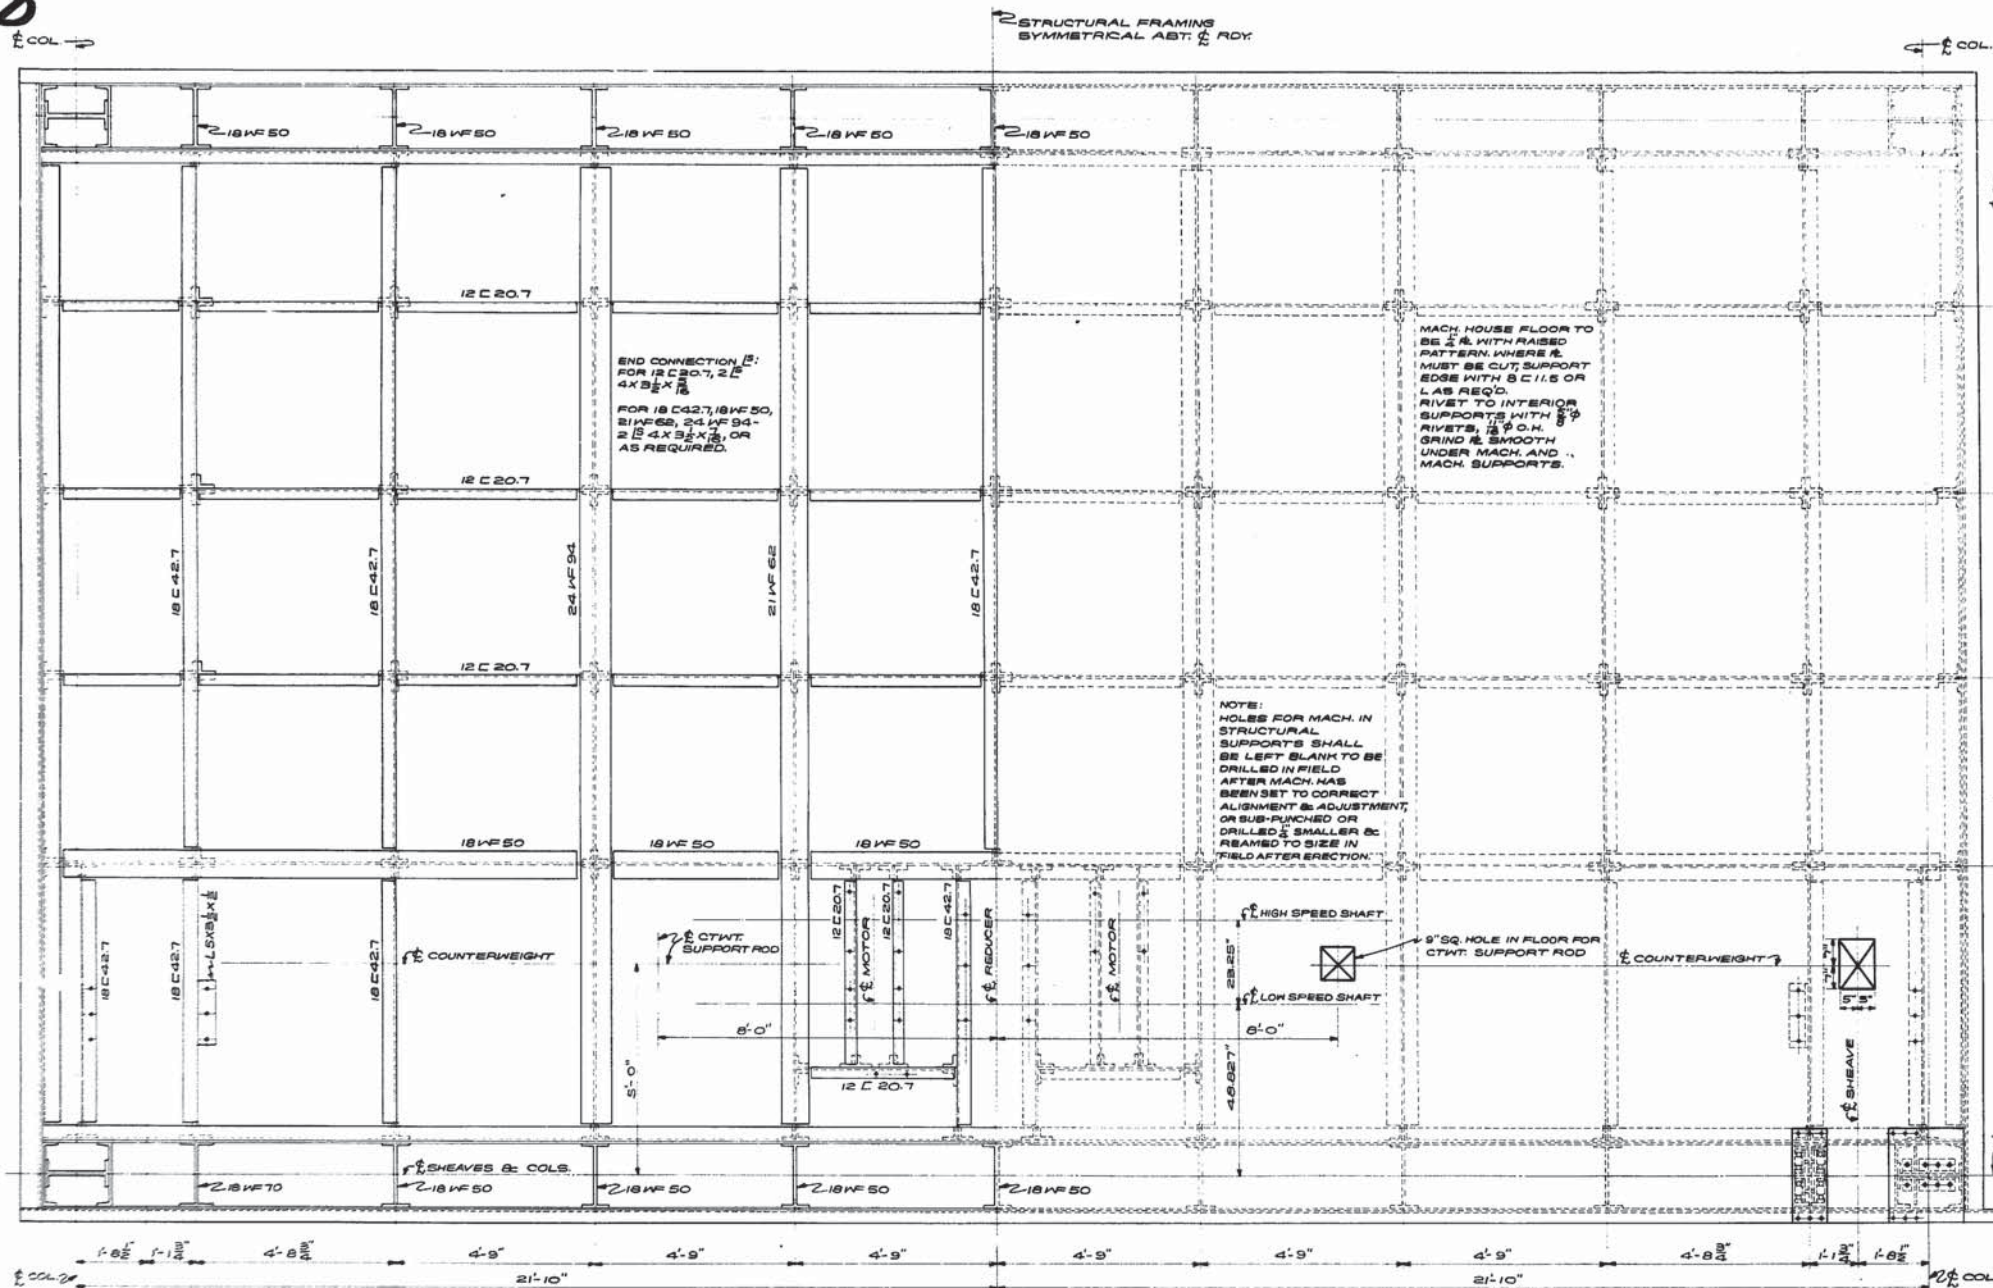


END CONNECTION B:
FOR 12 C 20.7, 2 L
4 X 3 1/2 X 3/8
FOR 18 C 42.7, 18 WF 50,
21 WF 62, 24 WF 94 -
2 L 4 X 3 1/2 X 3/8, OR
AS REQUIRED.

MACH HOUSE FLOOR TO
BE 1/2" WITH RAISED
PATTERN WHERE IT
MUST BE CUT, SUPPORT
EDGE WITH 8 C.I.I.S OR
L AS REQ'D.
RIVET TO INTERIOR
SUPPORTS WITH 3/8"
RIVETS, 3" O.C.
GRIND & SMOOTH
UNDER MACH. AND
MACH. SUPPORTS.

NOTE:
HOLES FOR MACH. IN
STRUCTURAL
SUPPORTS SHALL
BE LEFT BLANK TO BE
DRILLED IN FIELD
AFTER MACH. HAS
BEEN SET TO CORRECT
ALIGNMENT & ADJUSTMENT,
OR SUB-PUNCHED OR
DRILLED & SMALLER &
REAMED TO SIZE IN
FIELD AFTER SECTION.

HALF PLAN OF TOWER AT FLOOR LEVEL
(FLOOR PL. REMOVED)


HALF PLAN TOWER

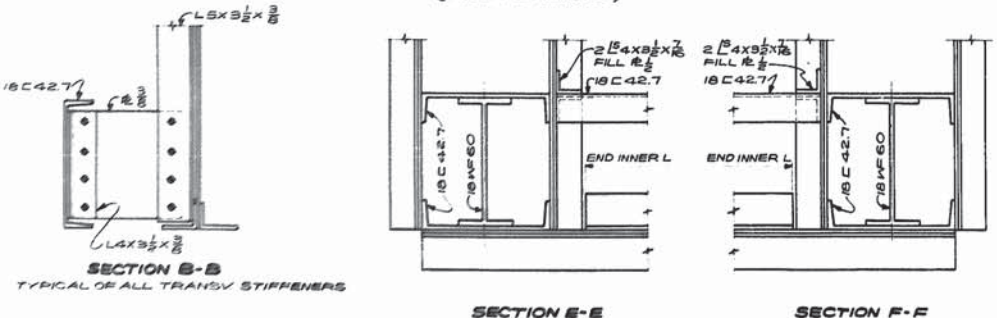

SECTION B-B
TYPICAL OF ALL TRANSV. STIFFENERS


SECTION E-E

SECTION F-F

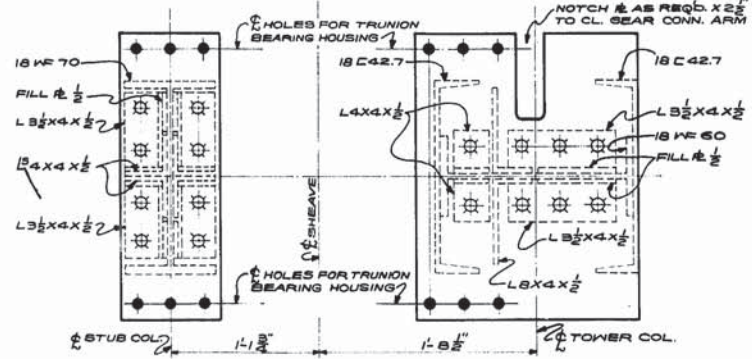


PLAN VIEW AT TOP OF STUB AND TOWER COLUMNS


NOTE:
FOR DETAIL OF CHANNEL PLATE AROUND
MACHINERY HOUSE, SEE DETAILS OF
MACHINERY HOUSE.

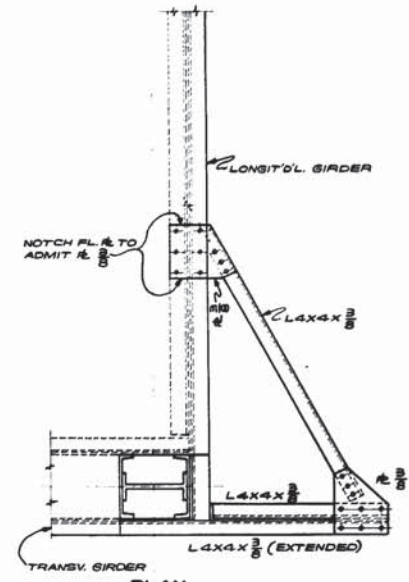

DETAILS AERIAL
CABLE BRACKET
(4 REQ'D.)

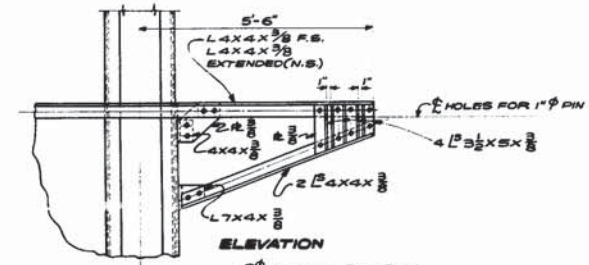

ELEVATION
SHEAVE BEARINGS

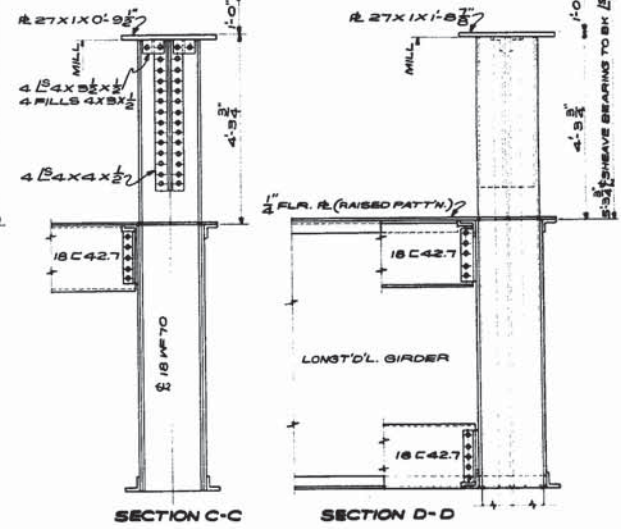


SECTION C-C

SECTION D-D







TOWER DETAILS

150' STANDARD LIFT SPAN
VERTICAL LIFT SPAN
 LIVE LOAD H20-S16-44
 28'-0" ROADWAY 5'-0" SIDEWALKS
 45'-0" LIFT OPEN STEEL GRID FLOOR
 DATED APRIL 29 '57
 STAT. OF LOUISIANA
 DEPARTMENT OF HIGHWAYS
 BRIDGE DESIGN SECTION

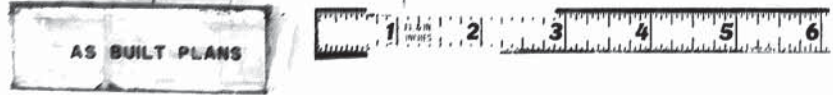


124

STATE PROJECT	PARISH	SHEET
62-06-1G	Lafayette	35

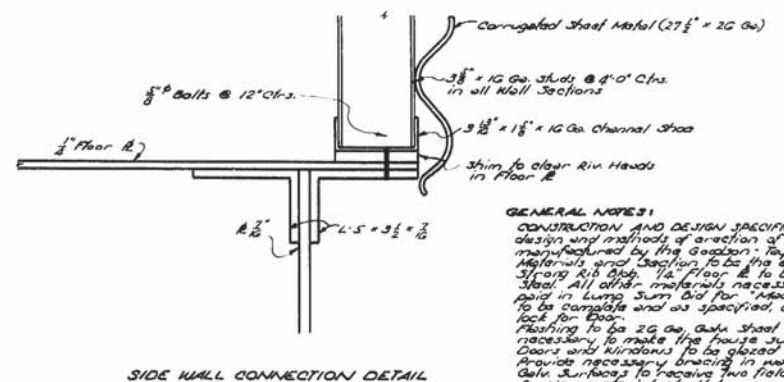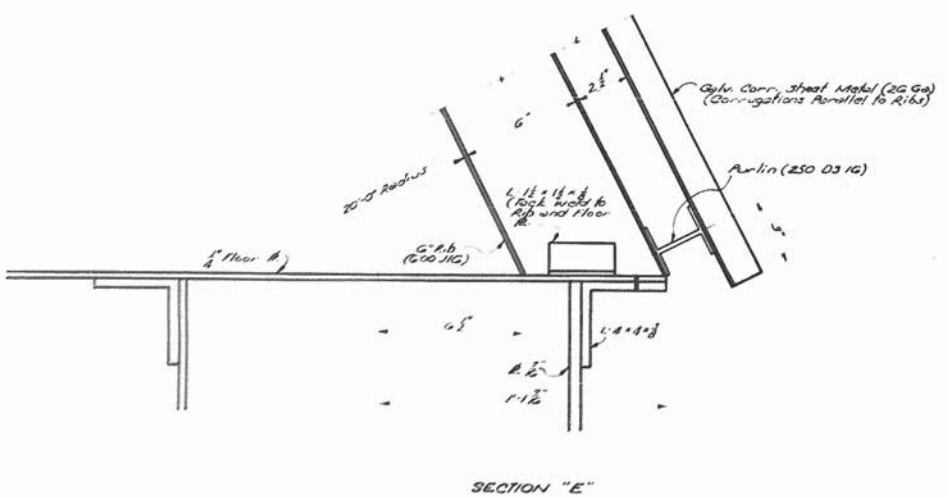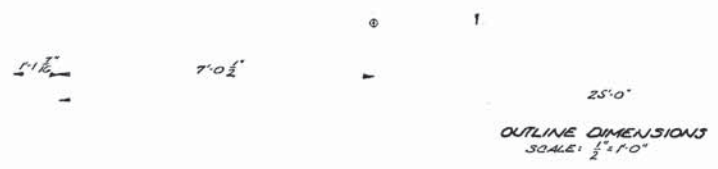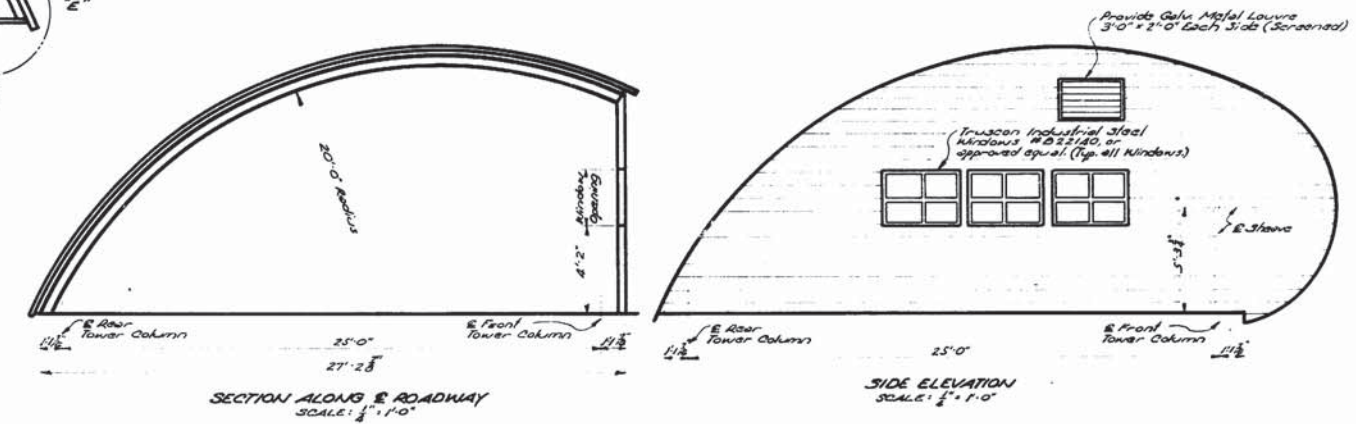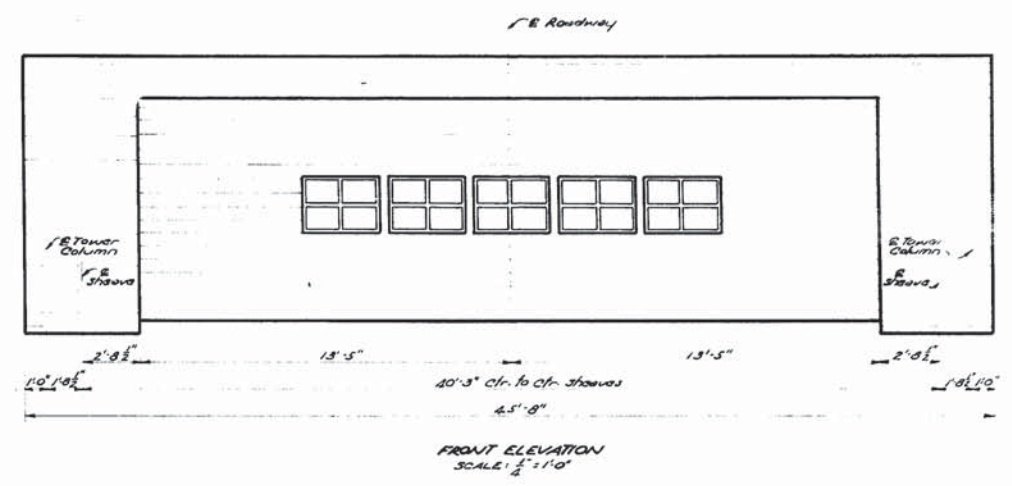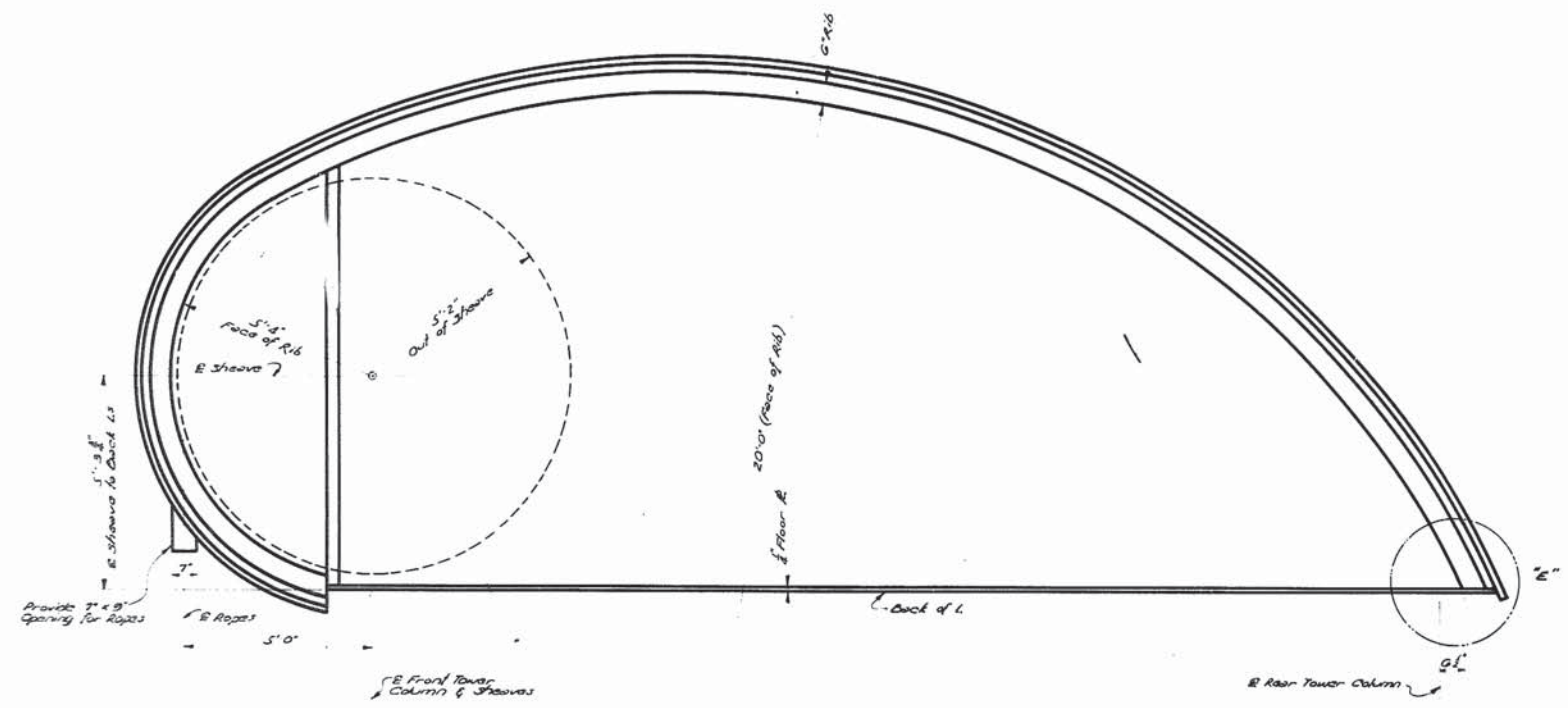

GENERAL NOTES:
 CONSTRUCTION AND DESIGN SPECIFICATIONS: According to the latest design and methods of erection of the "40" STRONG RIB ALUM.", as manufactured by the Gussner Taylor Steel Co. or an approved equal. Materials and Section to be the equivalent, or better, than the 40" Strong Rib Alu. 1/2" Floor B to be paid for as fabricated Carbon Steel. All other materials necessary to complete house are to be paid in Lump Sum Bid for "Machinery House". Door and window to be complete and as specified, or an approved equal. Provide lock for door.
 Flashing to be 26 Ga. Gln. Sheet Metal, and provided where necessary, to make the house substantially water-tight. Doors and windows to be glazed with polished hard glass. Provide necessary bracing in walls and ceiling.
 Gln. surfaces to receive two field coats of aluminum paint. All foreign material shall be removed from surfaces before painting. The contractor will not be required to treat Gln. surfaces with solution stipulated in specifications "Finishing of Metal Surfaces" Art. 4.13, Part 3, Div. II, Std. Specs.

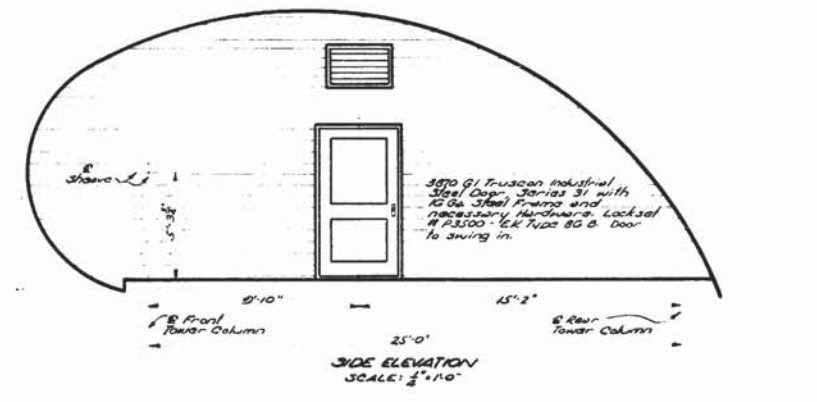


MACHINERY HOUSES		
STANDARD PLAN		
150' VERTICAL LIFT SPAN		
LIVE LOAD H20-S16-44		
28'-0" ROADWAY 5'-0" SIDEWALKS		
45'-0" LIFT OPEN STEEL GRID FLOOR		
DATED May 8 1957		
STATE OF LOUISIANA		
DEPARTMENT OF HIGHWAYS		
DESIGNED	DRAWN	TRACED
CHECKED	CHECKED	CHECKED
BRIDGE DESIGN SECTION		

DATE	DESCRIPTION	BY
	REVISIONS	


SHEET 11 OF 26

SL50-150-28

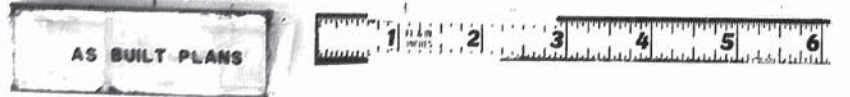


125


STATE PROJECT	PARISH	SHEET
62-051G	Lafayette	35

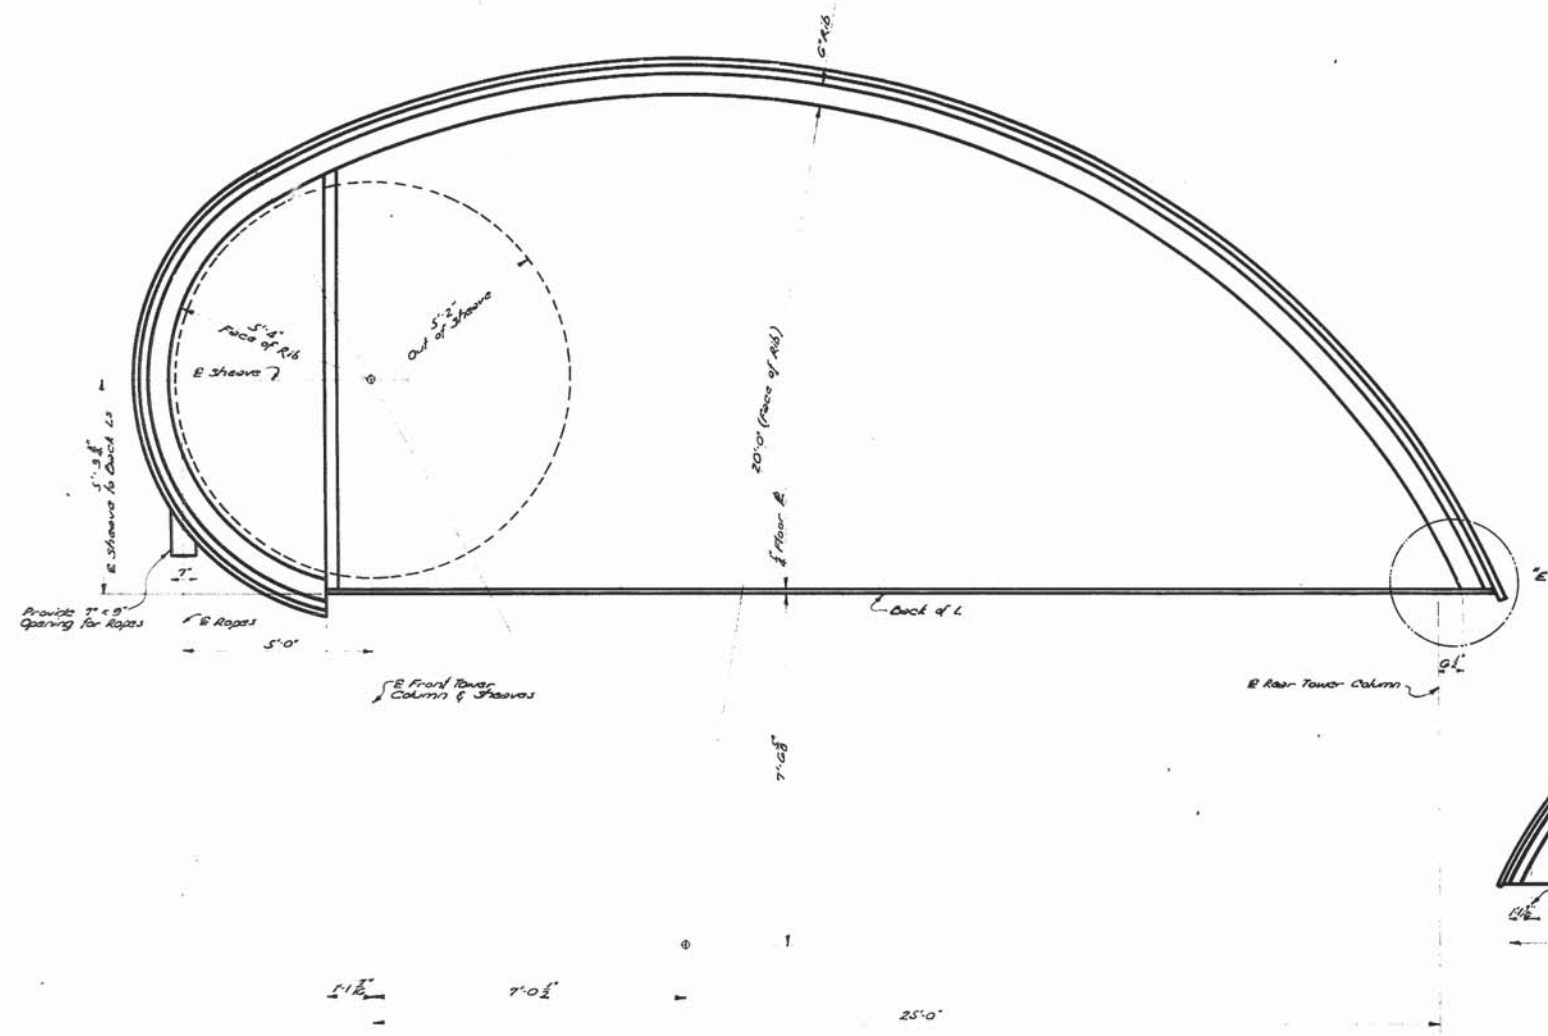


OUTLINE DIMENSIONS
SCALE: 1/2" = 1'-0"

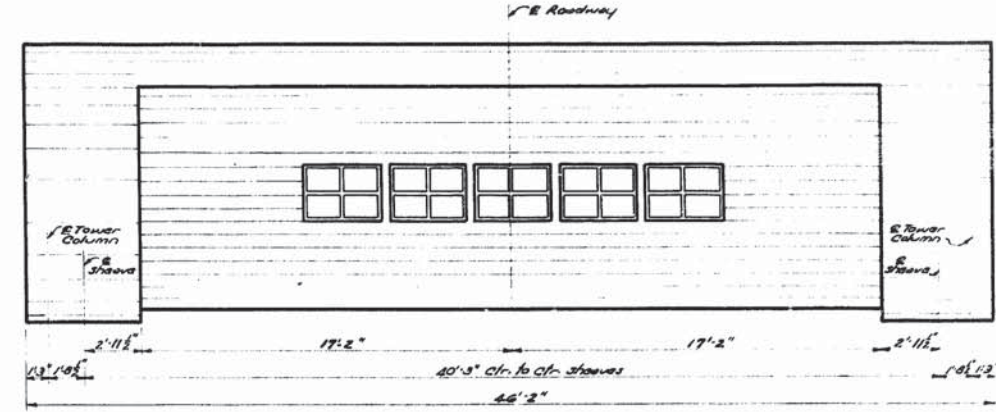


FRONT ELEVATION
SCALE: 1/2" = 1'-0"

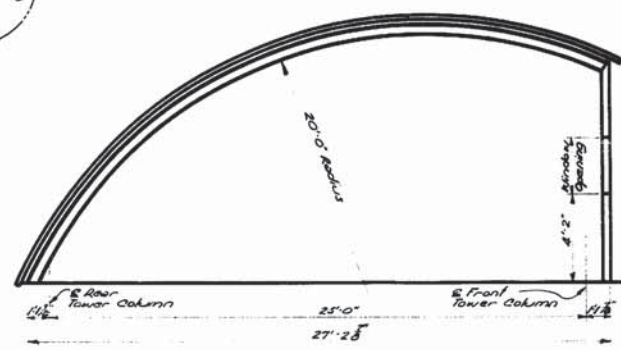


SECTION ALONG E ROADWAY
SCALE: 1/2" = 1'-0"

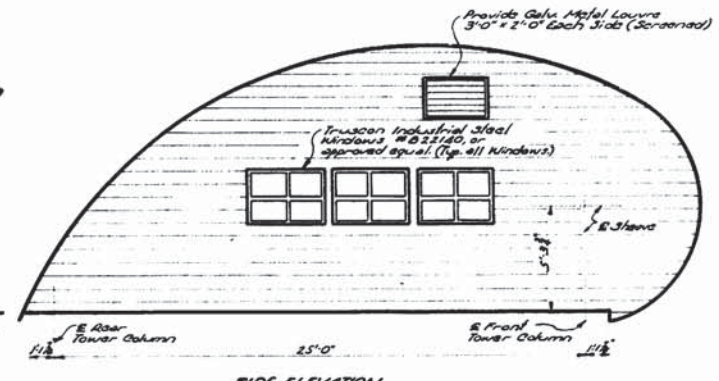


SIDE ELEVATION
SCALE: 1/2" = 1'-0"

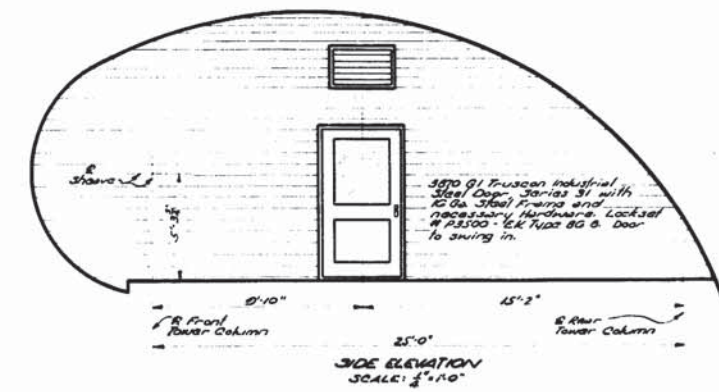

SIDE ELEVATION
SCALE: 1/2" = 1'-0"

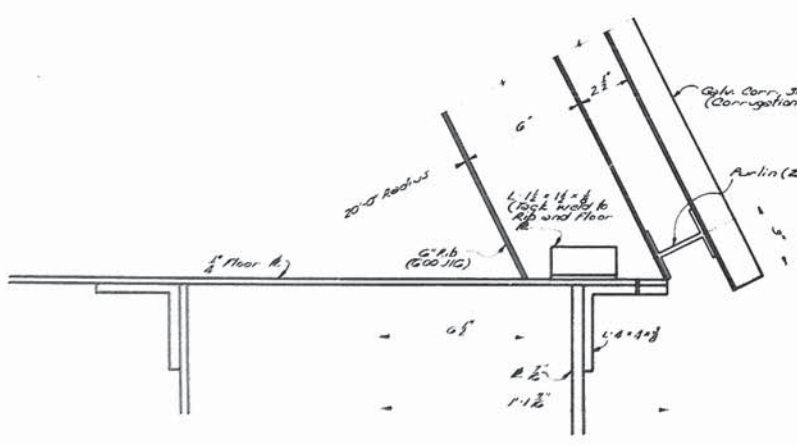

SECTION "E"

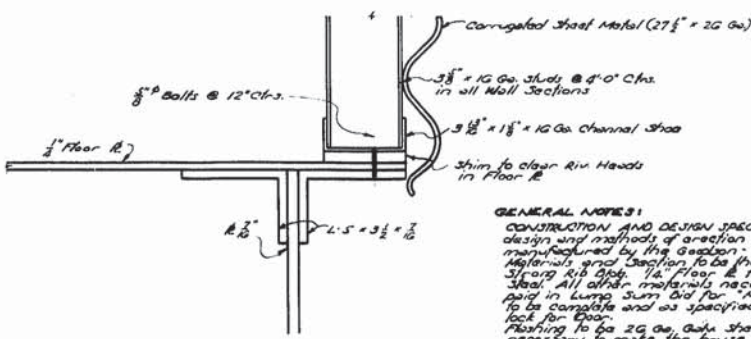

SIDE WALL CONNECTION DETAIL

GENERAL NOTES:
 CONSTRUCTION AND DESIGN SPECIFICATIONS: According to the latest design and methods of erection of the "SP" STRONG RIB BLDG., as manufactured by the Gascon - Taylor Steel Co. or an approved equal materials and design to be the equivalent or better than the 40' Strong Rib Bldg. 1st Floor is to be paid for as fabricated carbon steel. All other materials necessary to complete house are to be paid in lump sum bid for "Machinery House". Door and windows to be complete and as specified, or an approved equal. Provide lock for door.
 Flashing to be 20 Ga. Galva Steel Metal, and provide wherever necessary to make the house substantially watertight. Doors and windows to be glazed with polished wire glass. Provide necessary bracing in walls and ceiling.
 Galva surfaces to receive two field coats of aluminum paint. All foreign material shall be removed from surfaces before painting. The Contractor will not be required to treat Galva surfaces with solution stipulated in specifications "Painting of Metal Surfaces" Art. 4.13, Part 5, Div. 22, Std. Specs.

MACHINERY HOUSES		
STANDARD PLAN		
150' VERTICAL LIFT SPAN		
LIVE LOAD H20-S16-44		
28'-0" ROADWAY	45'-0" LIFT	6'-0" SIDEWALKS
OPEN STEEL GRID FLOOR		
DESIGNED <i>[Signature]</i>		
CHECKED <i>[Signature]</i>		
DATE May 8, 1957		
STATE OF LOUISIANA		
DEPARTMENT OF HIGHWAYS		
DESIGNED	DETAILED	TRACED/AMENDED
CHECKED	CHECKED	CHECKED
BRIDGE DESIGN SECTION		




DATE	DESCRIPTION	BY



AS BUILT PLANS

SHEET 11 OF 24

SI 50-150-28

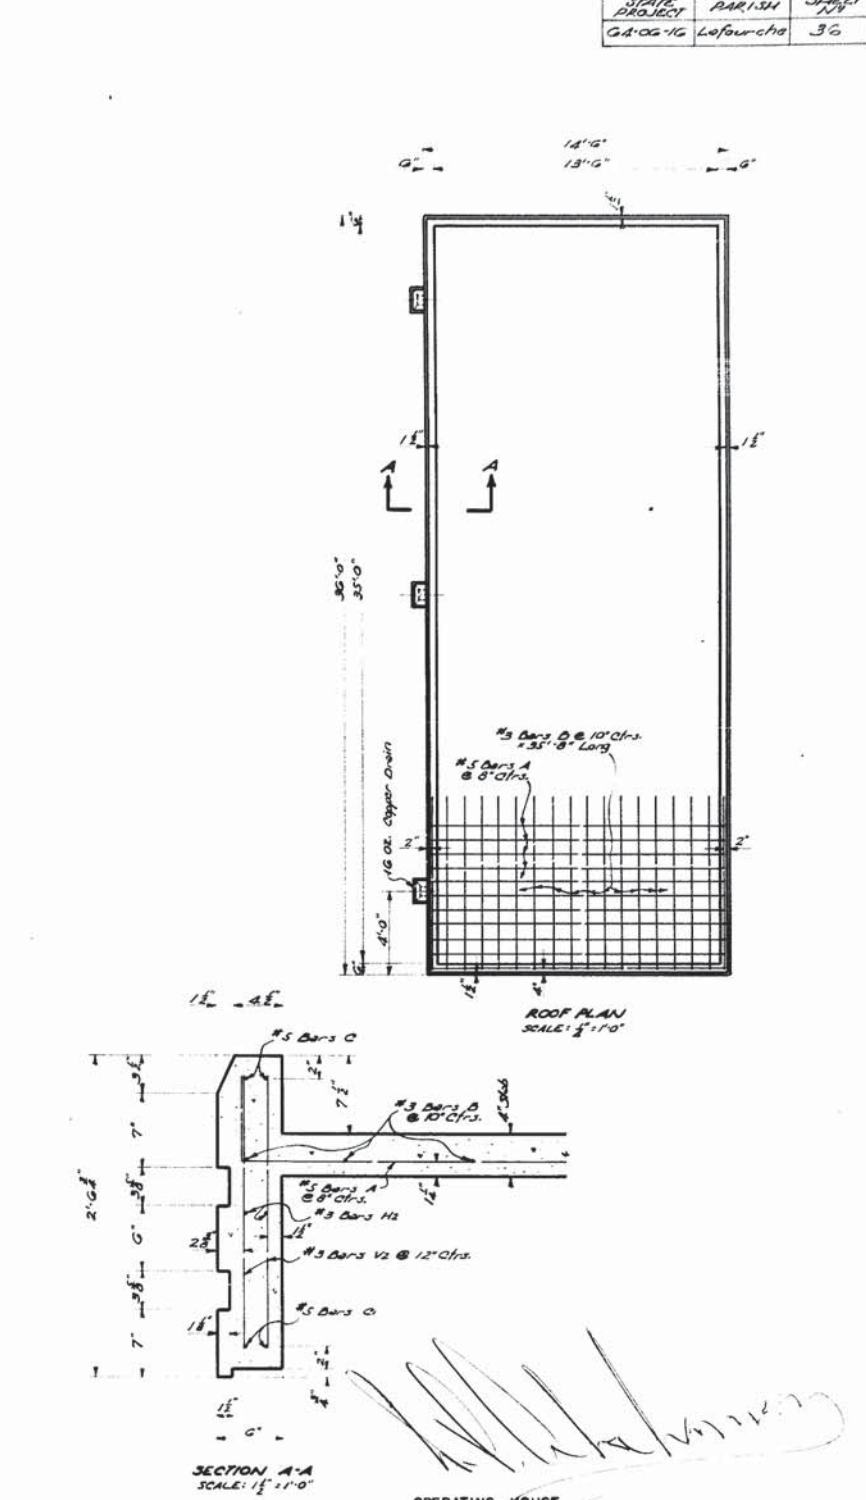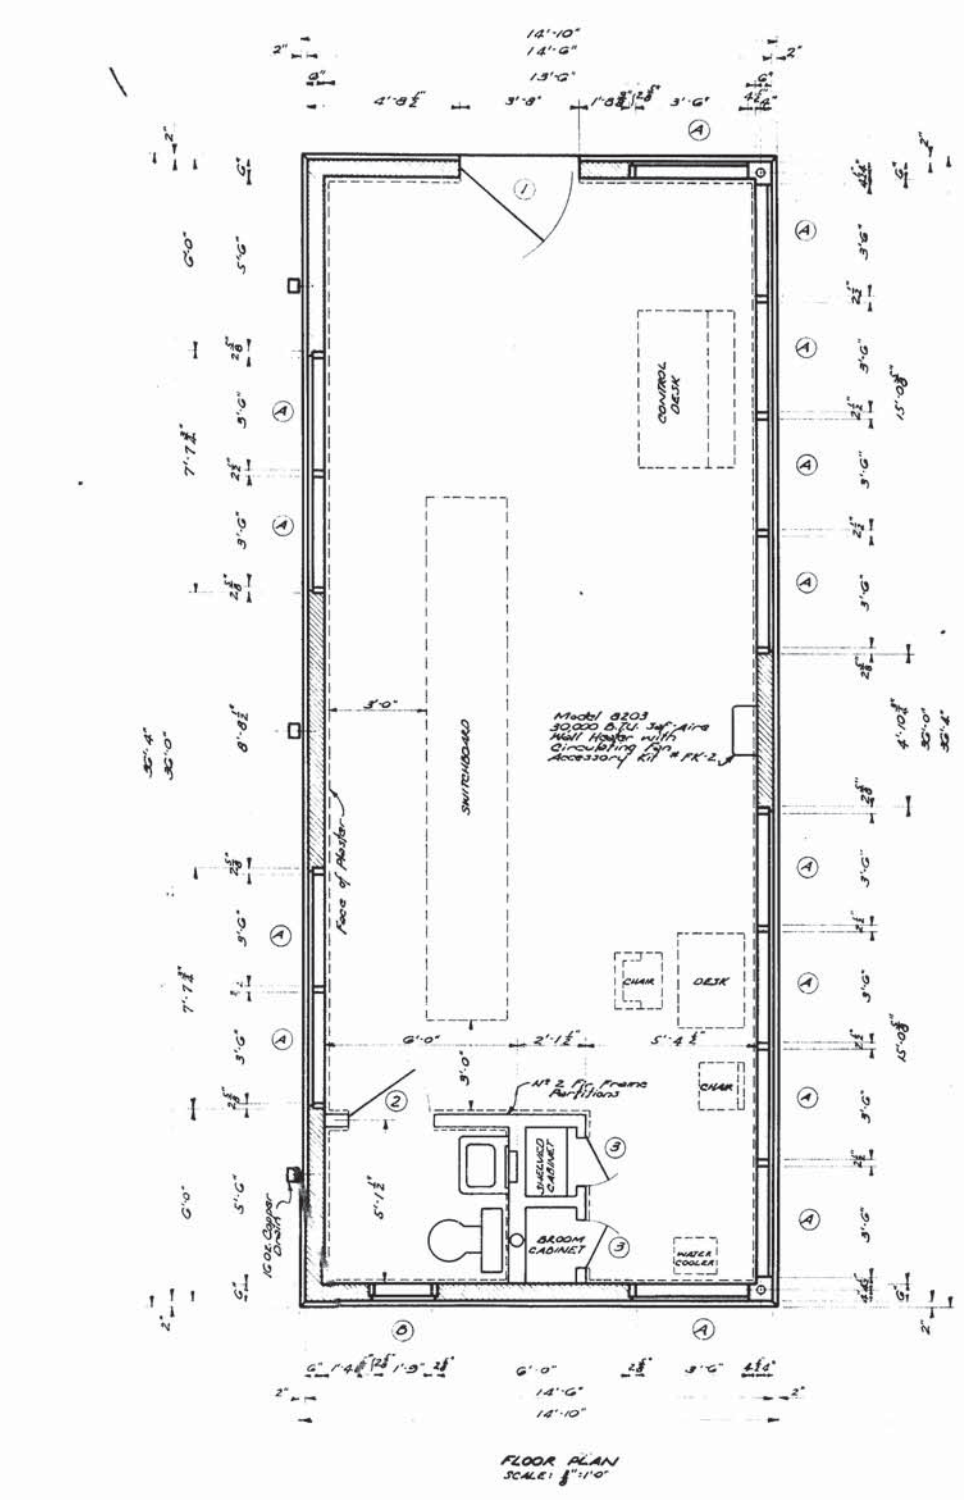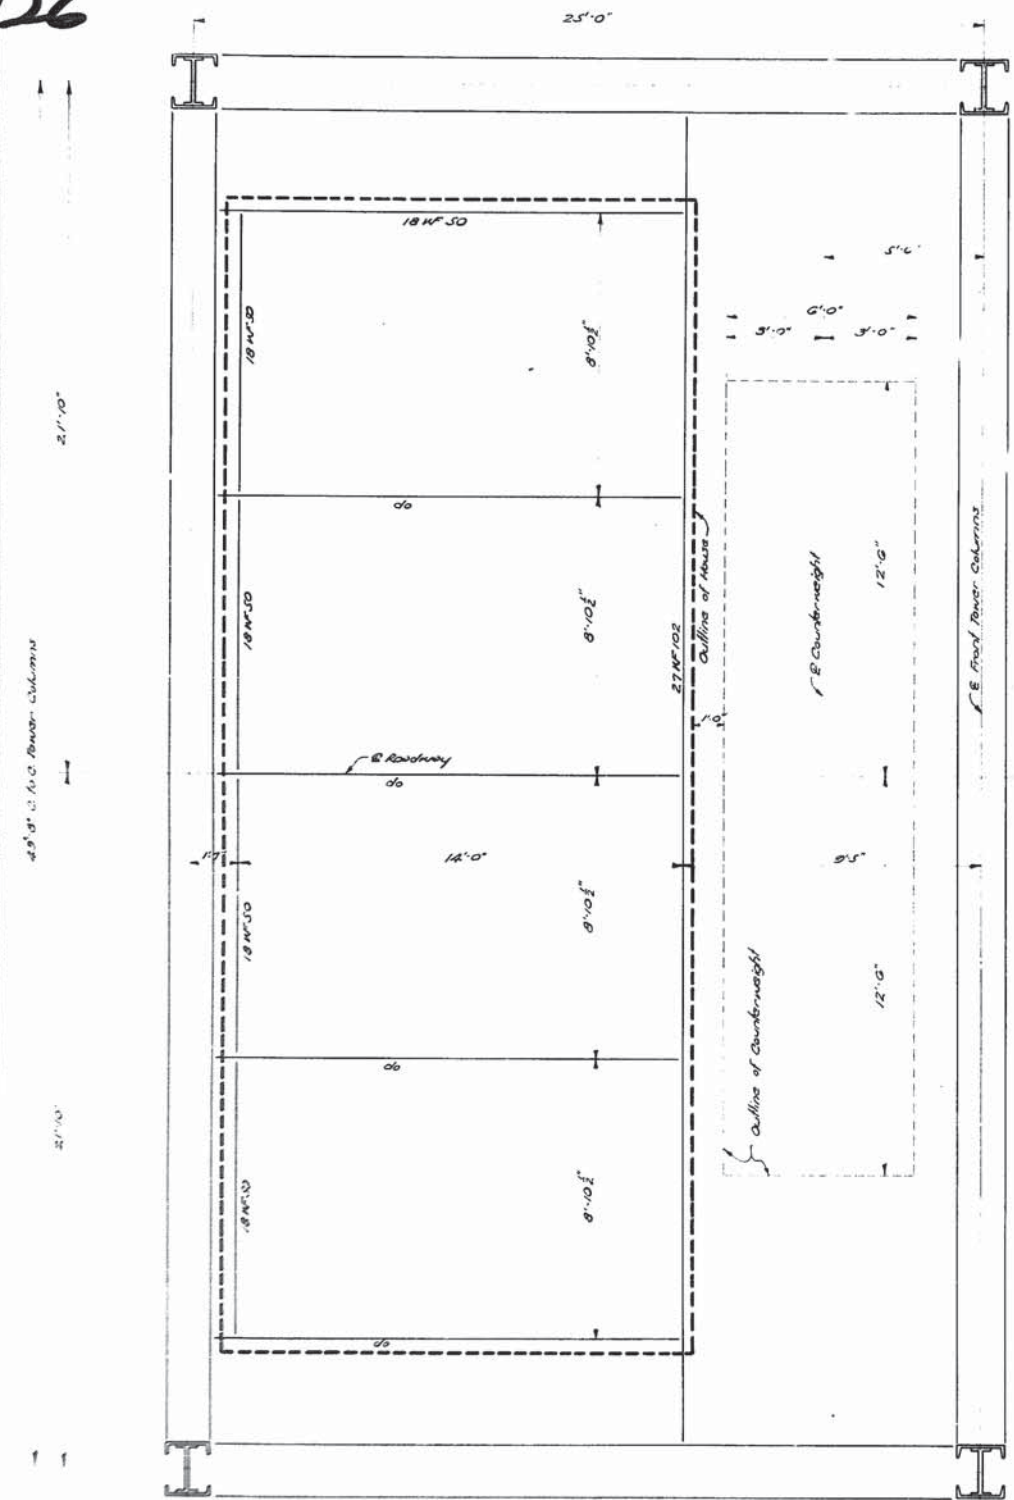

DOOR AND WINDOW SCHEDULE

MARK	SIZE	TYPE	STYLE	REMARKS
1	3'-6" x 7'-0" = 18"	Sliding	1/2" Glass	Aluminum Frame
2	2'-0" x 6'-8" = 18"	Flush	Steel	Steel Metal Frame
3	1'-0" x 6'-8" = 18"	Flush	Steel	Steel Metal Frame
A	3'-0" x 6'-8" = 18"	Sliding	3/8" Glass	Aluminum Frame GS-75
B	1'-0" x 2'-2"	Sliding	3/8" Glass	Aluminum Frame GS-75

FINISH SCHEDULE

ITEM	WALLS		CEILING	FLOOR	BASE	TRIM	ROOF	MAINFLOOT
	OUTSIDE	INSIDE						
House	Rubbed	Tile & Plaster	Plaster	Tile	Tile	Metel	Dr. (Gravel) 8" Bars 18"	
Toilet	-	Tile & Plaster	Plaster	Tile	Tile	Metel	-	As Above Per
Cabinets	Plaster	1/2" Plywood	Plaster	Tile	-	Metel	-	

NOTE:
 All Aluminum Surfaces to be placed in contact with, or fastened to, steel members shall be thoroughly coated with an approved aluminum impregnated caulking compound. All aluminum Surfaces to be placed in contact with concrete shall be given a heavy coat of an approved alkali-resistant bituminous paint, or a coat of zinc chromate paint, and allowed to dry before placing on the concrete.

OPERATING HOUSE


STANDARD PLAN
150' VERTICAL LIFT SPAN
 LIVE LOAD H20-S16-44
 2'-0" ROADWAY 5'-0" SIDEWALKS
 45'-0" LIFT OPEN STEEL GRID FLOOR

DATE: May 13 1957


STATE OF LOUISIANA
 DEPARTMENT OF HIGHWAYS

BRIDGE DESIGN SECTION




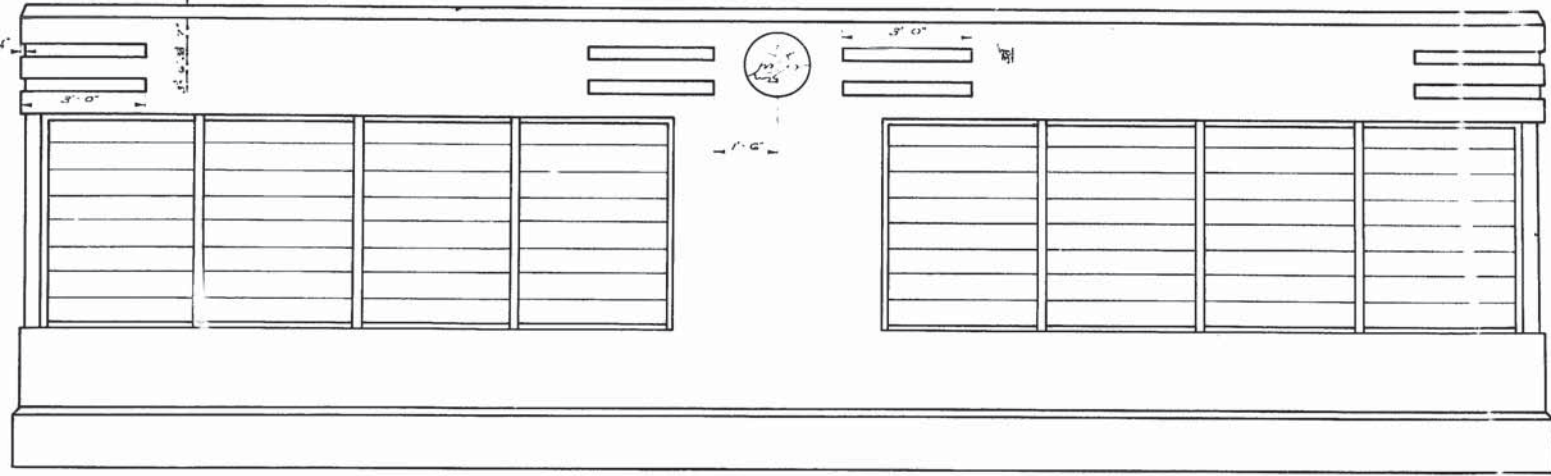


FRONT ELEVATION
SCALE: 1/8" = 1'-0"

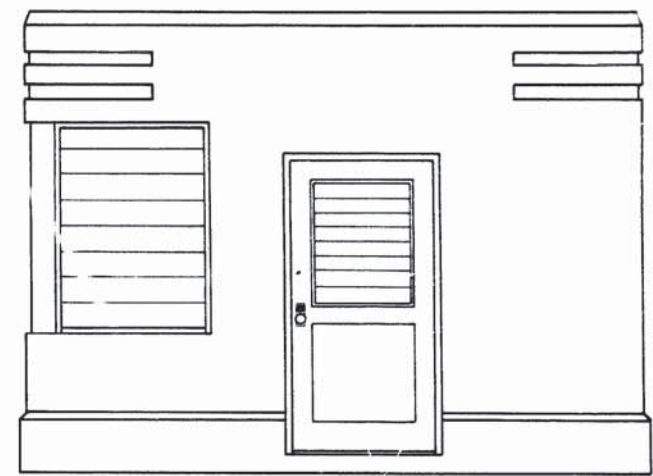


SIDE ELEVATION
SCALE: 1/8" = 1'-0"

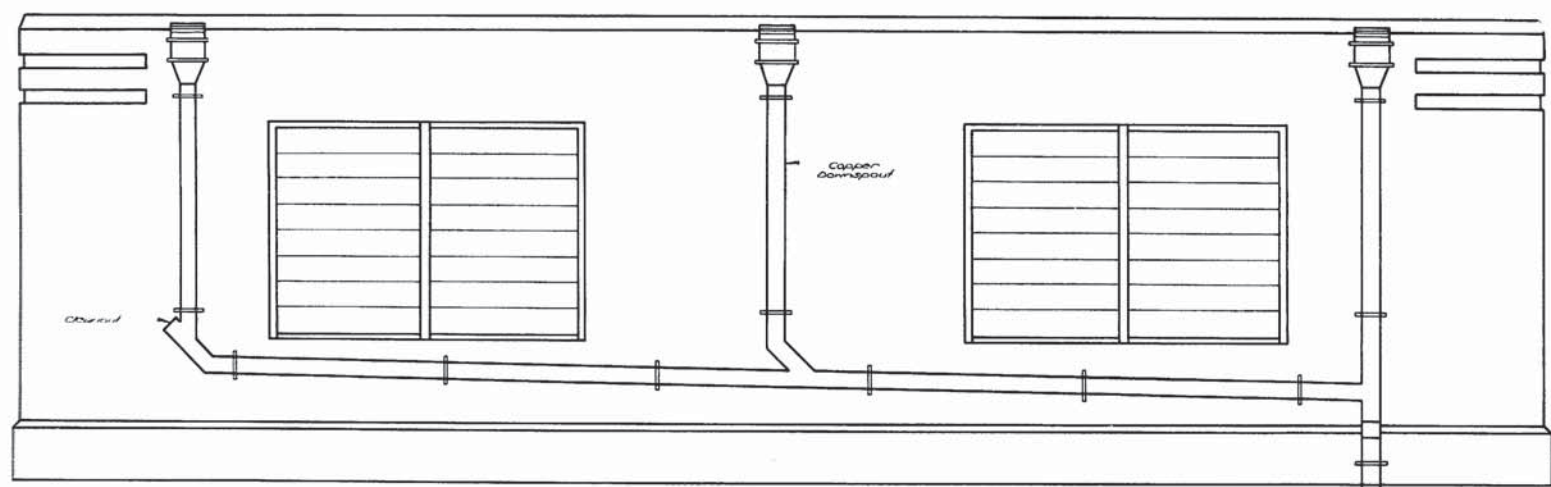

REAR ELEVATION
SCALE: 1/8" = 1'-0"

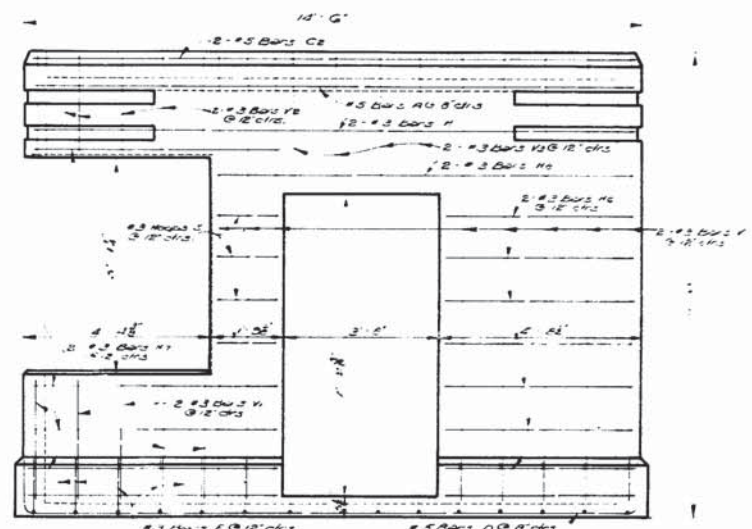


SIDE ELEVATION
SCALE: 1/8" = 1'-0"

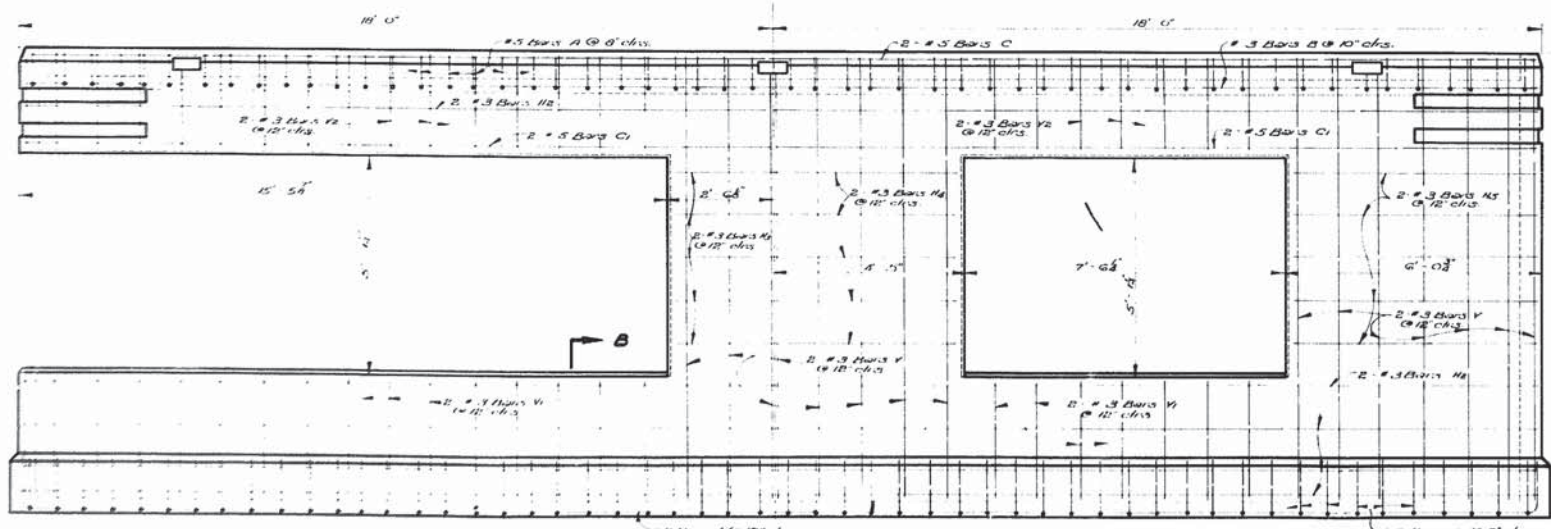


HALF FRONT ELEVATION
SCALE: 1/8" = 1'-0"

HALF REAR ELEVATION
SCALE: 1/8" = 1'-0"

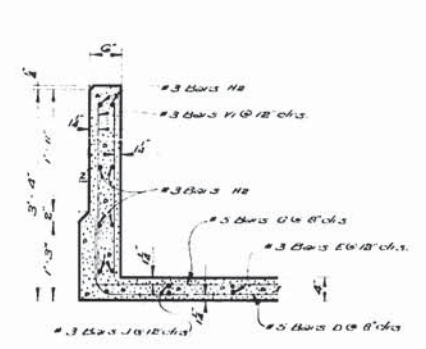

SECTION B-B
SCALE: 1/8" = 1'-0"

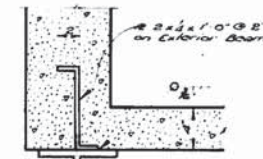

ANCHOR DETAILS FOR EXTERIOR BEAMS








OPERATING HOUSE

STANDARD PLAN 150' VERTICAL LIFT SPAN LIVE LOAD H20-S16-44		
28'-0" ROADWAY	45'-0" LIFT	5'-0" SIDEWALKS OPEN STEEL GRID FLOOR
DATED May 13, 1957		
STATE OF LOUISIANA DEPARTMENT OF HIGHWAYS		
DESIGNED <i>Neen</i>	DETAILED <i>Neen</i>	TRACED <i>S. Davis</i>
CHECKED <i>Neen</i>	CHECKED <i>R. Law</i>	CHECKED <i>R. Law</i>
BRIDGE DESIGN SECTION		


DATE	DESCRIPTION	BY



128

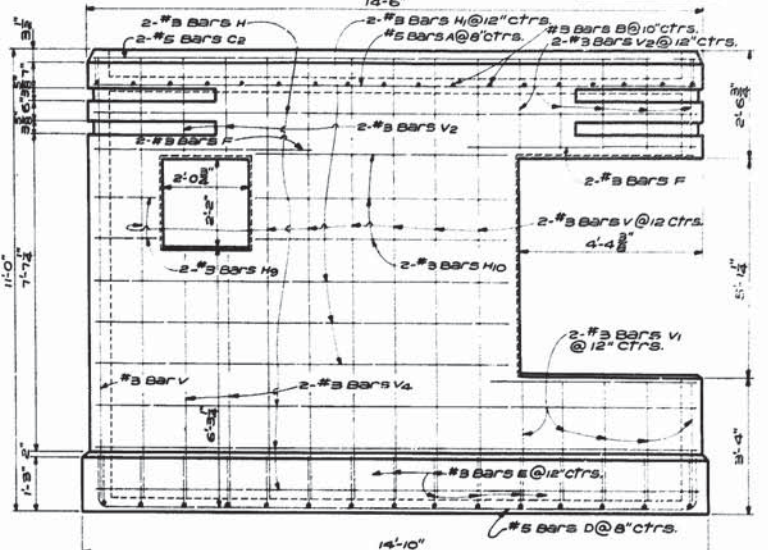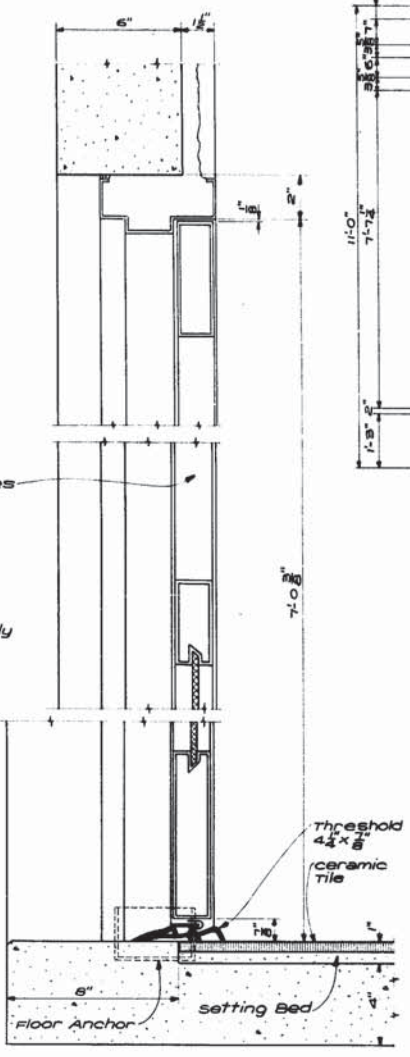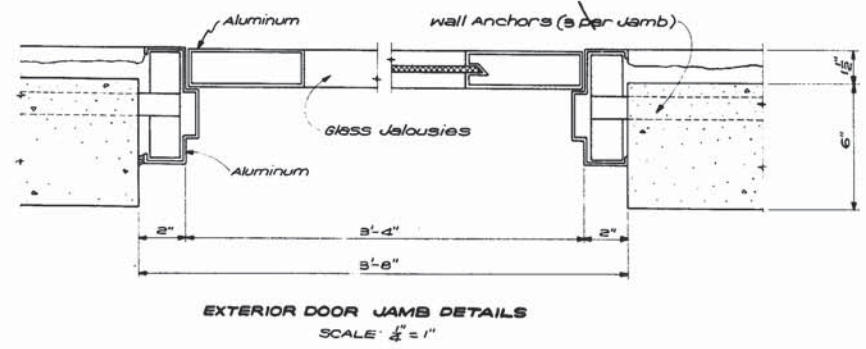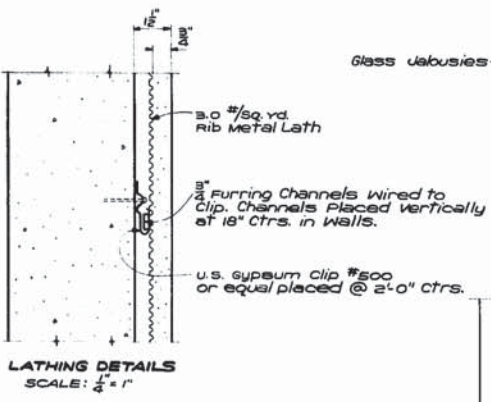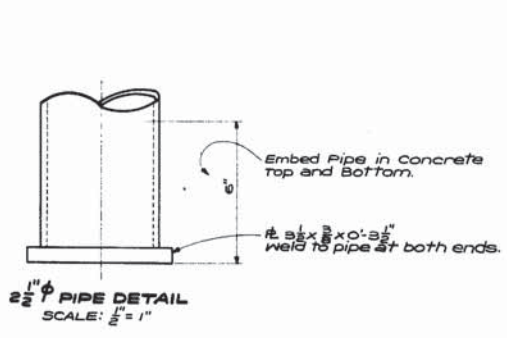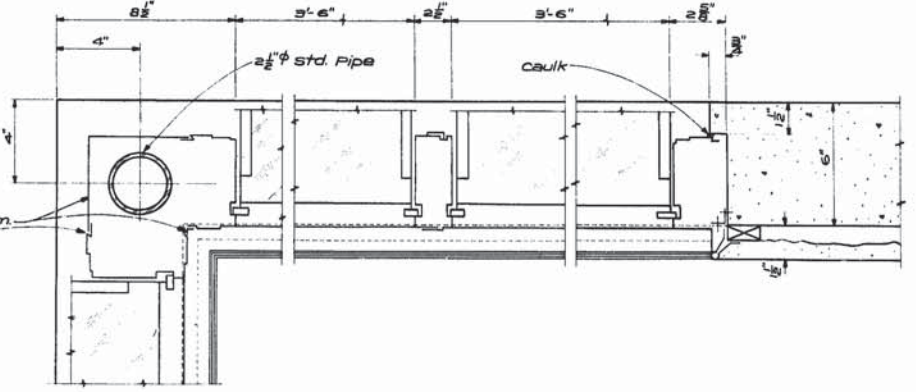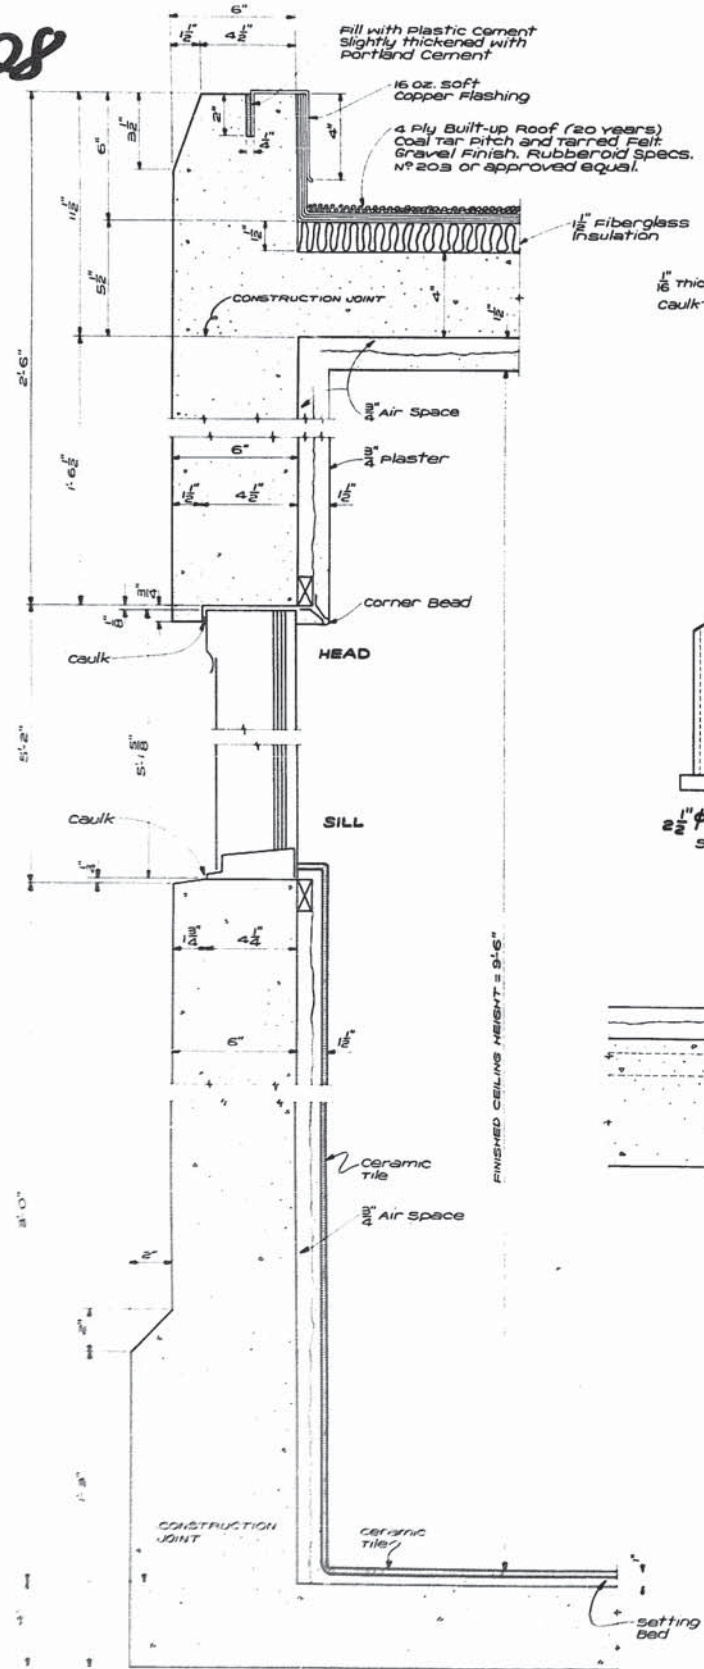

BILL OF REINFORCING STEEL					
BAR	SIZE	N°	UNIT LENGTH	TOTAL LENGTH	LOCATION
A	5	54	15'-5"	822'-5"	short span in Roof Slab
C	5	4	35'-8"	142'-8"	Horiz. in Front and Rear walls (top)
C1	5	4	35'-8"	142'-8"	Horiz. in Front & Rear walls over windows
C2	5	4	14'-2"	56'-8"	Horiz. in Side walls (top)
D	5	54	16'-9"	904'-6"	short span in Floor Slab (bottom)
E	5	54	14'-6"	783'-0"	short span in Floor Slab (top)
Total #5 Bars = 2862'-0" = 2985 Lbs.					
B	3	18	35'-8"	642'-0"	Long Span in Roof Slab
E	3	15	35'-4"	515'-0"	Long Span in Floor Slab (bottom)
F	3	2	5'-3"	10'-6"	Horiz. in Side wall over toilet window
H	3	10	14'-2"	141'-8"	Horiz. in Side walls
H1	3	6	9'-10"	59'-0"	Horiz. in Side wall below toilet window
H2	3	20	35'-8"	713'-4"	Horiz. in Front and Rear walls
H3	3	10	4'-8"	48'-8"	Horiz. in Front wall between windows
H4	3	10	5'-8"	58'-0"	Horiz. in Rear wall between windows
H5	3	20	5'-8"	113'-4"	Horiz. in Rear wall at ends
H6	3	14	4'-4"	60'-8"	Horiz. in wall near door
H7	3	3	5'-9"	17'-0"	Horiz. in wall near door
H8	3	2	9'-9"	19'-6"	Horiz. in wall over door
H9	3	4	1'-6"	6'-0"	Horiz. in side wall near toilet window
H10	3	6	5'-9"	34'-6"	Horiz. in side wall near toilet window
J	3	18	26'-0"	468'-0"	Long Span in Floor Slab (top)
S	3	4	3'-8"	14'-8"	Hoops in wall near door
V	3	84	10'-6"	882'-0"	vertical in walls
V1	3	108	2'-10"	306'-0"	vertical in walls below windows
V2	3	112	2'-2"	228'-8"	vertical in walls above windows
V3	3	8	3'-0"	24'-0"	vertical in walls above door
V4	3	4	5'-9"	23'-0"	vert. in side wall below toilet window
Total #3 Bars = 4513'-6" = 1697 Lbs.					

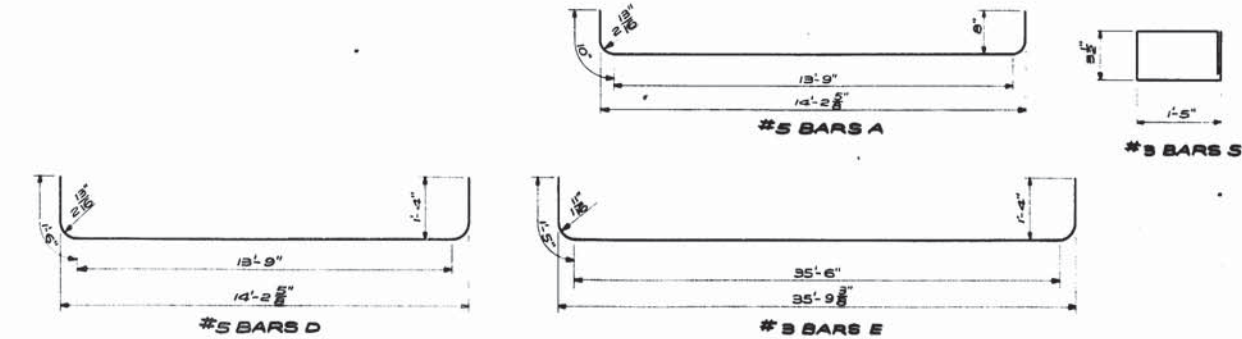

[Handwritten signature]


OPERATING HOUSE

STANDARD PLAN
 150' VERTICAL LIFT SPAN
 LIVE LOAD H20-S16-44
 28'-0" ROADWAY 5'-0" SIDEWALKS
 45'-0" LIFT OPEN STEEL GRID FLOOR
 DATED MAY 14 '57



STATE OF LOUISIANA
 DEPARTMENT OF HIGHWAYS

DESIGNED: [Signature] CHECKED: [Signature] DRAWN: [Signature]
 CHECKED: [Signature] REVISIONS:

BRIDGE DESIGN SECTION

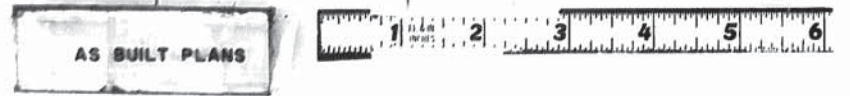

129

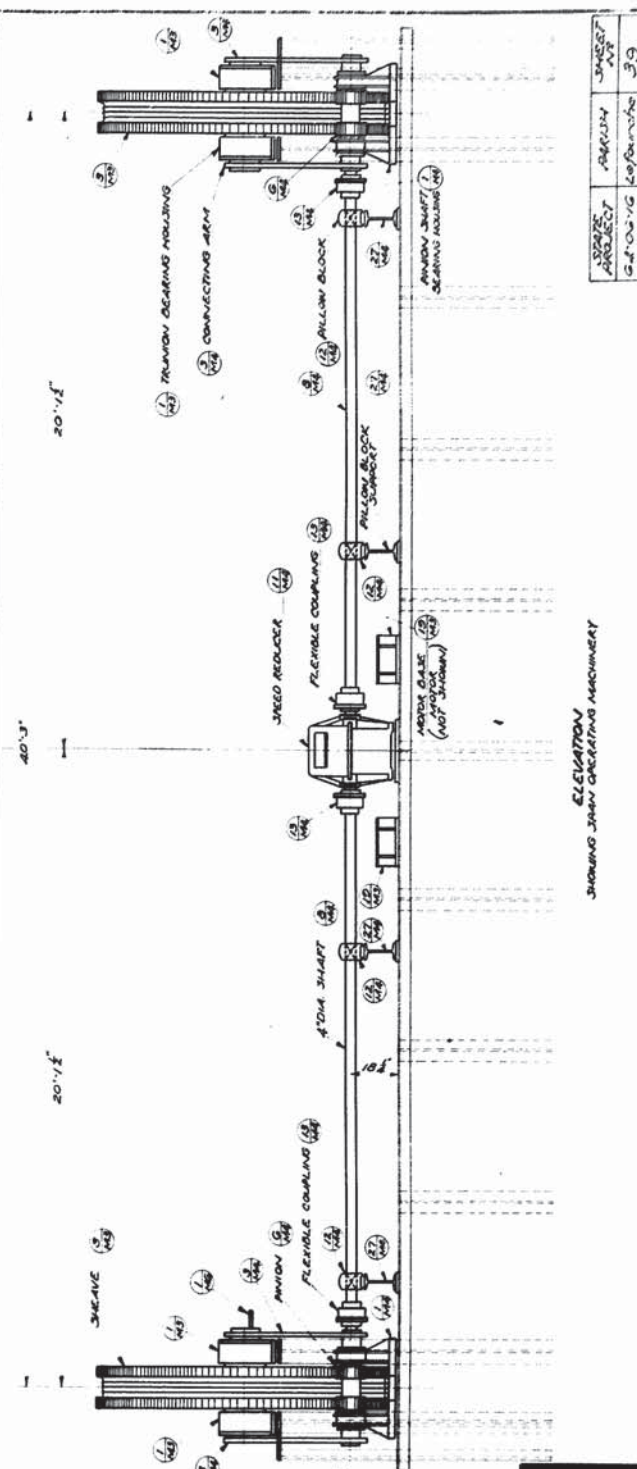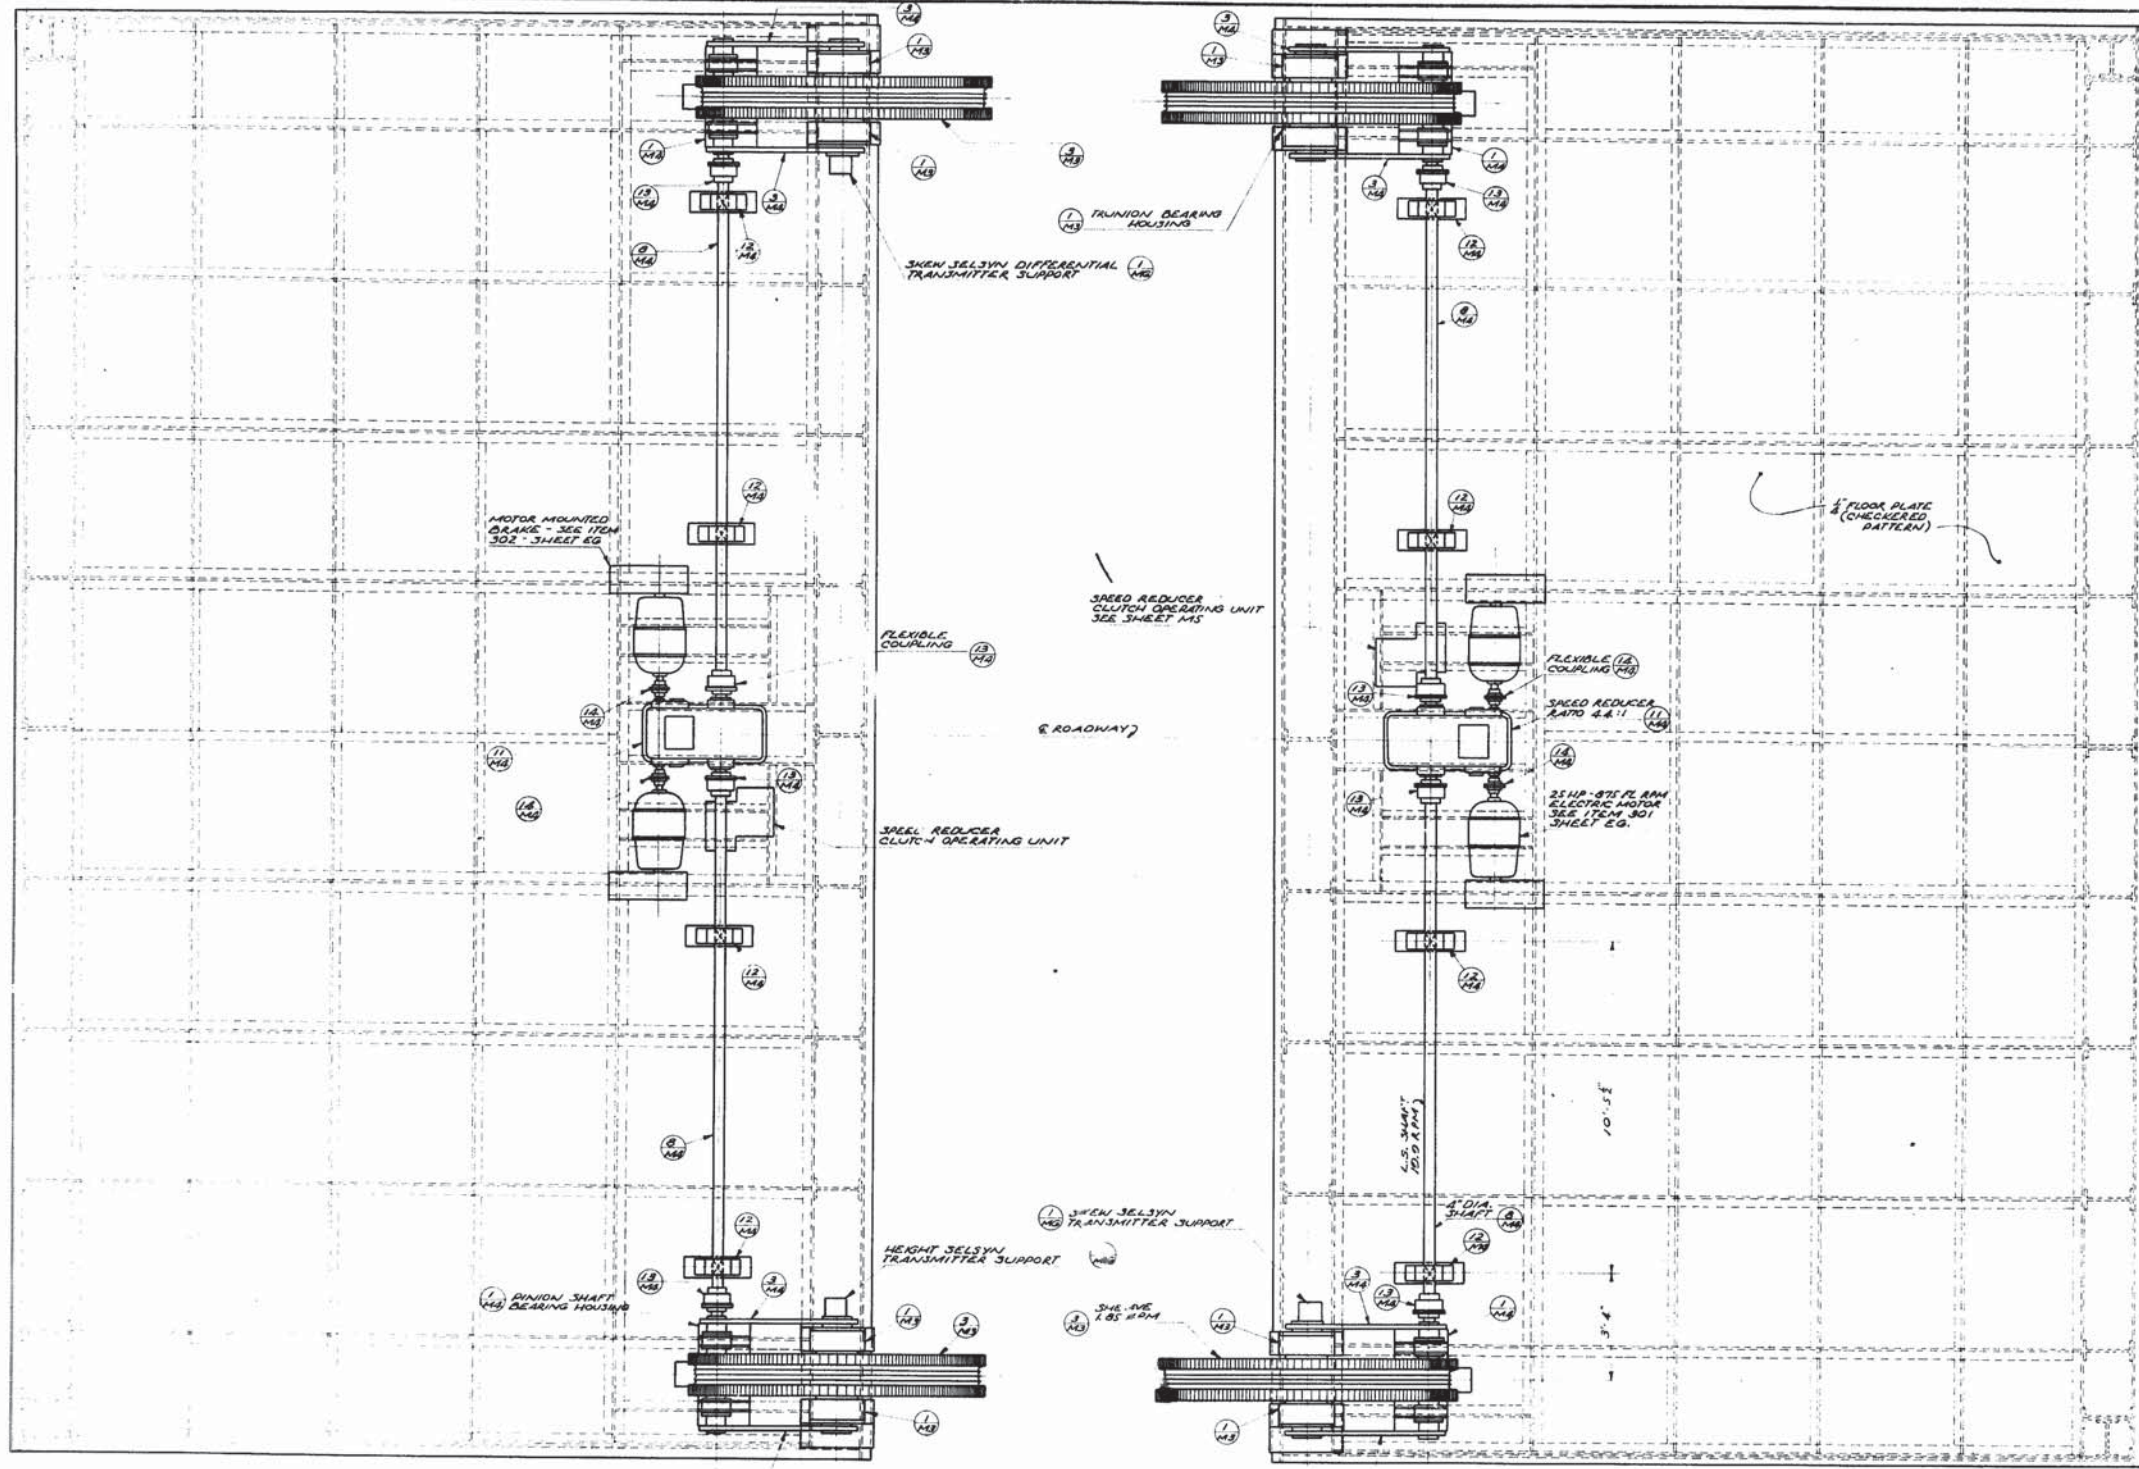

SHEET NO. 39
PROJECT AREA
DATE 12/15/57

ELEVATION
SPAN OPERATING MACHINERY

THICKNESS AND NO. OF SHIMS TO BE FURNISHED

THICKNESS SHAFT SHIM	3/8"	1/2"	5/8"
3/8"	2	2	3
1/2"	4	2	4
5/8"	6	5	5

NOTE:
THE CONTRACTOR SHALL DETERMINE THE FINAL DIMENSIONS OF PARTS INVOLVING COMMERCIAL PRODUCTS SUCH AS MOTORS, SPEED REDUCERS, BEARINGS, ELECTRICAL EQUIPMENT AND THE LIKE, FROM CERTIFIED DIMENSIONS OUTLINES OF THE COMMERCIAL PRODUCTS BEFORE MAKING SHOP DRAWINGS OF THE PARTS INVOLVED.

PAINTING NOTE:
ALL UNFINISHED SURFACES OF MACHINERY SHALL BE PAINTED ONE SHOP COAT OF RED LEAD AND OIL. ALL FINISHED SURFACES SHALL BE COATED WITH WHITE LEAD AND PALLON BEFORE SHIPMENT AND SHALL BE PROTECTED BY WOODEN LAGGING.

LUBRICATION NOTE:
LUBRICANTS SPECIFIED ON DETAIL DRAWING
LUBRICANT SHALL BE AS FOLLOWS OR APPROVED EQUAL:
PILLOW BLOCKS, COUPLINGS & TRUNION BEARINGS - ESSO FORD GREASE "O"
ENCLOSED SPEED REDUCER - STD. OIL TERES30 95" VISO 3AE 30.
WIRE ROPE - STD. OIL CO. SURETTE COMPOUND NY 1500.

MI

GENERAL ARRANGEMENT OF SPAN OPERATING MACHINERY

**STANDARD PLAN
150' VERTICAL LIFT SPAN
LIVE LOAD H20-S16-44
28'-0" ROADWAY 45'-0" LIFT 5'-0" SIDEWALKS
OPEN STEEL GRID FLOOR**

STATE OF LOUISIANA
DEPARTMENT OF HIGHWAYS


DATE: APRIL 25, 1957

DESIGNED BY: KUREL
CHECKED BY: KUREL
DRAWN BY: BREWSTER
DATE: APRIL 25, 1957


BRIDGE DESIGN SECTION

SHEET 15 OF 26


SL50-150-28

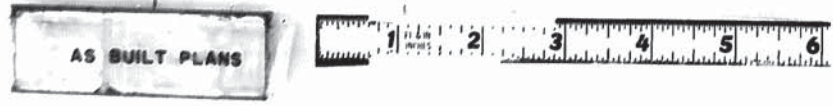



130

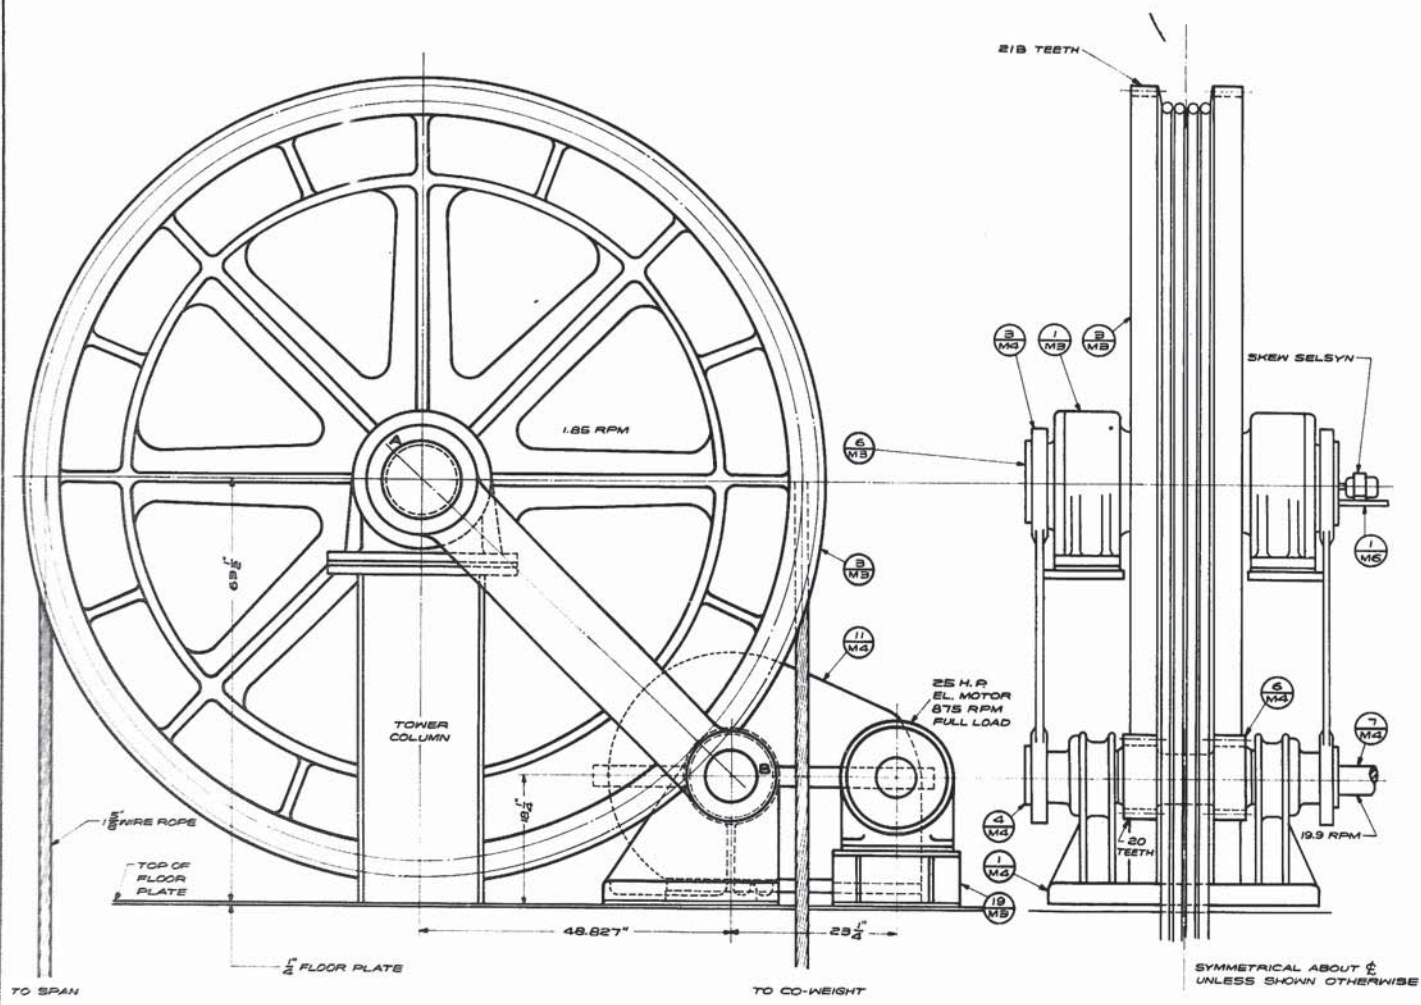

GENERAL ARRANGEMENT OF BRIDGE MACHINERY ON DWG. # M1

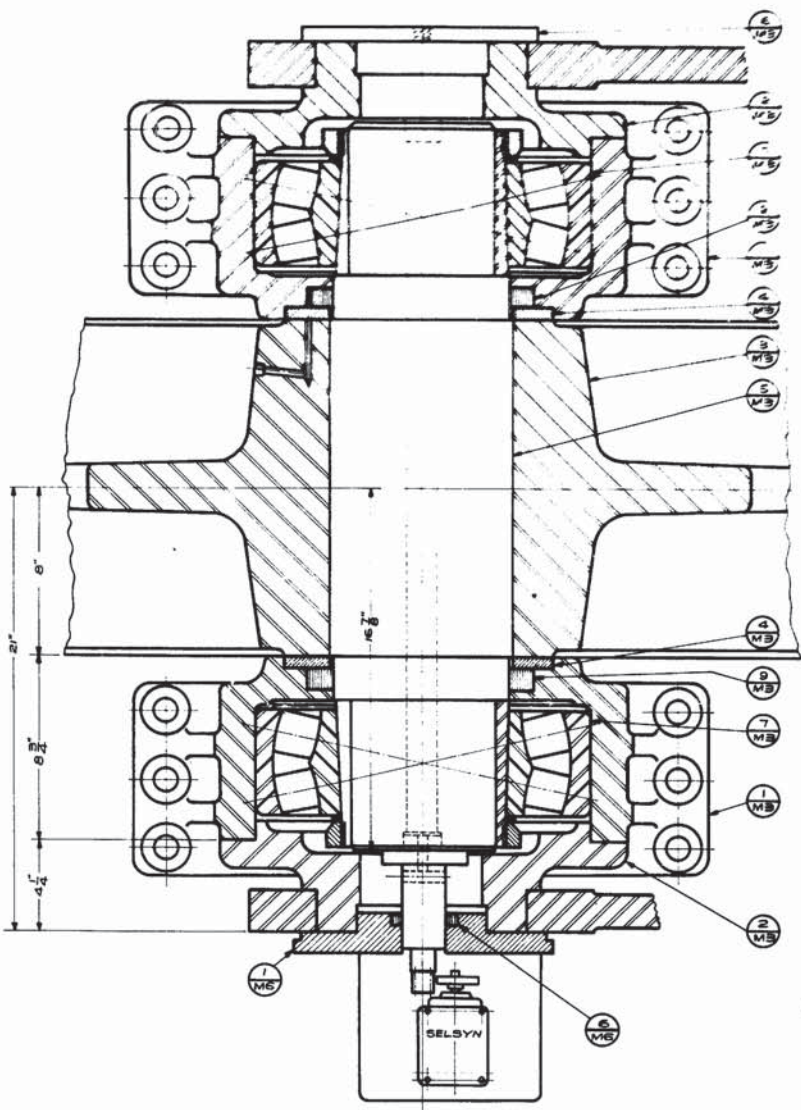

SECTION "A"- "B"

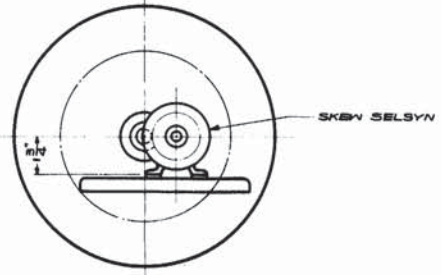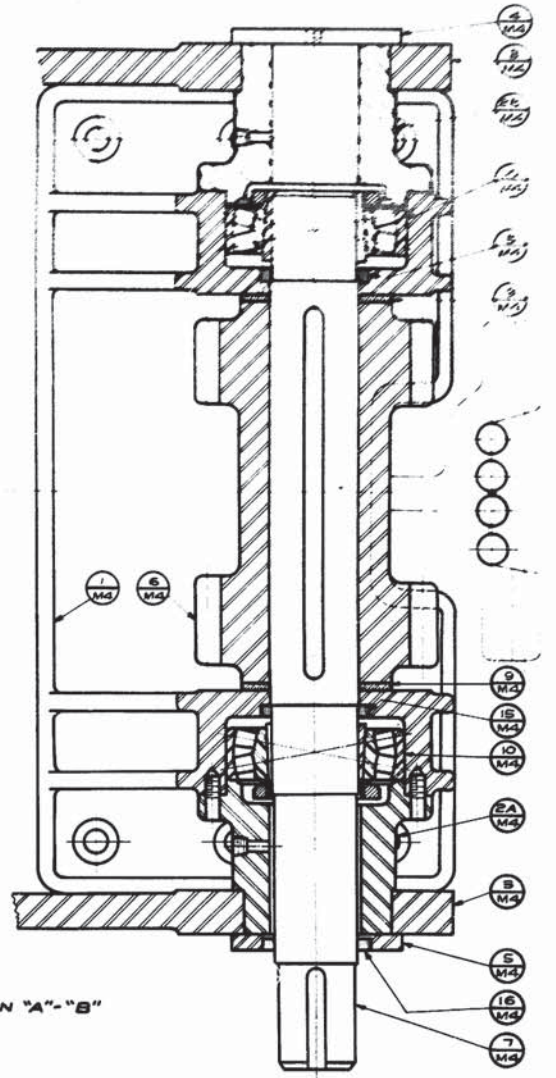

SELSYN MOUNTING AND GEARS ON DWG. M6

NOTE:
 FOR REMOVING PINION SHAFT REMOVE CAPS, BEARINGS AND GREASE SEALS FROM BOTH ENDS OF THE ASSEMBLY. ROTATE THE PINION SPACER NEAREST THE COUPLING END OF THE SHAFT UNTIL ITS KEY SLOT IS IN LINE WITH THE KEY SLOT IN THE BORE OF THE HOUSING. ROTATE THE SHAFT UNTIL THE KEYS ARE STRAIGHT DOWN. LIFT IT UPWARD AGAINST THE TOP OF THE BORE AND PRESS IT OUT IN THE DIRECTION OF THE COUPLING END.

NOTE:
 THE CONTRACTOR SHALL DETERMINE THE FINAL DIMENSIONS OF PARTS INVOLVING COMMERCIAL PRODUCTS SUCH AS MOTORS, SPEED REDUCERS, BEARINGS, ELECTRICAL EQUIPMENT AND THE LIKE, FROM CERTIFIED DIMENSIONS OUTLINES OF THE COMMERCIAL PRODUCTS BEFORE MAKING SHOP DRAWINGS OF THE PARTS INVOLVED.
 UNLESS OTHERWISE SHOWN ON DETAIL DRAWING LUBRICANT SHALL BE AS FOLLOWS OR APPROVED EQUAL:
 PILLOW BLOCKS, COUPLINGS & TRUNION BEARINGS - ESSO FIBRE GREASE "C"
 EXPOSED TEETH - MEDIUM HARD GREASE.
 ENCLOSED SPEED REDUCERS - STD. OIL "TERESSO 65" VISC SAE 30.
 WIRE ROPE - STD. OIL CO. SURRETTE COMPOUND N° 1500.
 ALL UNFINISHED SURFACES OF MACHINERY SHALL BE PAINTED ONE SHOP COAT OF RED LEAD AND OIL.
 ALL FINISHED SURFACES SHALL BE COATED WITH WHITE LEAD AND TALLOW BEFORE SHIPMENT AND SHALL BE PROTECTED BY WOODEN LAGGERS.

Handwritten signature

M2


ASSEMBLY OF GEAR TRAIN FOR SHEAVE DRIVE

STANDARD PLAN
150' VERTICAL LIFT SPAN
 LIVE LOAD H20-S16-44
 28'-0" ROADWAY 5'-0" SIDEWALKS
 45'-0" LIFT OPEN STEEL GRID FLOOR
 DATED FEB. 22 1957



4-9-58 REV. PART NO.	DESIGNER <i>Ruzel</i>	DETAILED <i>Ruzel</i>	TRACED <i>Q. Chappin</i>
DATE	CHECKED <i>Brewer</i>	CHECKED <i>Brewer</i>	CHECKED <i>Brewer</i>
DESCRIPTION	BRIDGE DESIGN SECTION		



131

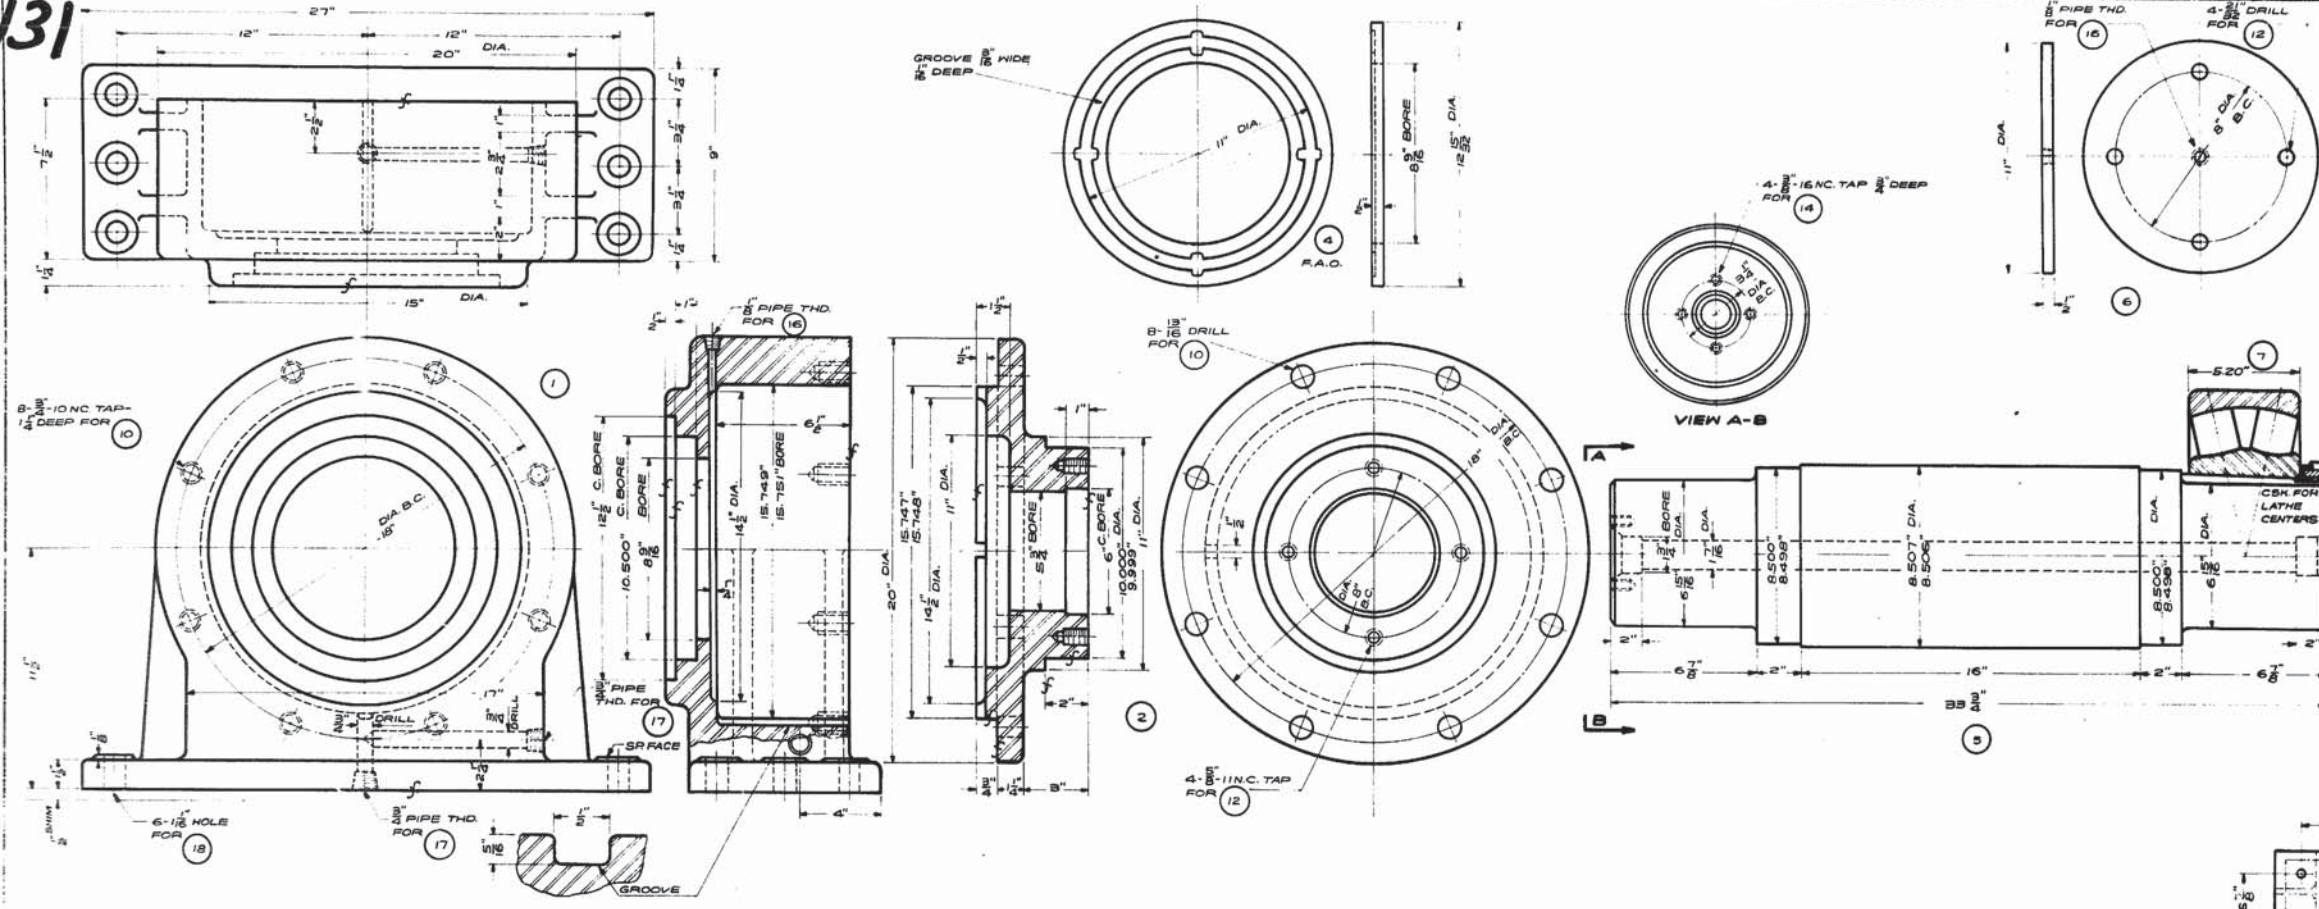

BILL OF MATERIAL FOR ONE SPAN			
PART #	QTY	DESCRIPTION	MATERIAL
1	8	TRUNION BEARING HOUSING	ST. CAST. ASTM-A27-GR 65-35
2	8	HOUSING COVER	ST. CAST. ASTM-A27-GR 65-35
3	4	SHEAVE	ST. CAST. ASTM-A27-GR 65-35
4	8	SHEAVE THRUSTWASHER	BRONZE
5	4	TRUNION	ST. FORG. ASTM-A285-CL. G
6	5	CONN. ARM RETAINER	STEEL
7	8	TRUNION BEARING SKF 22209 CK-2NN1 OR TORR 1905023A	COMM.
8	16	1" DIA. PIN - 4" LONG	STEEL
9	8	GARLOCK SEAL #S1-3510	COMM.
10	64	1/16" DIA. CAPSCREW - 2 1/2" LG.	STEEL
11	64	SHAKEPROOF LOCKWASHER	COMM.
12	32	1/16" DIA. CAPSCREW - 1 1/2" LG.	STEEL
13	32	SHAKEPROOF LOCKWASHER	COMM.
14	12	1/16" DIA. CAPSCREW - 1" LONG	STEEL
15	12	SHAKEPROOF LOCKWASHER	COMM.
16	21	ALEMITE HYDRAULIC FITTING	COMM.
17	16	COUNTERSUNK PLUG	BRASS
18	48	TURNED BOLT COMPL.	STEEL
19	4	MOTOR BASE	STEEL WELDM.
20	16	MOTOR BOLT COMPL.	STEEL
21	6	BASE FOR REDUCER	STEEL C.F. 1/2" X 3"
22	12	BOLT FOR REDUCER - COMPL.	STEEL

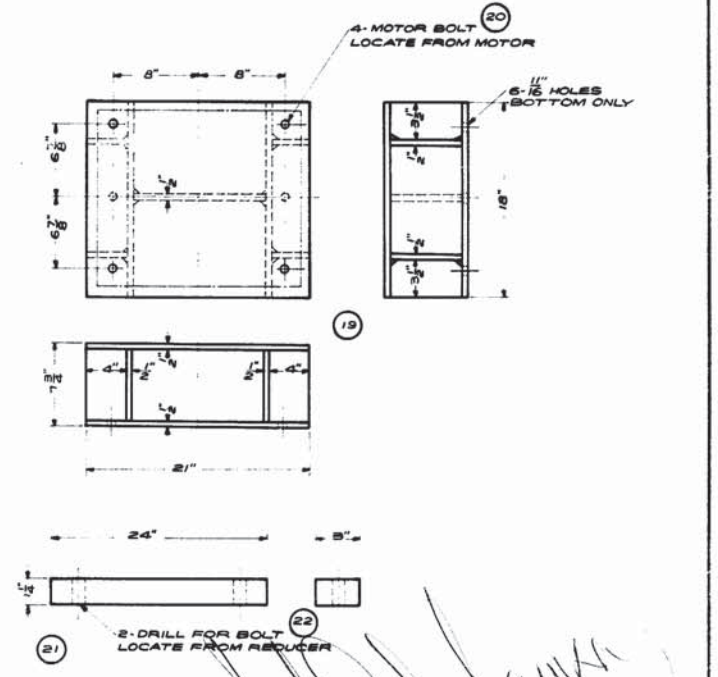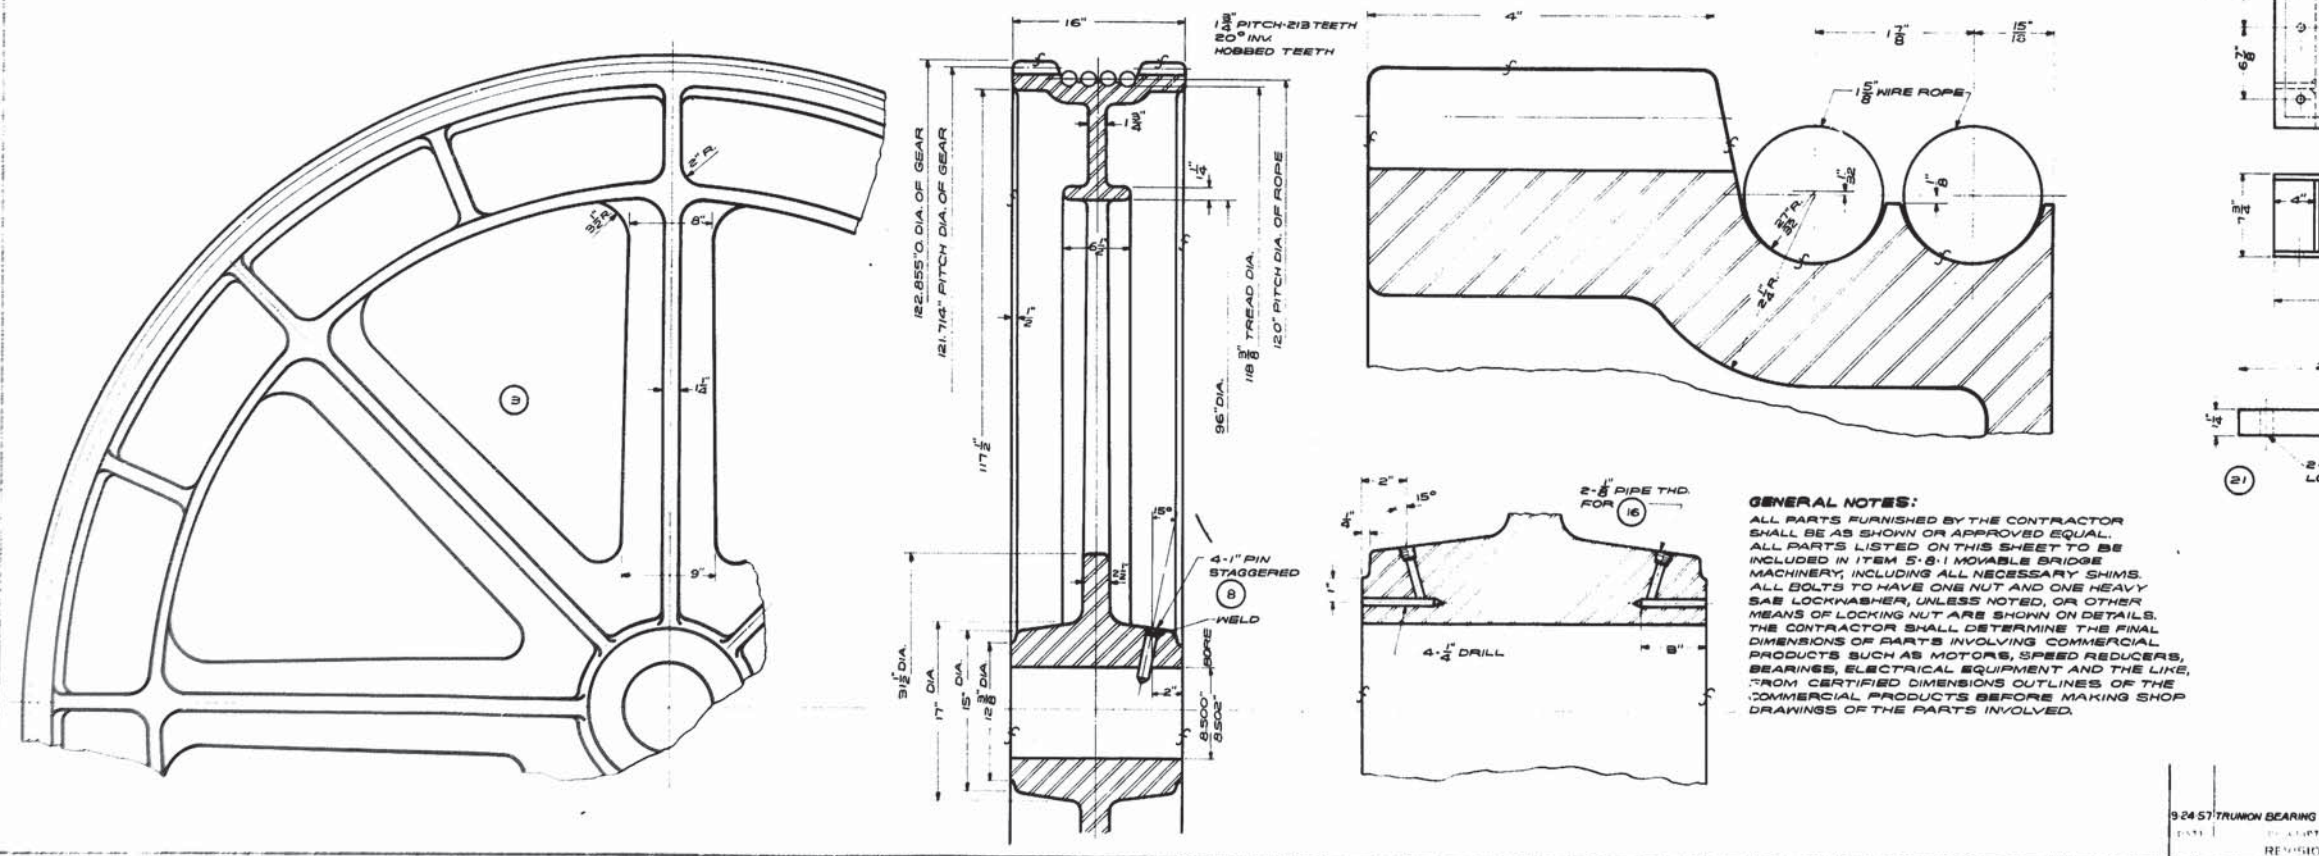

GENERAL NOTES:
 ALL PARTS FURNISHED BY THE CONTRACTOR SHALL BE AS SHOWN OR APPROVED EQUAL. ALL PARTS LISTED ON THIS SHEET TO BE INCLUDED IN ITEM 5-B-1 MOVABLE BRIDGE MACHINERY, INCLUDING ALL NECESSARY SHIMS. ALL BOLTS TO HAVE ONE NUT AND ONE HEAVY SAE LOCKWASHER, UNLESS NOTED, OR OTHER MEANS OF LOCKING NUT ARE SHOWN ON DETAILS. THE CONTRACTOR SHALL DETERMINE THE FINAL DIMENSIONS OF PARTS INVOLVING COMMERCIAL PRODUCTS SUCH AS MOTORS, SPEED REDUCERS, BEARINGS, ELECTRICAL EQUIPMENT AND THE LIKE, FROM CERTIFIED DIMENSIONS OUTLINES OF THE COMMERCIAL PRODUCTS BEFORE MAKING SHOP DRAWINGS OF THE PARTS INVOLVED.

M3

DETAILS OF SHEAVE & SHEAVE DRIVE

STANDARD PLAN
150' VERTICAL LIFT SPAN
 LIVE LOAD H20-S16-44
 28'-0" ROADWAY 5'-0" SIDEWALKS
 45'-0" LIFT OPEN STEEL GRID FLOOR
 FEB. 18 56




STATE OF LOUISIANA
 DEPARTMENT OF HIGHWAYS
 KUZEL, KUZEL, Brown, A. Chapman, KUZEL
 BRIDGE DESIGN SECTION

92457 TRUNION BEARING HOUSING
 DATE: 1/18/56
 REVISIONS:



136

STATE PROJECT	PARISH	SHEET
LA 0616	Lafayette	46

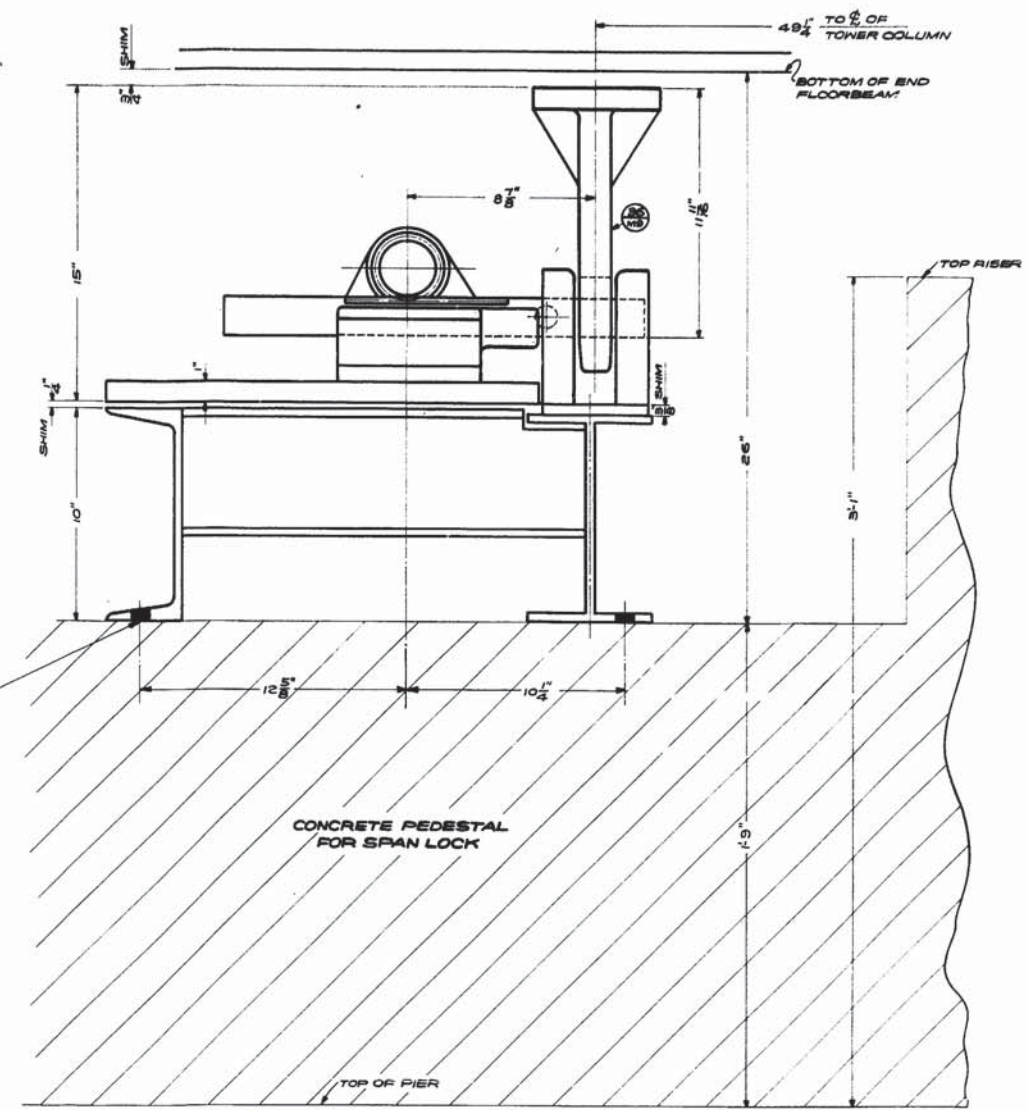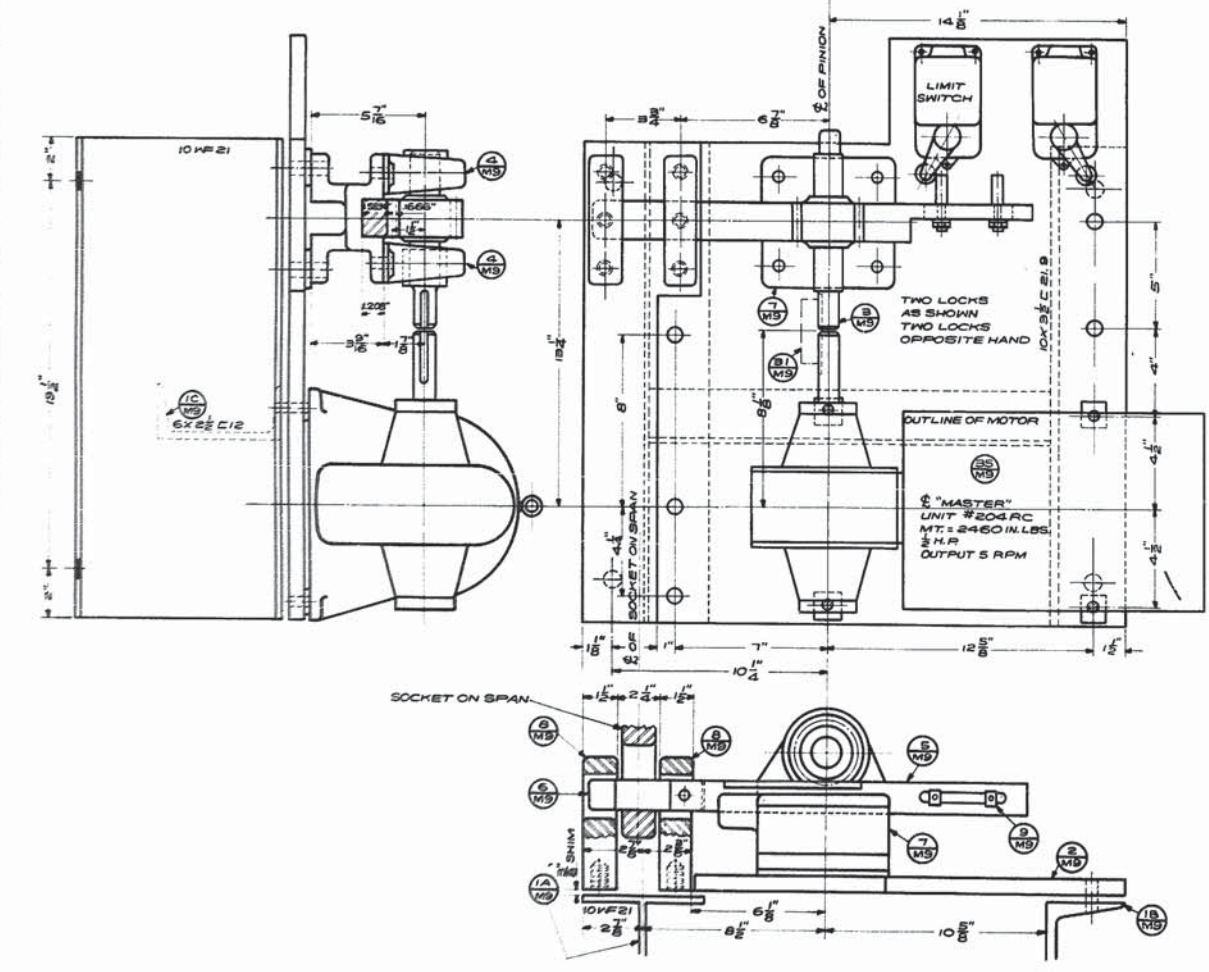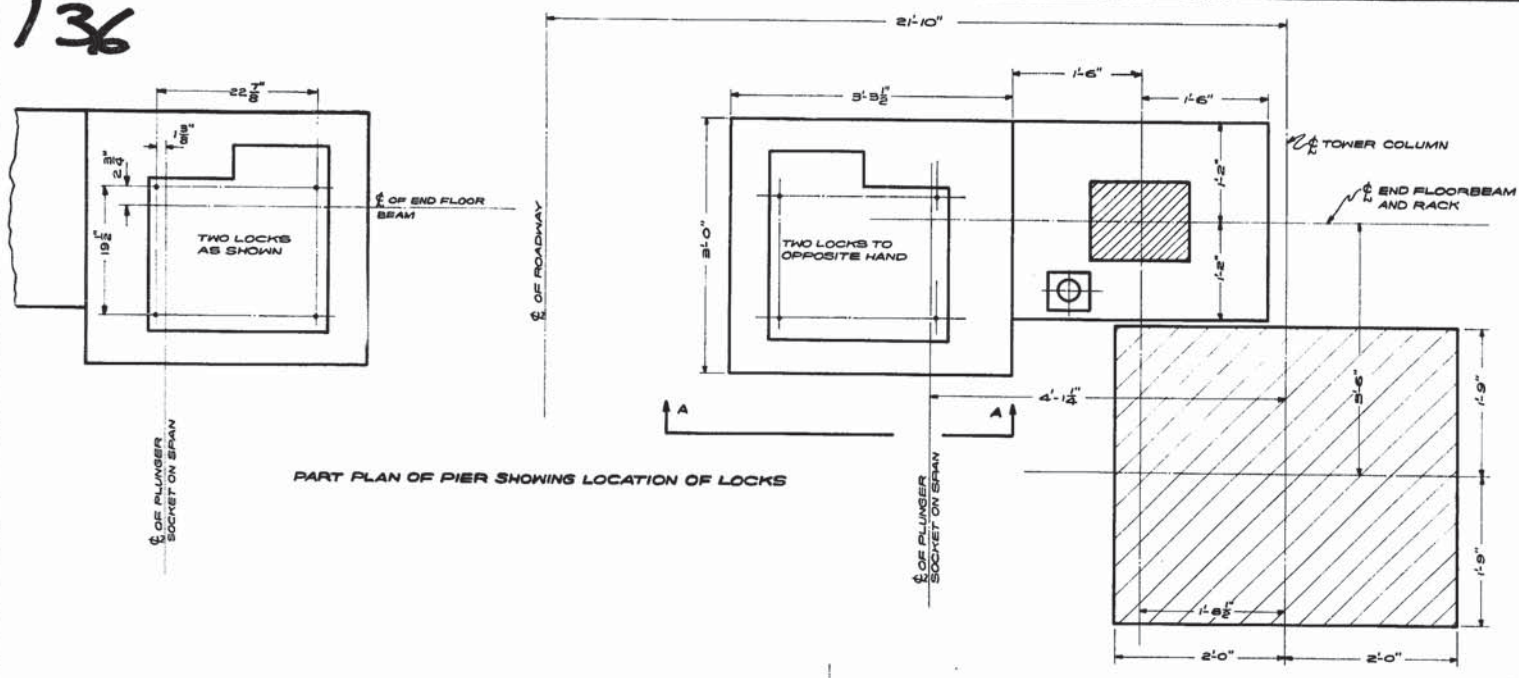

NOTE:
 THE CONTRACTOR SHALL DETERMINE THE FINAL DIMENSIONS OF PARTS INVOLVING COMMERCIAL PRODUCTS SUCH AS MOTORS, SPEED REDUCERS, BEARINGS, ELECTRICAL EQUIPMENT AND THE LIKE, FROM CERTIFIED DIMENSIONS OUTLINES OF THE COMMERCIAL PRODUCTS BEFORE MAKING SHOP DRAWINGS OF THE PARTS INVOLVED. ALL UNFINISHED SURFACES OF MACHINERY SHALL BE PAINTED ONE SHOP COAT OF RED LEAD AND OIL. ALL FINISHED SURFACES SHALL BE COATED WITH WHITE LEAD AND TALLOW BEFORE SHIPMENT AND SHALL BE PROTECTED BY WOODEN LAGGING. UNLESS OTHERWISE SHOWN ON DETAIL DRAWING LUBRICANT SHALL BE AS FOLLOWS OR APPROVED EQUAL:
 PILLION BLOCKS, COUPLINGS & TRUNION BEARINGS- ESSO FIBRE GREASE "C"
 EXPOSED TEETH- MEDIUM HARD GREASE.
 ENCLOSED SPEED REDUCERS- STD. OIL "TERRESSO G5" VISC SAE 30.
 WIRE ROPE- STD. OIL CO. SURRETTE COMPOUND N° 100.

Handwritten signature: J. W. Kuzel

ASSEMBLY OF SPAN LOCK

M8

STANDARD PLAN 150' VERTICAL LIFT SPAN LIVE LOAD H20-S16-44 28'-0" ROADWAY 5'-0" SIDEWALKS 45'-0" LIFT OPEN STEEL GRID FLOOR DATED MAY 1 1957		
STATE OF LOUISIANA DEPARTMENT OF HIGHWAYS		
DESIGNED <i>Kuzel</i>	Detailed <i>Kuzel</i>	TRACED <i>A. Chapman</i>
CHECKED <i>Brewer</i>	CHECKED <i>Brewer</i>	PLOTTED <i>Brewer</i>
BRIDGE DESIGN SECTION		

DATE	DESCRIPTION
	REVISIONS



AS BUILT PLANS

137

BILL OF MATERIAL FOR ONE SPAN LOCK		
ITEM	DESCRIPTION	MATERIAL
1	SUPPORT FOR LOCK ASSY	STEEL WELLM
11	10" W/ 21" L - 2 1/2" LONG	STEEL
12	10" W/ 21" L - 1 1/2" LONG	STEEL
13	10" W/ 21" L - 1 1/2" LONG	STEEL
2	BASE PLATE	STEEL
3	PISTON	STEEL
4	PISTON BEARING	316 ST 316T COMP
5	RACK	STEEL C.I.
6	RACK EXTENSION	STEEL
7	RACK HOUSING	C.I.
8	SOCKET ON LOCK	STEEL
9	LIMIT SWITCH ACTUATOR COMP.	BRASS
10	1" PIN - 1 1/2" LONG	STEEL
11	1" PIN - 1 1/2" LONG	STEEL
12	3/8" - 16 NC MACH BOLT - 2 1/2" LONG	STEEL
13	1/2" - 16 NC MACH BOLT - 1 1/2" LONG	STEEL
14	3/8" BEVEL WASHER	COMP
15	1/2" - 16 NC STD NUT	STEEL
16	1/2" SHAKENPROOF LOCKWASHER	COMP
17	1/2" - 16 NC MACH BOLT - 2 1/2" LONG	STEEL
18	1/2" - 16 NC STD NUT	STEEL
19	1/2" SHAKENPROOF LOCKWASHER	COMP
20	1/2" - 16 NC MACH BOLT - 2 1/2" LONG	STEEL
21	1/2" - 16 NC STD NUT	STEEL
22	1/2" BEVEL WASHER	COMP
23	1/2" SHAKENPROOF LOCKWASHER	COMP
24	1/2" - 16 NC MACH BOLT - 2 1/2" LONG	STEEL
25	1/2" - 16 NC STD NUT	STEEL
26	1/2" SHAKENPROOF LOCKWASHER	COMP
27	1/2" - 16 NC MACH BOLT - 1 1/2" LONG	STEEL
28	1/2" SHAKENPROOF LOCKWASHER	COMP
29	1/2" - 16 NC MACH BOLT - 1 1/2" LONG	STEEL
30	1/2" SHAKENPROOF LOCKWASHER	COMP
31	COUPLING - MORSE DISC # 8 - 16	COMP
32	1/2" SQ KEY - 1 1/2" LONG	STEEL KEYSTOCK
33	G SPACER	BRASS
34	1/2" ALUMITE PIPER FITTING	COMP
35	MASTER ELECTRIC UNIT FR 200 AC 2400 IN 1.85 TORQUE 1/2" HP - OUTPUT SHFT 3 RPM	
36	SOCKET ON SHAFT	STAINLESS STEEL
37	TURNED BOLT COMP	STEEL

FOUR LOCKS REQUIRED FOR ONE SPAN
TWO LOCKS AS SHOWN
TWO LOCKS TO OPPOSITE HAND

GENERAL NOTES:
ALL PARTS FURNISHED BY THE CONTRACTOR SHALL BE AS SHOWN OR APPROVED EQUAL.
ALL PARTS LISTED ON THIS SHEET TO BE INCLUDED IN ITEM 5-B 1 MOVABLE BRIDGE MACHINERY, INCLUDING ALL NECESSARY SHIMS.
ALL BOLTS TO HAVE ONE NUT AND ONE HEAVY SAE LOCKWASHER, UNLESS NOTED, OR OTHER MEANS OF LOCKING NOT SHOWN ON DETAILS.
THE CONTRACTOR SHALL DETERMINE THE FINAL DIMENSIONS OF PARTS INVOLVING COMMERCIAL PRODUCTS SUCH AS PUMPS, SPEED REDUCERS, BEARINGS, ELECTRICAL EQUIPMENT AND THE LIKE, FROM CERTIFIED DIMENSIONS OUTLINES OF THE COMMERCIAL PRODUCTS BEFORE MAKING SHOP DRAWING OF THE PARTS INVOLVED.

H. A. Mahoney

M9

DETAIL OF SPAN LOCK


STANDARD PLAN
150' VERTICAL LIFT SPAN
LIVE LOAD H20-S16-44
28'-0" ROADWAY 5'-0" SIDEWALKS
45'-0" LIFT OPEN STEEL GRID FLOOR

DATE: May 1 - 57

STATE OF LOUISIANA
DEPARTMENT OF HIGHWAYS


RUELL Brewer
RUELL Brewer
D. H. Brewer

BRIDGE DESIGN SECTION

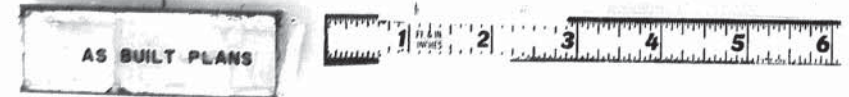

138

STATE PROJECT	PARISH	SHEET NO.
68-00-16	Lafourche	48

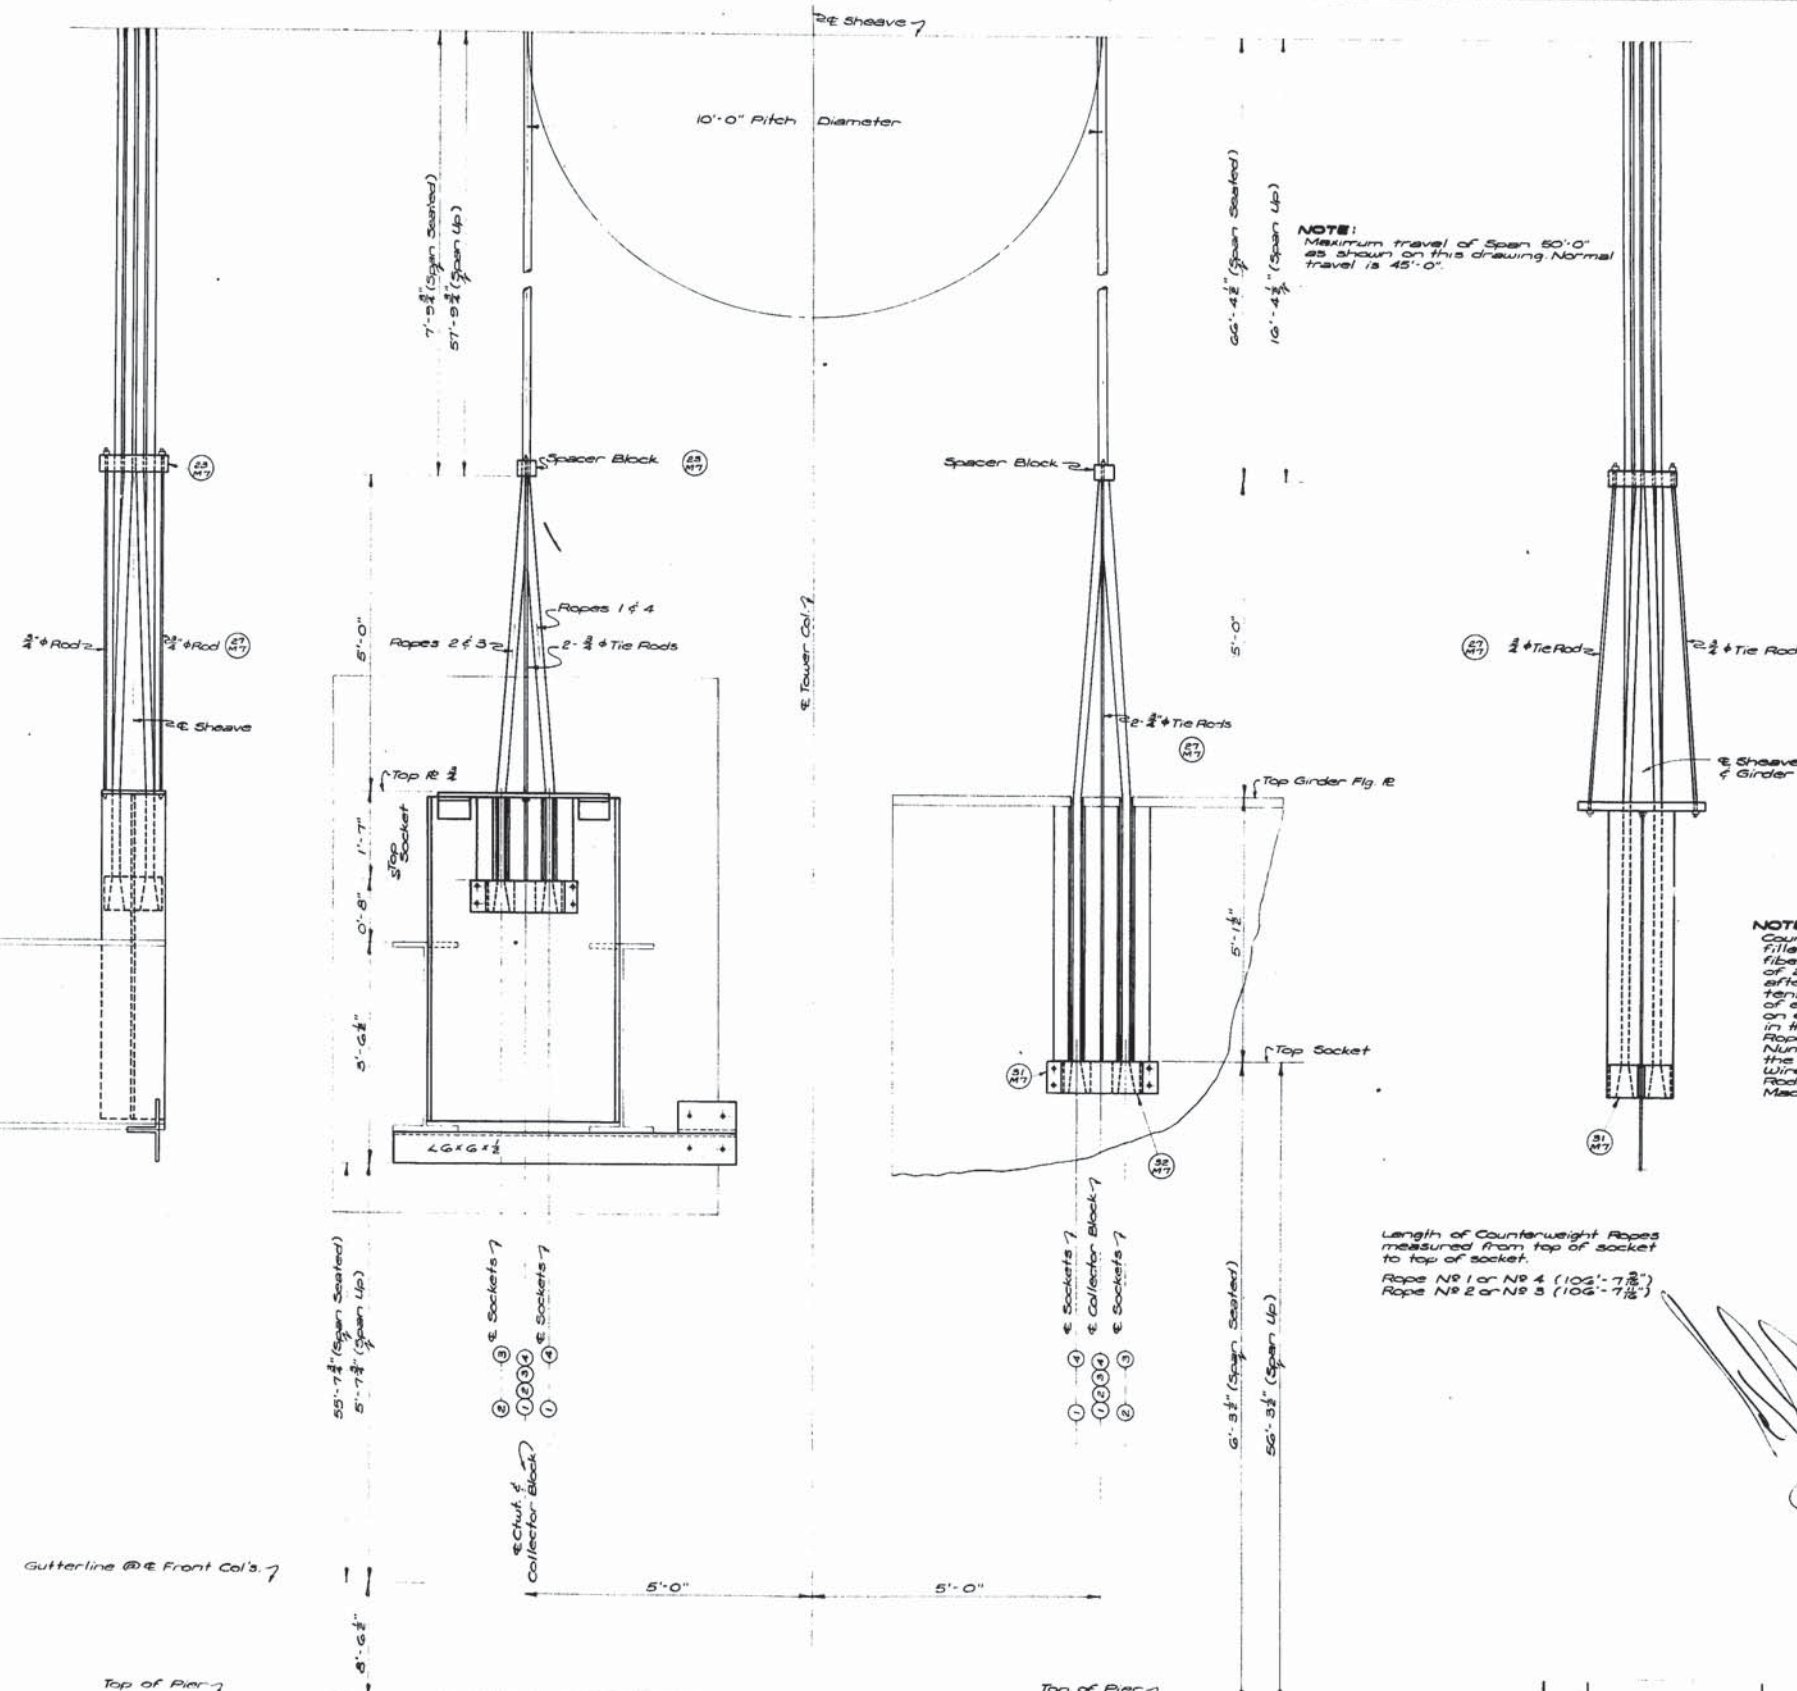

NOTE:
Maximum travel of Span 60'-0"
as shown on this drawing. Normal
travel is 45'-0".

NOTES:
Counterweight Ropes to be 1 1/2" diameter G-25
filler wire improved plow steel wire rope with
fiber core, having a minimum breaking strength
of 209,000 Lbs. The Ropes shall be measured
after the attachment of the sockets under a
tension of 25,100 Lbs., and the Fabricated Length
of each rope, top to top of sockets shall be stamped
on each socket. Suitable shims shall be provided
in the event that the Fabricated Lengths of the
Ropes vary from the Lengths shown. The Rope
Number shall be stamped on each socket and on
the Counterweight and Lift Span lifting points.
Wire Ropes, Sockets, Spacer Blocks and 2" Tie
Rods to be included in them S-5-1, Movable Bridge
Machinery.

Length of Counterweight Ropes
measured from top of socket
to top of socket.
Rope NR 1 or NR 4 (102'-7 1/2")
Rope NR 2 or NR 3 (106'-7 1/2")

[Handwritten signature]

ARRANGEMENT OF COUNTERWEIGHT ROPES **MIO**

STANDARD PLAN
150' VERTICAL LIFT SPAN
LIVE LOAD H20-S16-44
28'-0" ROADWAY 5'-0" SIDEWALKS
45'-0" LIFT OPEN STEEL GRID FLOOR
DATE: April 17, 1957

STATE OF LOUISIANA
DEPARTMENT OF HIGHWAYS

DESIGNED: *[Signature]* CHECKED: *[Signature]* TRACED: *[Signature]*
ENGINEER: S.L.P. C. CHECKED: S.L.P. CHECKED: S.L.P.

BRIDGE DESIGN SECTION

DATE	DESCRIPTION	REVISIONS



SHEET 24 OF 26

SL50-150-28



139

STATE PROJECT	PARISH	SHEET
68-06-1G	Labouchere	49

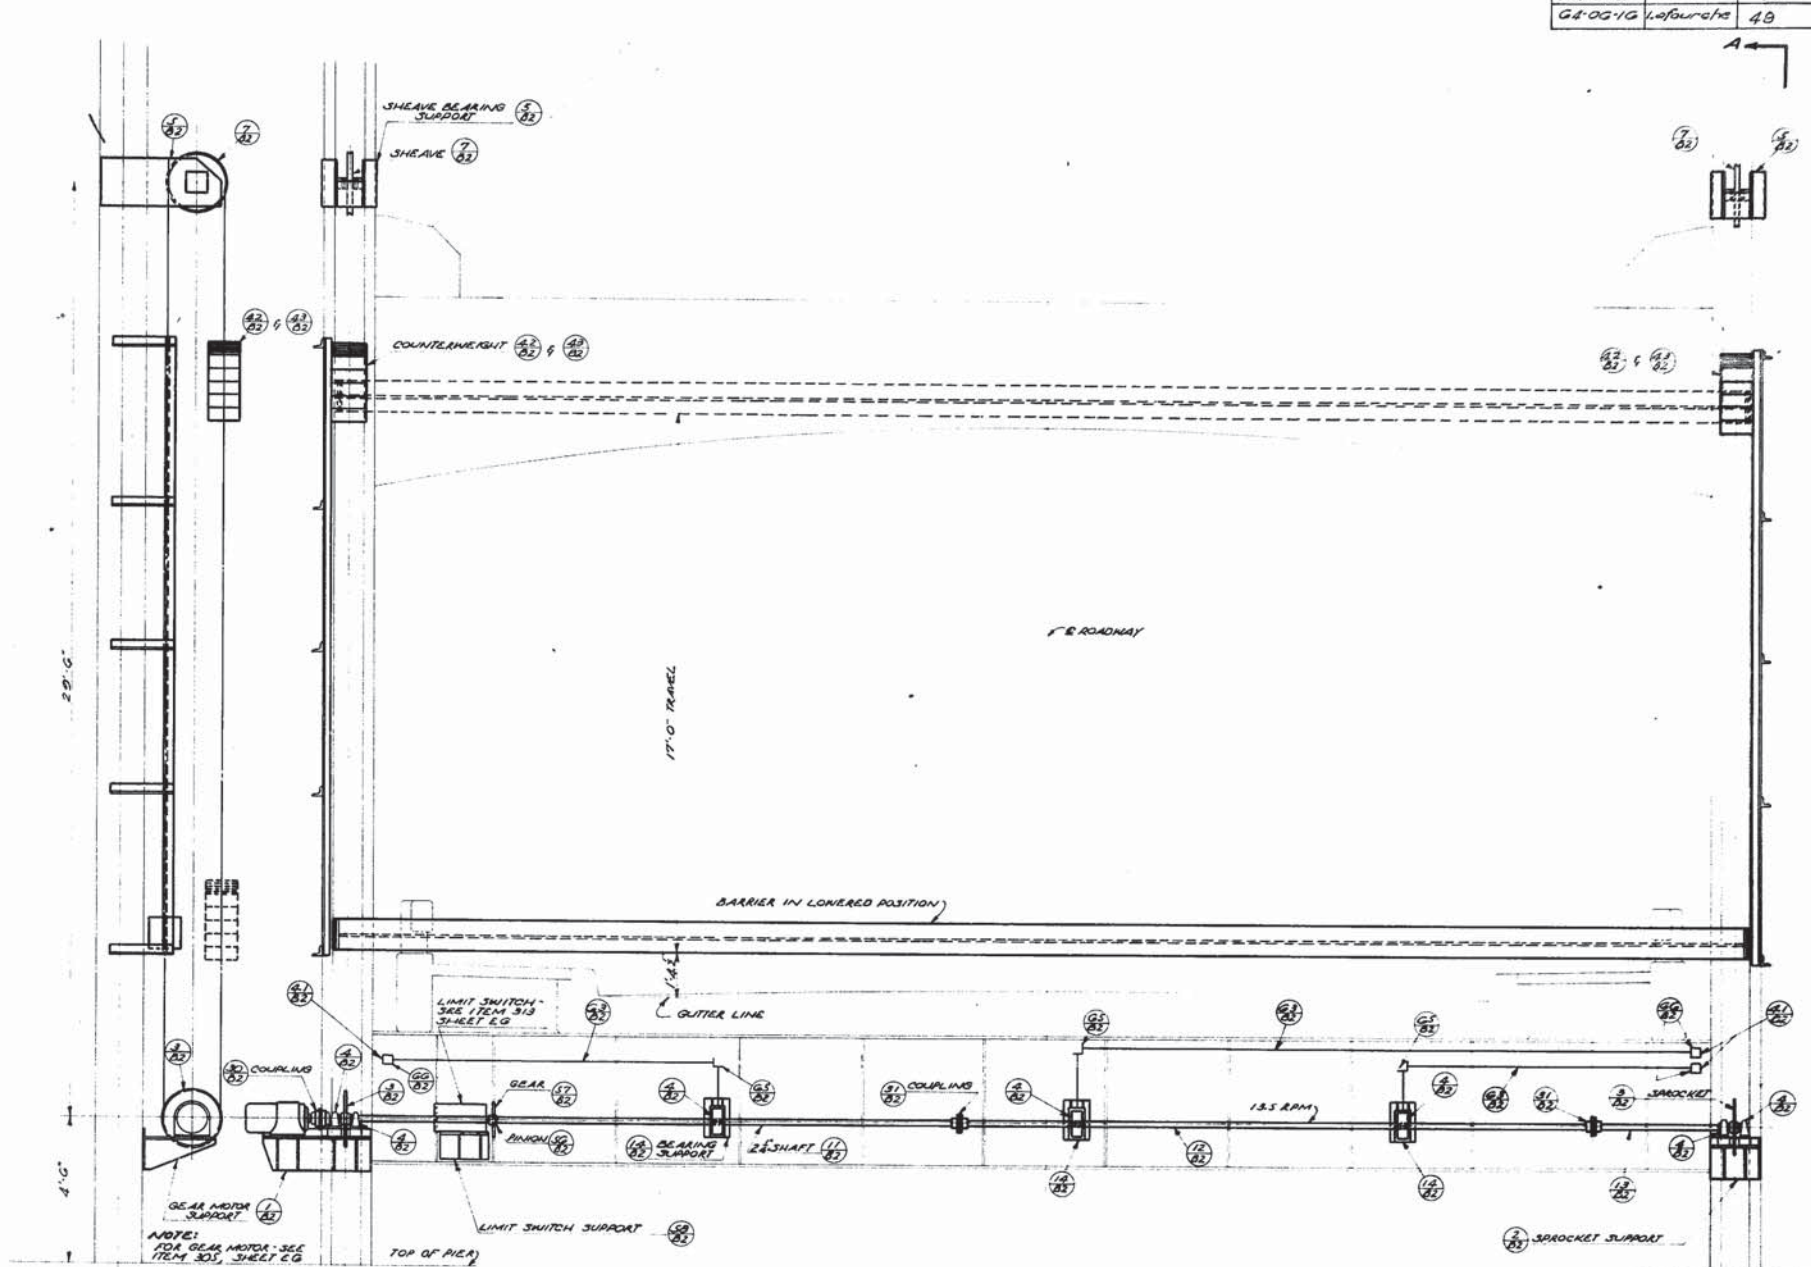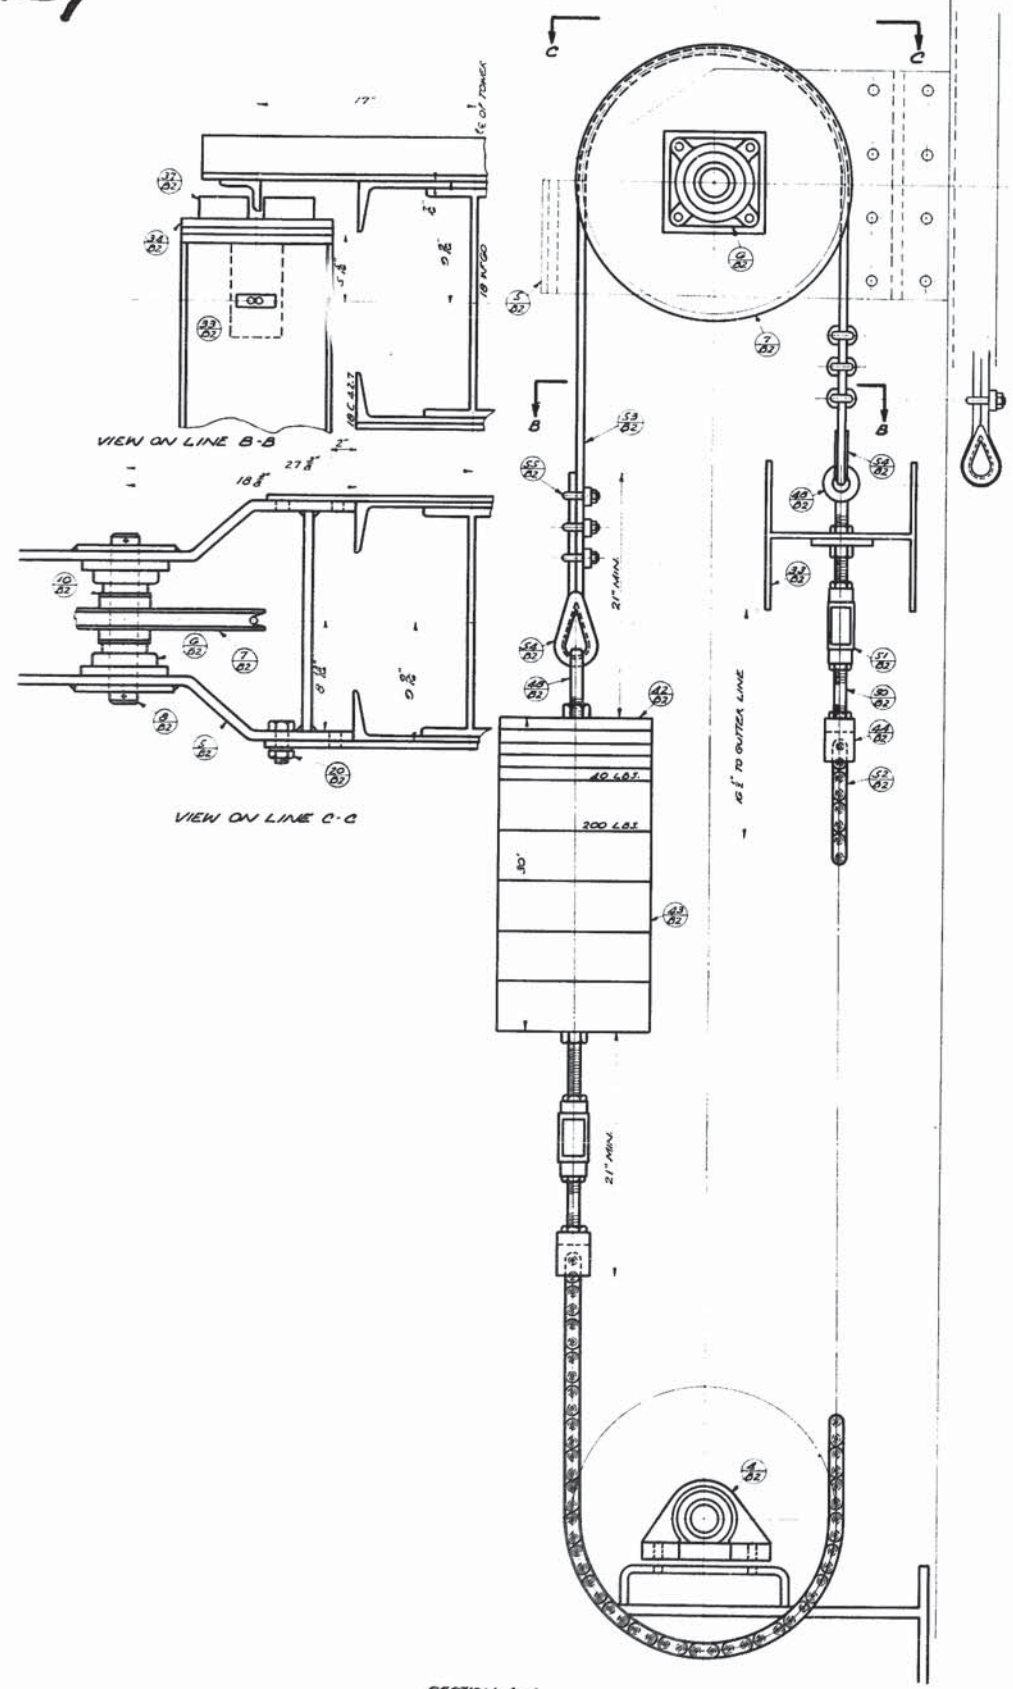

PART SIDE ELEVATION OF TOWER SHOWING BARRIER

PART REAR ELEVATION OF TOWER SHOWING BARRIER OPERATING MACHINERY

NOTE:
FOR GEAR MOTOR - SEE ITEM 305, SHEET E.G.

THICKNESS	5"	6"	8"
ONE SIDE	1	2	4
BOTH SIDES	2	4	8

NOTE:
THE CONTRACTOR SHALL DETERMINE THE FINAL DIMENSIONS OF PARTS INVOLVING COMMERCIAL PRODUCTS SUCH AS MOTORS, SPEED REDUCERS, GEARS, ELECTRIC EQUIPMENT AND THE LISC. FROM CERTIFIED DIMENSIONS OF THE COMMERCIAL PRODUCTS BEFORE MAKING SHOP DRAWINGS OF THE PARTS INVOLVED.

PAINTING NOTE:
ALL UNFINISHED SURFACES OF MACHINERY SHALL BE PAINTED ONE SHOP COAT OF RED LEAD AND OIL. ALL FINISHED SURFACES SHALL BE COATED WITH WHITE LEAD AND TALLOW BEFORE SHIPMENT AND SHALL BE PROTECTED BY WOODEN LAGGING.

LUBRICATION NOTE:
UNLESS OTHERWISE SHOWN ON DETAIL DRAWING, LUBRICANT SHALL BE AS FOLLOWS OR APPROVED EQUAL:
PILLOW BLOCKS, COUPLINGS, & TRUNION BEARINGS - ESSO FIBRE GREASE "C".
EXPOSED TEETH - MEDIUM HARD GREASE.
ENCLOSED SPEED REDUCERS - STD. OIL "TEXRESSO 05" VISC. SAE 30.
WIRE ROPE - STD. OIL CO. SURRETTE COMPOUND N11530.

[Handwritten Signature]

GENERAL ARRANGEMENT OF TRAFFIC BARRIER

B1

STANDARD PLAN
150' VERTICAL LIFT SPAN
LIVE LOAD H20-S16-44
28'-0" ROADWAY 5'-0" SIDEWALKS
45'-0" LIFT OPEN STEEL GRID FLOOR
DATE MAY 1 1957

STATE OF LOUISIANA
DEPARTMENT OF HIGHWAYS
DESIGNED: RUSSEL
CHECKED: Brewer
TRACED: M. MOORE
CHECKED: RUSSEL
CHECKED: Brewer
BRIDGE DESIGN SECTION

DATE	DESCRIPTION	BY
	REVISIONS	


SHEET 25 OF 26

SL50-150-28





Job No. _____ Sheet _____ of _____
 Job Name 000930
 Task Rail Details
 Calculated by _____ Date _____
 Checked by _____ Date _____

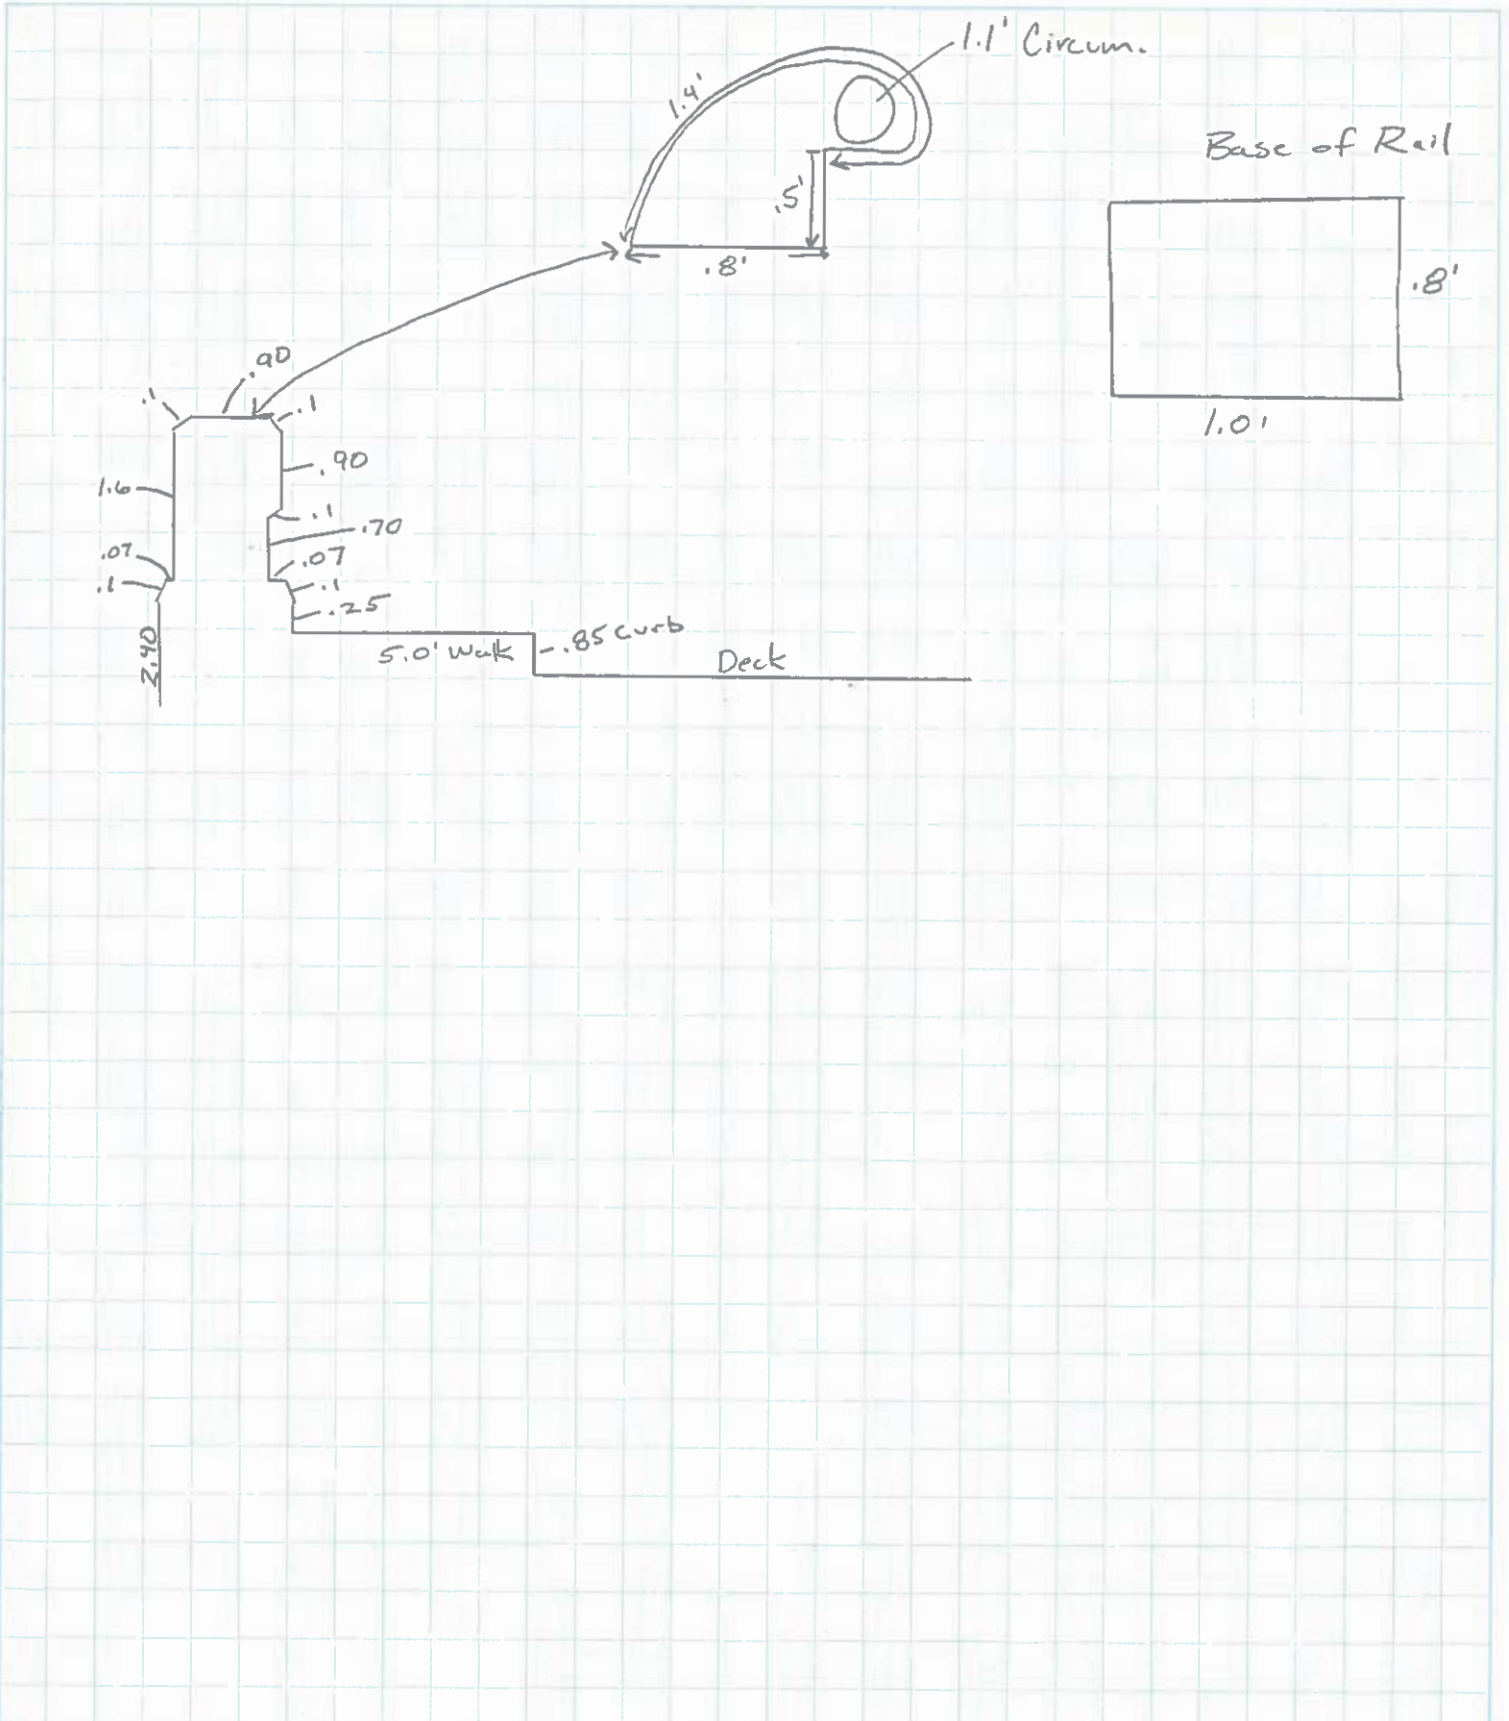




Job No. _____ Sheet _____ of _____

Job Name 000930

Task Rail Details

Calculated by _____ Date _____

Checked by _____ Date _____

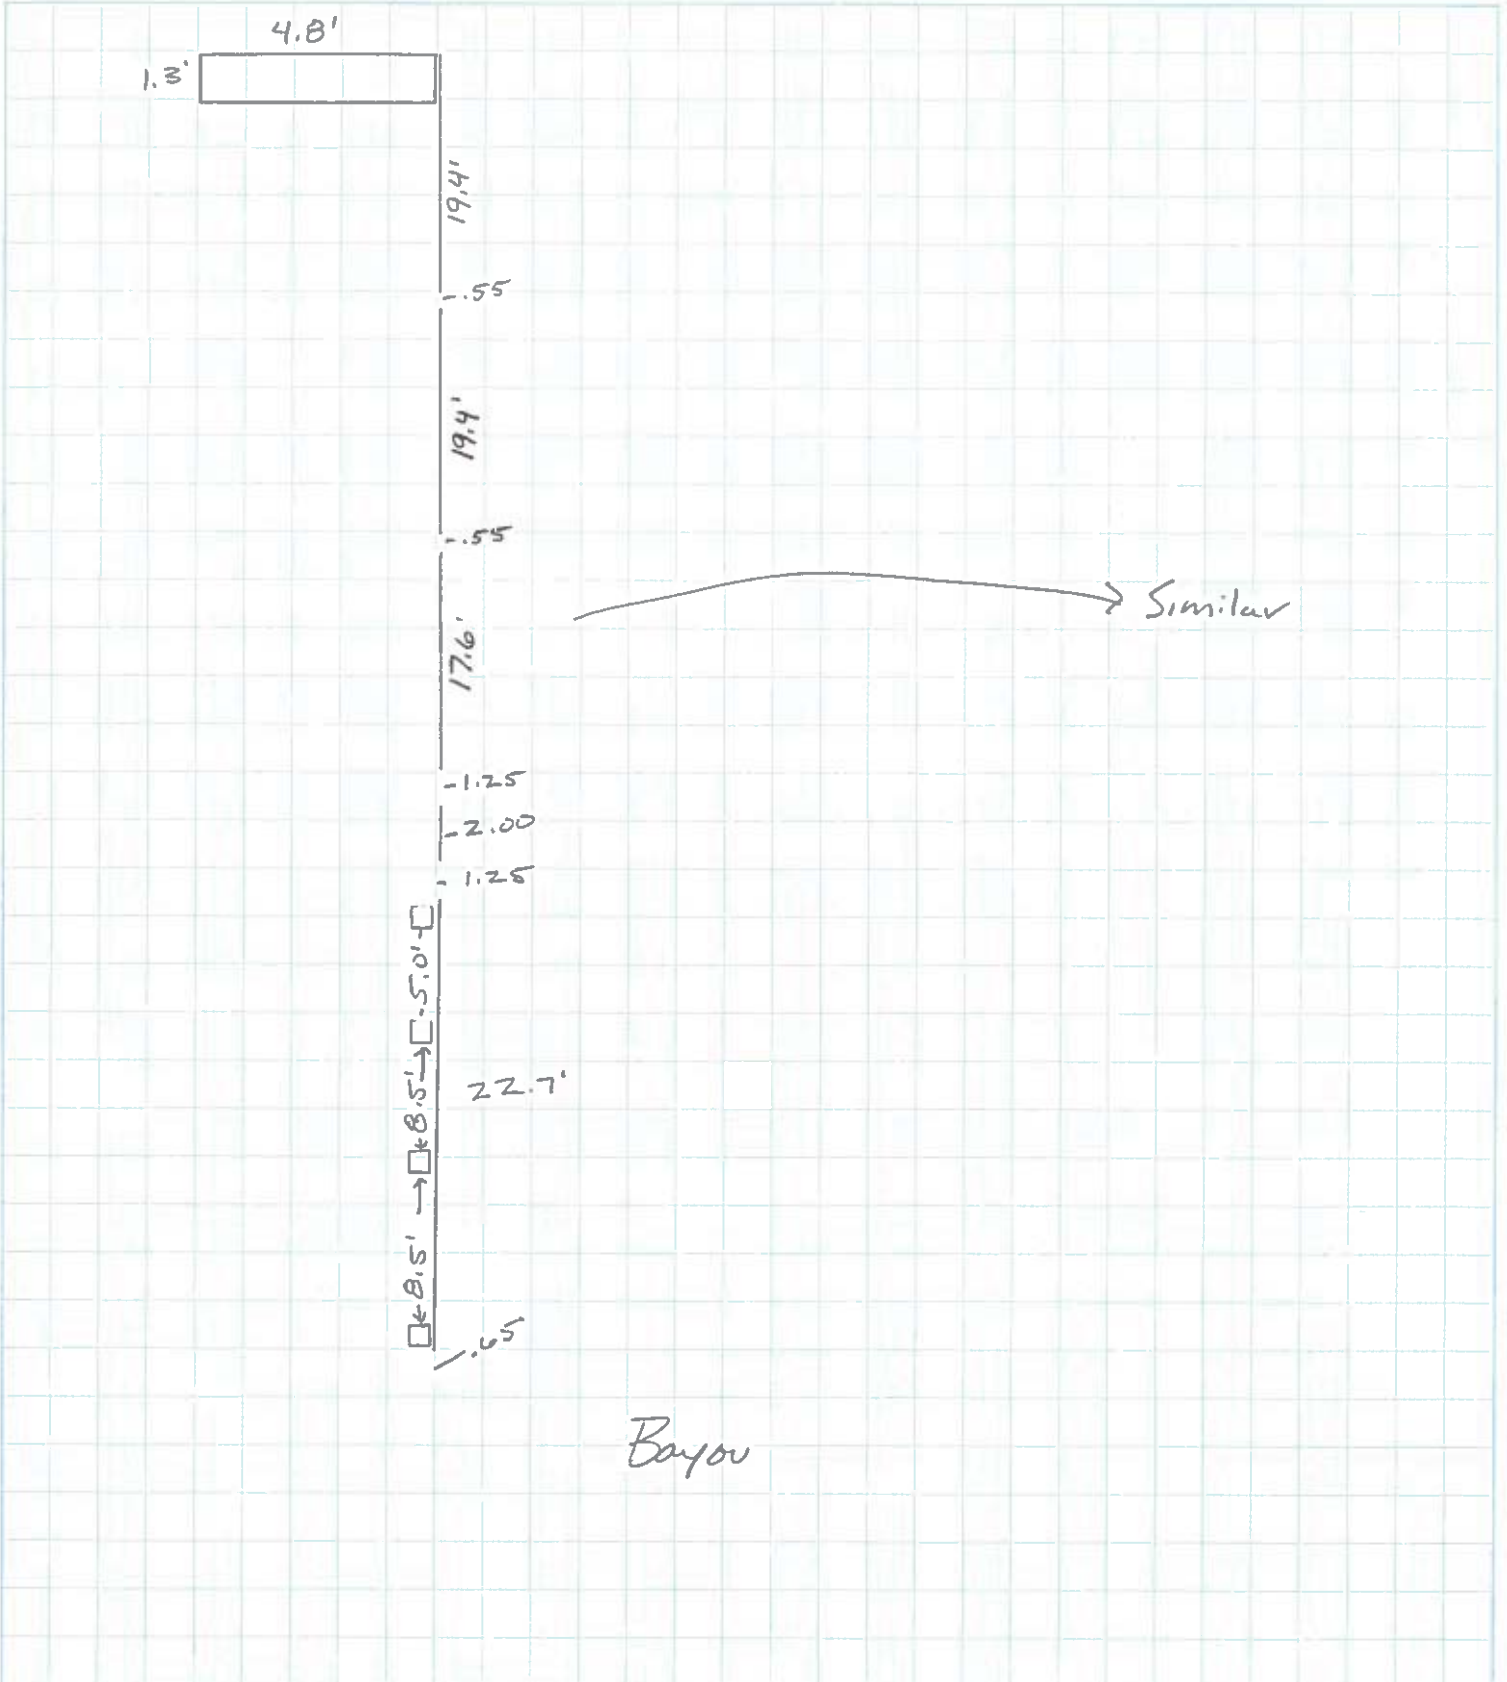



Job No. _____ Sheet _____ of _____


Job Name 000930

Task Rail Details

Calculated by _____ Date _____

Checked by _____ Date _____

Bayou

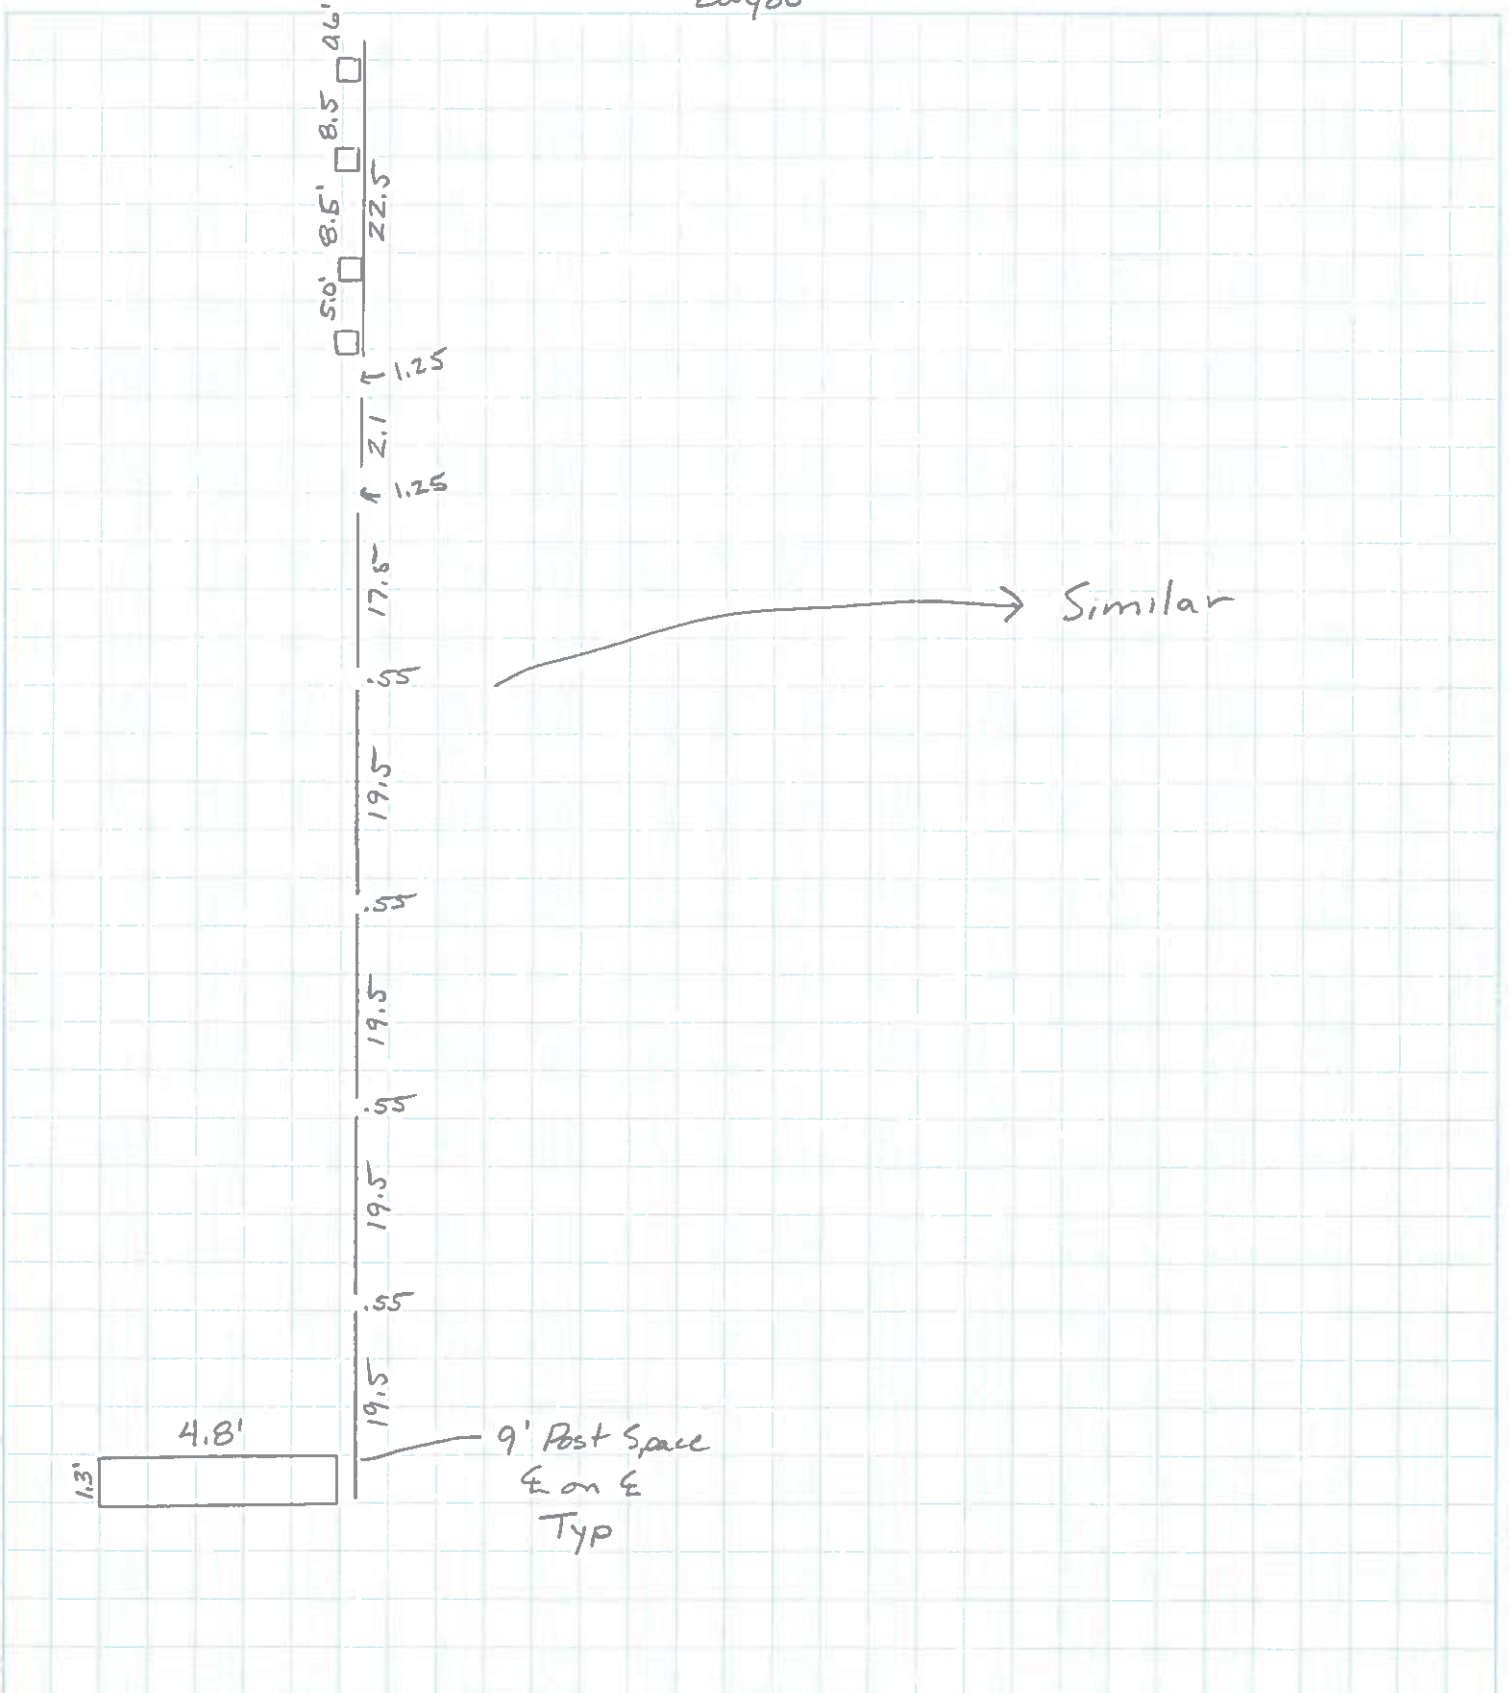




Job No. _____ Sheet _____ of _____

Job Name 000930

Task Equipment Room

Calculated by _____ Date _____

Checked by _____ Date _____

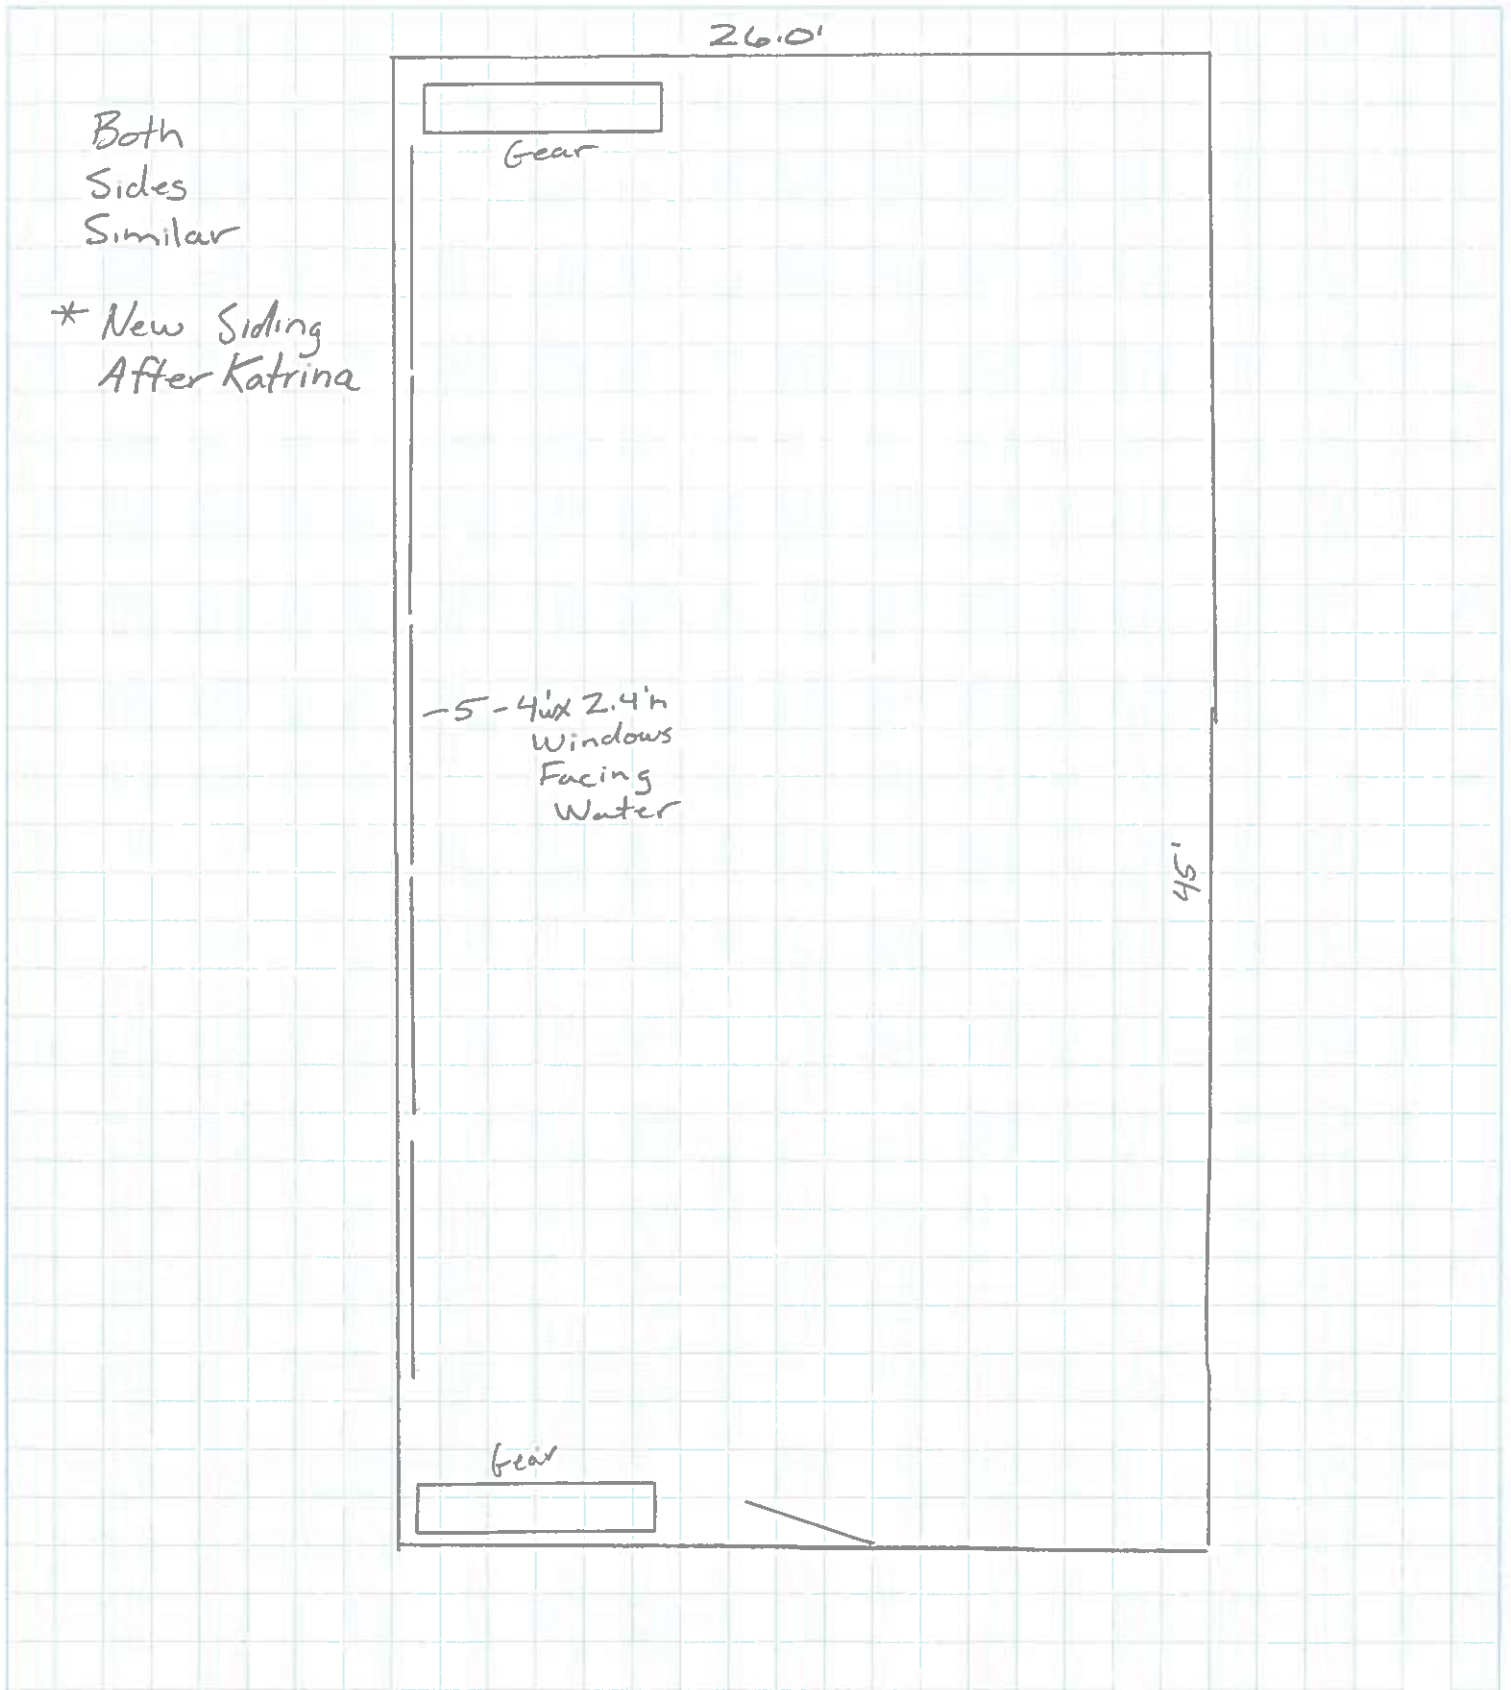




Job No. _____ Sheet _____ of _____

Job Name 000930

Task Equipment Room Roof Beams

Calculated by _____ Date _____

Checked by _____ Date _____

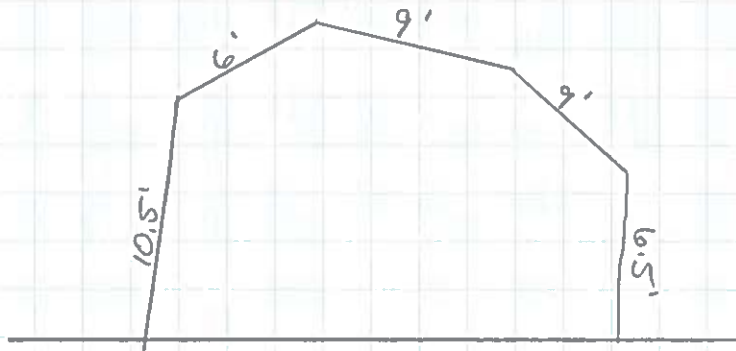


113

See Detail


000930
Sheet 3 of 4

Date	Revised	By
07-20-52	04-20-50	24

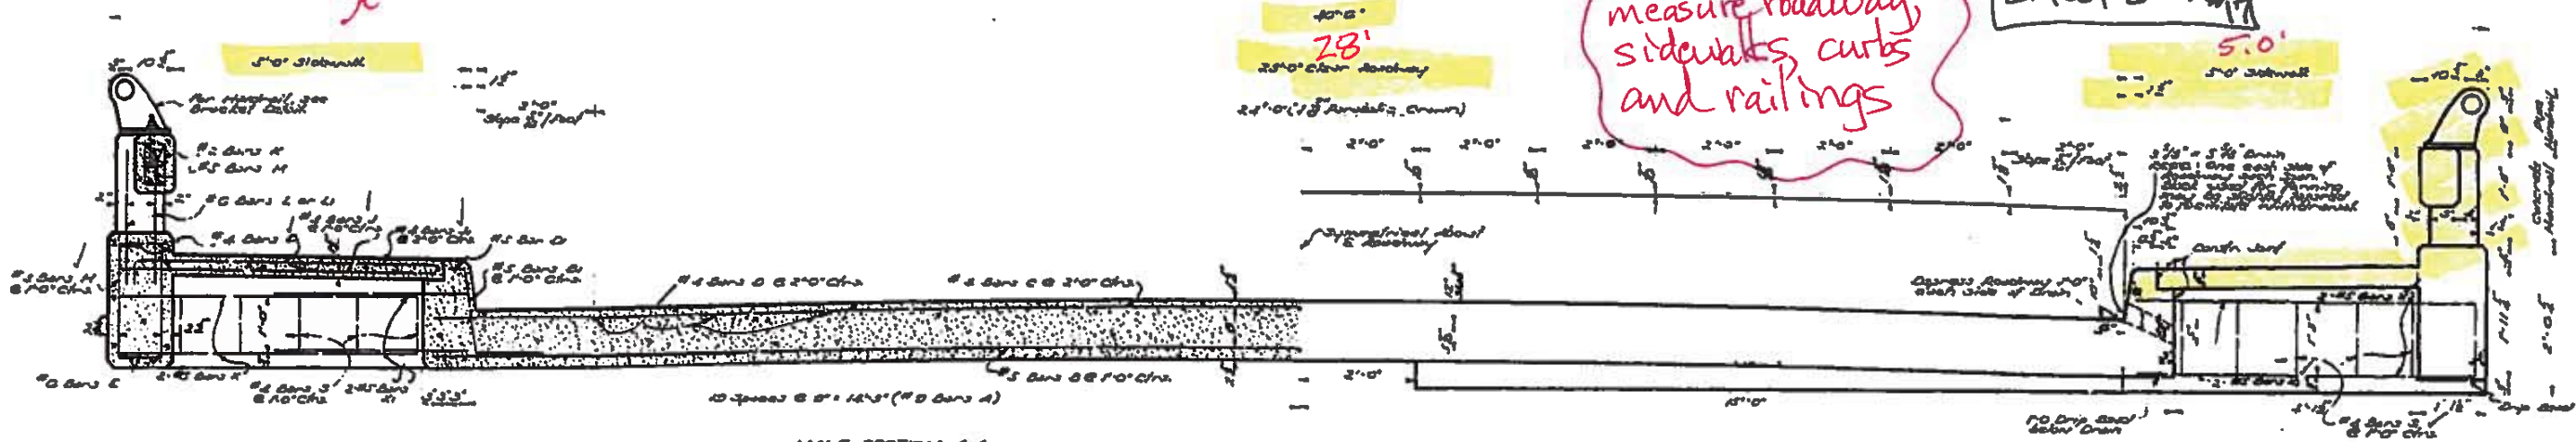


HALF SECTION A-A
SHOWING REINFORCING

HALF SECTION B-B
SHOWING DIMENSIONS, DRAIN, AND BRACKET REINFORCING AT END OF SPAN

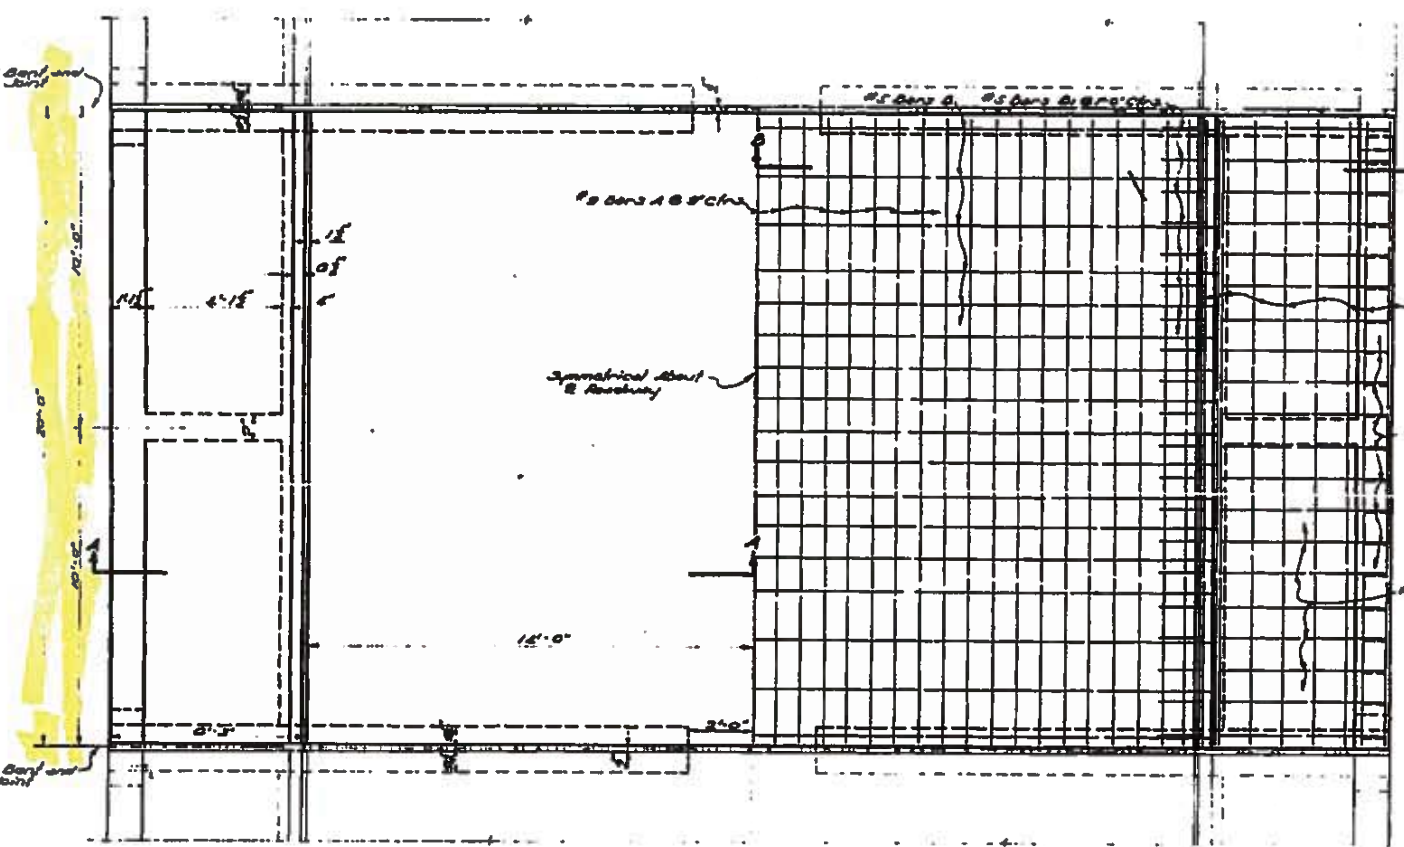

HALF PLAN
SHOWING DIMENSIONS
(HANDRAIL OMITTED)

HALF PLAN
SHOWING REINFORCING IN BOTTOM OF
SLAB AND SIDEWALK

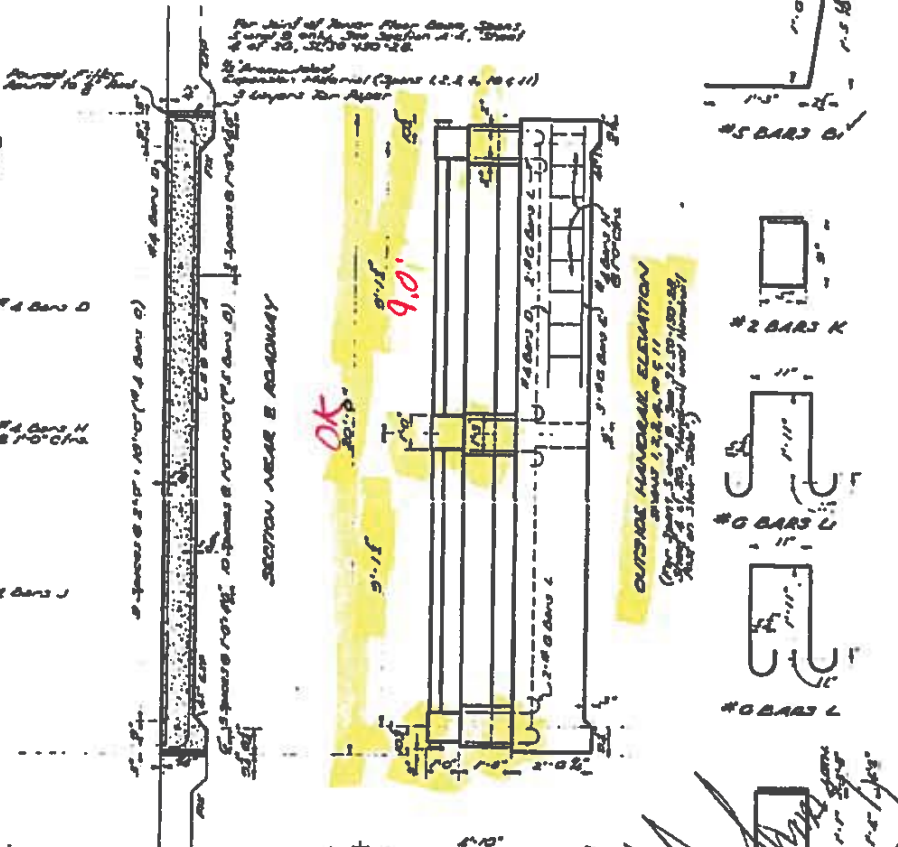

SECTION A-A-E & ROADWAY













BILL OF MATERIALS FOR ONE SPAN

BAR SIZE	NO	LENGTH	TOTAL LENGTH	LOCATION
C	24	20'-5"	492'-0"	Diaphragm in slab
D	24	18'-7"	448'-8"	Slab & sidewalk
H	24	20'	480'-0"	Diaphragm
J	24	5'-5"	132'-0"	Diaphragm in sidewalk
K	24	5'-0"	120'-0"	Diaphragm in sidewalk
L	24	2'-0"	48'-0"	Diaphragm
M	24	2'-0"	48'-0"	Diaphragm
EG	24	2'-0"	4	

000930 17
Sheet 4 of 6

DATE	BY	CHKD
04.00.10	Lufshure/0	26

see notes on Sheet 3 of 6

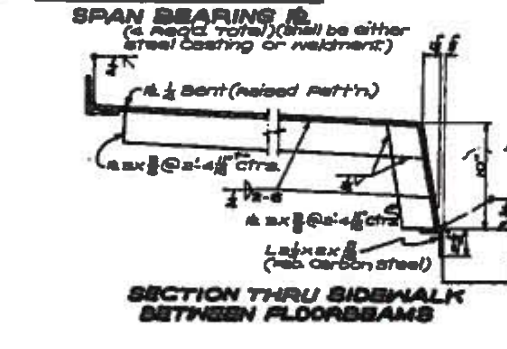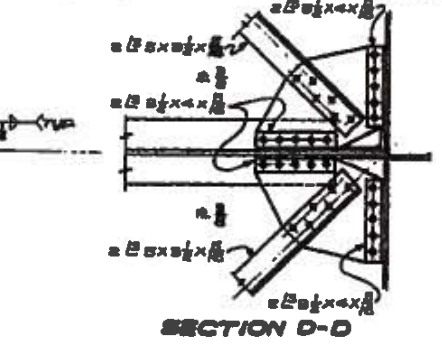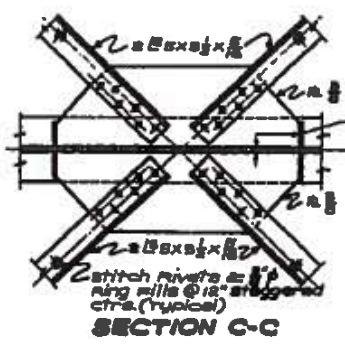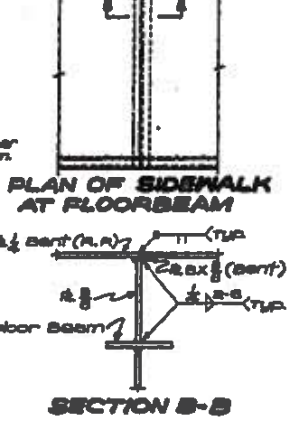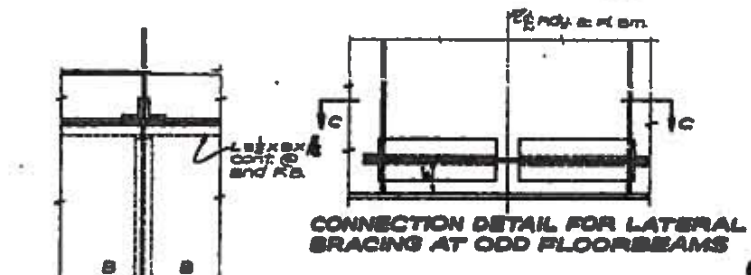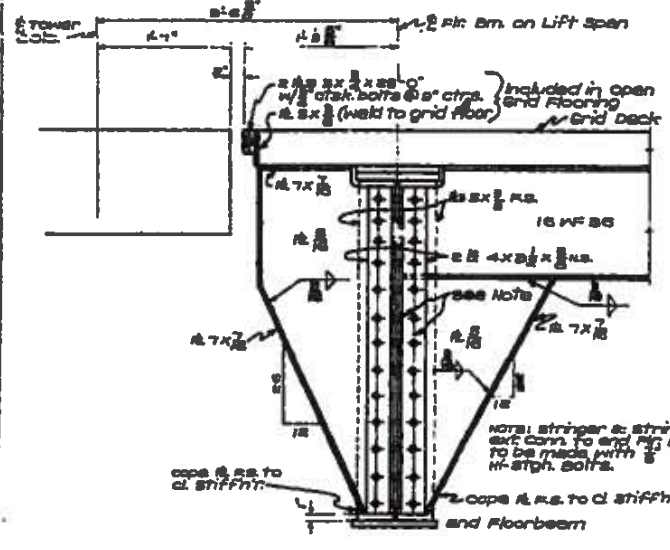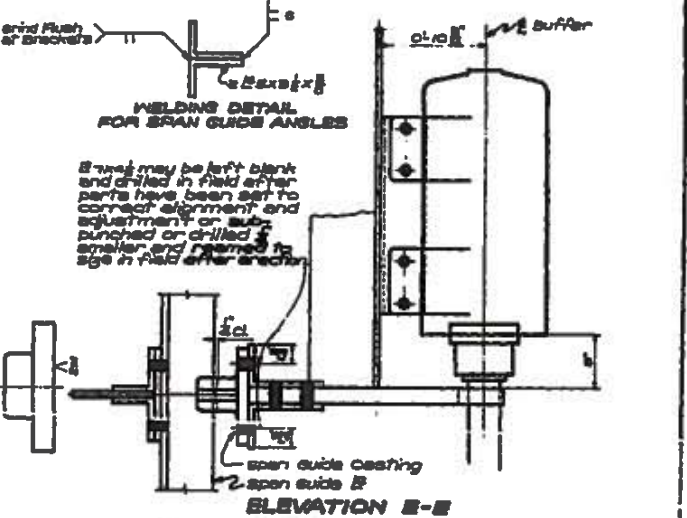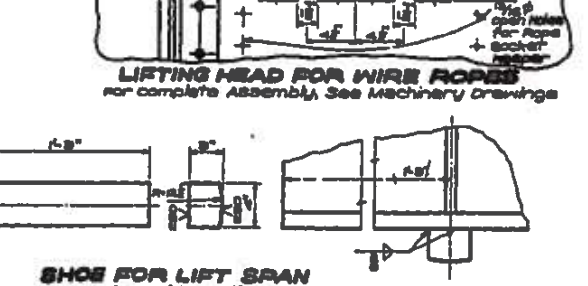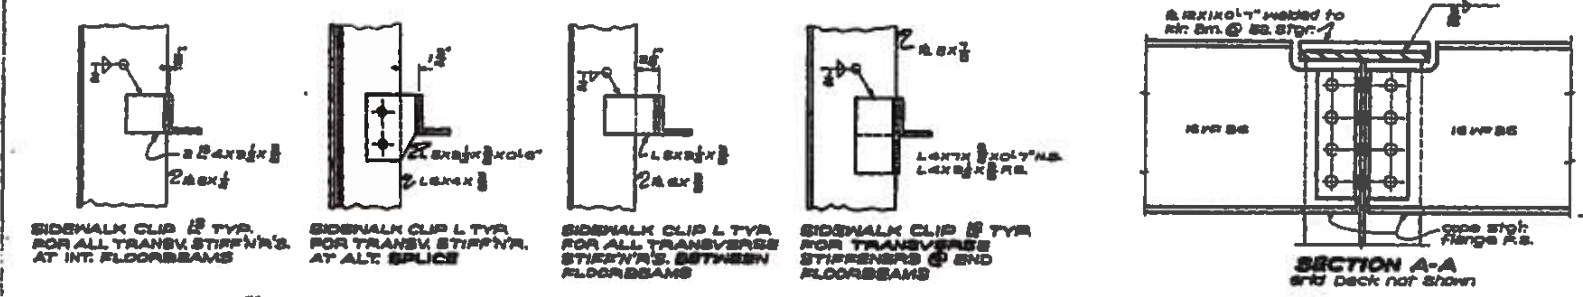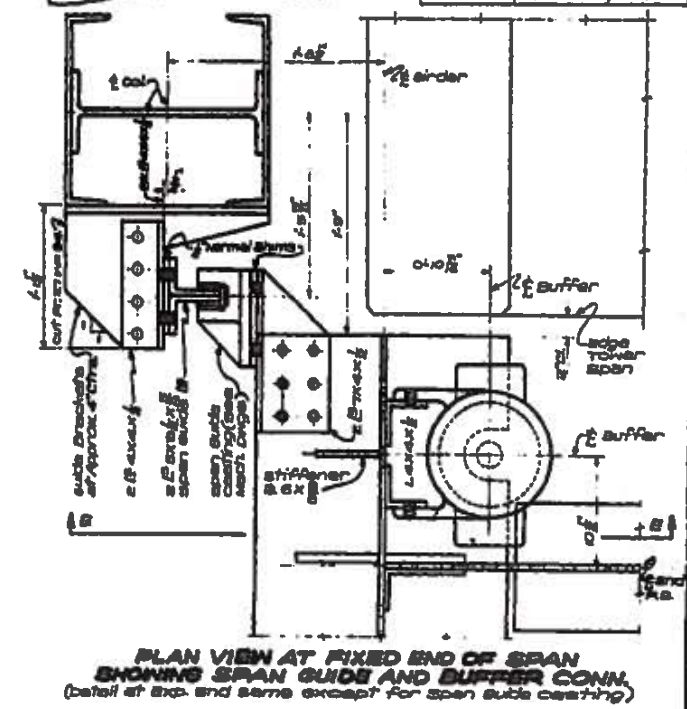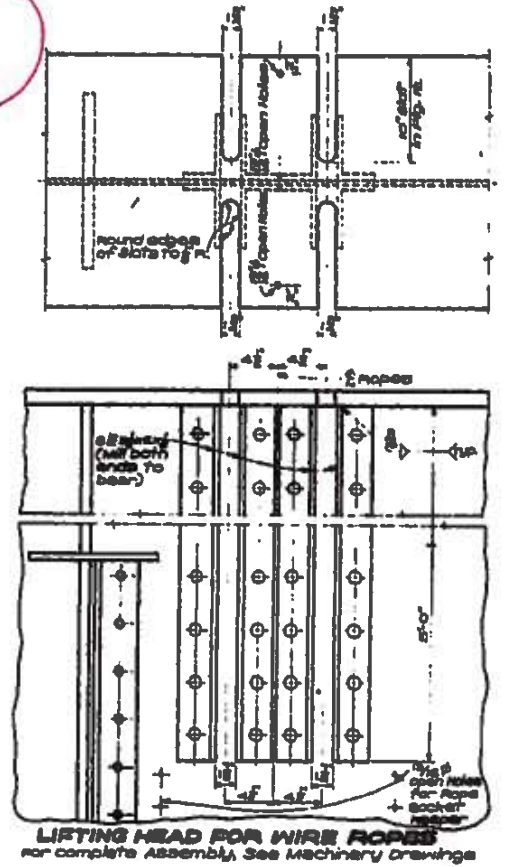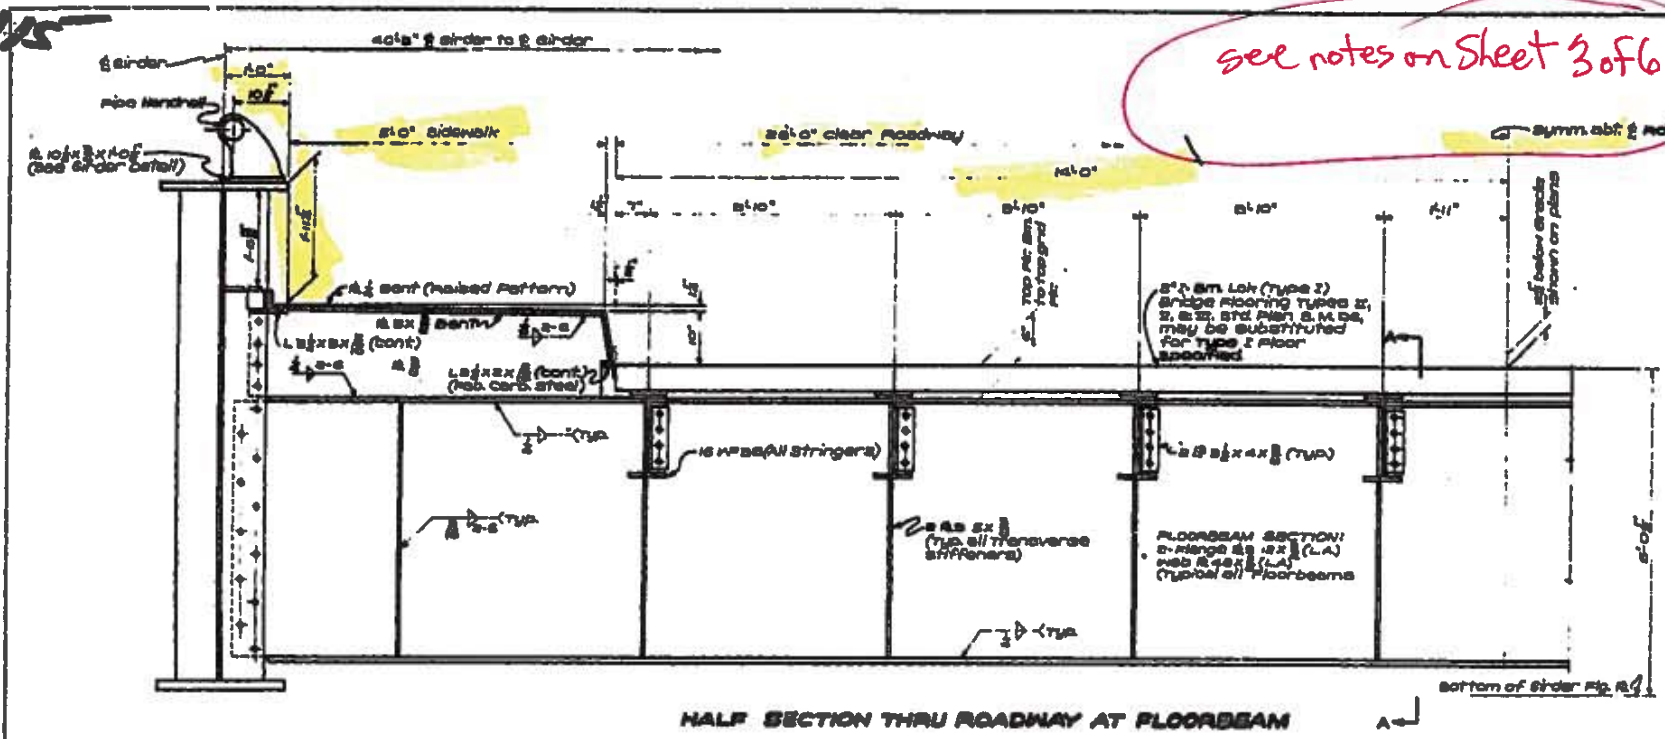

	EXTERIOR STOPS		INTERIOR STOPS		FLOORBEAMS	
	M(K-FT/R)	R(K)	M(K-FT/R)	R(K)	M(K-FT/R)	R(K)
O	6.9	1.6	8.1	1.1	155.6	19.0
1	11.5	3.4	0.0	0.0	22.2	8.2
L	48.2	18.8	58.7	20.1	646.1	73.0
T	15.8	4.1	17.6	6.0	199.9	14.1
T	21.0	21.4	21.4	27.3	1081.7	78.0

STANDARD PLAN
150' VERTICAL LIFT SPAN
LIVE LOAD H20-S16-44
28'-0" ROADWAY
48'-0" LIFT
OPEN STEEL BRD FLOOR
5'-0" SIDEWALKS

STATE OF CALIFORNIA
DEPARTMENT OF HIGHWAYS



BRIDGE DESIGN SECTION

112

see notes on Sheet 3 of 6






000930
Sheets of 5

DATE	NO.	BY
01-05-62	1474	28

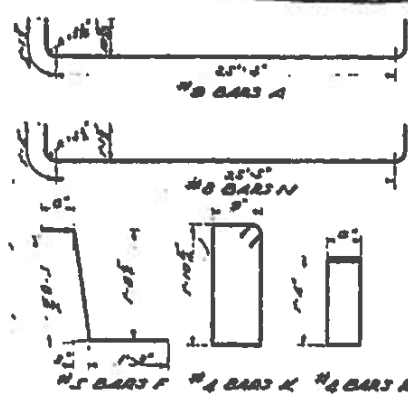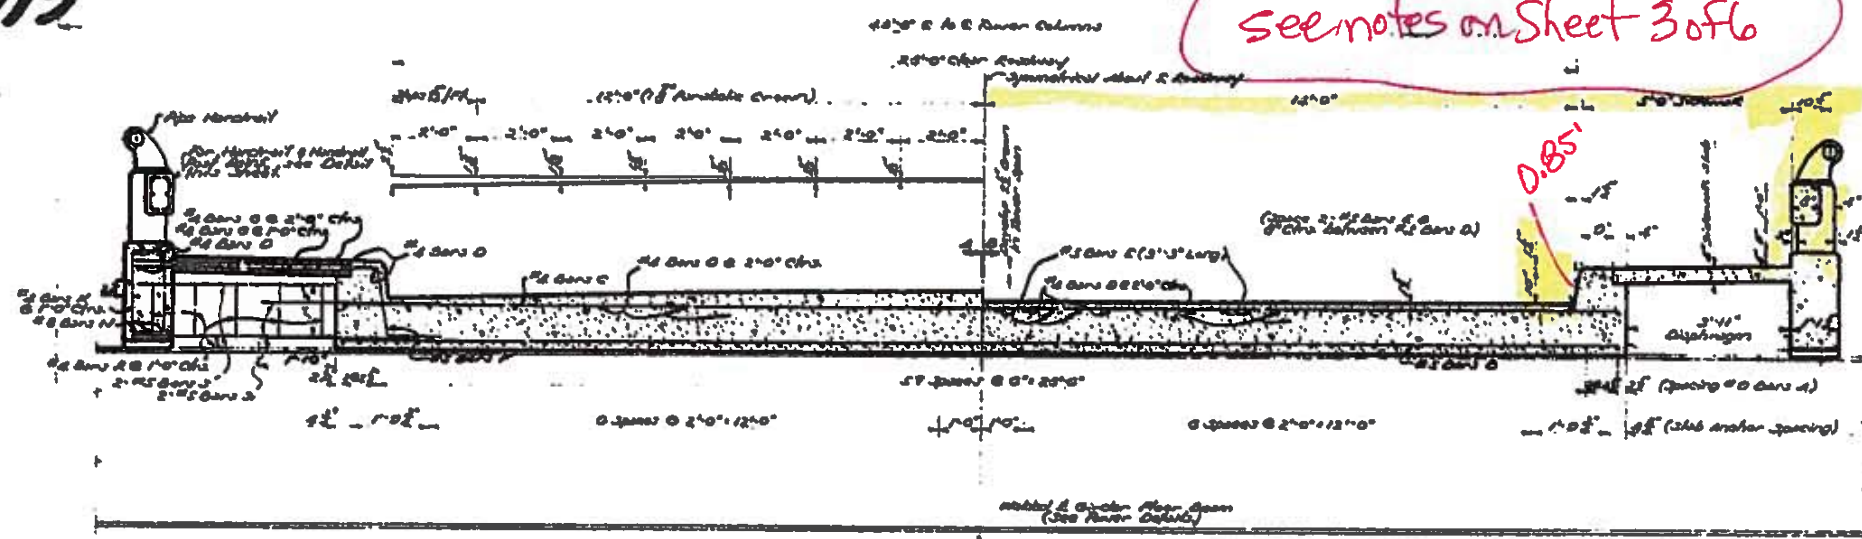

BILL OF MATERIAL (ONE SPAN)

BAR	SIZE	NO.	LENGTH	TOTAL LENGTH	LOCATION
A	#8	24	27'-3"	654'-0"	Length in 2nd beam
TOTAL NO. 8 BARS = 1084'-0" @ 28 LBS					
B	#8	8	29'-4"	235'-2"	Length in 2nd beam
TOTAL NO. 8 BARS = 1092'-0" @ 28 LBS					
C	#8	20	30'-0"	600'-0"	Perimeter of top of slab
D	#8	30	3'-3"	99'-0"	Top of slab @ center
E	#8	50	3'-0"	150'-0"	Top of slab @ center
F	#8	8	4'-10"	32'-8"	Length in 2nd beam
G	#8	8	3'-8"	30'-4"	Length in 2nd beam
TOTAL NO. 8 BARS = 1250'-0" @ 28 LBS					
H	#8	16	30'-0"	480'-0"	Perimeter of top of slab
I	#8	30	30'-2"	894'-0"	Length in slab @ 2.0M
J	#8	32	5'-2"	1664'-0"	Length in slab @ 2.0M
K	#8	50	6'-3"	3150'-0"	Length in slab @ 2.0M
L	#8	30	4'-2"	1260'-0"	Length in slab @ 2.0M
TOTAL REINFORCEMENT STEEL = 9880 LBS					
TOTAL CLASS 30 CONCRETE = 482 CU YD					
REINFORCED CARBON STEEL = 577 LBS					
CONCRETE MATERIAL = 4150 / LB YD					
PIPE MATERIAL = 45.50 / LB YD					

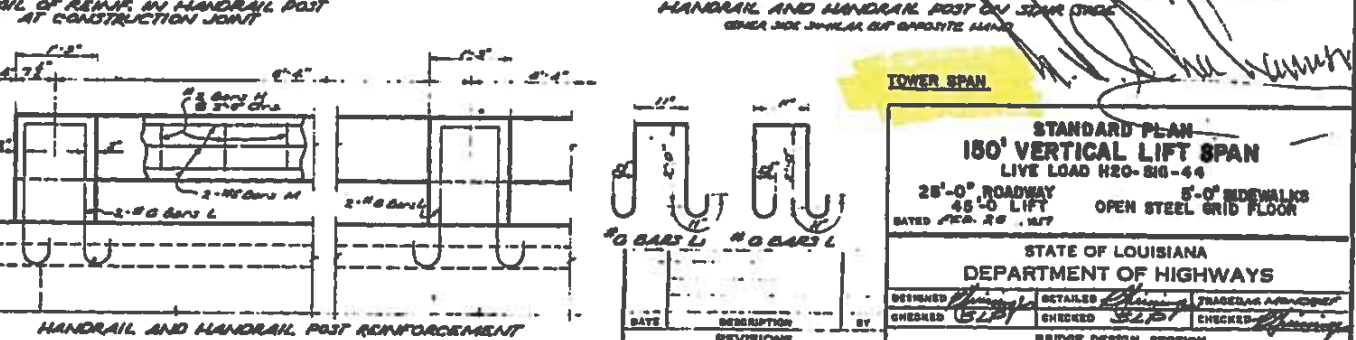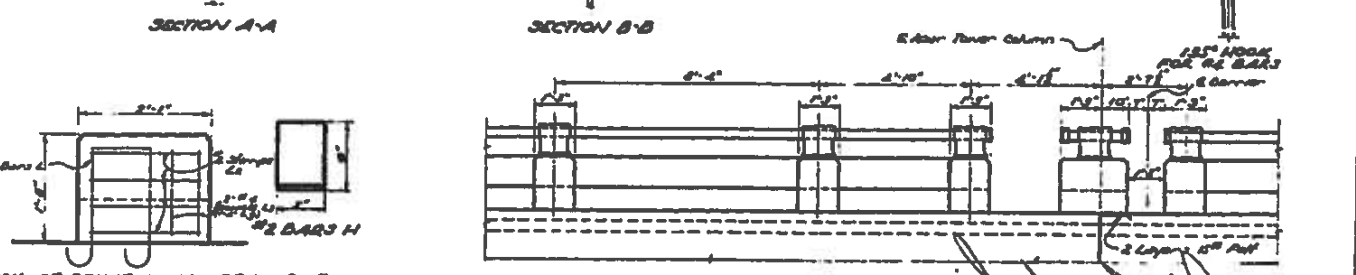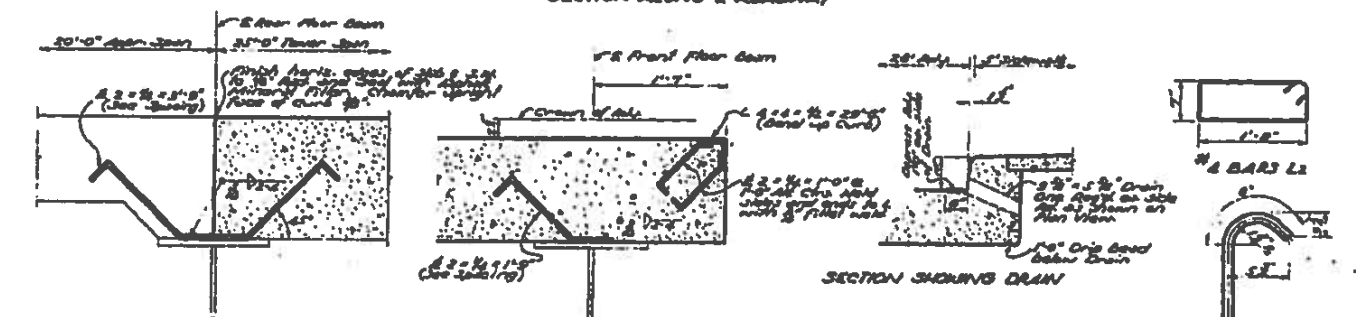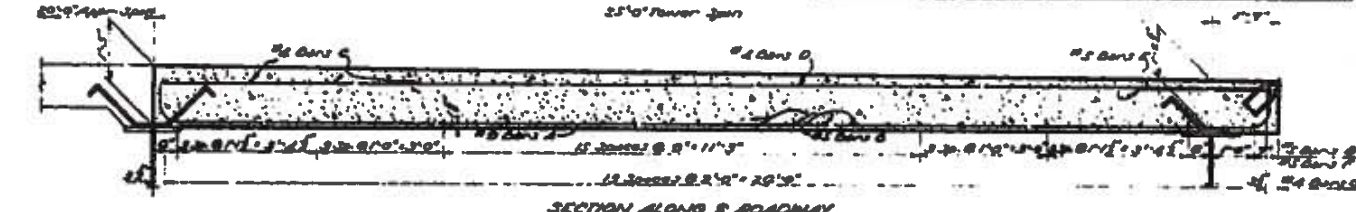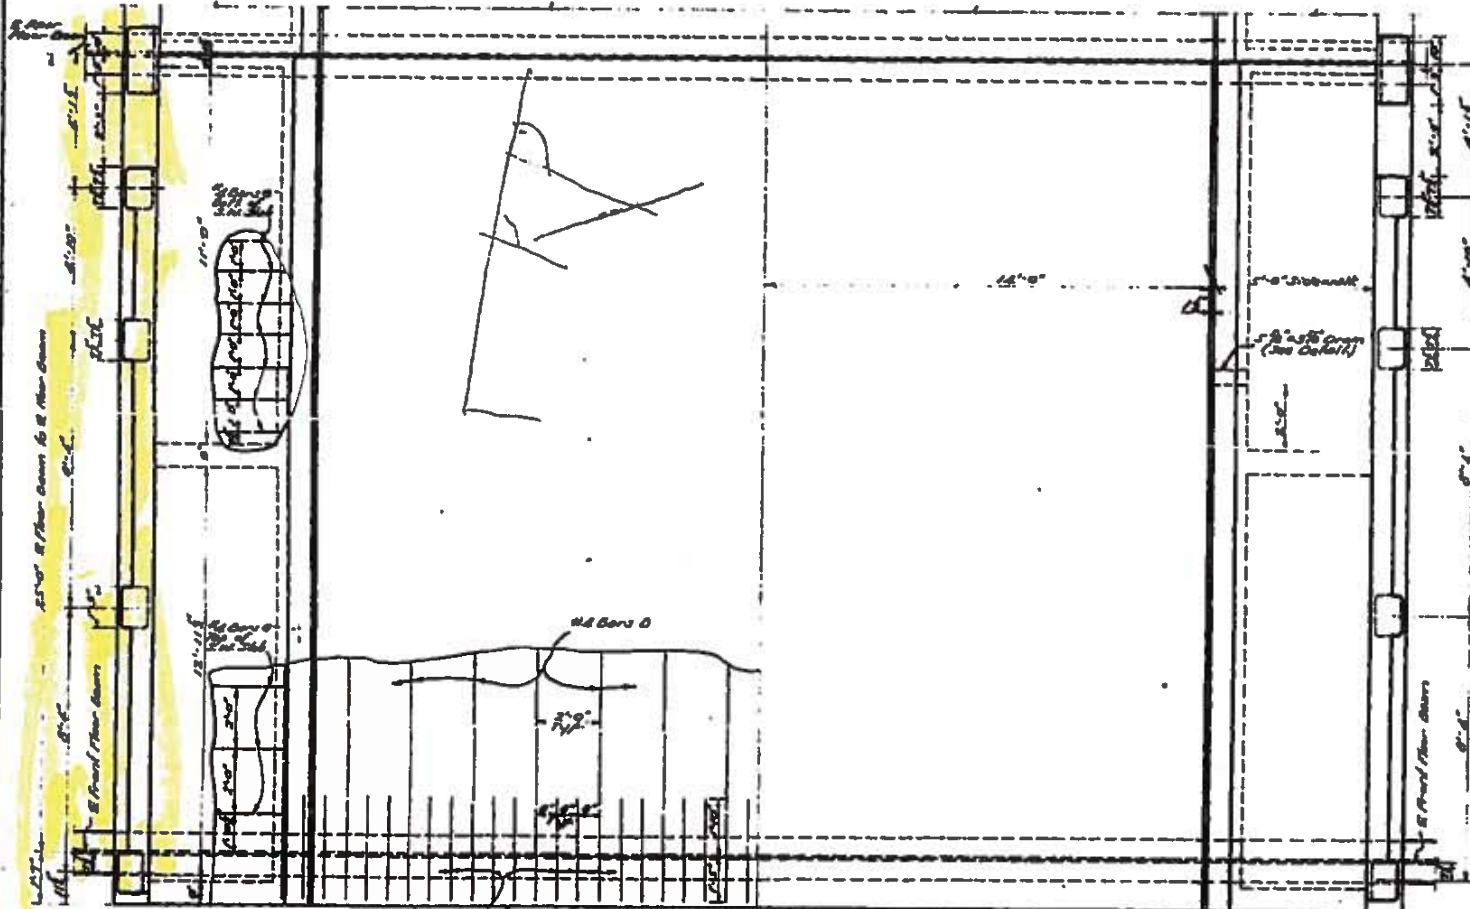

TOWER SPAN

STANDARD PLAN
150' VERTICAL LIFT SPAN
LIVE LOAD H20-S16-44


28'-0" ROADWAY
45'-0" LIFT
5'-0" SIDEWALKS
OPEN STEEL GRID FLOOR

STATE OF LOUISIANA
DEPARTMENT OF HIGHWAYS

DESIGNED	DATE	BY
CHECKED	DATE	BY

BRIDGE DESIGN SECTION

000930
Sheet 6 of 17

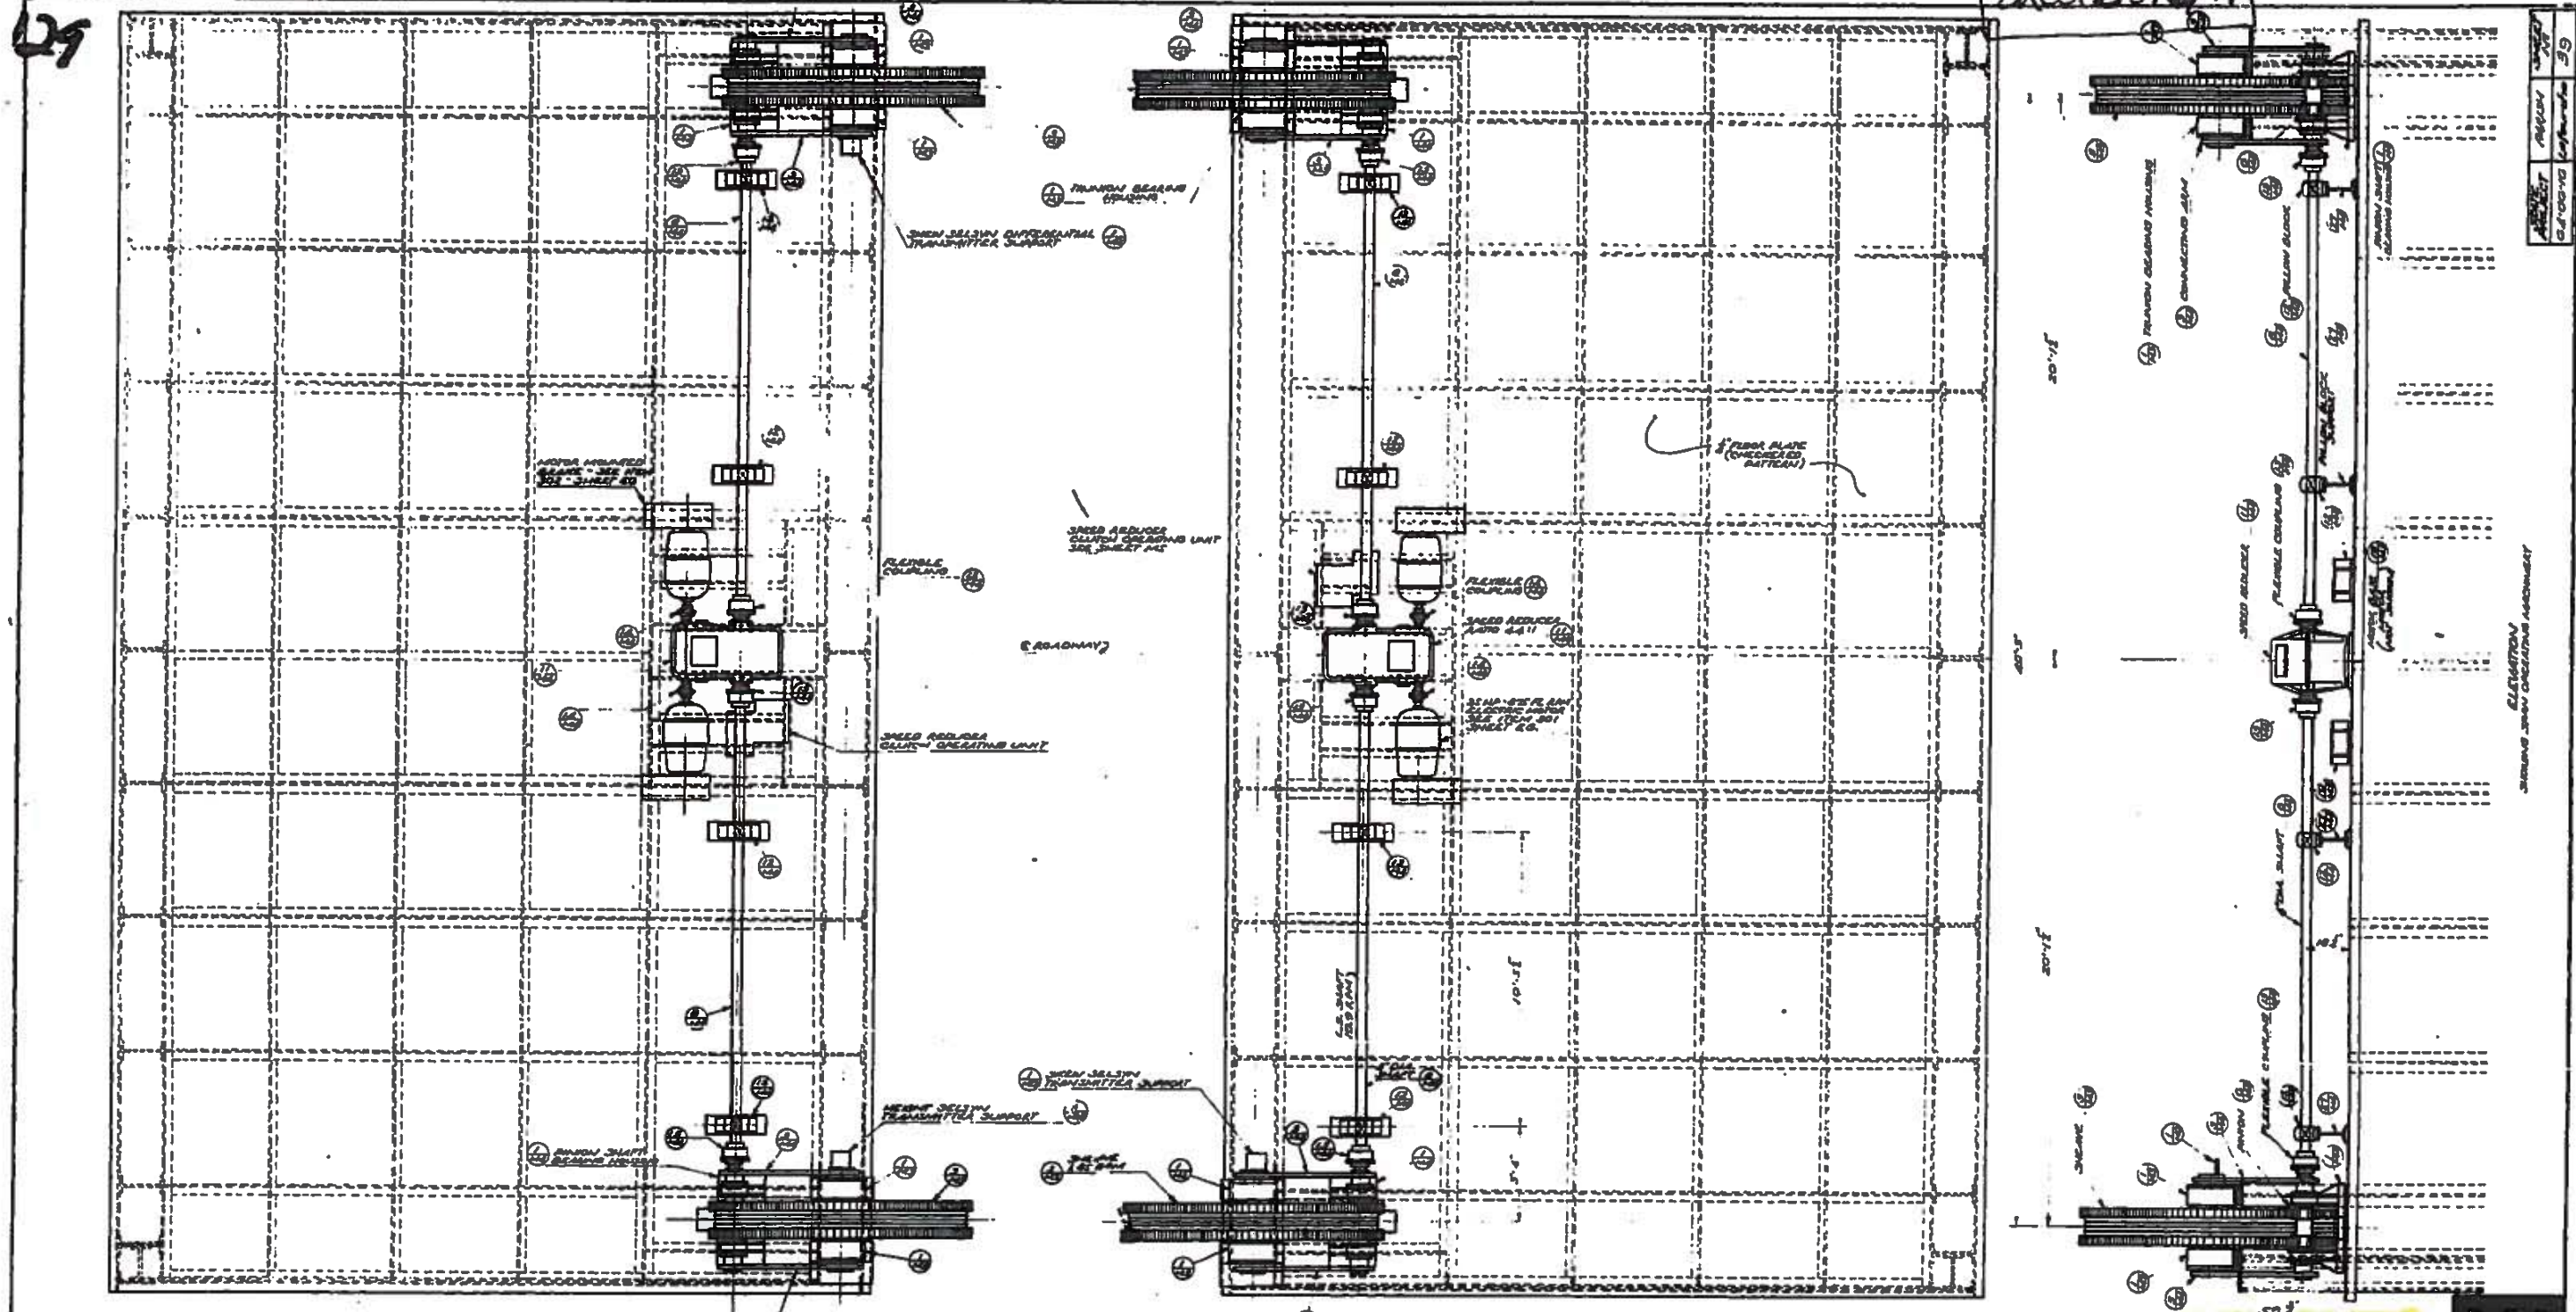

THICKNESS AND NO. OF SKINS TO BE FURNISHED

THICKNESS	NO. OF SKINS	NO. OF SKINS	NO. OF SKINS
1/2"	2	2	2
3/4"	4	2	4
1"	6	5	5

check/measure whatever you can safely get to; take photos

NOTE:
THE CONTRACTOR SHALL DETERMINE THE FINAL DIMENSIONS OF PARTS PURSUING COMMERCIAL PRODUCTS SUCH AS PULLEY, SPEED REDUCERS, GEARING, ELECTRICAL EQUIPMENT AND BE LINE FROM CERTIFIED DIMENSIONAL GUIDELINES OF THE MANUFACTURER BEFORE MAKING SHOP DRAWINGS OF THE PARTS INVOLVED.

ASSEMBLY NOTE:
ALL UNFINISHED SURFACES OF MACHINERY SHALL BE PAINTED ONE COAT OF RED LEAD AND OIL. ALL FINISHED SURFACES SHALL BE COATED WITH WHITE LEAD AND ZINC DUST BEFORE SHIPMENT AND SHALL BE INSPECTED BY MOODY L. ARBORE.

LUBRICATION NOTE:
UNLESS OTHERWISE SHOWN ON DETAIL DRAWINGS LUBRICANTS SHALL BE AS FOLLOWS OR APPROVED EQUALS:
FOLLOW GLEDES, COILINGS & ROLLING BEARINGS - 2300 FOOT GRADE "0"
EXPOSED TEETH - MEDIUM HARD OIL
ENVELOPED SPEED REDUCERS - 310 OIL TEMPS 81" VISC 346 SAE 90.
MISC OILS - STD. OIL CO. JARLITE COMPOUND #1100.

GENERAL ARRANGEMENT OF SPAN OPERATING MACHINERY


MI

STANDARD PLAN
150' VERTICAL LIFT SPAN
LIVE LOAD H20-S16-44
28'-0" ROADWAY 8'-0" SIDEWALKS
48'-0" LIFT OPEN STEEL 2ND FLOOR
DATE - APRIL 25, 1977

STATE OF LOUISIANA
DEPARTMENT OF HIGHWAYS

DESIGNED BY: [Signature] CHECKED BY: [Signature] DATE: [Signature]
BRIDGE DESIGN SECTION

000930
Sheet 7 of 17

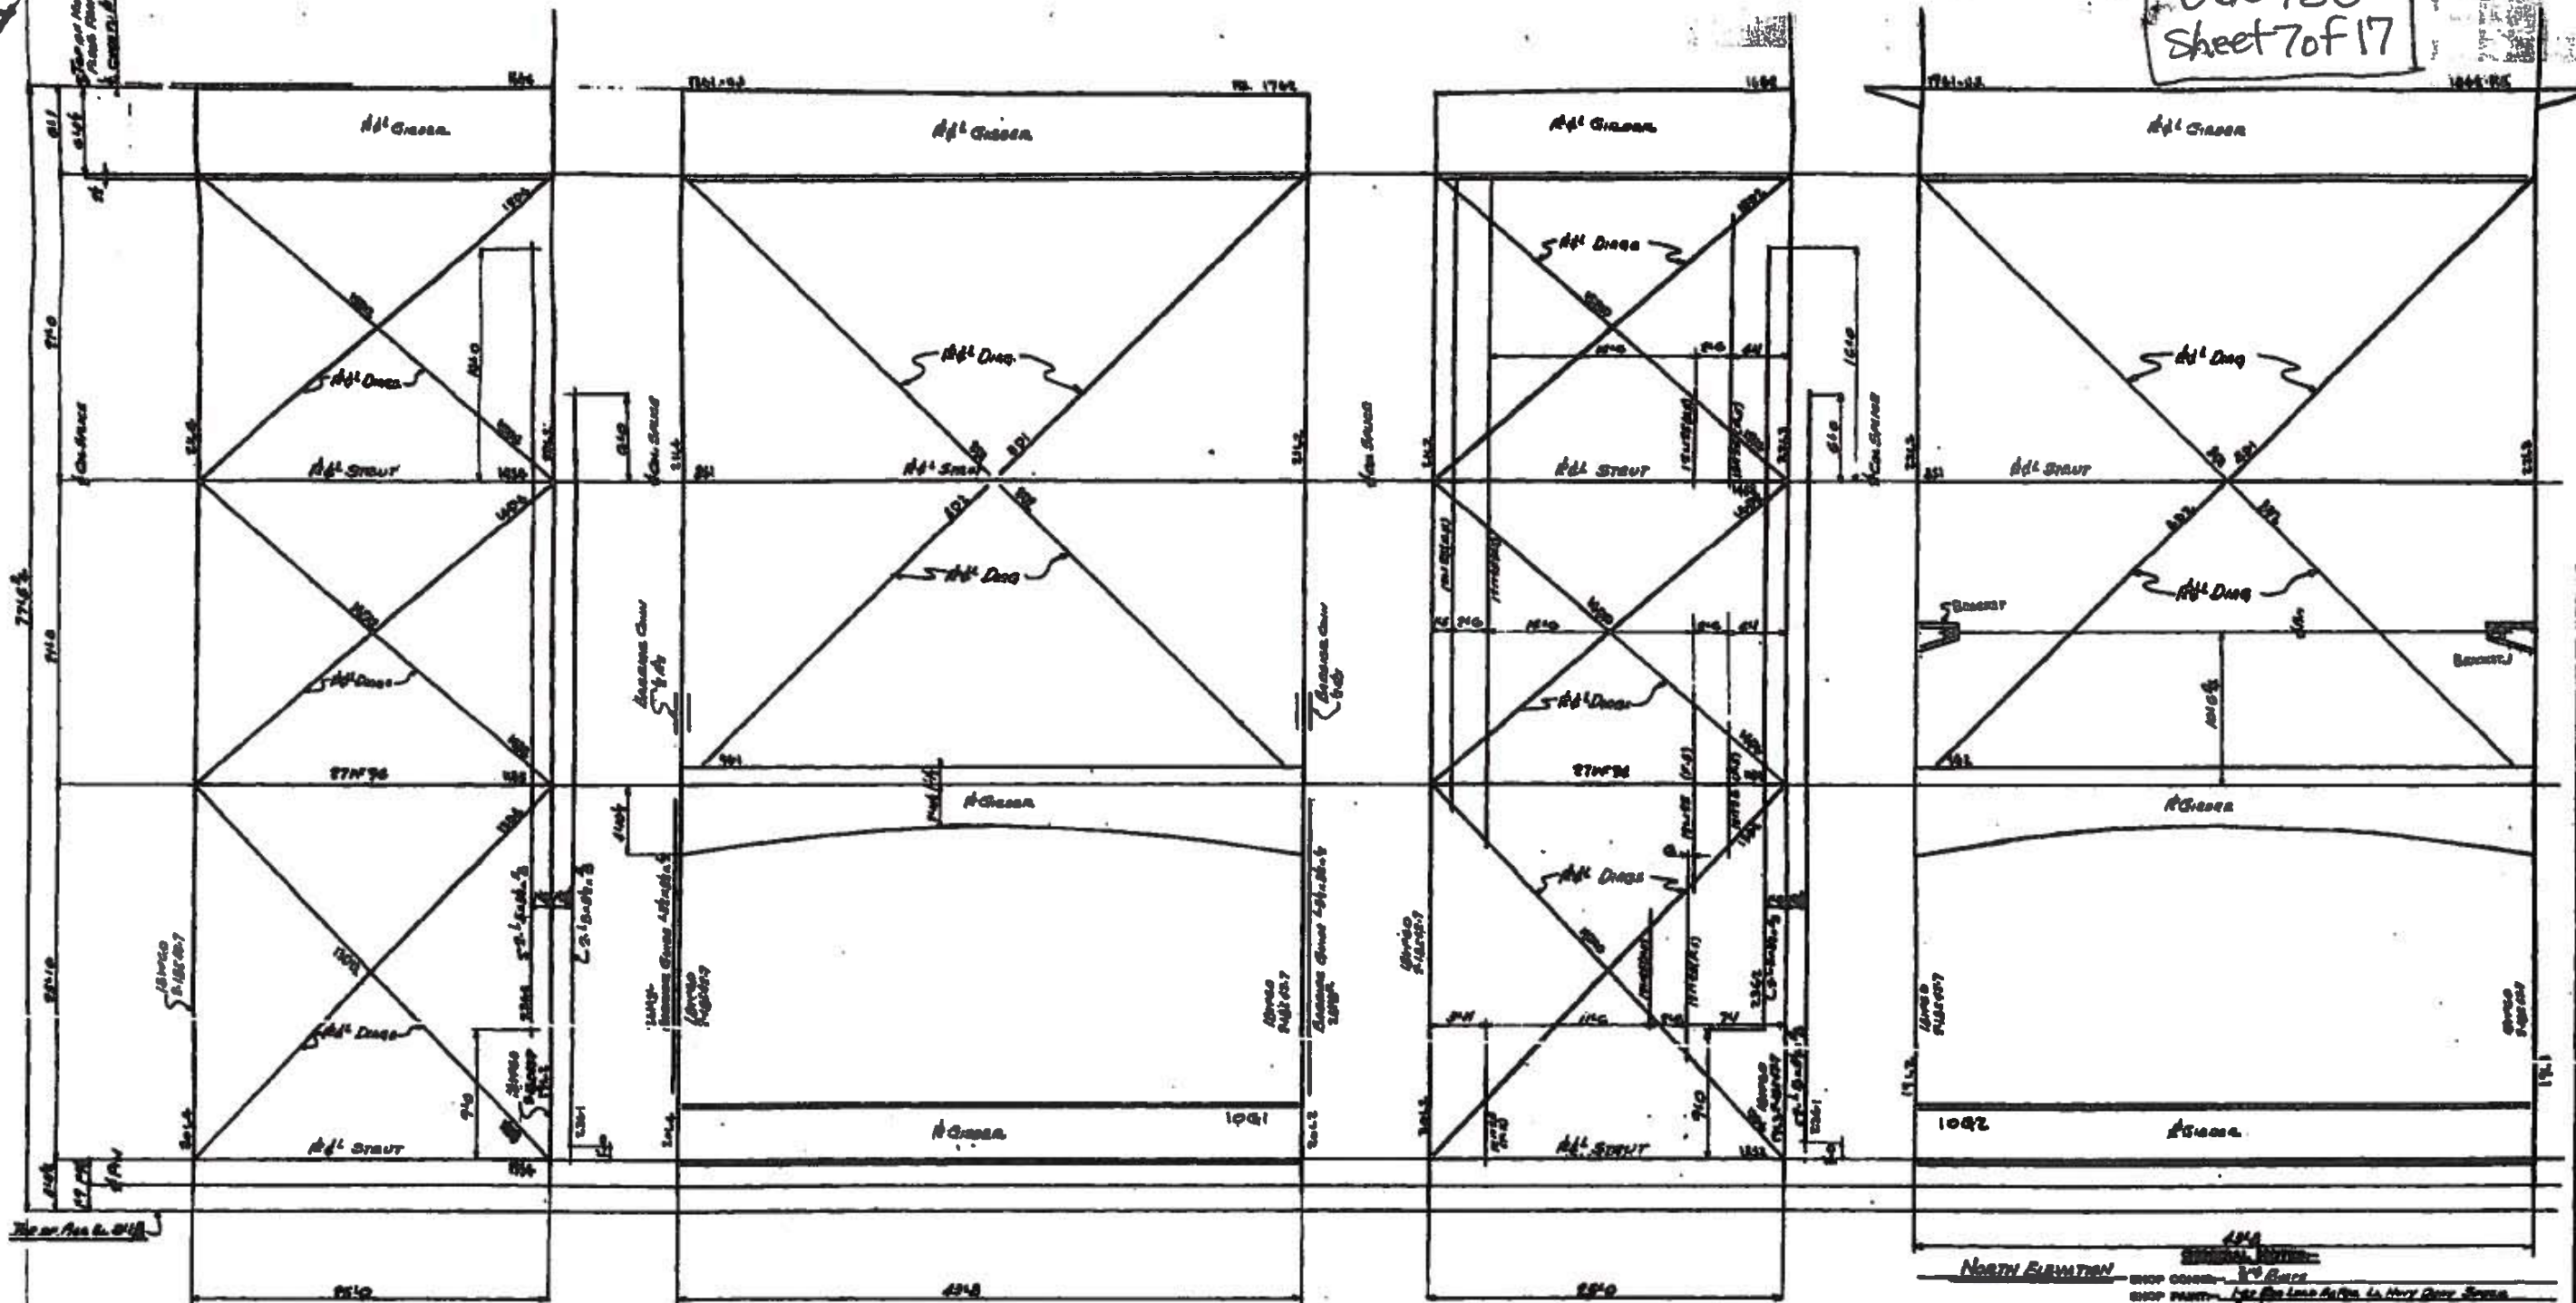

FRONT ELEVATION

SECTIONAL SOUTH ELEVATION
LOOKING SOUTH

SECTIONAL WEST ELEVATION
LOOKING WEST

NORTH ELEVATION


SOUTH TOWER ELEVATIONS

STATE OF LA. 84-2018. Act 17. Sections from 16-3-281(1)

ORLEANS MATERIALS & EQUIPMENT CO., INC.
NEW ORLEANS, LA.

PROJECT	STRUCTURE, INTERMEDIATE DECKING, BRIDGE		
NO.	740-68	740-68	5081
DATE	7-11-68	7-11-68	5/11/68
LOCATION	LAKE CHARLES BRIDGE, LAKE CHARLES, LOUISIANA		
ARCHITECT	LOUISIANA BRIDGE ENGINEERS		
CONTRACTOR	ANDRE BASSO CO.		
DETAIL OF	SECTIONAL ELEVATIONS - TOWER LEGS		
SCALE	AS SHOWN		
DESIGNED BY	[Signature]		
CHECKED BY	[Signature]		

000930
Sheet 8 of 17

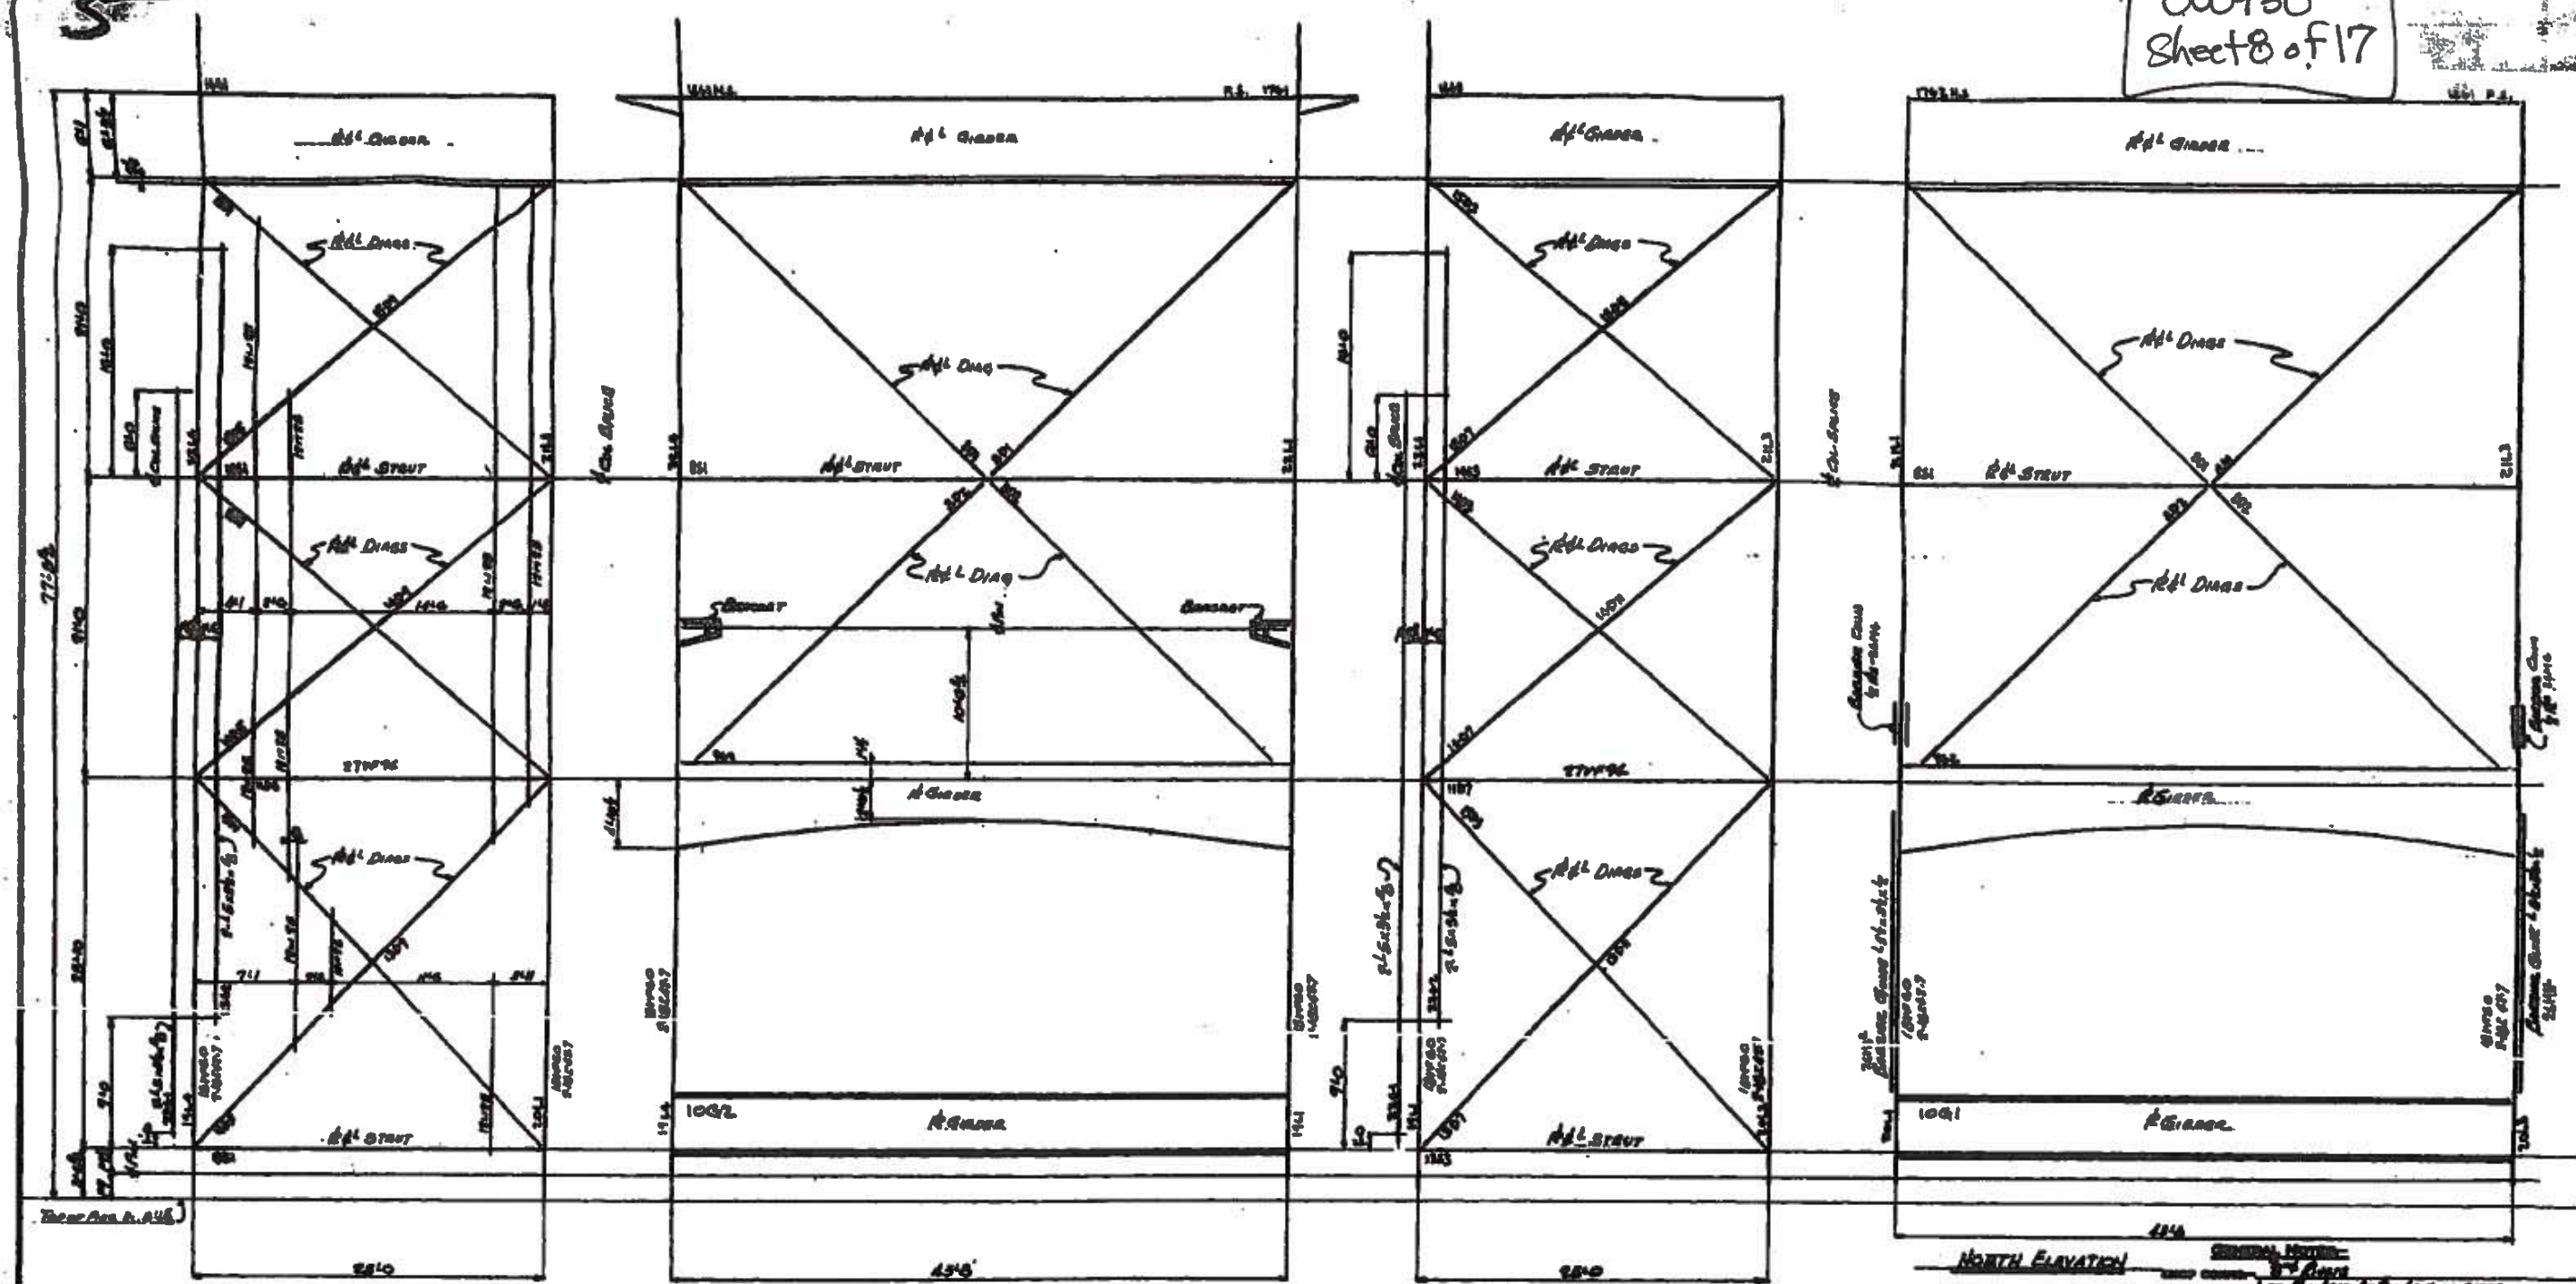

EAST ELEVATION

SECTIONAL SOUTH ELEVATION
Looking South

SECTIONAL WEST ELEVATION
Looking West

NORTH ELEVATION

NORTH TOWER ELEVATIONS

GENERAL NOTES:
 SHOP DRAWINGS - See the shop drawings for details.
 FIELD WORK - See the field notes for details.
 ALL work to be fabricated at the shop.
 STATE PROJ. No. 98-08-18 Add'l Section (Sheet No. 8-1170)

ORLEANS MATERIALS & EQUIPMENT CO. INC.
 NEW ORLEANS, LA.





NO.	DATE	DESCRIPTION
1	7-10-88	3081
2	8-1-88	578

No Vehicle Hits

000930
Sheet 9 of 17

DESIGNED BY	APPROVED BY	SHEET NO.
C. P. GUY	Lafayette	29

118

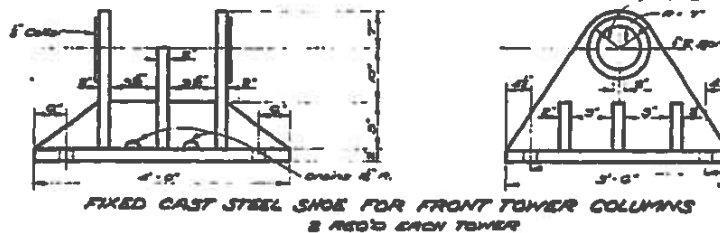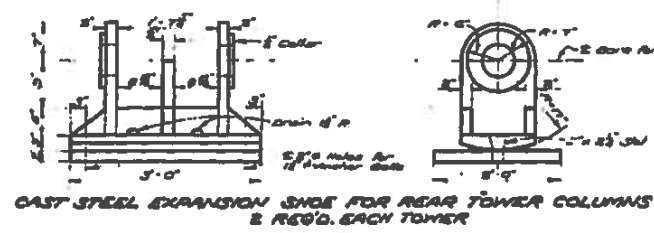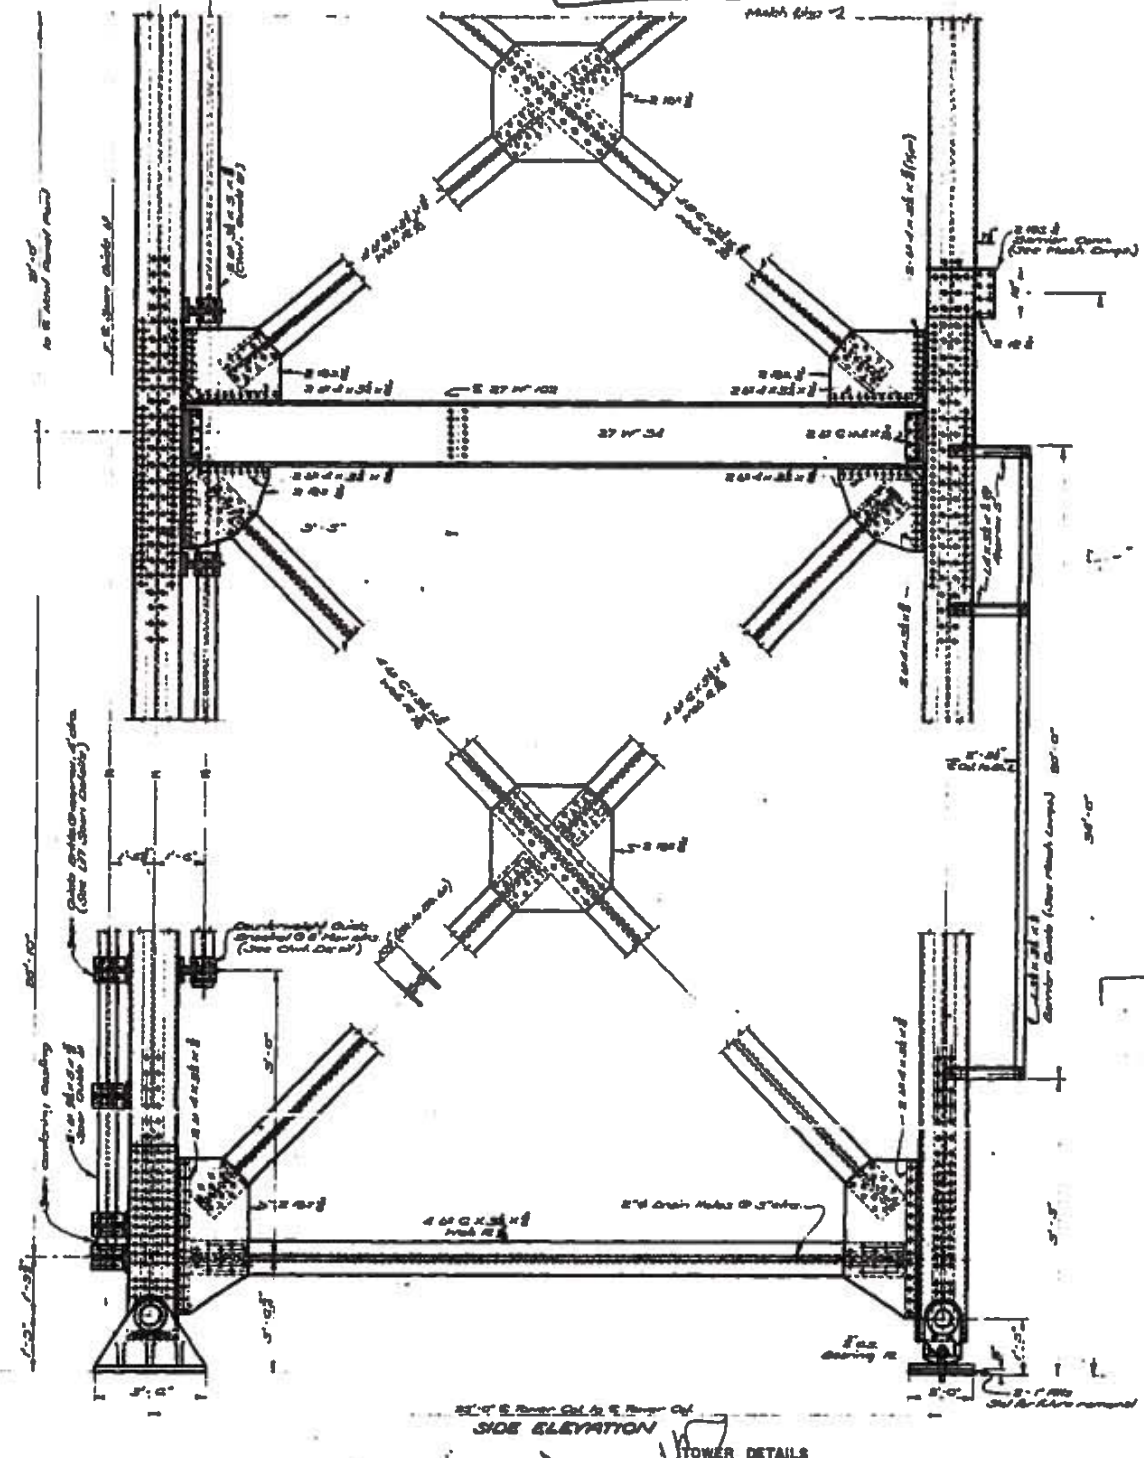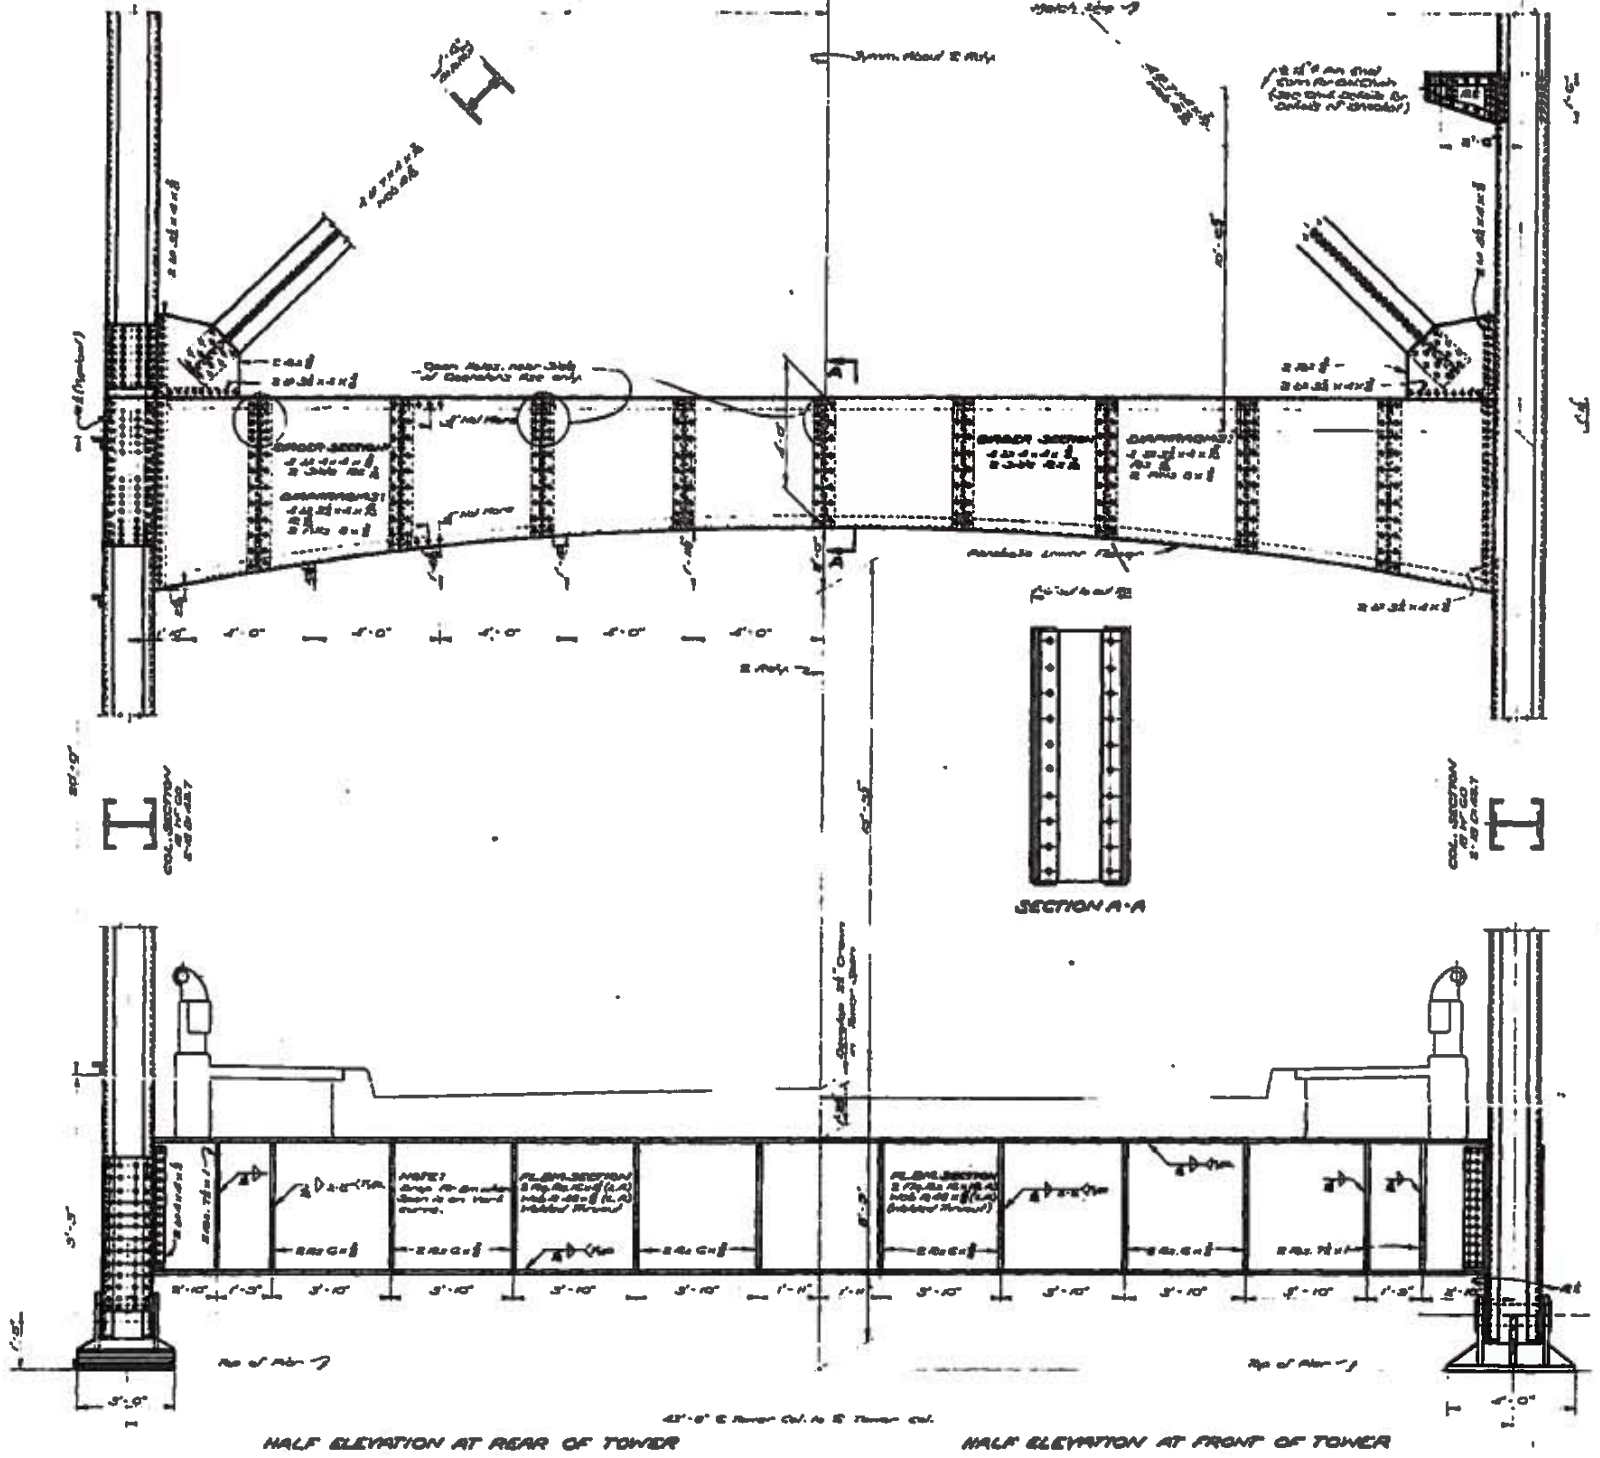

SURFACE FINISHES:
 All steel surfaces to have A.S.A. No. 16
 Anchor bolts and parts in contact with
 concrete to have A.S.A. No. 16
 Base of columns and bearing plates to
 have A.S.A. No. 16

[Handwritten signature]

DATE	DESCRIPTION	BY

TOWER DETAILS

STANDARD PLAN
150' VERTICAL LIFT SPAN
 LIVE LOAD H20-S16-44
 28'-0" ROADWAY
 48'-0" LIFT
 5'-0" SIDEWALKS
 OPEN STEEL GRID FLOOR

DATE: APRIL 22, 1957

STATE OF LOUISIANA
 DEPARTMENT OF HIGHWAYS



DESIGNED BY	DETAILED BY	TRACED BY
C. P. GUY	S. L. P.	S. L. P.
CHECKED BY	CHECKED BY	CHECKED BY
S. L. P.	S. L. P.	S. L. P.

SKETCH DESIGN SECTION

119

000930
Sheet 10 of 17


DATE	BY	CHKD	APP'D
12-1-66	W. J.

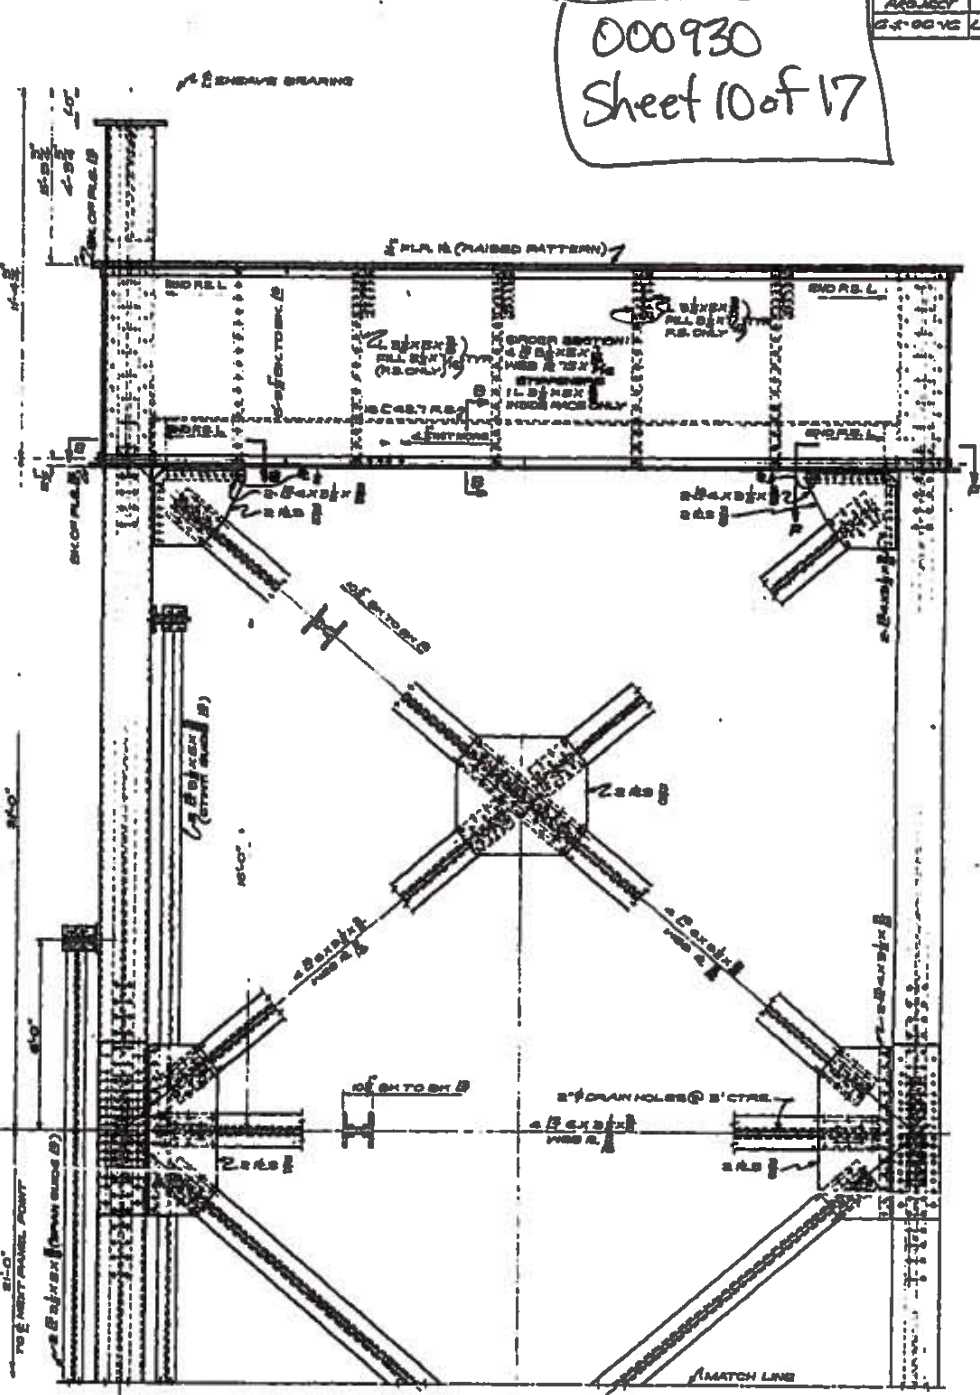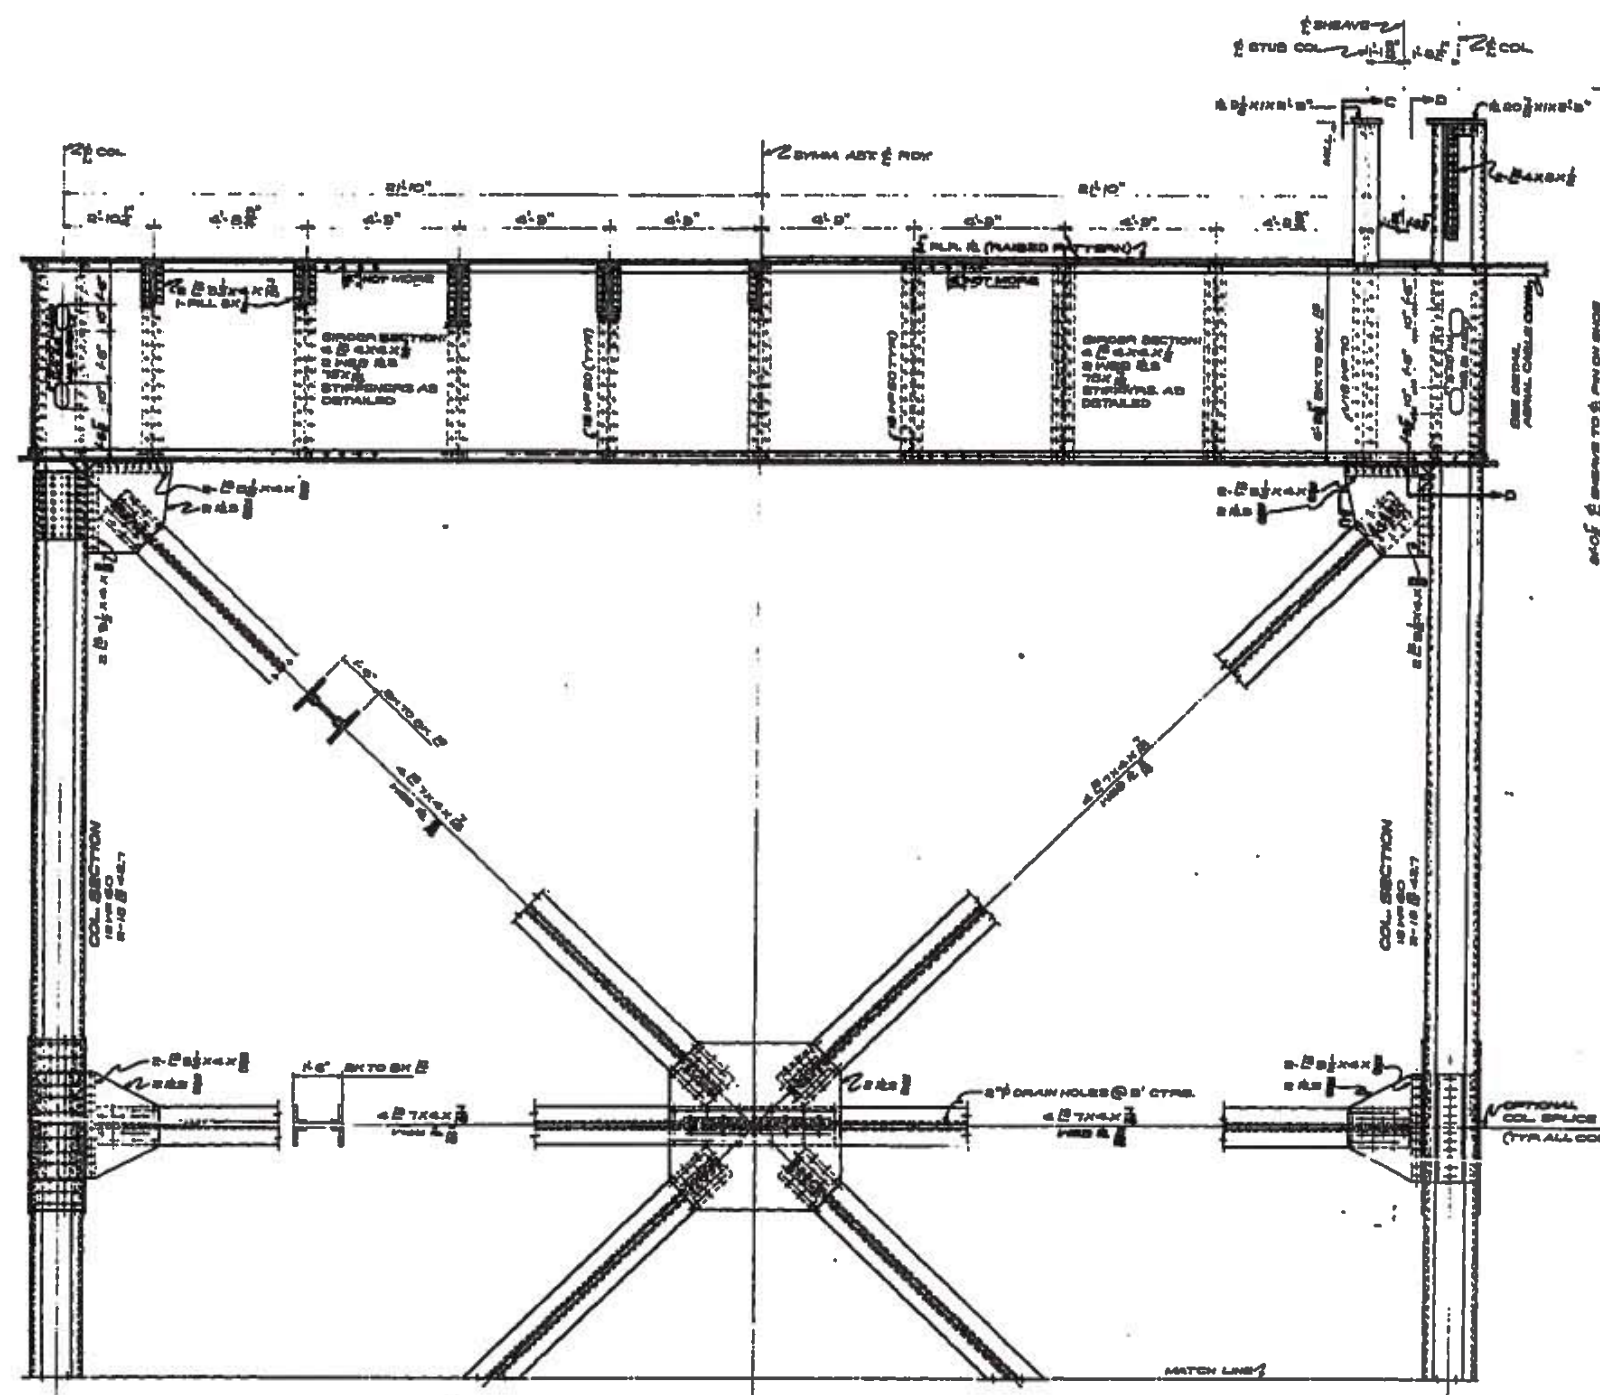

HALF ELEVATION AT REAR OF TOWER

HALF ELEVATION AT FRONT OF TOWER

SIDE ELEVATION

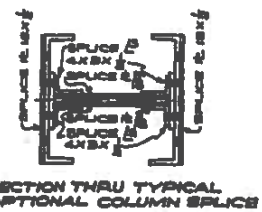

NOTE: SEE SHEET N° 7 OF 26 FOR SECTION B-B, C-C, D-D, E-E AND F-F

TOWER DETAILS

STANDARD PLAN
 160' VERTICAL LIFT SPAN
 LIVE LOAD H20-S16-44
 28'-0" ROADWAY 8'-0" SIDEWALKS
 48'-0" LIFT OPEN STEEL GRID FLOOR


DATE: APRIL 68
 STATE OF LOUISIANA
 DEPARTMENT OF HIGHWAYS
 BRIDGE DESIGN SECTION

121


DESIGNED	BY	DATE
TRACED	BY	DATE
CHECKED	BY	DATE
APPROVED	BY	DATE

000930
Sheet 11 of 17


NOTES FOR STAIRWAYS & LANDINGS:
 Provide all stairways, landings and stairs with 12 gage galvanized steel plate tread and 12 gage galvanized steel plate riser. All stairs shall be constructed in accordance with the provisions of the Louisiana Building Code, 1975 Edition, Chapter 10, Section 1005. All stairs shall be constructed with 2" x 4" stringers and 2" x 4" nosing. All stairs shall be constructed with 2" x 4" stringers and 2" x 4" nosing. All stairs shall be constructed with 2" x 4" stringers and 2" x 4" nosing.

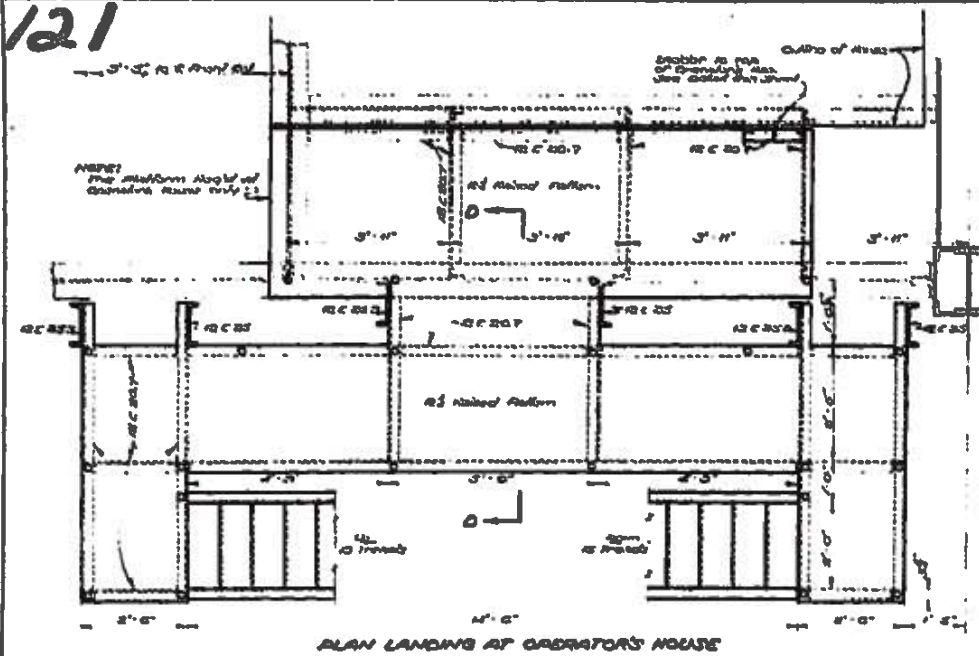


PLAN LANDING AT OPERATOR'S HOUSE

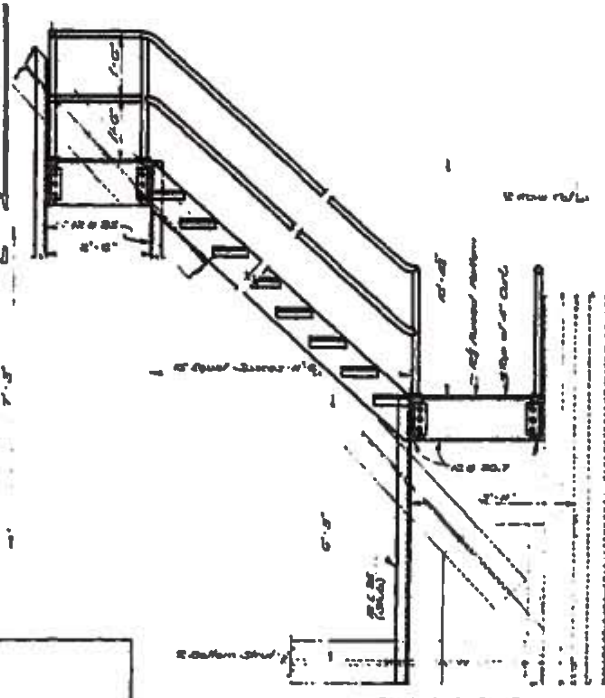


SECTION B-B

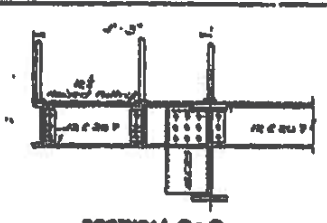


SECTION D-D

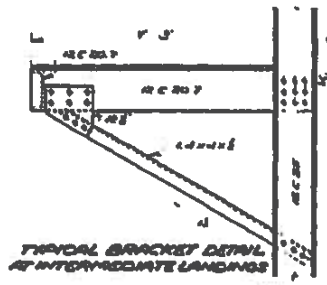

TYPICAL BRACKET DETAIL AT INTERMEDIATE LANDINGS

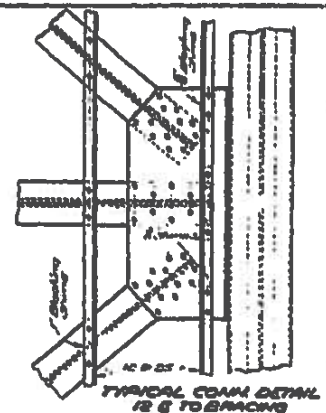


TYPICAL CORNER DETAIL IS TO BRACKING

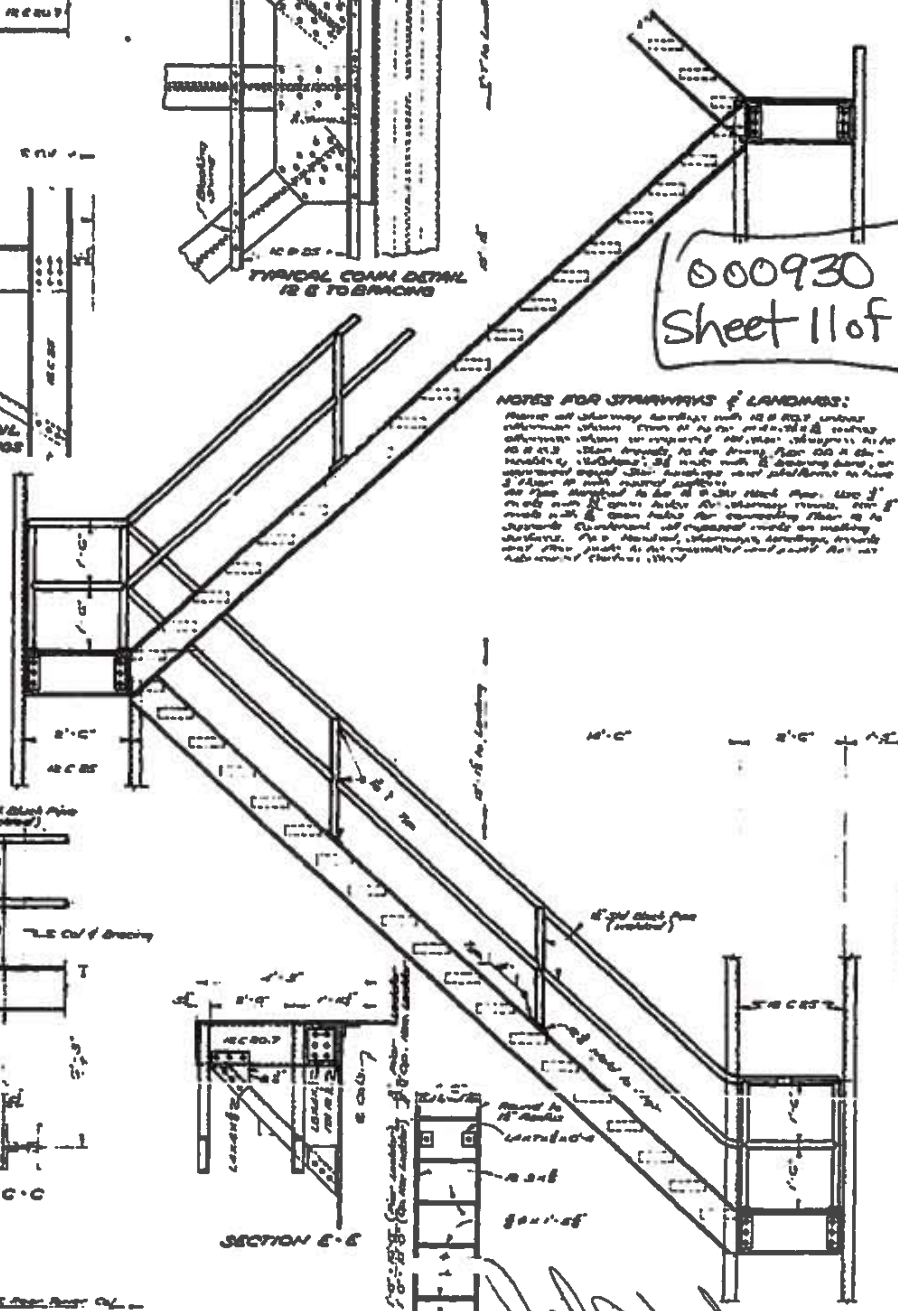


SECTION E-E


TOWER STAIRWAY DETAILS

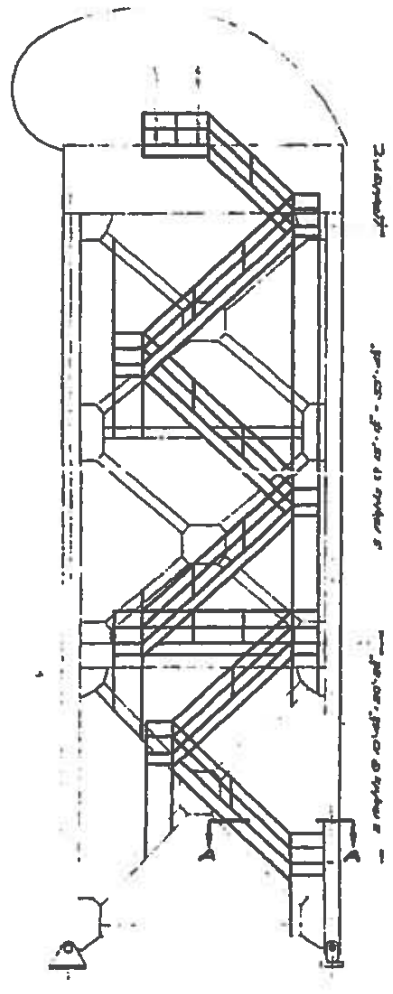


SIDE ELEVATION

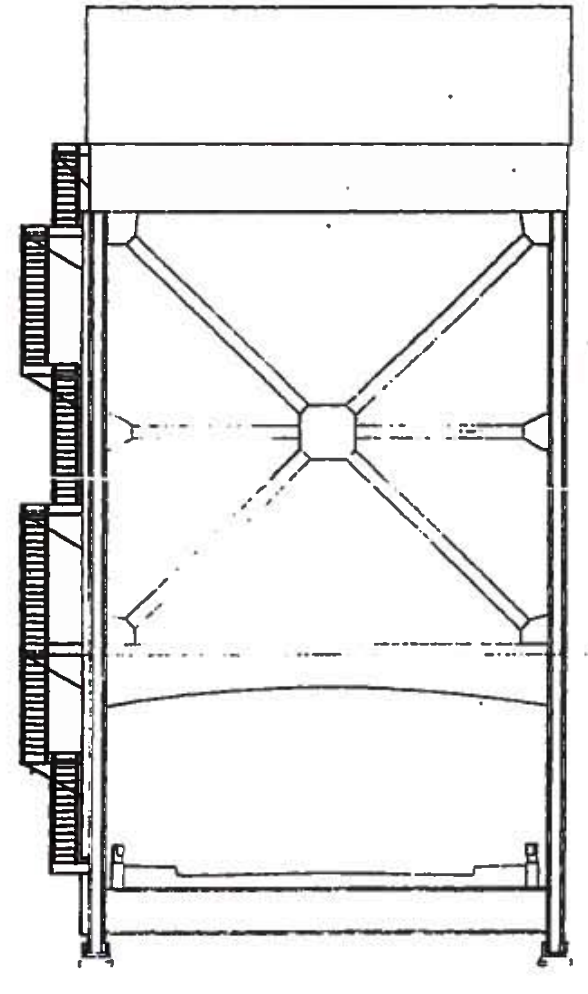


REAR ELEVATION

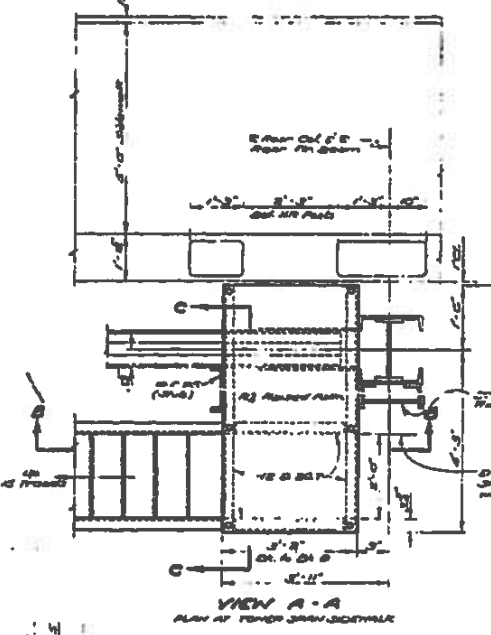


VIEW A-A
PLAN AT TREAD SPACING

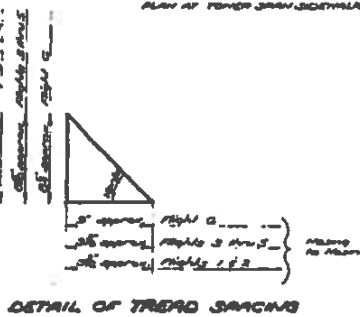


DETAIL OF TREAD SPACING

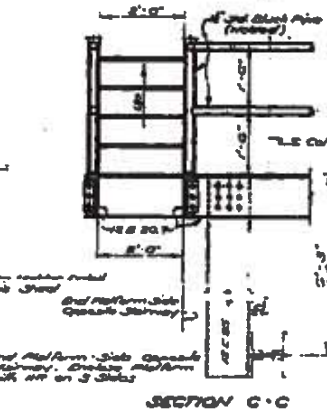

SECTION C-C

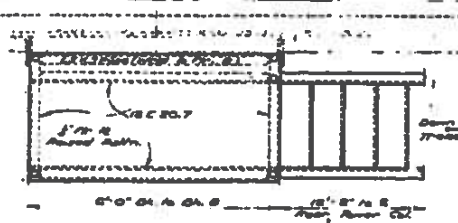

PLAN LANDING AT TRUCK HOUSE

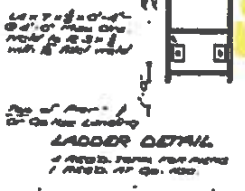


LADDER DETAIL

STANDARD PLAN 180' VERTICAL LIFT SPAN LIVE LOAD H20-S16-44		
28'-0" ROADWAY	6'-0" SIDEWALKS	OPEN STEEL GRID FLOOR
STATE OF LOUISIANA DEPARTMENT OF HIGHWAYS		
DESIGNED	TRACED	DATE
CHECKED	ENTERED	DATE
BRIDGE DESIGN SECTION		


126

000930
Sheet 14 of 17

DATE	BY	CHKD
04-00-15	Lafayette	36

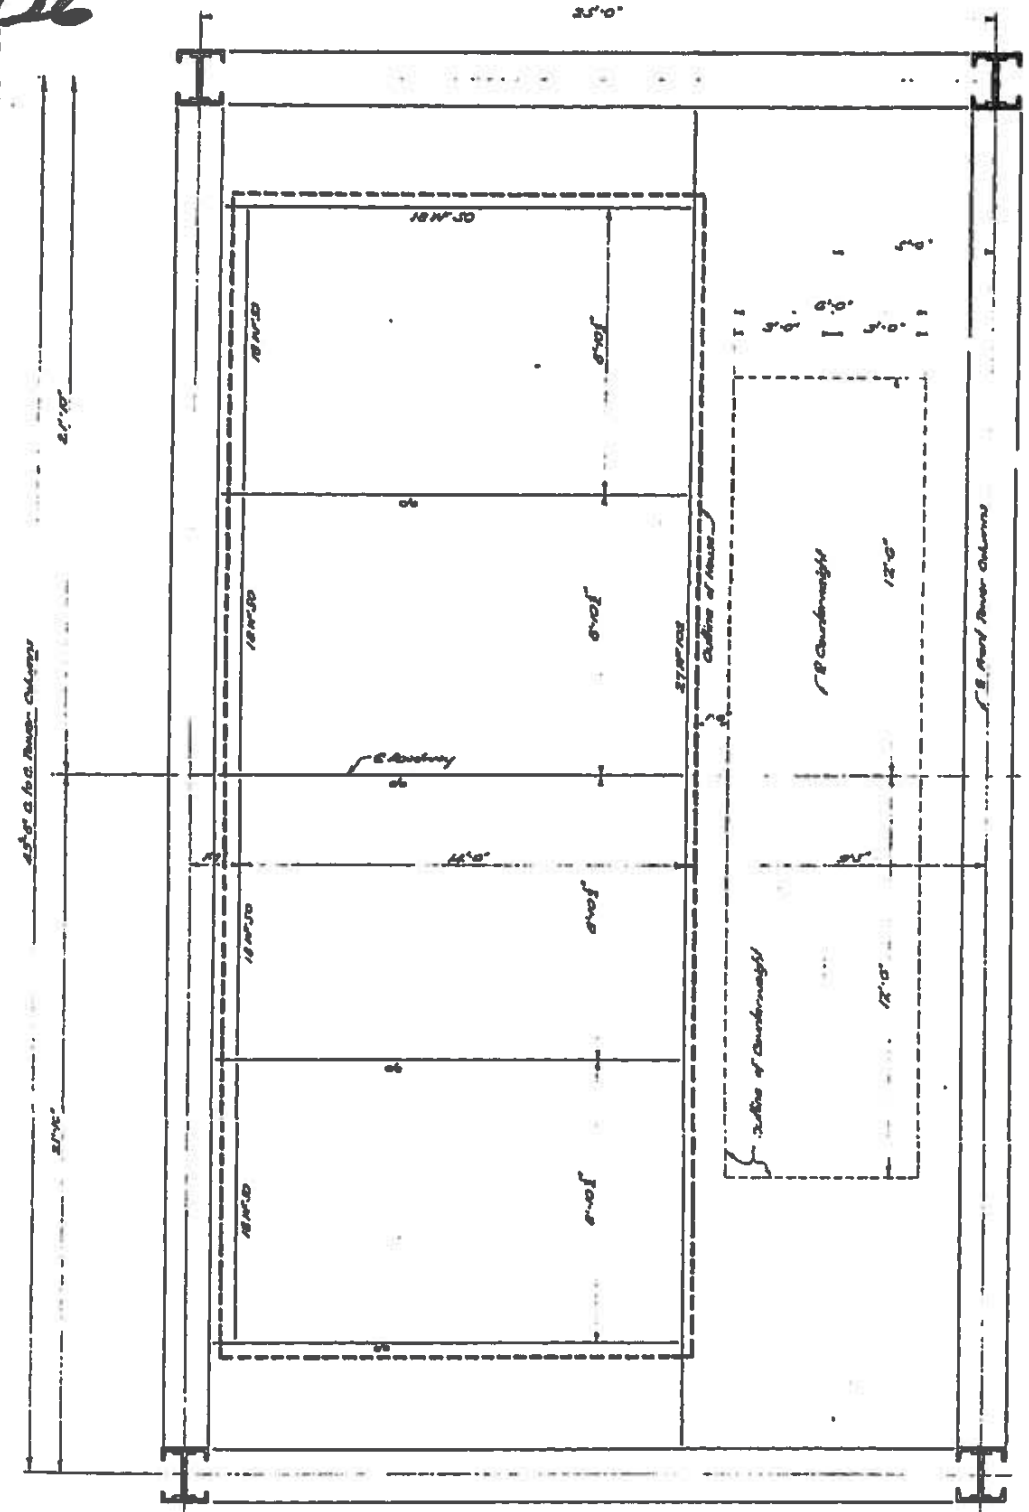


PLAN
SHOWING GRID LOCATION AND STRUCTURAL STEEL LOCATION
SCALE: 1/4" = 1'-0"

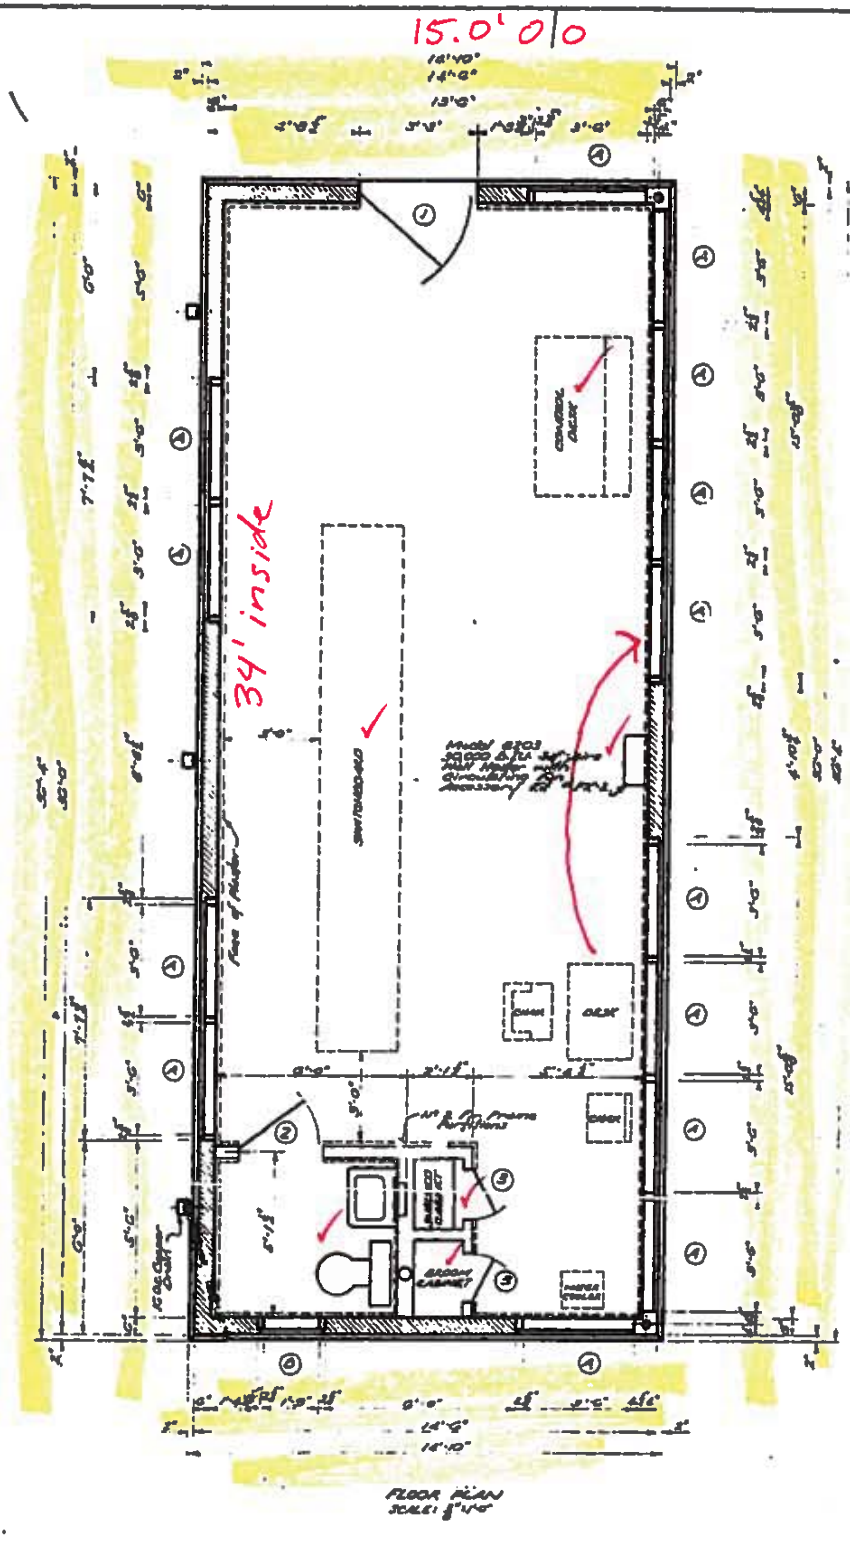


FLOOR PLAN
SCALE: 1/4" = 1'-0"

NOTE:
All Aluminum surfaces to be placed in contact with, or fastened to, steel members shall be thoroughly coated with an approved aluminum impregnated caulking compound. All Aluminum surfaces to be placed in contact with concrete shall be given a heavy coat of an approved alkali resistant bituminous paint, or a coat of zinc chromate paint, and allowed to dry before placing on the concrete.

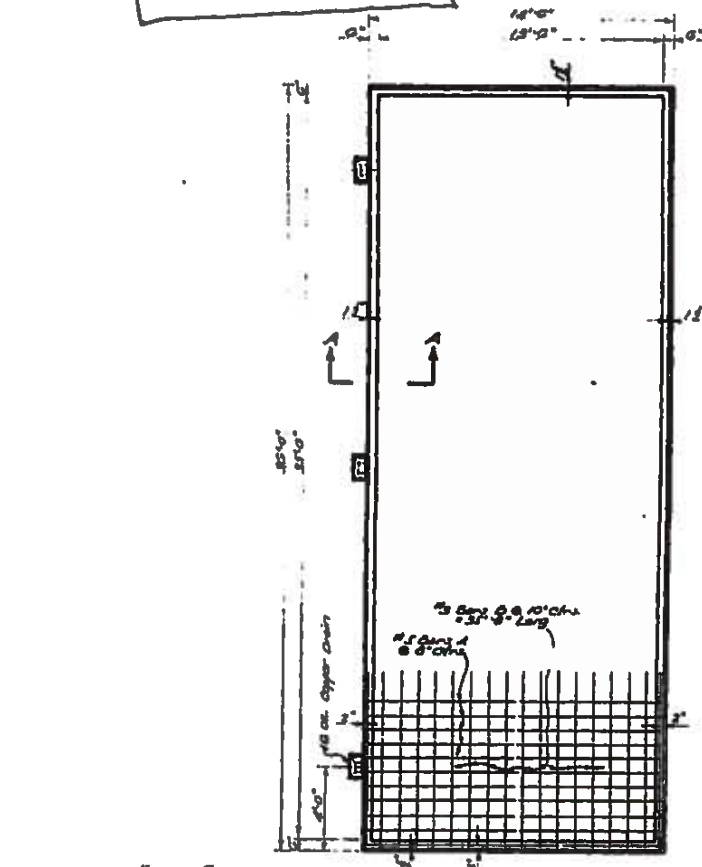

ROOF PLAN
SCALE: 1/4" = 1'-0"

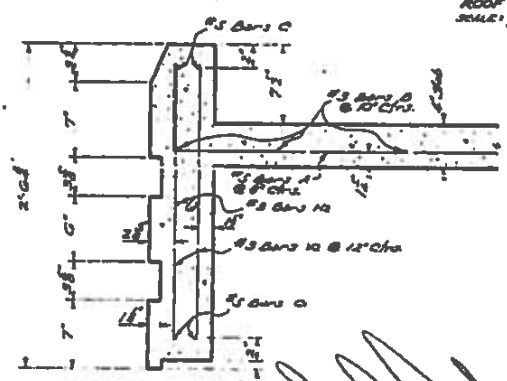

SECTION A-A
SCALE: 1/4" = 1'-0"

[Handwritten Signature]

MARK	SIZE	TYPE	STYLE	REMARKS
1	5'-6" x 7'-0" x 1 1/2"	Sliding	4 1/2" Glass	Aluminum Frame
2	2'-0" x 6'-6" x 1 1/2"	Flush	Steel	Steel Metal Frame
3	7'-0" x 6'-6" x 1 1/2"	Flush	Steel	Steel Metal Frame
4	5'-6" x 5'-6" x 1 1/2"	Sliding	8 1/2" Glass	Aluminum Frame CBS-12
5	1'-6" x 2'-2" x 1 1/2"	Sliding	8 1/2" Glass	Aluminum Frame CBS-12

ITEM	WALLS		CEILING	FLOOR	BASE	TRIM	ROOF	MEMBER
	OUTSIDE	INSIDE						
Walls	Adobe	1/2" x Master	Master	Tile	Tile	Master	Br & Concrete	As above
Tile	-	1/2" x Master	Master	Tile	Tile	Master	-	As above
Cabinets	Master	1/2" x Master	Master	Tile	-	Master	-	-

OPERATING HOUSE

STANDARD PLAN
150' VERTICAL LIFT SPAN
LIVE LOAD H20-S16-44
28'-0" ROADWAY 5'-0" SIDEWALKS
45'-0" LIFT OPEN STEEL GRID FLOOR

DATED July 13 1957

STATE OF LOUISIANA
DEPARTMENT OF HIGHWAYS


DESIGNED BY: [Signature] CHECKED BY: [Signature]
DRAWN BY: [Signature] TRACED BY: [Signature]

BRIDGE DESIGN SECTION


127

SCALE 1/8" = 1'-0" SHEET 37


000930
Sheet 15 of 17

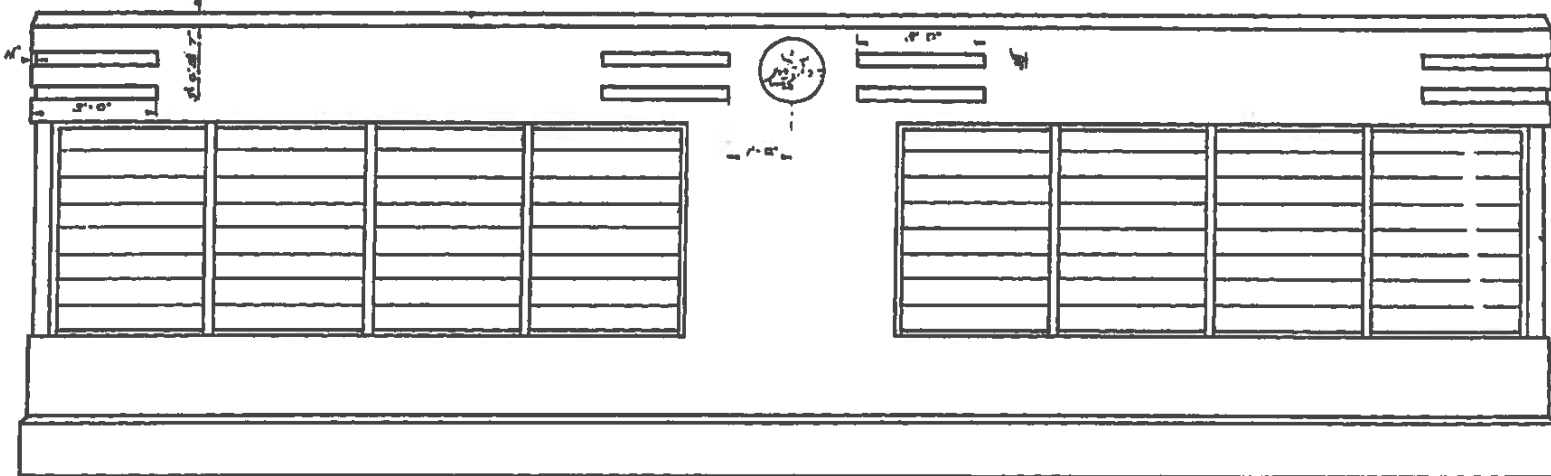


FRONT ELEVATION
SCALE: 1/8" = 1'-0"

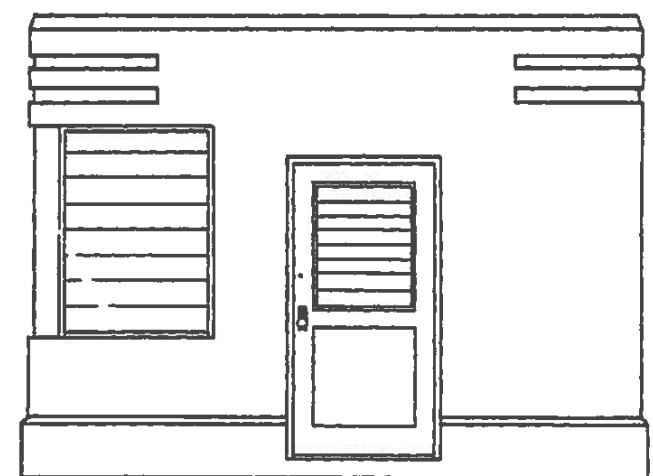


SIDE ELEVATION
SCALE: 1/8" = 1'-0"

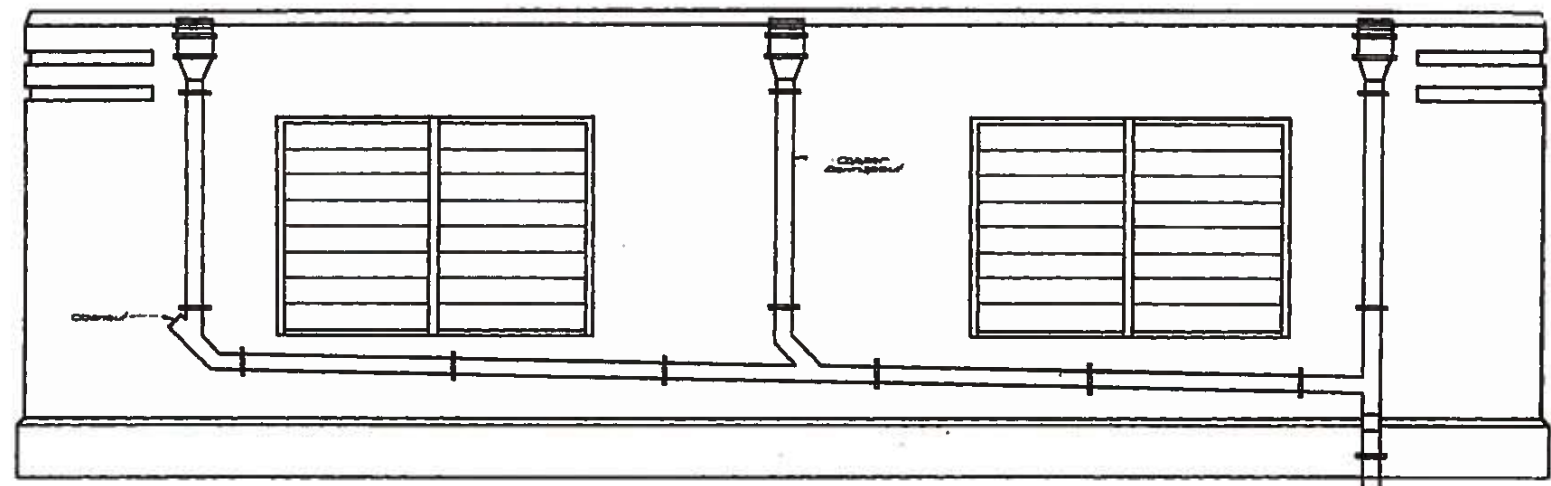

REAR ELEVATION
SCALE: 1/8" = 1'-0"

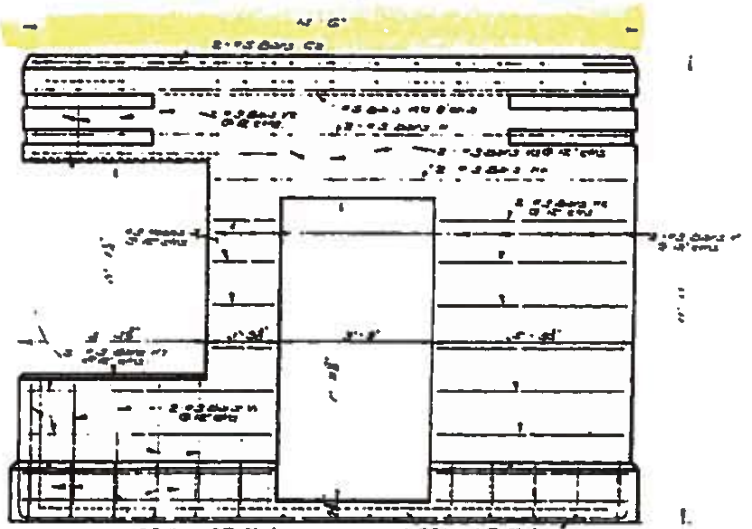


SIDE ELEVATION
SCALE: 1/8" = 1'-0"

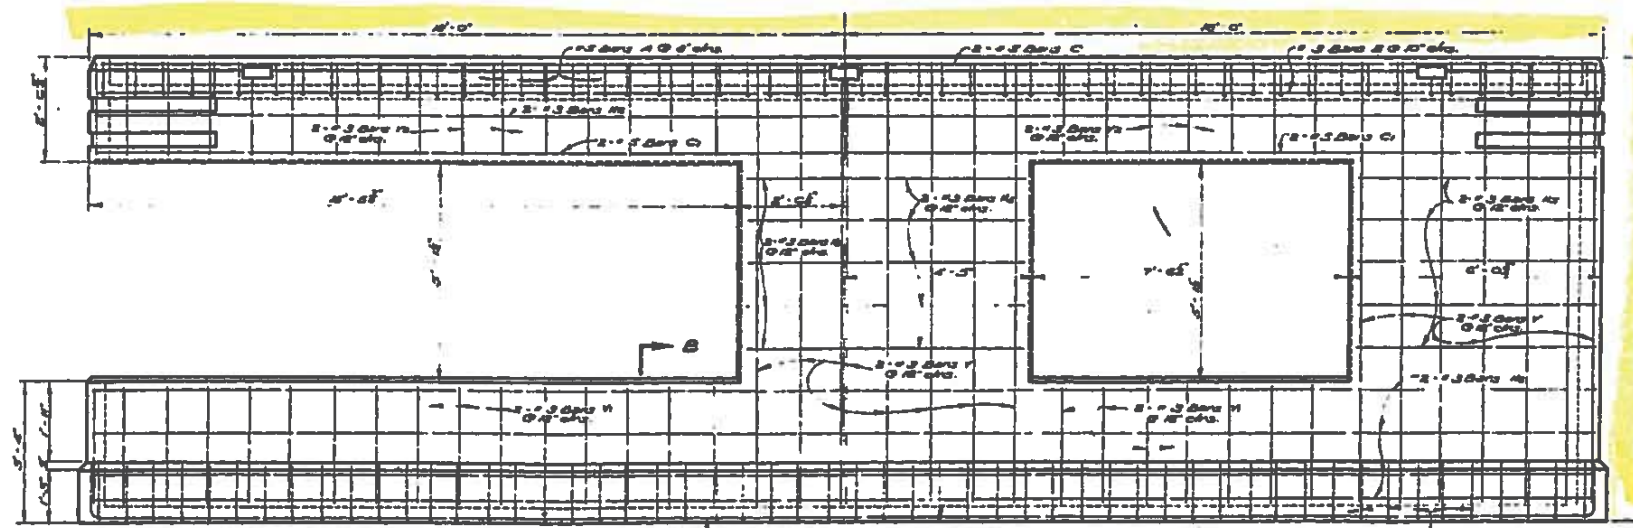


HALF FRONT ELEVATION
SHOWING REINFORCING
SCALE: 1/8" = 1'-0"

HALF REAR ELEVATION
SHOWING REINFORCING
SCALE: 1/8" = 1'-0"

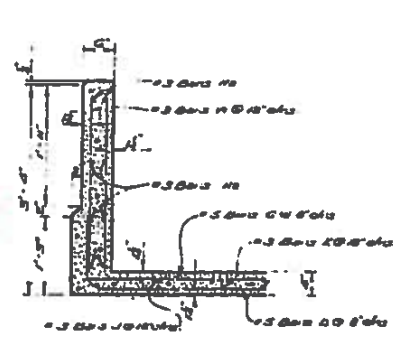

SECTION B-B
SCALE: 1/8" = 1'-0"

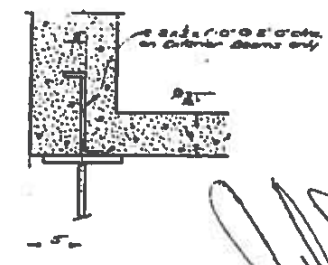

ANCHOR DETAILS
FOR
EXTERIOR BEAMS

[Handwritten signature]

OPERATING HOUSE


STANDARD PLAN 180' VERTICAL LIFT SPAN LIVE LOAD H20-S16-44		
28'-0" ROADWAY	45'-0" LIFT	5'-0" SIDEWALKS OPEN STEEL GRID FLOOR
DATE: May 13, 1957		
STATE OF LOUISIANA DEPARTMENT OF HIGHWAYS		
DESIGNED <i>[Signature]</i>	DETAILED <i>[Signature]</i>	TRACED <i>[Signature]</i>
CHECKED <i>[Signature]</i>	CHECKED <i>[Signature]</i>	CHECKED <i>[Signature]</i>
BRIDGE DESIGN SECTION		

DATE	DESCRIPTION	BY

130

000930
Sheet 16 of 17

DESIGNED	BY	SHEET
000930	LA-32	16

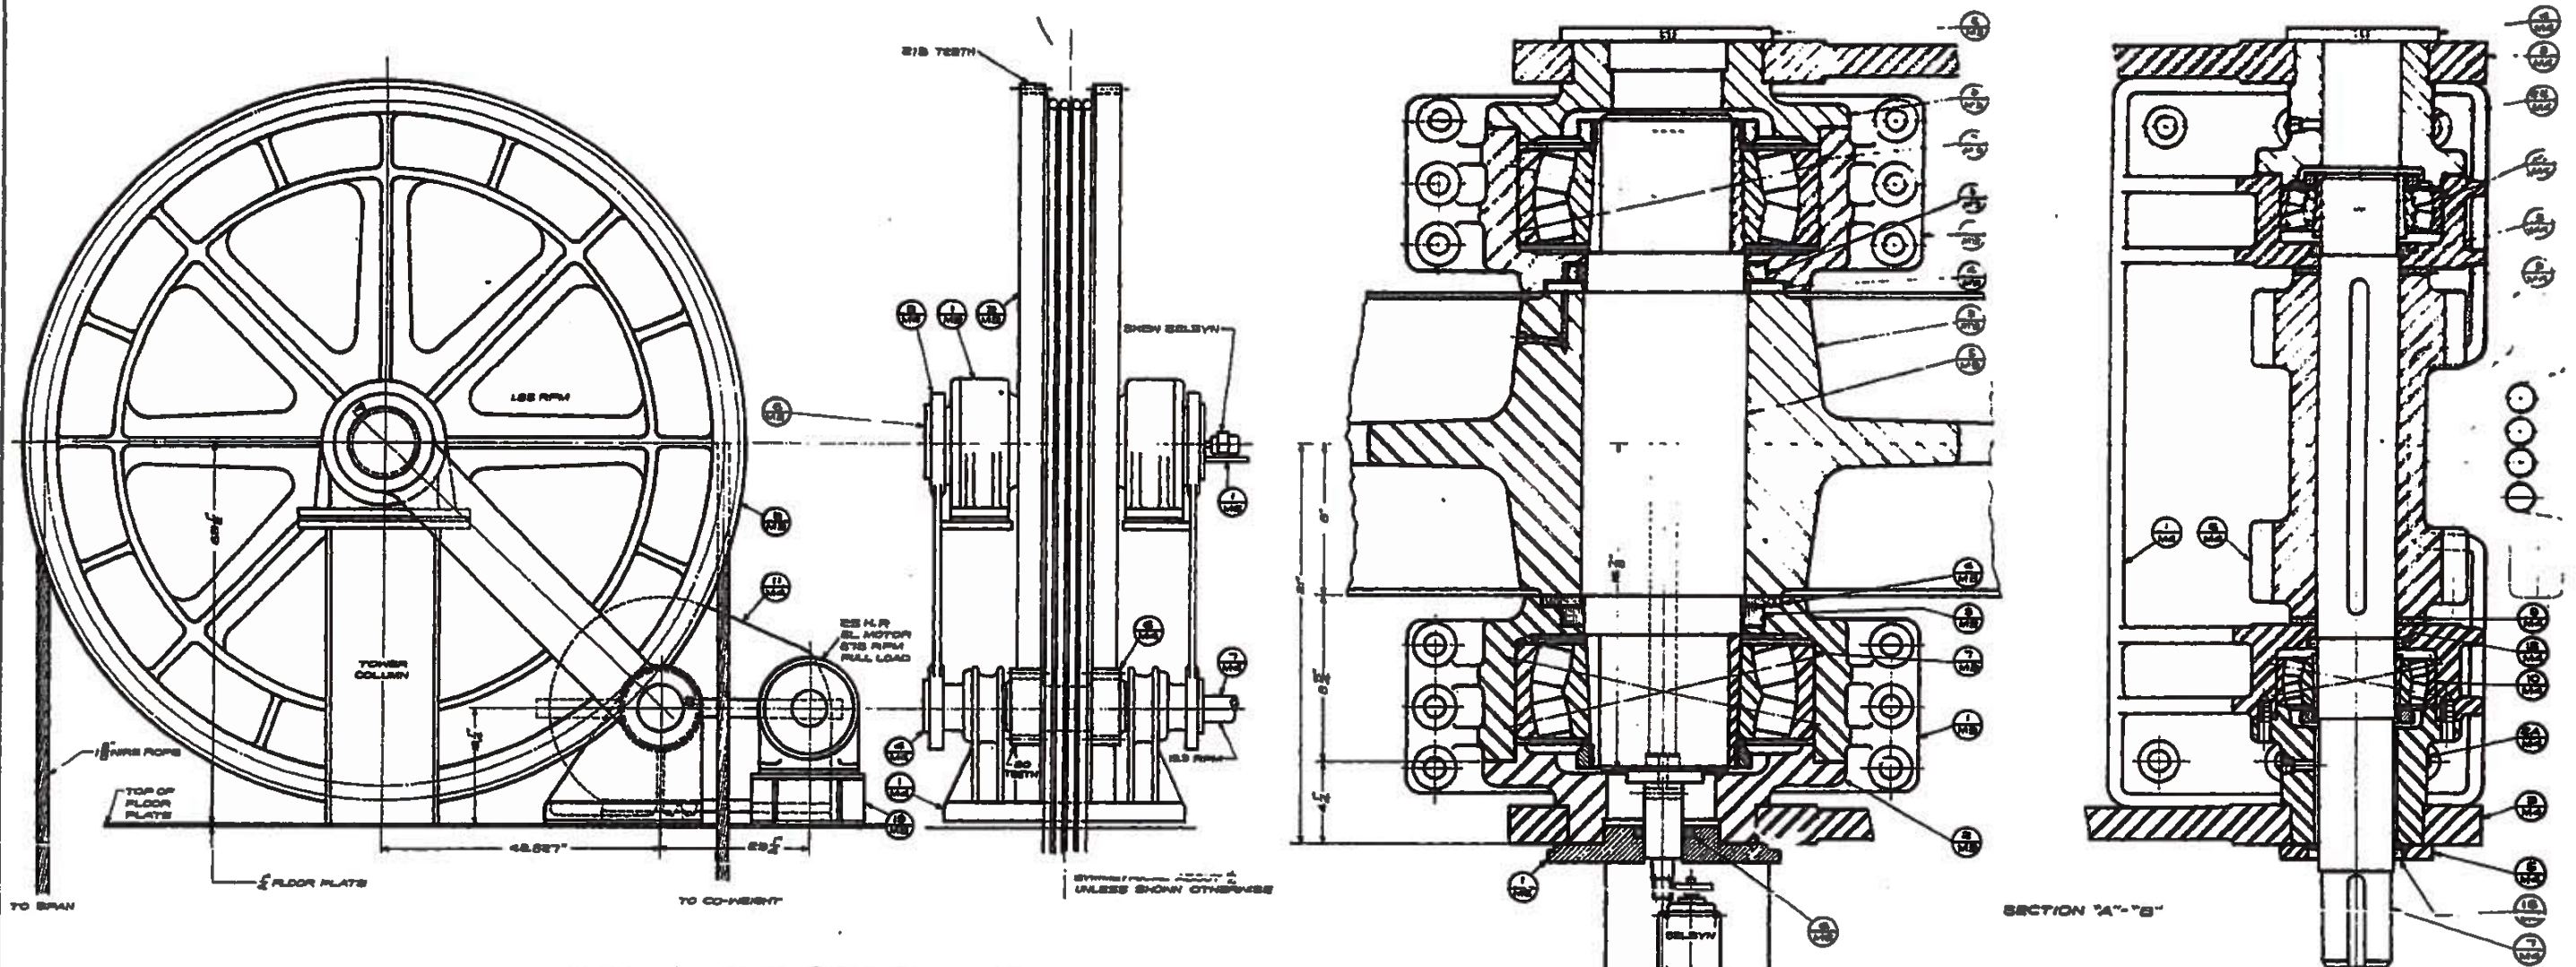

GENERAL ARRANGEMENT OF BRIDGE MACHINERY ON ONE # M1

SECTION "A-A-B-B"

NOTE:
FOR REMOVING PINION SHAFT
REMOVE CAPS, BEARINGS AND
GREASE SEALS FROM BOTH ENDS
OF THE ASSEMBLY.
POINT THE PINION SPACER
NEAREST THE COUPLER END OF THE
SHAFT UNTIL ITS KEY SLOT IS IN
LINE WITH THE KEY SLOT IN
THE BORE OF THE HOUSING.
ROTATE THE SHAFT UNTIL THE KEYS
ARE STRAIGHT DOWN. LIFT IT UPWARD
AGAINST THE TOP OF THE BORE AND
PRESS IT OUT IN THE DIRECTION OF
THE COUPLER END.

NOTE:
THE CONTRACTOR SHALL DETERMINE THE FINAL DIMENSIONS
OF PARTS INVOLVING COMMERCIAL PRODUCTS SUCH AS
MOTORS, SPEED REDUCERS, BEARINGS, ELECTRICAL EQUIPMENT
AND THE LIKE, FROM CERTIFIED DIMENSIONS OUTLINES OF THE
COMMERCIAL PRODUCTS BEFORE MAKING SHOP DRAWINGS
OF THE PARTS INVOLVED.
UNLESS OTHERWISE SHOWN ON DETAIL DRAWINGS LUBRICANT
SHALL BE AS FOLLOWS OR APPROVED EQUAL:
PINION BLOCS, COUPLERS & TRUNION BEARINGS-ESSO FIRE GREASE "C"
EXPOSED TEETH-MEDIUM HARD GREASE.
ENCLOSED SPEED REDUCERS-STD. OIL "TERESSO 65" VISC SAE 50.
WIRE ROPES-STD. OIL CO. SURRETTE COMPLING N71500.
ALL UNFINISHED SURFACES OF MACHINERY SHALL BE
PAINTED ONE SHOP COAT OF RED LEAD AND OIL.
ALL FINISHED SURFACES SHALL BE COATED WITH
WHITE LEAD AND TALLOW BEFORE SHIPMENT AND
SHALL BE PROTECTED BY WOODEN LAGGERS.

Handwritten signature

ASSEMBLY OF GEAR TRAIN FOR SHEAVE **M2**

STANDARD PLAN
150' VERTICAL LIFT SPAN
LIVE LOAD H20-S16-44
28'-0" ROADWAY 6'-0" SIDEWALKS
45'-0" LIFT OPEN STEEL GRID FLOOR
DATED FEB. 22 1957

STATE OF LOUISIANA
DEPARTMENT OF HIGHWAYS

DESIGNED <i>Russell</i>	DRAWN <i>Russell</i>	TRACED <i>C. Chilton</i>
CHECKED <i>Brewer</i>	CHECKED <i>Brewer</i>	CHECKED <i>Brewer</i>


BRIDGE DESIGN SECTION

NO.	DATE	DESCRIPTION	BY

138

DATE	PROJECT	ARCH	SHEET
04-03-70	Laboure		48

000930
Sheet 17 of 17

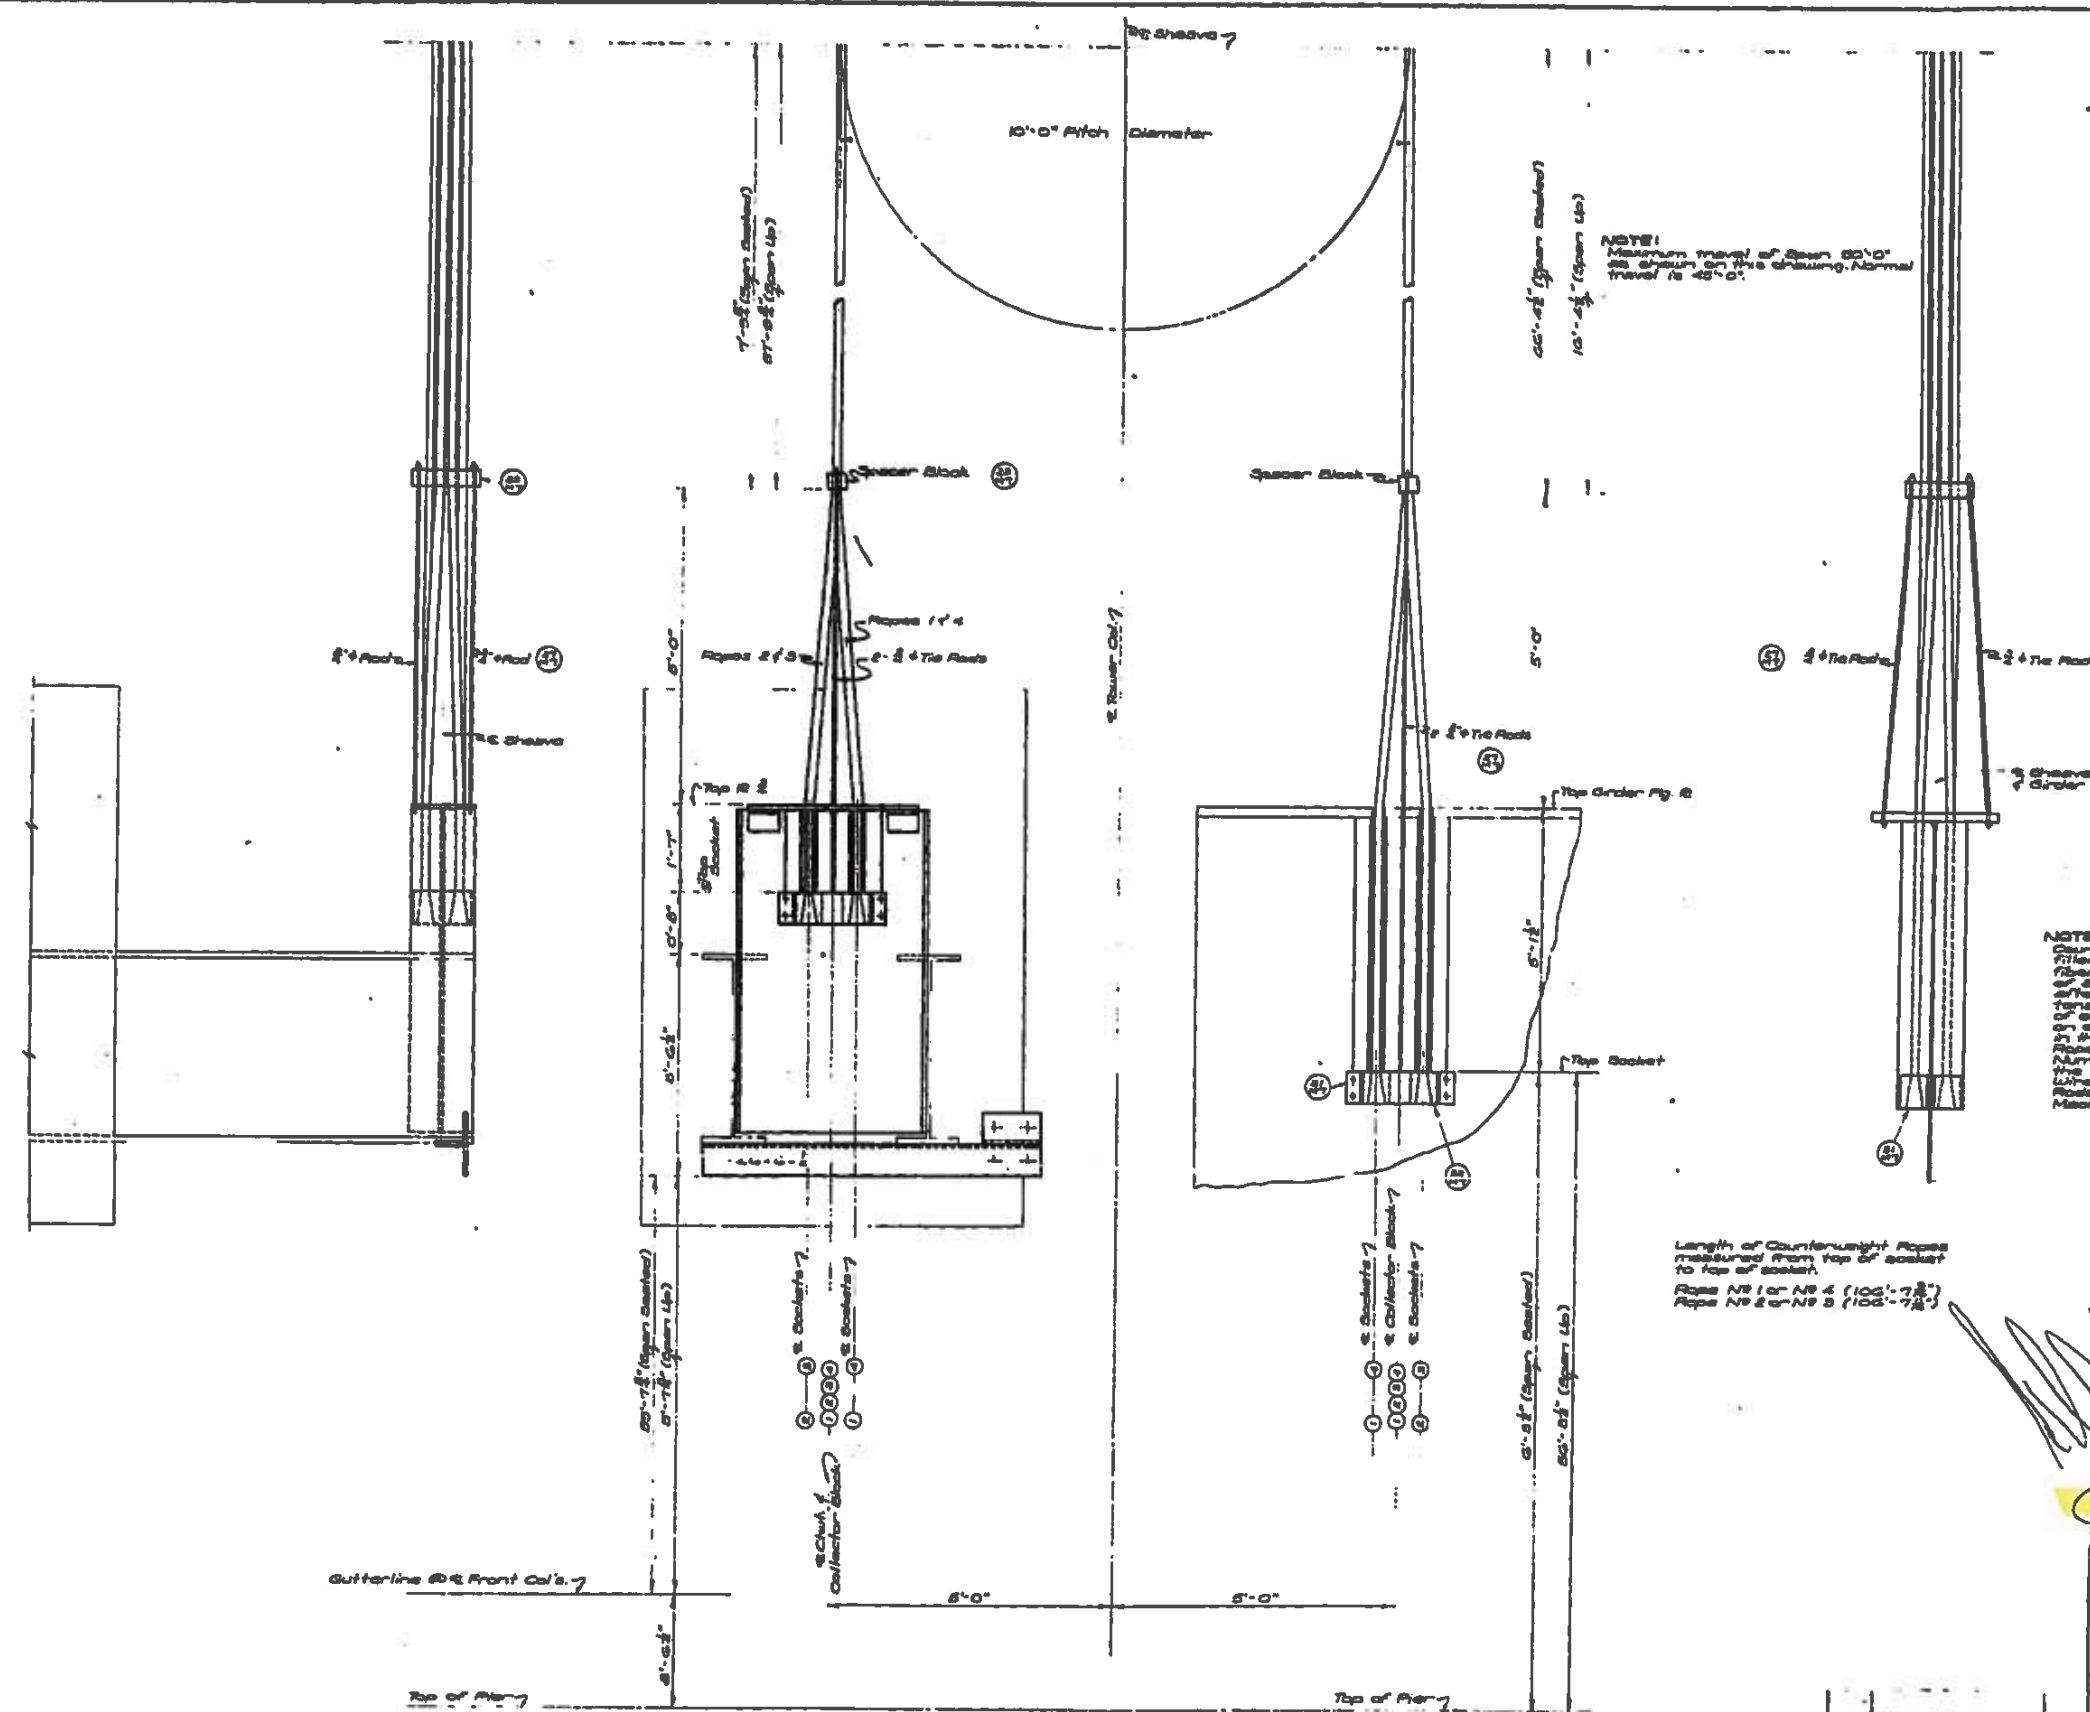

NOTE:
Maximum travel of Shear Block as shown on this drawing. Normal travel is 45'-0".

NOTES:
Counterweight Ropes to be 1" diameter 6 x 25 fiber wire improved plain steel wire rope with fiber core having a minimum breaking strength of 60,000 lbs. The Ropes shall be measured after the attachment of the sockets under a tension of 25,000 lbs. and the fabricated length of each rope less the loss of sockets shall be stamped on each socket. Suitable Shims shall be provided in the event that the fabricated lengths of the Ropes vary from the lengths shown. The Rope Number shall be stamped on each socket and on the Counterweight and Lift Span lifting points. Wire Ropes, Sockets, Shear Blocks and 1" Dia. Ropes to be included in Item 6.6.1, Movable Bridge Machinery.

Length of Counterweight Ropes measured from top of socket to top of socket.
Rope No 1 or No 2 (100'-7 1/2")
Rope No 3 or No 4 (100'-7 1/2")

M. Mahan

ARRANGEMENT OF COUNTERWEIGHT ROPES **MIO**

**STANDARD PLAN
150' VERTICAL LIFT SPAN**
LIVE LOAD H20-S16-44
26'-0" ROADWAY 5'-0" SIDEWALKS
45'-0" LIFT OPEN STEEL GRID FLOOR
DATE: April 17, 1967


STATE OF LOUISIANA
DEPARTMENT OF HIGHWAYS

DESIGNED BY: <i>Shaw</i>	DRAWN BY: <i>Shaw</i>	CHECKED BY: <i>Shaw</i>
APPROVED BY: <i>Shaw</i>	DATE: <i>4-17-67</i>	PROJECT: <i>SL-150-28</i>


BRIDGE DESIGN SECTION

139

DESIGNED	APPROVED	DATE
BY	BY	

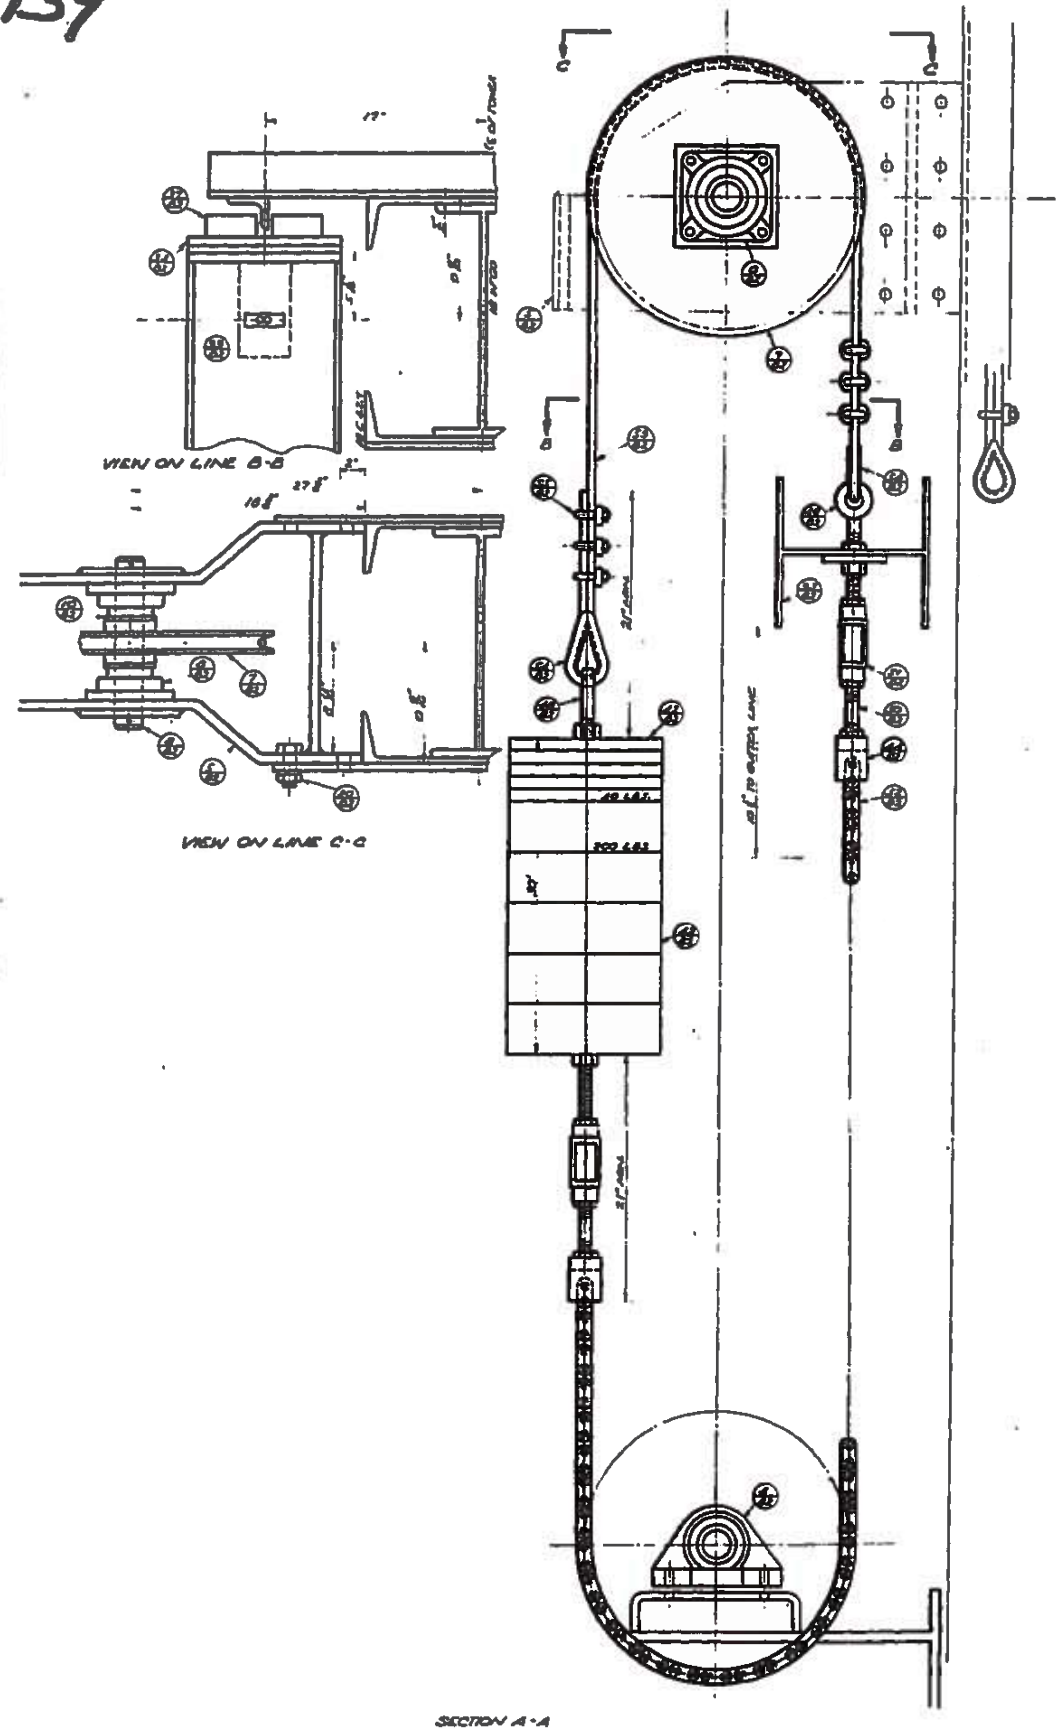

SECTION A-A

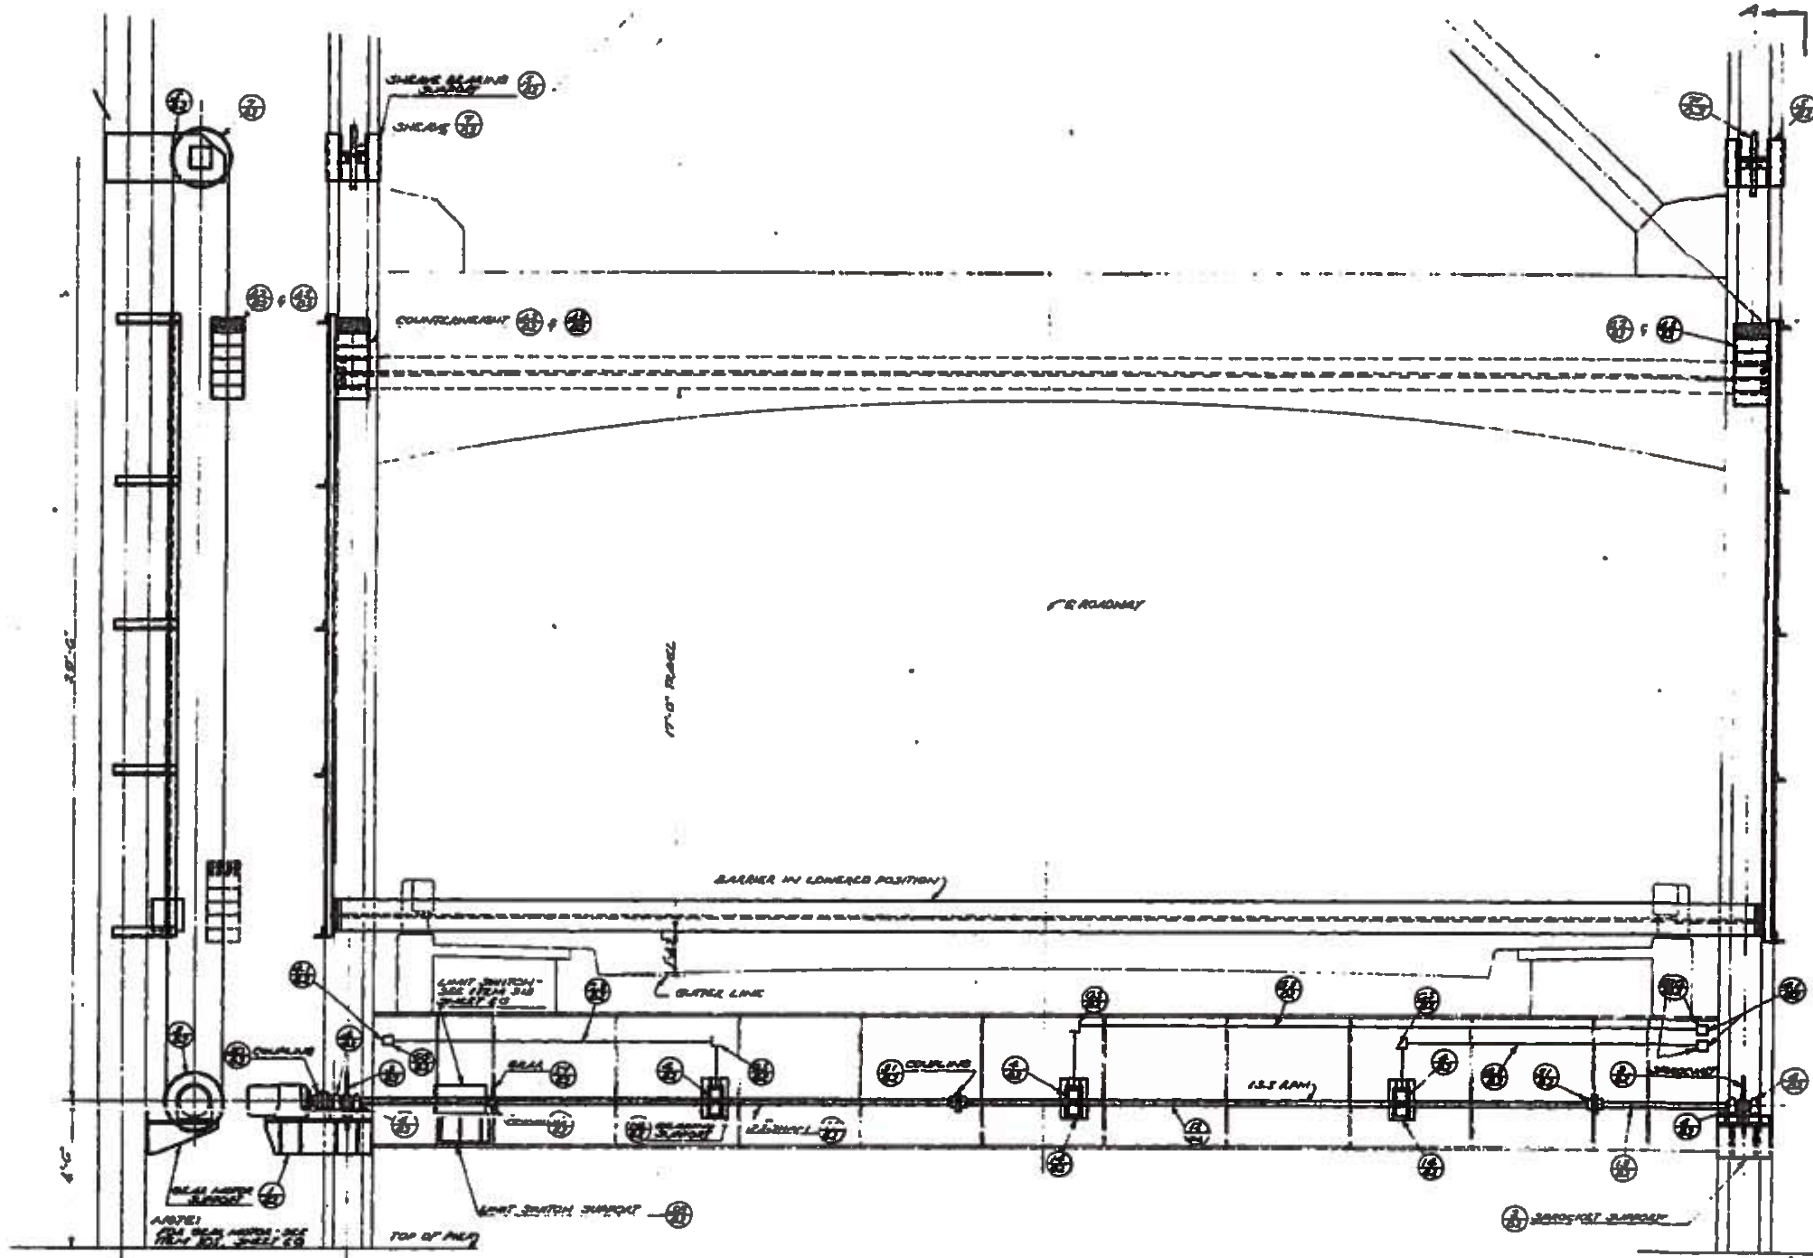

PART SIDE ELEVATION OF TOWER SHOWING BARRIER

PART REAR ELEVATION OF TOWER SHOWING BARRIER OPERATING MACHINERY

THICKNESS	5	6	7	8
BASE	5	6	7	8
ADDITIONAL				

NOTE:
THE CONTRACTOR SHALL DETERMINE THE FINAL DIMENSIONS OF PARTS AND FINISH CONDITIONS SUCH AS WHEEL SPEED REDUCERS, BEARINGS, ELECTRICAL EQUIPMENT AND THE LIKE, FROM LISTED DIMENSIONS OUTLINES OF THE COMMERCIAL PRODUCTS BEFORE MAKING SHOP DRAWINGS OF THE PARTS INVOLVED.

PAINTING NOTE:
ALL UNPAINTED SURFACES OF IRONWORK SHALL BE PAINTED ONE SHOP COAT OF RED LEAD AND OIL. ALL FINISHED SURFACES SHALL BE COATED WITH WHITE LEAD AND BLENDED BEFORE SHIPMENT AND SHALL BE PROTECTED BY IMPERIAL LAMINATE.

LUBRICATION NOTE:
UNLESS OTHERWISE SHOWN ON DETAIL, BEARING LUBRICANT SHALL BE AS FOLLOWS OR APPROVED EQUAL:
FOLLOW BLOCKS, COUNTERS, & ROLLER BEARINGS - 2330 PEAR OIL
ENCLOSED TIE-IN - MEDIUM PAID OIL
ENCLOSED SPEED REDUCERS - STD. OIL "TRASSID 61" VISC. SAE 30
WIRE ROPE - STD. OIL OR SYNTHETIC COMPOUND N1100.

H. P. Johnson

GENERAL ARRANGEMENT OF TRAFFIC BARRIER

150' VERTICAL LIFT SPAN
LIVE LOAD H20-S16-44
28'-0" ROADWAY 6'-0" SIDEWALKS
48'-0" LIFT OPEN STEEL GRID FLOOR

DATE MAY 1 1977

STATE OF LOUISIANA
DEPARTMENT OF HIGHWAYS

DESIGNED	BY	TRACED AS APPROVED
CHECKED	BY	CHECKED

BRIDGE DESIGN SECTION

DATE	REVISIONS	BY

BI