83

INDEX TO SHEETS

SHEET No.	DESCRIPTION
1	Title, Plans and Layout Map
2-2a 2b 2c	General Sections & Details
3 13	Plan & Profile
14 15	Summary Sheets
16 17	Summary of Drainage Structures
18 19	Detail of Intersections & Turnouts
20	General Bridge Plan
21	Detail of Bents
22-22A	Detail of Piers
23	Detail of Spans
24-24C	Detail of 150' Vertical Lift Span (Std. Plan St-50-150-28)
25	Welding Details for Aluminum Railings
26	Concrete Approach Slab
27	Fender System
28	Summary of Bridge Quantities and Camber Detail
29-29	Electrical System
30-31	Bridge Seepage

	Standard Plans	Rev. Date
201	C-30-05	11-30-53
202	[illegible]	8-8-39
204	[illegible]	6-11-57
205	[illegible]	8-1-57
206	[illegible]	5-28-56
208	C-12-170	1-28-58
209	[illegible]	
210	[illegible]	
211	[illegible]	
212	[illegible]	
213	[illegible]	
214	[illegible]	
215	[illegible]	
216	[illegible]	
218	R-CT-75	
[illegible]	Cross Sections	

Total Sheets without X Sections 69
Total Sheets with X Sections 124

S	STATE PROJECT	PARISH	SHEET NO.
253(3)	64-06-16	Lafourche	1

STATE OF LOUISIANA

DEPARTMENT OF HIGHWAYS

PLANS OF PROPOSED

STATE HIGHWAY

S-253(3)

STATE PROJECT NO. 64-06-16

LOCKPORT RELOCATION

LAFOURCHE PARISH

La 1

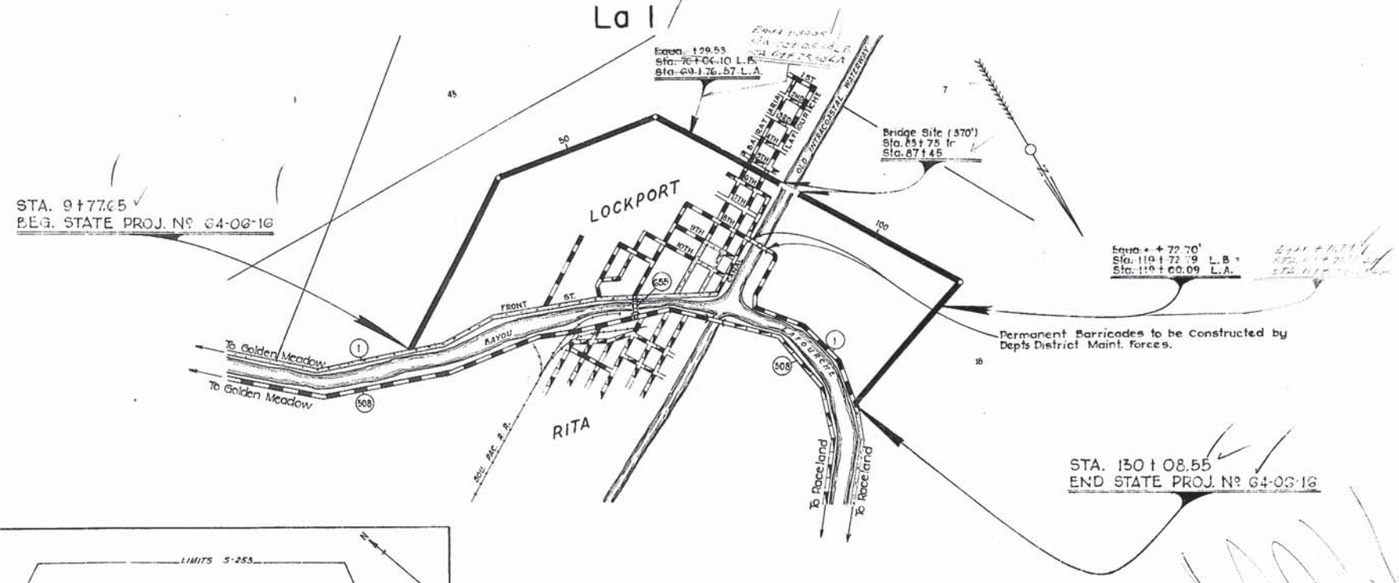

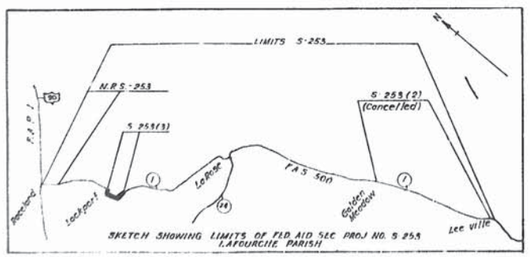

SCHEDULE OF REVISIONS

DATE	REVISION	DATE	RECOMMENDED	DATE	APPROVED
[illegible]	[illegible]				

DATUM USED:	U.S.C.G.S. (1932)
MAG. VAR.:	6°-40' E
BEARINGS ARE	True
TRANSIT BOOKS:	36-271
LEVEL BOOKS:	36-491
SCALES PLAN:	1" = 40'
PROFILE: HOR.	1" = 40'
VERT.	1" = 4'

TYPE OF CONSTRUCTION: Portland Cement Concrete Pavement

DELIVERY POINTS: [illegible]

LAYOUT MAP

SCALE: 1 INCH 1000 FEET

LENGTH OF PROJECT

DESCRIPTION	ALGEBRAIC SUM OF ALL EQUATIONS	GROSS LENGTH	EXCEPTION	BRIDGE LENGTH		ROADWAY LENGTH	
STA. TO STA.	FEET	FEET	FEET	FEET	MILES	FEET	MILES
9+77.65 - 130+08.55	+102.23	12353.13		370	0.070	11768.13	2.227
TOTAL LENGTH OF BRIDGES				370	0.070		
TOTAL LENGTH OF ROADWAY						11768.13	2.227
TOTAL MILES						2.297	

RECOMMENDED FOR APPROVAL

TRAFFIC & PLANNING ENGINEER

RECOMMENDED FOR APPROVAL

A. D. Jackson
ROAD DESIGN ENGINEER 11-7-57

RECOMMENDED FOR APPROVAL

J. B. Peters
BRIDGE DESIGN ENGINEER 11-7-57

APPROVED

C. R. Wiggins
CHIEF ENGINEER 11-7-57

RECOMMENDED FOR APPROVAL DATE

[redacted]
DISTRICT ENGINEER
DEPARTMENT OF COMMERCE
BUREAU OF PUBLIC ROADS

APPROVED DATE

[redacted]
DIVISION ENGINEER
DEPARTMENT OF COMMERCE
BUREAU OF PUBLIC ROADS

AS BUILT PLANS

HAER No. LA-32

9f

STATE PROJECT	PARISH	SHEET NO
700-11	LAFOURCHE	9

PLAN	SURVEYED	DRAWN	ALIGNMENT CHECKED	NOTE BOOK	PROFILE CHECKED	NO. 16229	PLANS BY

PROFILE	SURVEYED	DRAWN	NOTE BOOK	NO. 16229	PLANS BY

79+00 80+00 85+00 90+00 91+00

Total 370'-0" Length of Bridge

For Detail of Intersection See Sheet No. 19

Remove to R/W Line

To be Moved

5TH ST.

20' Approach Slab

INTRACOASTAL CANAL

Projected & Adopted ℄

Surveyed & Abandoned ℄

N. 32° 46' W

N. 90° 46' W

R/W

ETHEL TOURS

ANTOINETTE CULLOTTA

MRS V. LUSCO, SR.

GEORGE BOLLINGER

TRAILER PARK

FELIX SAUCET

RICHARD BARKER

NUMA MAYET

Field Ditch

Wooden Gate

SPOIL BANK

RICHARD BARKER

Ends of Bridge at -4.5

20' Approach Slab

12% Top of Bank

3:1 Slope of Water

Edge of Water

300' Canal R/W (CORPS OF ENGINEERS)

B.M.
Gold Nail in 6" Cottonwood
35' Lt. Sta. 84+10
Elev. 4.51

B.M.
Top of Abutment (Left)
Sta. 93+45
Elev. 13.74

P.I. 75+49.75
El. 6.76

-0.50 %

300' V.C.

200' V.C.

P.I. 82+75
El. 6.13

+4.00 %

-3.00 %

400' V.C.

P.I. 85+80
El. 17.35 (B.S.)

200' V.C.

0.00 %

P.I. 88+80
Elev. 5.35


AS BUILT PLANS

109

State Project	Parish	Sheet No.
G4-06-13	Lafourche	20

BORING No. 1
STA. 83 + 00
32' L.T. ℄

BORING No. 2
STA. 85 + 00
ON ℄

BORING No. 3
STA. 86 + 00
ON ℄

BORING No. 4
STA. 87 + 85
ON ℄

Sta. 83 + 55
℄ Traffic Gates

Sta. 83 + 50
℄ Warning Signal

Sta. 88 + 10
℄ Warning Signal

Sta. 88 + 05
℄ Traffic Gates

125'-0"
Horiz. Clearance

INTRACOASTAL

WATERWAY

← TO GOLDEN MEADOW

TO RACELAND →

N 32° 42' W.

25'-0" Clear Roadway

END ROADWAY
BEG. BRIDGE
STA. 83 + 75

END BRIDGE
BEG. ROADWAY
STA. 87 + 45

370'-0"
Total Length of Bridge

100'-0"
5 @ 20' Conc. Slab Spans

2.5'-0" Tower Span

150'-0"
Vertical Lift Span

2.5'-0" Tower Span

60'-0"
3 @ 20' Conc. Slab Spans

Sta. 84 + 75
℄ Rear Cols.

Sta. 85 + 00
℄ Front Cols.

Sta. 86 + 00
℄ Front Cols.

Sta. 86 + 85
℄ Rear Cols.

400' V.C.
P.I. Sta. 85 + 80
P.I. El. 18.50
El. of G. 19' @ P.I. 14.50
Design Speed 40 M.P.H.
S.S.D. 275'

Machinery House

Aerial Cable

20'-0"

Position of Span when open ?

Operating House

Traffic Barrier

20'-0" Conc. Appr. Slab

+4.0% Grade

-4.0% Grade

50' Vert. Clear

H.W. El. 3.07

L.W. El. 0.89

El. 8.0 (at b-hdge)
El. 10.0 (beyond Bridge)

125'-0"
Horiz. Clearance

PIER No. 1

PIER No. 2

6 in. Galv. Nail in ℄ of Fenderwood
35' Lt. Sta. 86 + 10
El. 6.21

200' V.C.
P.I. Sta. 82 + 55
P.I. El. 9.30 (R.S.)
El. of G. 7' @ P.I. 7.23
Design Speed 40 M.P.H.

200' V.C.
P.I. Sta. 88 + 50
P.I. El. 9.80 (R.S.)
El. of G. 9' @ P.I. 7.88
Design Speed 40 M.P.H.

NOTE:
Name of Waterway and Date of Construction
Required Each End of Bridge.
Sta. Standard Plans C.M. 85 and C.M. 87.

NOTE:
PILING to be in place prior to driving Piles if practical.

DATUM: MEAN SEA LEVEL.

M.I. PLACE TO BE REMOVED:
Located approx. 10.30' Northeast of Proposed Bridge Sta. (At Bar. Street)
7 @ 17'-0" Timber Trestle Approach Spans
1 @ 8'-0" and 6 @ 5'-0" Timber Aprons
1 @ 5' x 24' x 5' Steel Pontoon Barge
(Hor. 9' Clear Roadway)
Salvagable Material and Steel Pontoon Barge to be delivered to the Lafitte Maintenance Headquarters in Lafitte.
Removal of Existing Bridge to be paid for under Item 7.225, and Hauling of Salvaged Material to be included in Pay Item 3 M.

GENERAL BRIDGE PLAN

INTRACOASTAL WATERWAY BRIDGE
LOCKPORT
LA. ROUTE No. 1

DATED MAY 3, 1957

STATE OF LOUISIANA
DEPARTMENT OF HIGHWAYS

DESIGNED	DETAILED	TRACED
CHECKED	CHECKED E.D.L.A.J.	CHECKED

BRIDGE DESIGN SECTION

DATE	DESCRIPTION	BY
REVISIONS		

AS BUILT PLANS

HAER No. LA-32

114

STATE PROJECT	PARISH	SHEET NO

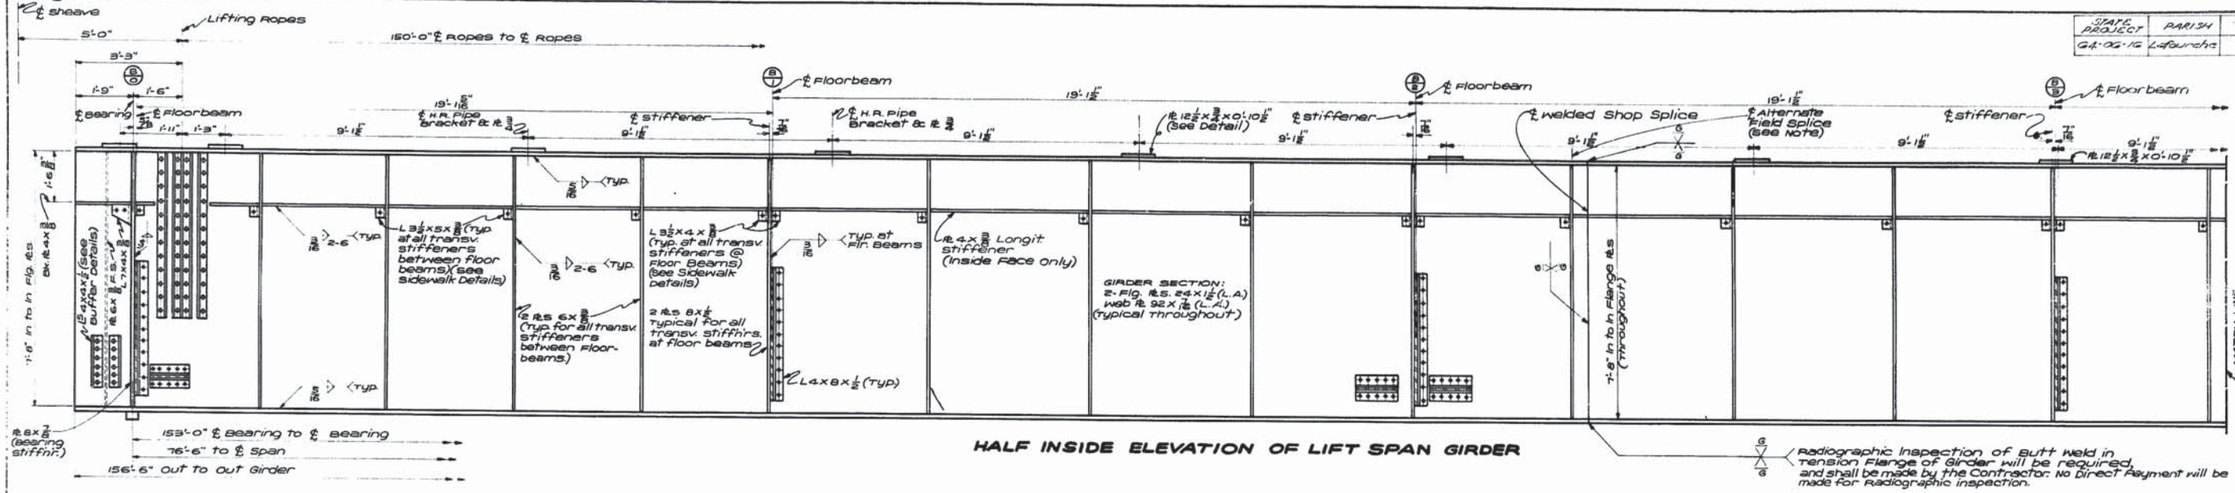

HALF INSIDE ELEVATION OF LIFT SPAN GIRDER

G Radiographic Inspection of butt weld in tension flange of girder will be required, and shall be made by the Contractor. No Direct Payment will be made for radiographic inspection.

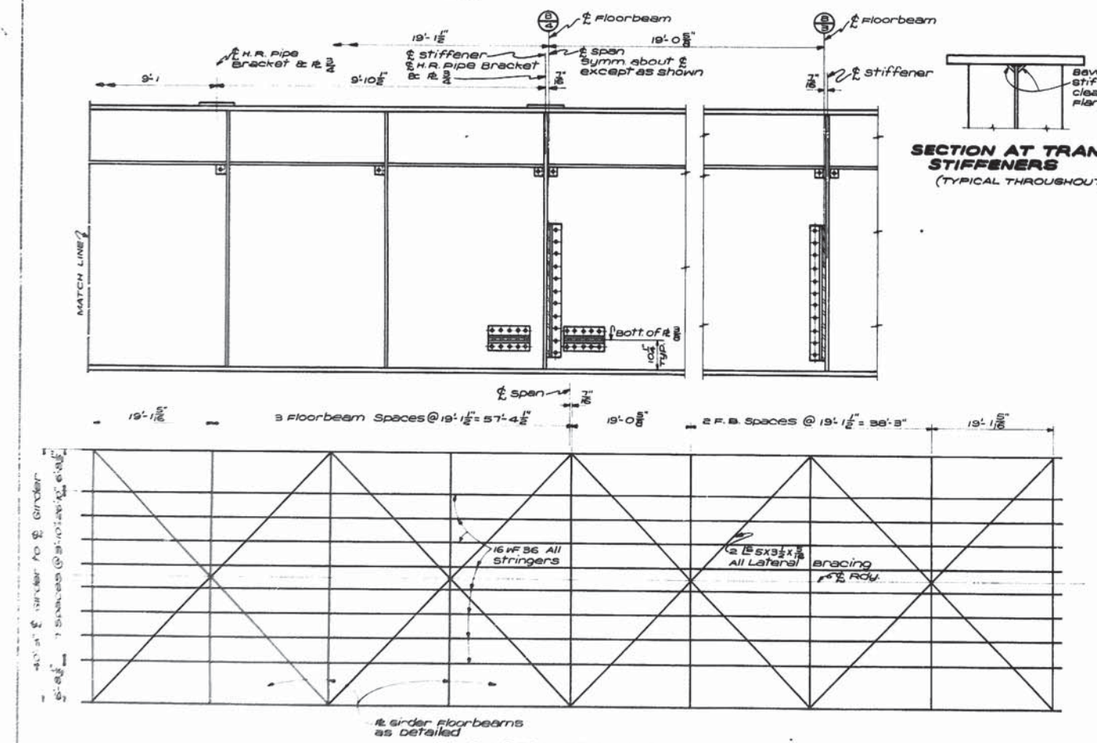

PLAN DECK FRAMING AND LATERAL SYSTEM

GIRDER DESIGN DATA

DESIGN SPAN FOR DEAD LOAD =	150'-0"		
DESIGN SPAN FOR S.W.L.L. & LIVE LOAD =	153'-0"		
DEAD LOAD CONCENTRATION AT PANEL POINTS:	13,488 LBS.		
UNIFORM DEAD LOAD:	468 LBS. PER FT.		
MAX. MOM. AT ℄: DL	3351 FT.-KIPS	DLR = 97.7K	SWLL = 19.7K
SWLL	755	20% I = 19.5	LLR = 82.4
LL	2816	TOTAL = 117.2K	I = 15.0
I	513		TOTAL = 117.1K
TOTAL	7435 FT.-KIPS		

GIRDER PROPERTIES

I GROSS =	185,746 IN.⁴	MRC = 7622 I-K	
I NET @ FLOORBEAM =	182,749	MRC = 7622	
I NET @ ℄ ALT. SPLICE =	168,149	MRT = 6869	

SECTION AT TRANSV. STIFFENERS
(TYPICAL THROUGHOUT)

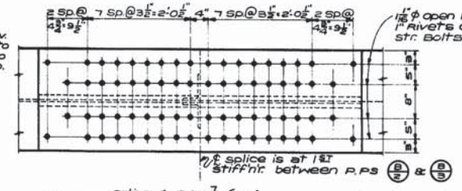

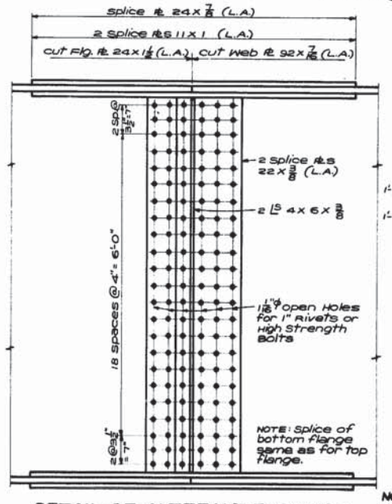

DETAIL OF ALTERNATE SPLICE

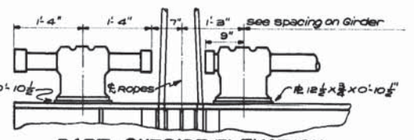

PART OUTSIDE ELEVATION OF PIPE HANDRAIL AT GIRDER ENDS

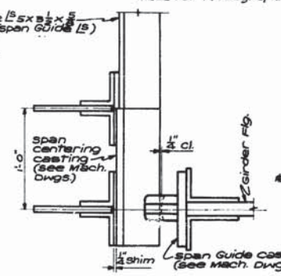

ELEVATION OF SPAN CENTERING DEVICE (LIFT SPAN SEATED)
DETAIL SHOWN IS FOR FIXED END)
(detail for Exp. End Similar)

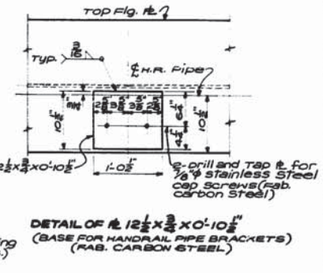

DETAIL OF Pl 12½x¾x0'-10⅝"
(BASE FOR HANDRAIL PIPE BRACKETS)
(RAB. CARBON STEEL)

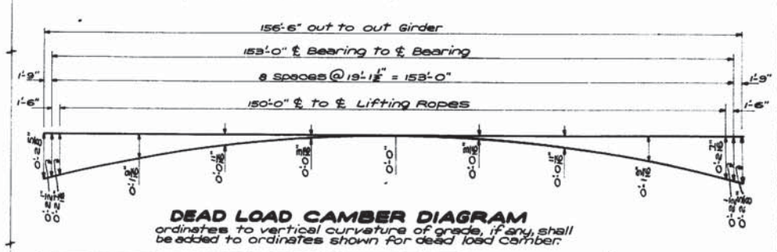

DEAD LOAD CAMBER DIAGRAM
ordinates to vertical curvature of grade, if any, shall be added to ordinates shown for dead load camber.

ESTIMATED QUANTITIES
(150' VERTICAL LIFT SPAN)

OPEN GRID BRIDGE FLOORING	4950 SQ. FT.
STRUCTURAL LOW ALLOY STEEL	163,000 LBS.
FABRICATED CARBON STEEL	121,800 LBS.
PIPE HANDRAIL	308.67 LIN. FT.

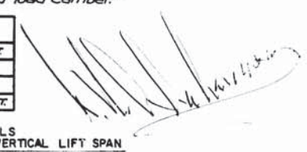

DETAILS
150' VERTICAL LIFT SPAN

NOTE:
contractor will be required to use alternate splice if he elects to splice girder in field. weight of splice material, estimated at 2600 lbs. per splice, will not be included in pay quantity for Structural Low Alloy Steel if the contractor elects to use the alternate splice, but shall be included in the price bid on other items.

DATE	DESCRIPTION	BY
	REVISIONS	

STANDARD PLAN
150' VERTICAL LIFT SPAN
LIVE LOAD H20-S16-44
28'-0" ROADWAY — 5'-0" SIDEWALKS
45'-0" LIFT — OPEN STEEL GRID FLOOR
DATED MAR. 15 1957

STATE OF LOUISIANA
DEPARTMENT OF HIGHWAYS

DESIGNED	DETAILED	TRACED	CHECKED
S.L.P.	S.L.P.	O. Chapman	S.L.P.

BRIDGE DESIGN SECTION

SHEET 1 OF 26

SL50-150-28

AS BUILT PLANS

STATE PROJECT	PARISH	SHEET
924-06-16	Lafourche	26

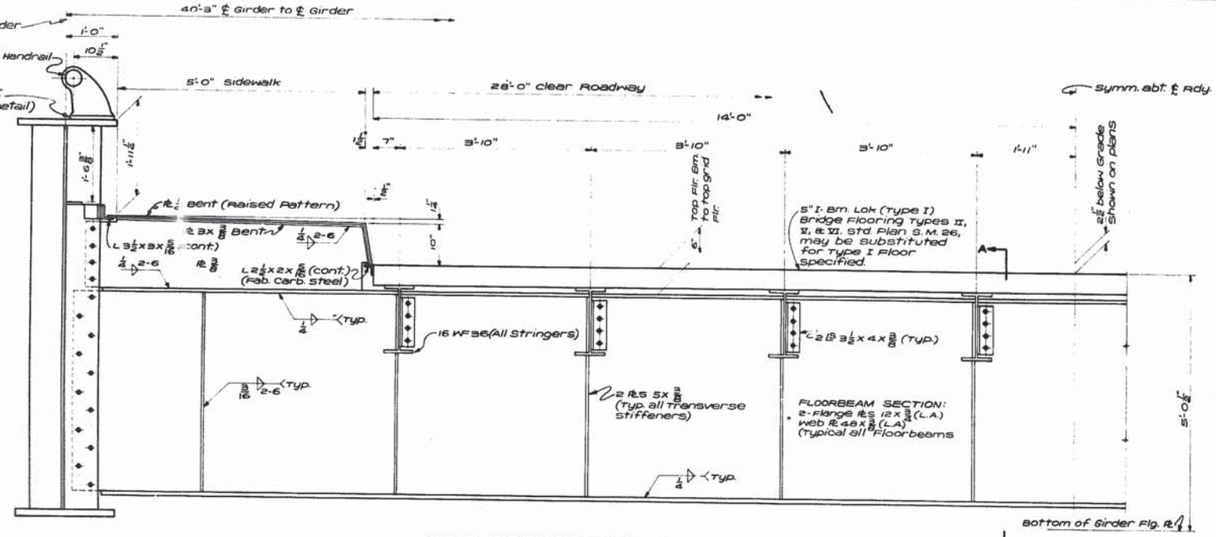

HALF SECTION THRU ROADWAY AT FLOORBEAM

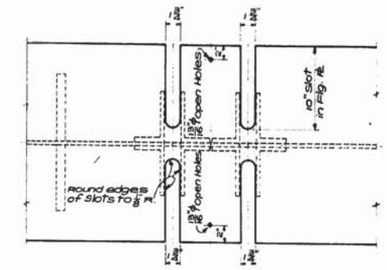

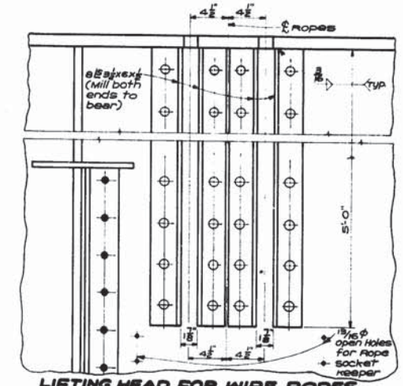

LIFTING HEAD FOR WIRE ROPES
For complete Assembly, See Machinery Drawings

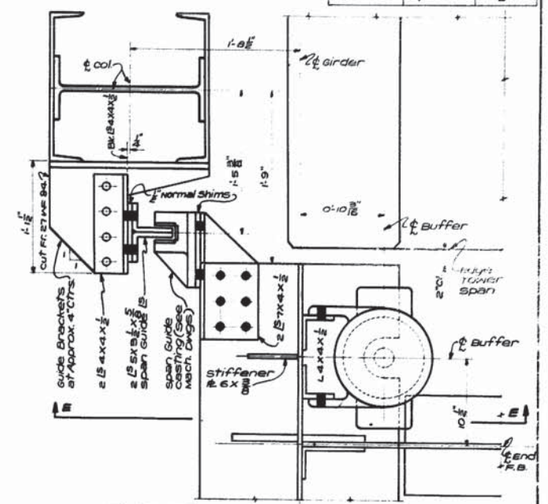

PLAN VIEW AT FIXED END OF SPAN
SHOWING SPAN GUIDE AND BUFFER CONN.
(detail at Exp. end same except for Span Guide casting)

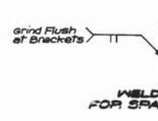

WELDING DETAIL
FOR SPAN GUIDE ANGLES

PL 7x4½ may be left blank and drilled in field after parts have been set to correct alignment and adjustment or sub-punched or drilled ¾" smaller and reamed to size in field after erection.

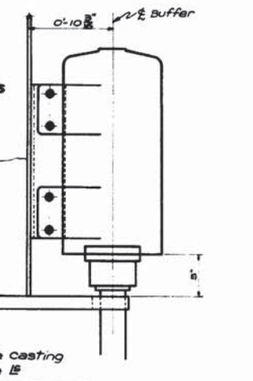

ELEVATION E-E

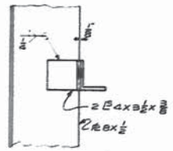

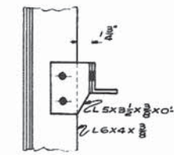

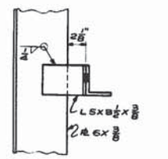

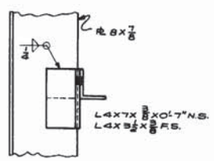

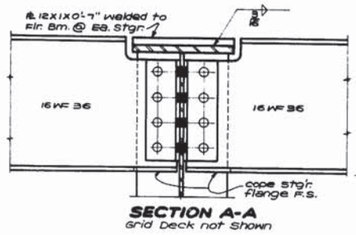

SECTION A-A
Grid Deck not Shown

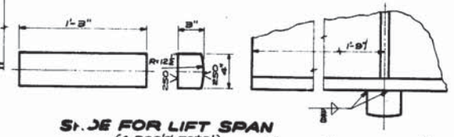

SHOE FOR LIFT SPAN
(4 Req'd Total)

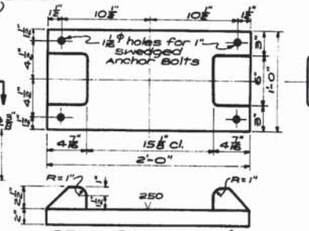

SPAN BEARING
(4 Req'd. Total) (Shall be either steel casting or weldment)

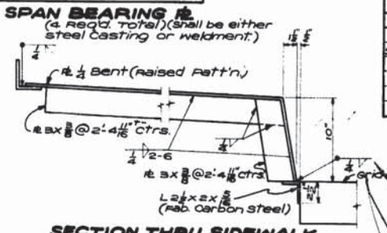

SECTION THRU SIDEWALK BETWEEN FLOORBEAMS

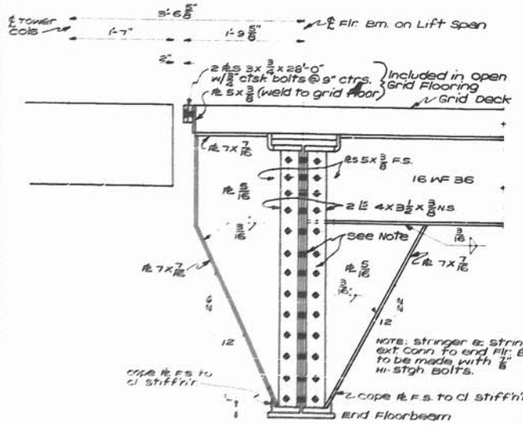

CONNECTION DETAIL AT TOWER

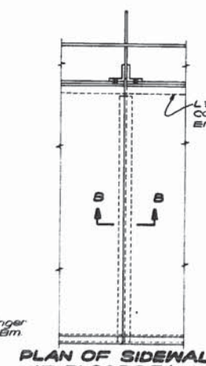

PLAN OF SIDEWALK AT FLOORBEAM

SECTION B-B

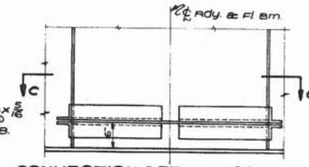

CONNECTION DETAIL FOR LATERAL BRACING AT ODD FLOORBEAMS

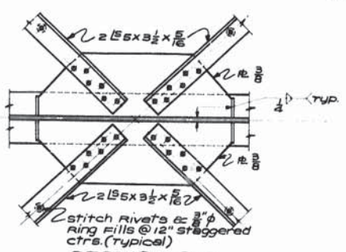

SECTION C-C

CONNECTION DETAIL FOR LAT'L. BRACING AT EVEN FLOORBEAMS

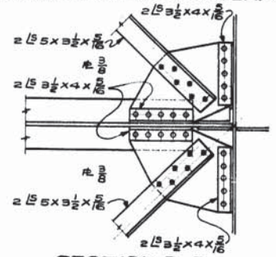

SECTION D-D

MOMENTS AND REACTIONS FOR STRINGERS & FLOORBEAMS						
	EXTERIOR STERS.		INTERIOR STGRS.		FLOORBEAMS	
	M(K-FT)	R (K)	M(K-FT)	R (K)	(M)(K-FT)	R (K)
D	6.9	1.4	5.1	1.1	155.6	13.0
SWL	11.4	2.4	0.0	0.0	26.2	3.9
L	48.2	19.5	58.7	20.1	646.1	47.0
I	14.5	4.1	17.6	6.0	193.8	14.1
T	81.0	21.4	81.4	27.2	1021.7	78.0

DETAILS
150' VERTICAL LIFT SPAN

STANDARD PLAN
150' VERTICAL LIFT SPAN
LIVE LOAD H20-S16-44
28'-0" ROADWAY 5'-0" SIDEWALKS
45'-0" LIFT OPEN STEEL GRID FLOOR
DATE MARCH 18 57

STATE OF LOUISIANA
DEPARTMENT OF HIGHWAYS
DESIGNED J.L.P. DETAILED J.L.P. CHECKED J.L.P.
BRIDGE DESIGN SECTION

REVISIONS

SHEET 2 OF 26

SL50-150-28

AS BUILT PLANS

116

STATE PROJECT	PARISH	SHEET NO
640-01-16	Lafourche	27

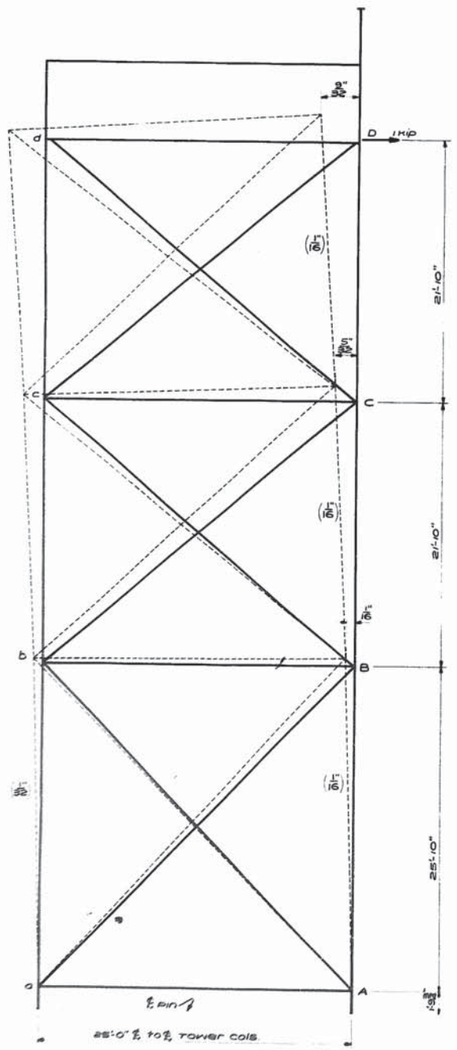

TOWER CAMBER DIAGRAM

LEGEND
——— Indicates uncambered position of tower
- - - - - Indicates cambered position of tower

MEMBER	DL. STRESS KIPS	LENGTH INS.	AREA SQ. INS.	SL/AE CALCULATED INS.	SL/AE ACTUAL INS.	"U" STRESS IKIP LD @ d	Δ_H = SUL/AE
DC	253.1	252	42.60	0.0516"	-0.0626	-0.8400	+0.0525
CB	269.1	252	42.60	0.0549"	-0.0625	-1.6800	+0.1050
BA	307.2	310	42.60	0.0771"	-0.0625	-2.7188	+0.1696
dc	29.3	252	42.60	0.0060"	0.0000	0.0000	0.0000
cb	42.7	252	42.60	0.0087"	0.0000	+0.8400	0.0000
ba	90.0	310	42.60	0.0226"	-0.0313	+1.6800	-0.0525

$\Sigma \frac{SU_L}{AE} = \Delta_H = +0.2746$

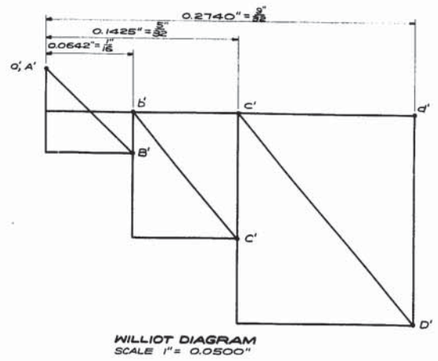

WILLIOT DIAGRAM
SCALE 1" = 0.0500"

GENERAL NOTES:

CONSTRUCTION SPECS: LA. DEPT. OF HIGHWAYS STD. SPECS. FOR ROADS AND BRIDGES, DATED JULY, 1955.
DESIGN SPECS: A.A.S.H.O. STD. SPECS. FOR HIGHWAY BRIDGES, 1953, AS AMENDED TO DEC., 1955.
WELDING SPECS: STD. SPECS. FOR WELDED HIGHWAY AND RAILWAY BRIDGES, 1956, AND L.A. DEPT. OF HWYS. SPECIAL PROVISIONS.
LIVE LOAD: H20-S16-44.
REINFORCING BARS SHALL BE INTERMEDIATE OR HARD GRADE A.S.T.M. A15, OR RAIL STEEL A.S.T.M. A16, AND SHALL CONFORM TO A.S.T.M. A-305. DIMENSIONS TO REINFORCING STEEL ARE TO BAR CENTERS. EXPOSED CONCRETE CORNERS TO BE CHAMFERED 3/4" UNLESS OTHERWISE NOTED. HANDRAIL AND HANDRAIL POSTS TO BE POURED IN ONE OPERATION. HANDRAIL POSTS TO BE CONSTRUCTED NORMAL TO GRADE. CONCRETE AND REINFORCING STEEL IN H.R. ABOVE TOP OF 4" SIDEWALK CURB TO BE PAID FOR PER LIN. FT. OF CONCRETE H.R., INCLUDING BARS L_1, L_1, L_2 AND L_3 THAT PROJECT INTO SAID 4" CURB. PIPE HANDRAIL AND BRACKETS, INCLUDING ANCHOR BOLTS FOR SAME, ON TOWER SPAN, ARE TO BE PAID FOR PER LIN. FT. OF PIPE HANDRAIL. NO DEDUCTION IN QUANTITY OF CLASS "A" CONCRETE WILL BE MADE FOR 3" x 5" DRAIN OPENINGS. SURFACE FINISHES, WHERE INDICATED, SHALL CONFORM TO THE AMERICAN STANDARDS FOR SURFACE ROUGHNESS, WAVINESS AND LAY, PART 1 A.S.A. B46.1-1947. SHOP CONNECTIONS 7/8" RIVETS, OPEN HOLES 15/16" UNLESS OTHERWISE NOTED. ALL RIVETS SHALL CONFORM TO A.S.T.M. A141. THE CONTRACTOR MAY SUBSTITUTE HIGH STRENGTH BOLTS FOR RIVETS FOR ALL FIELD CONNECTIONS. WELDED PLATE GIRDERS ARE TO BE CAMBERED FOR DEAD LOAD AND VERTICAL CURVATURE AS SHOWN ON PLANS. FLOORBEAMS AND STRINGERS NEED NOT BE CAMBERED BUT ARE TO BE FABRICATED WITH CONVEX FLANGE UP. MATERIAL MARKED "L.A." SHALL BE STRUCTURAL LOW ALLOY STEEL, A.S.T.M. DESIGNATION A242. THE CONTRACTOR'S ATTENTION IS CALLED TO THE ALTERNATE SPLICES, AND NOTE THEREON, FOR THE WELDED GIRDERS OF THE VERTICAL LIFT SPAN. TOWERS SHALL BE CAMBERED SO THAT FRONT LEGS WILL BE VERTICAL UNDER DEAD LOAD.
TOWER COLUMNS AND LONGITUDINAL BRACING SHALL BE SHOP ASSEMBLED, AND THE HOLES IN THE FIELD CONNECTIONS OF THE LONGITUDINAL BRACING MEMBERS AND COLUMN SPLICES SHALL BE REAMED AT ASSEMBLY. SHOP ASSEMBLY WILL NOT BE REQUIRED FOR THE TRANSVERSE BRACING, AND THE HOLES FOR THE FIELD CONNECTIONS OF THE TRANSVERSE BRACING MAY BE PUNCHED OR DRILLED FULL SIZE.

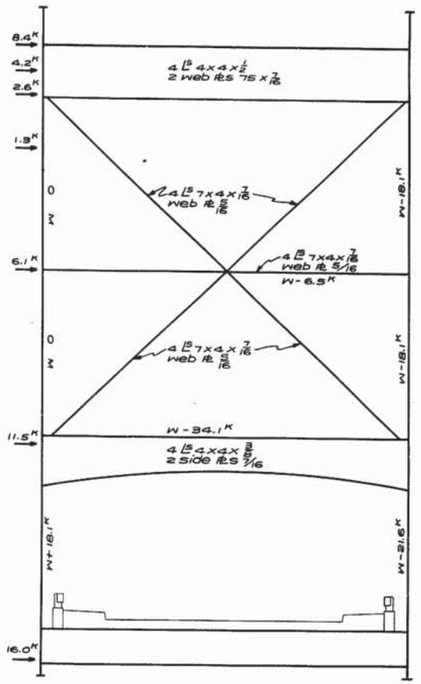

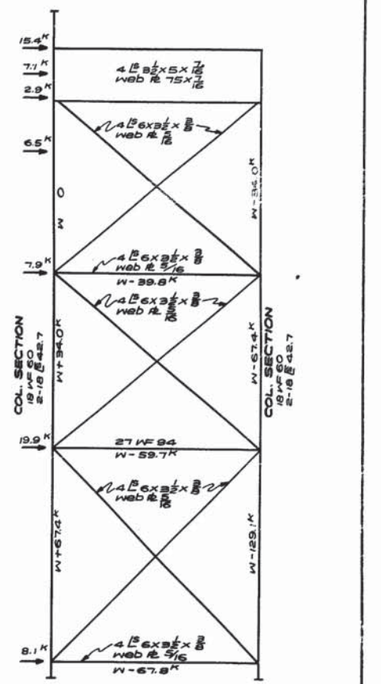

WIND LOADS AND STRESSES FOR 50#/0' WIND SPAN LOWERED

BASIS OF DESIGN FOR LATERAL STRESSES

SPAN LOWERED:	50#/0' WIND @ 125 % OF BASIC STRESSES
SPAN RAISED:	30#/0' WIND @ 150 % OF BASIC STRESSES
	15#/0' WIND @ 125 % OF BASIC STRESSES

MAXIMUM REACTION PER SHOE

	FRONT COL.	REAR COL.
D.L.	375K	182K *
D.L.I.	75K	36K *
L.L.	91K	44K *
L.L.I.	18K	13K *
S.W.L.L.	25K	10K *

* Incl. 20' appr. span

TABLE OF ESTIMATED QUANTITIES

	2 TOWERS	2 COUNTERWEIGHTS
CLASS "A" CONCRETE	98.40 CU. YDS.	
RAIL CARBON STEEL	581,700 LBS.	41,440 LBS.
DEF. REINF. STEEL	17,872 LBS.	3460 LBS.
CONCRETE HANDRAIL	91.00 LIN. FT.	
PIPE HANDRAIL	91.00 LIN. FT.	
CLASS "A" CONCRETE IN COUNTERWEIGHTS		89.48 CU.YDS.
STRUCTURAL LOW ALLOY STEEL	36,600 LBS.	
BALANCE CHAINS		LUMP

TOWER DESIGN DATA

STANDARD PLAN
150' VERTICAL LIFT SPAN
LIVE LOAD H20-S16-44
28'-0" ROADWAY
45'-0" LIFT
5'-0" SIDEWALKS
OPEN STEEL GRID FLOOR
DATED: MAY 9 1957

STATE OF LOUISIANA
DEPARTMENT OF HIGHWAYS
DESIGNED: H. Messinger | DETAILED: H. Messinger | TRACED: A. Broussard
CHECKED: S.L.P. | CHECKED: S.L.P. | CHECKED: H. Messinger
BRIDGE DESIGN SECTION

NO.	DATE	DESCRIPTION
SIG-50		Struct. Low Alloy Steel Question Sta.

REVISIONS

SHEET 3 OF 26

SL50-150-28

AS BUILT PLANS

HAER No. LA-32

112

STATE PROJECT	PARISH	SHEET NO
64-00-116	Lafourche	28

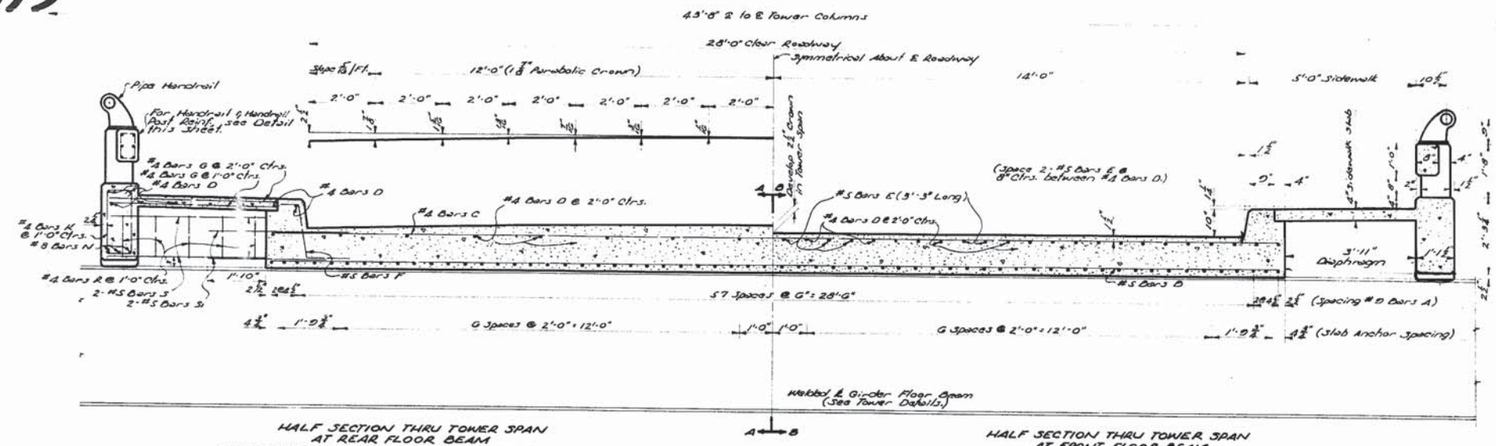

HALF SECTION THRU TOWER SPAN AT REAR FLOOR BEAM
SHOWING TYPICAL SIDEWALK AND HANDRAIL REINFORCEMENT

HALF SECTION THRU TOWER SPAN AT FRONT FLOOR BEAM
SHOWING TYPICAL SIDEWALK AND HANDRAIL DIMENSIONS

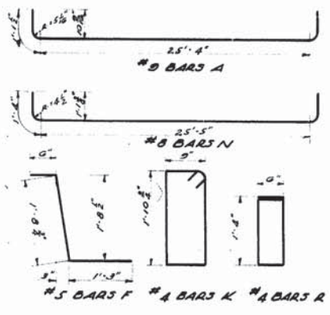

BILL OF MATERIAL (ONE SPAN)

BAR	SIZE	No	LENGTH	TOTAL LENGTH	LOCATION
A	#9	62	27'-4"	1004'-8"	Longit. in Slab
TOTAL No 9 BARS = 1004'-8" = 5702 LBS.					
N	#8	6	28'-1"	168'-6"	Longit. in S.W. Beam
TOTAL No 8 BARS = 168'-6" = 450 LBS.					
D	#5	20	30'-0"	870'-0"	Transv. Bott. of Slab
E	#5	30	3'-3"	97'-6"	Top of Slab @ Curb End
F	#5	58	3'-6"	203'-0"	Curb
S	#5	8	4'-10"	38'-8"	Diaphragm
T	#5	8	3'-8"	29'-4"	Diaph. to Slab Dowels
TOTAL No 5 BARS = 1238'-6" = 1202 LBS.					
C	#4	14	30'-0"	420'-0"	Transv. in Top of Slab
D	#4	34	26'-2"	889'-8"	Longit. Top Slab & S.W.
G	#4	72	5'-2"	372'-0"	Top & Bott. Transv. in S.W.
K	#4	54	6'-3"	337'-6"	Stirrups in S.W. Beam
R	#4	30	4'-2"	125'-0"	Stirrups in Diaph.
TOTAL No 4 BARS = 2144'-2" = 1432 LBS.					
TOTAL REINFORCING STEEL =				3634	LBS.
TOTAL CLASS "A" CONCRETE =				40.2	CU. YDS.
FABRICATED CARBON STEEL =				577	LBS.
CONCRETE HANDRAIL				45.90	LIN. FT.
PIPE HANDRAIL				45.90	LIN. FT.

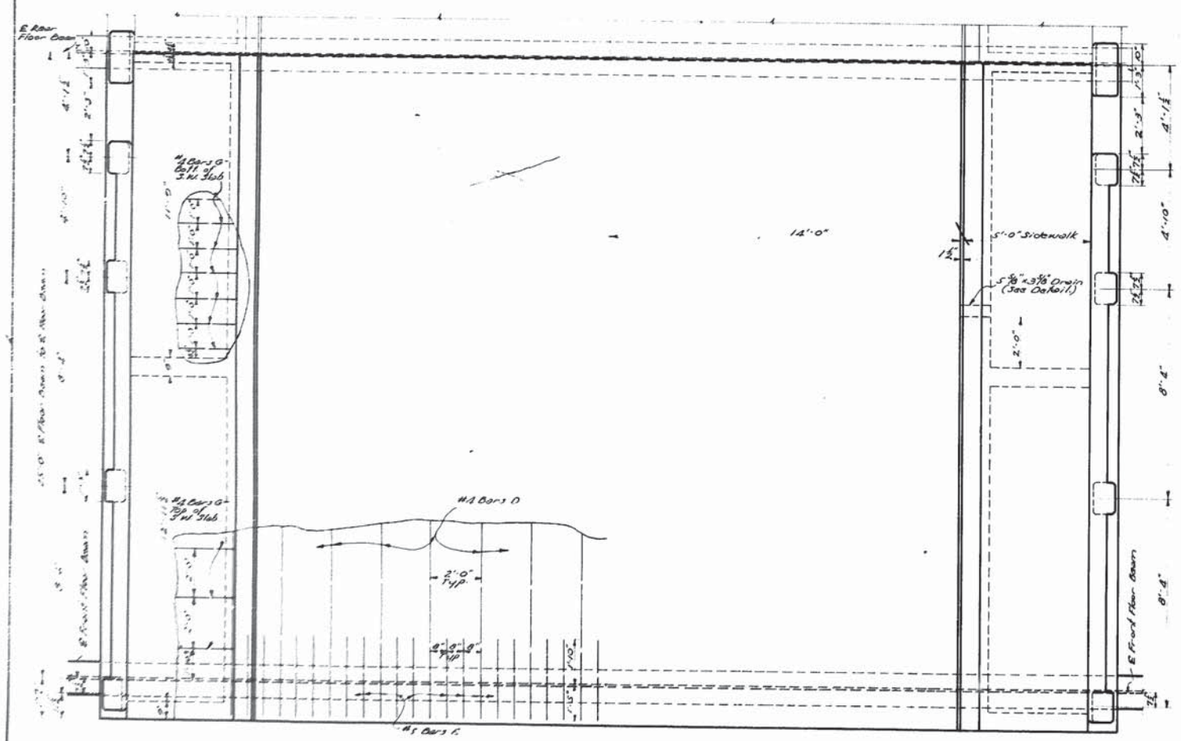

HALF PLAN
SHOWING HANDRAIL ON SIDE OPPOSITE STAIRS AND REINFORCEMENT AS NOTED

HALF PLAN
SHOWING HANDRAIL SPACING ON STAIR SIDE

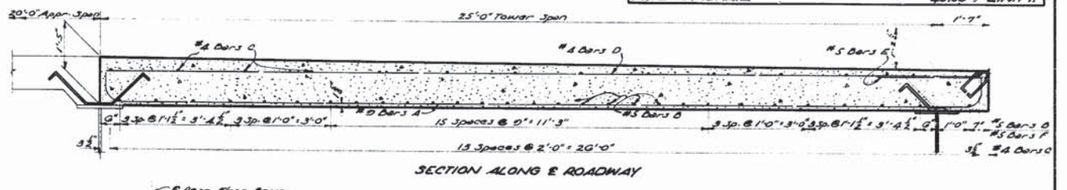

SECTION ALONG ℄ ROADWAY

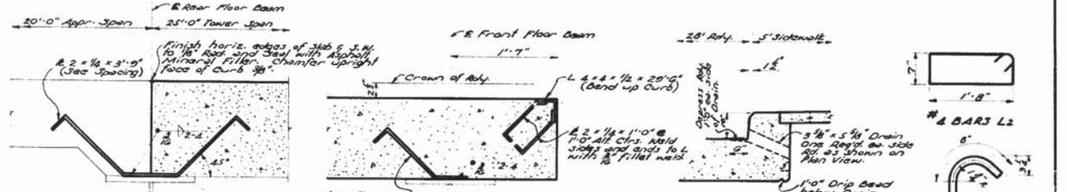

SECTION A-A

SECTION B-B

SECTION SHOWING DRAIN

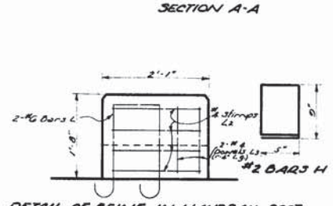

DETAIL OF REINF. IN HANDRAIL POST AT CONSTRUCTION JOINT

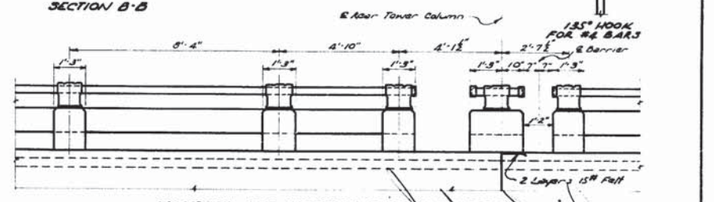

HANDRAIL AND HANDRAIL POST ON STAIR SIDE
OTHER SIDE SIMILAR BUT OPPOSITE HAND

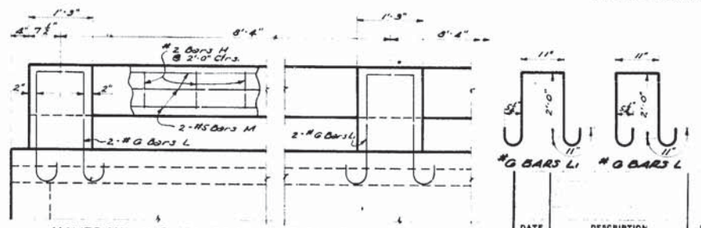

HANDRAIL AND HANDRAIL POST REINFORCEMENT

TOWER SPAN

STANDARD PLAN
150' VERTICAL LIFT SPAN
LIVE LOAD H20-S16-44
28'-0" ROADWAY 5'-0" SIDEWALKS
45'-0 LIFT OPEN STEEL GRID FLOOR
DATED FEB. 28, 1957

STATE OF LOUISIANA
DEPARTMENT OF HIGHWAYS

DESIGNED	DETAILED	TRACED AS MODIFIED
CHECKED SLP	CHECKED SLP	CHECKED

BRIDGE DESIGN SECTION

DATE	DESCRIPTION	BY
	REVISIONS	

SHEET 4 OF 26

SL50-150-28

AS BUILT PLANS

HAER No. LA-32

118

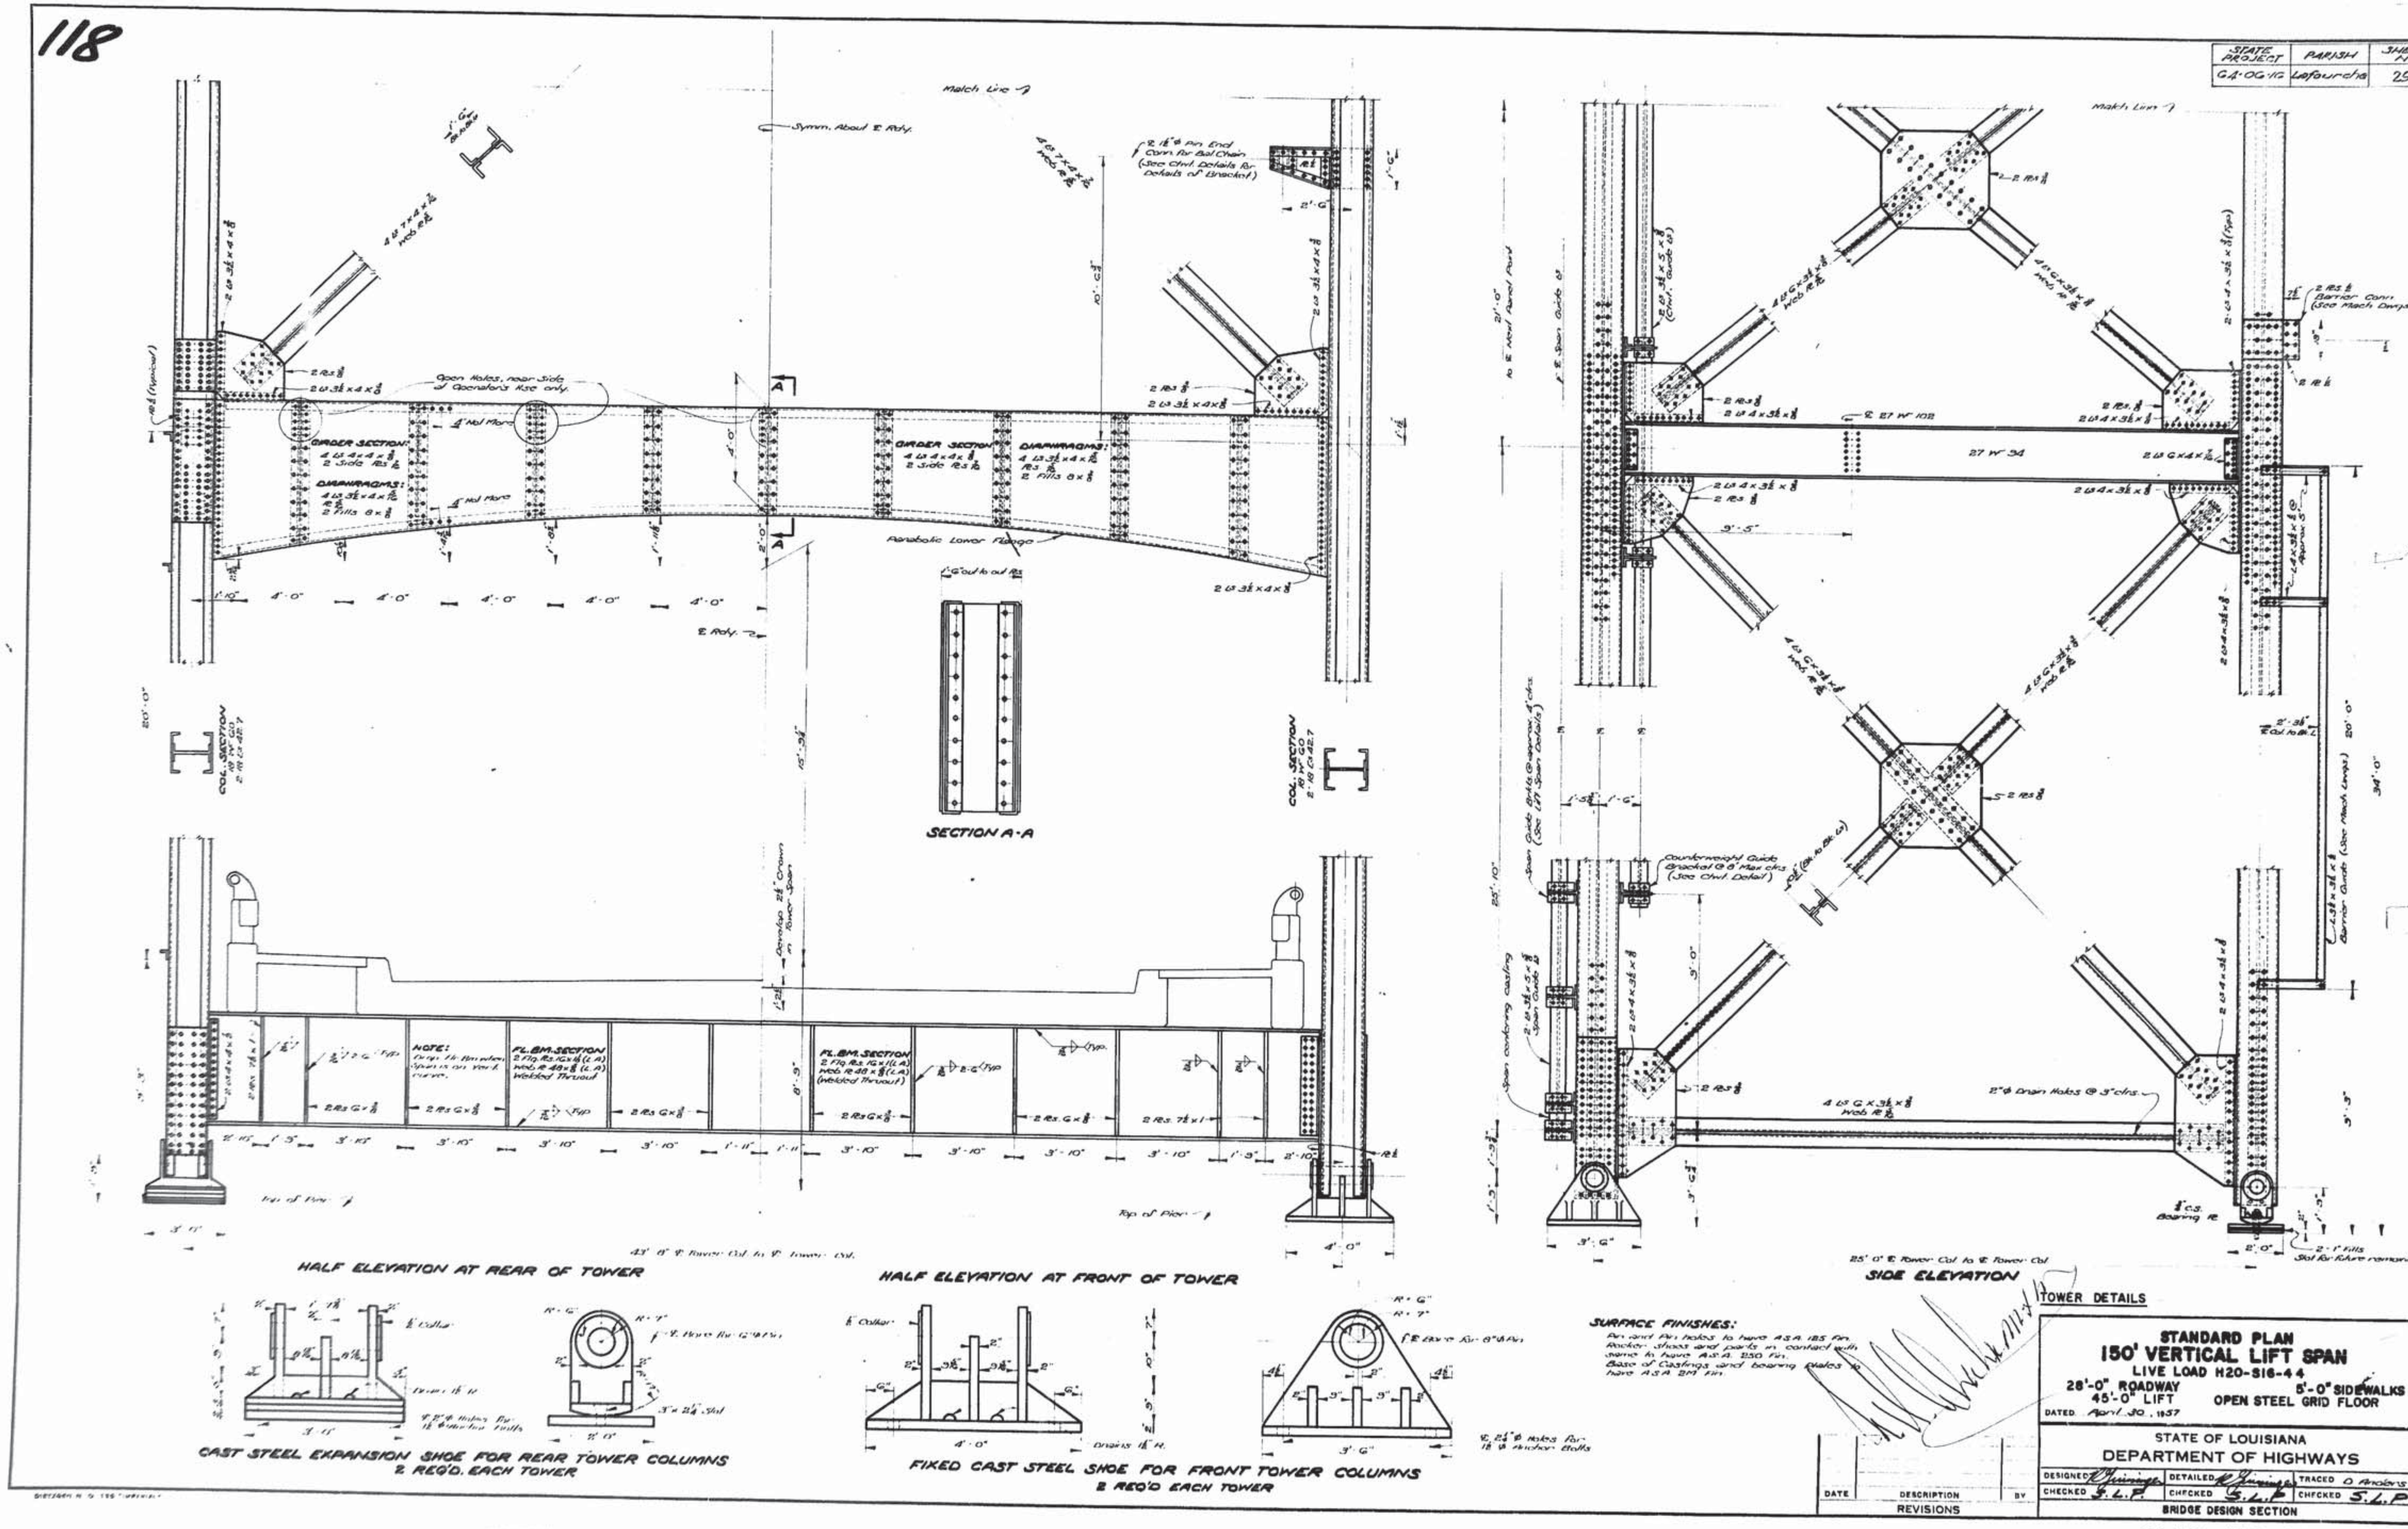

SHEET 5 OF 26

SL50-150-28

HAER No. LA-32

119

STATE PROJECT	PARISH	SHEET NO.
024-06-12	Lafourche	30

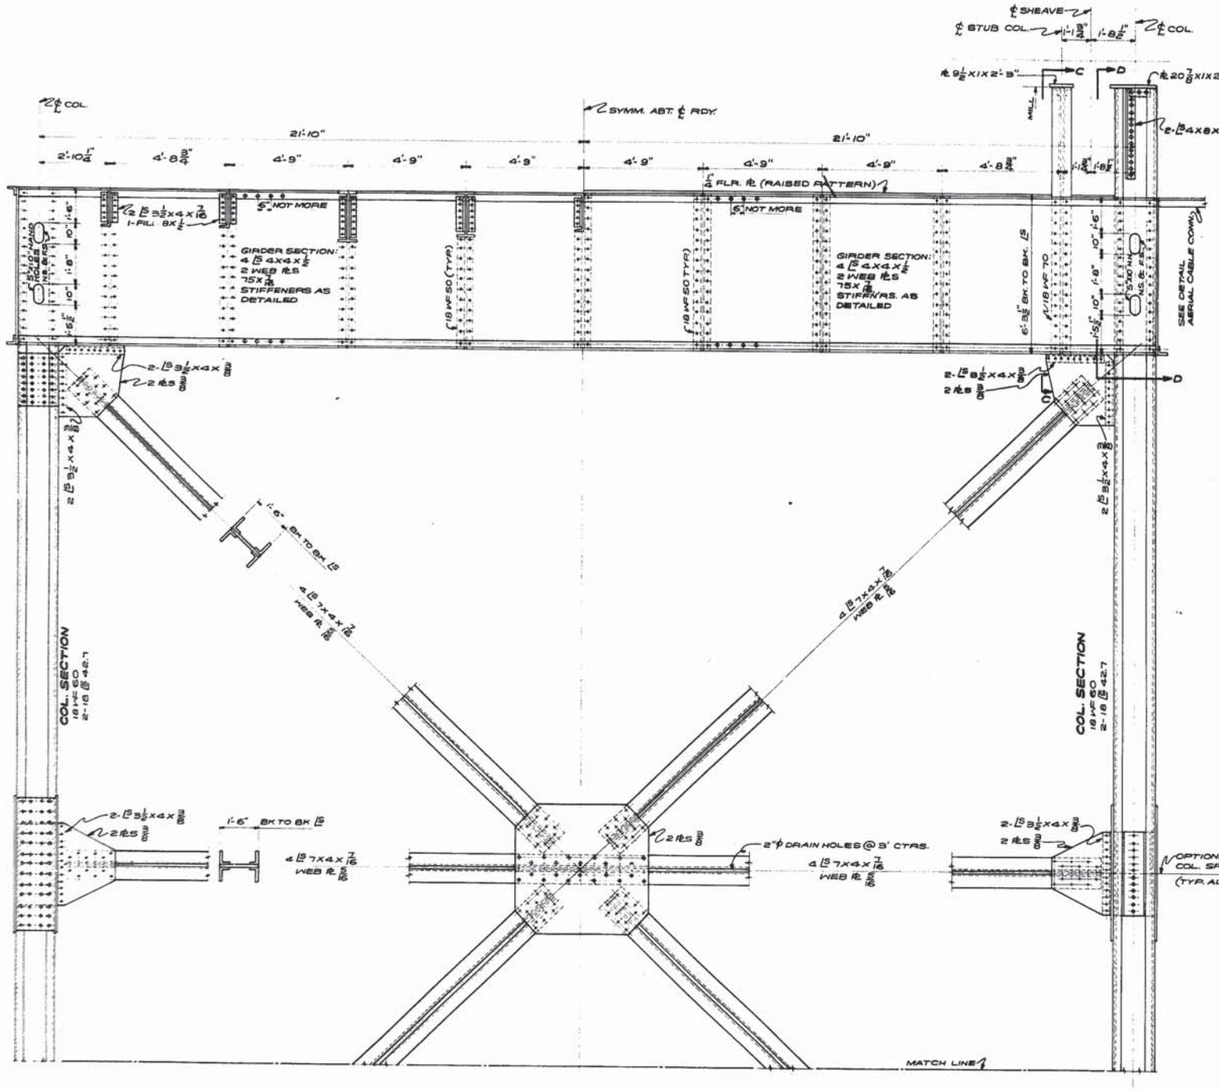

HALF ELEVATION AT REAR OF TOWER

HALF ELEVATION AT FRONT OF TOWER

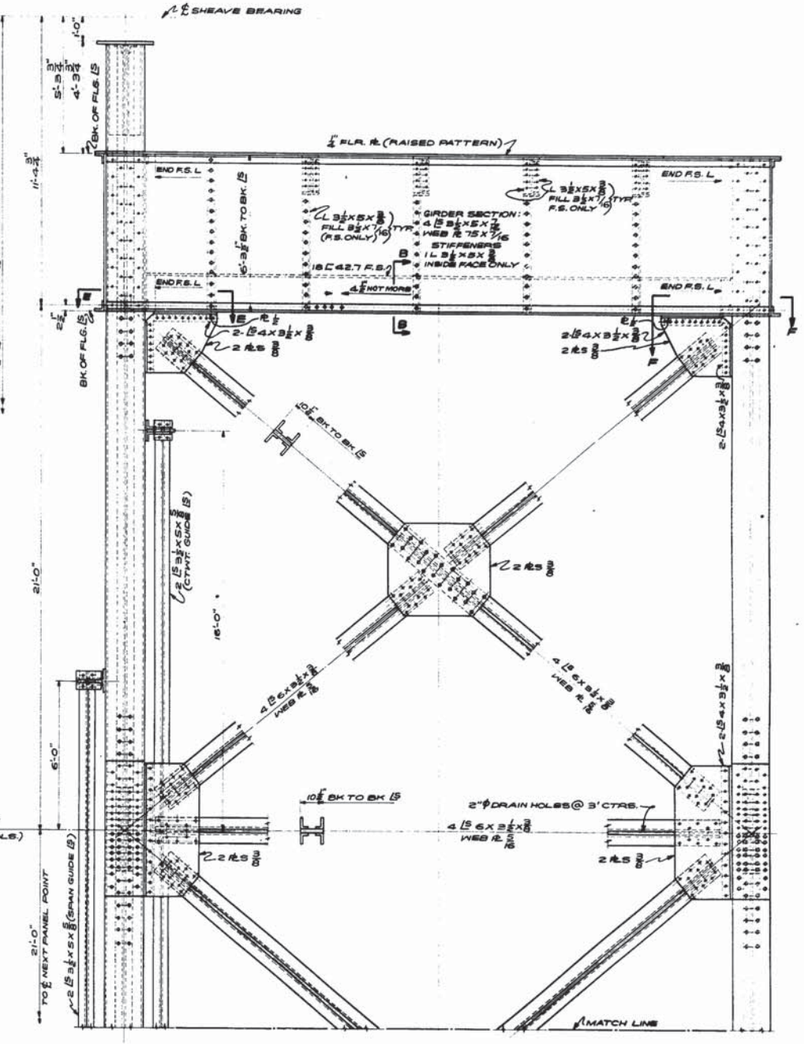

SIDE ELEVATION

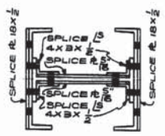

SECTION THRU TYPICAL OPTIONAL COLUMN SPLICE

NOTE: SEE SHEET N° 7 OF 26 FOR SECTION B-B, C-C, D-D, E-E AND F-F

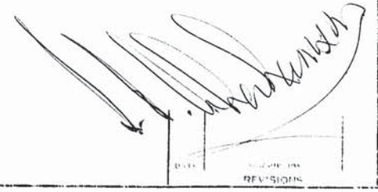

TOWER DETAILS

STANDARD PLAN
150' VERTICAL LIFT SPAN
LIVE LOAD H20-S16-44
28'-0" ROADWAY 5'-0" SIDEWALKS
45'-0" LIFT OPEN STEEL GRID FLOOR
APRIL 23 57

STATE OF LOUISIANA
DEPARTMENT OF HIGHWAYS
S.L.P. S.L.P. S.L.P.
BRIDGE DESIGN SECTION

REVISIONS

SHEET 6 OF 26

SL50-150-28

AS BUILT PLANS

20

STATE PROJECT	PARISH	SHEET NO

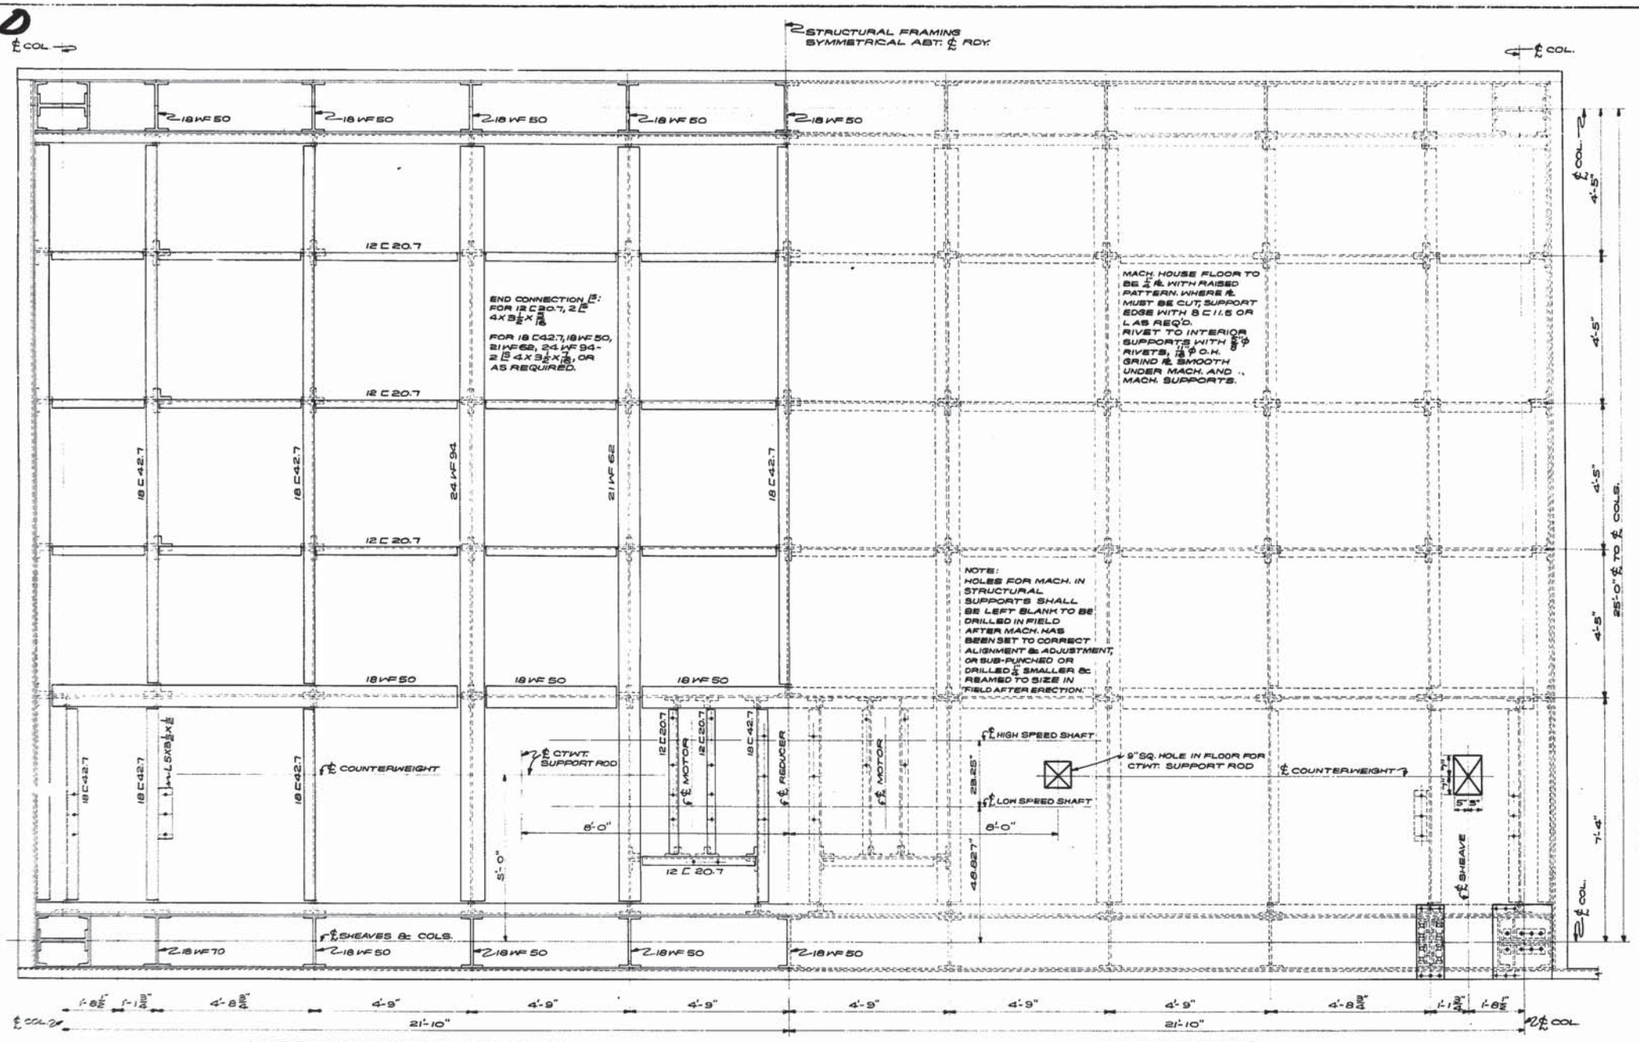

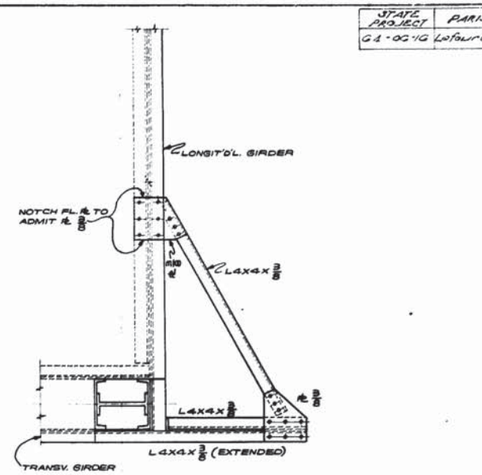

DETAILS AERIAL CABLE BRACKET (4 REQ'D.)

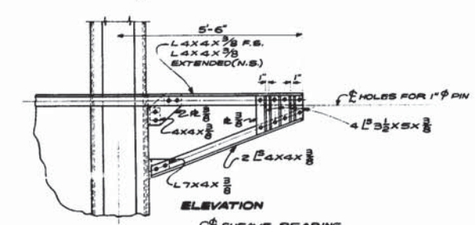

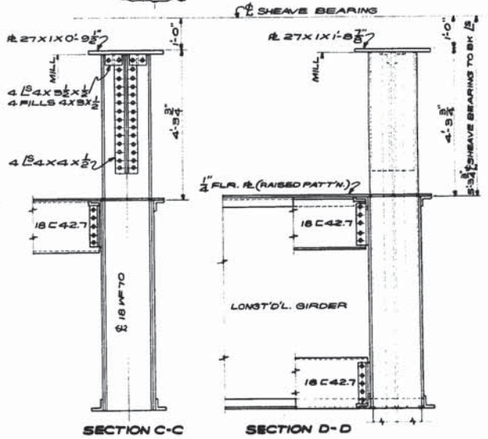

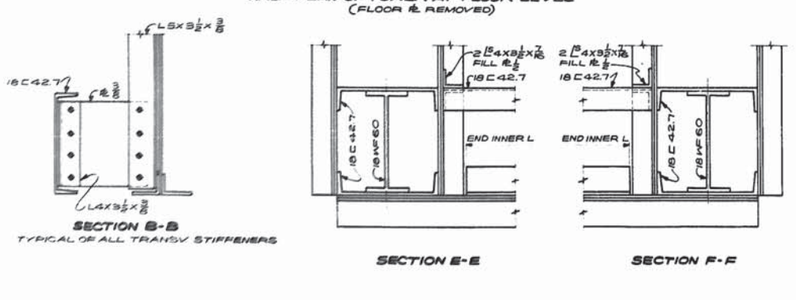

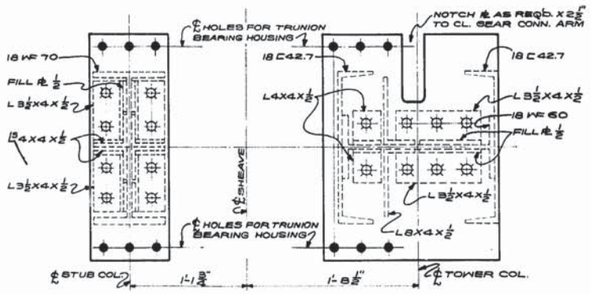

NOTE: FOR DETAIL OF CHANNEL PL. AROUND MACHINERY HOUSE, SEE DETAILS OF MACHINERY HOUSE.

TOWER DETAILS

STANDARD PLAN
150' VERTICAL LIFT SPAN
LIVE LOAD H20-S16-44
28'-0" ROADWAY 5'-0" SIDEWALKS
45'-0" LIFT OPEN STEEL GRID FLOOR
DATED APRIL 29 1957

STATE OF LOUISIANA
DEPARTMENT OF HIGHWAYS
CHIEF ENGINEER S.E. | DIRECTOR OF PUBLIC WORKS S.E. | A. Chapman STATE HIGHWAY ENGINEER S.E.
BRIDGE DESIGN SECTION

DATE | SPECIFICATIONS | REVISIONS

SHEET 7 OF 26

SL50-150-28

AS BUILT PLANS

HAER No. LA-32

121

STATE PROJECT	PARISH	SHEET NO.
Gal. 066-16	Lafourche	32

NOTE: The Platform Req'd at Operators House only

Ladder to top of Operator's Hse. See detail this Sheet

Outline of House

PLAN LANDING AT OPERATOR'S HOUSE

SECTION B-B

SECTION D-D

TYPICAL BRACKET DETAIL AT INTERMEDIATE LANDINGS

TYPICAL CONN. DETAIL 12 E TO BRACING

NOTES FOR STAIRWAYS & LANDINGS:

Frame all stairway landings with 12 B 20.7 unless otherwise shown. Cover to be 14 4 x 18 x 5/16 unless otherwise shown or required. All stair stringers to be 10 B 15.3. Stair treads to be Irving Type 30 X Bar, molded, 5.5# psf, 3/8 wide with 1/2 bearing bars, or approved equal. Stair landings and platforms to have 3/4 Floor fit with raised pattern.

All Pipe Handrail to be 1 1/2 " Std Black Pipe. Use 3/4" rivets with 13/16" open holes for stairway risers, 1 3/8" rivets with 1 1/16" open holes for connecting floor fit to supports. Countersink all exposed rivets on walking surfaces. All Handrail, stairways, landings, treads and floor plate to be classified and inspected for as fabricated Carbon Steel.

SIDE ELEVATION

REAR ELEVATION

NOTE: Fire HR not shown this view

DETAIL OF TREAD SPACING

VIEW A-A

PLAN AT TOWER STAIR SIDEWALK

SECTION C-C

SECTION E-E

PLAN LANDING AT MACH. HOUSE

LADDER DETAIL

4 REQ'D. TOTAL FOR RIVERS
1 REQ'D. AT Op. HSE.

TOWER STAIRWAY DETAILS

DATE	DESCRIPTION	BY
	REVISIONS	

STANDARD PLAN
150' VERTICAL LIFT SPAN
LIVE LOAD H20-S16-44
28'-0" ROADWAY 5'-0" SIDEWALKS
45'-0" LIFT OPEN STEEL GRID FLOOR
DATED April 24, 1957

STATE OF LOUISIANA
DEPARTMENT OF HIGHWAYS

DESIGNED	DETAILED	TRACED
CHECKED S.L.P.	CHECKED S.L.P.	CHECKED S.L.R.

BRIDGE DESIGN SECTION

SHEET 8 OF 26

SL50-150-28

AS BUILT PLANS

122

STATE PROJECT	PARISH	SHEET NO.
064-02-16	Lafourche	33

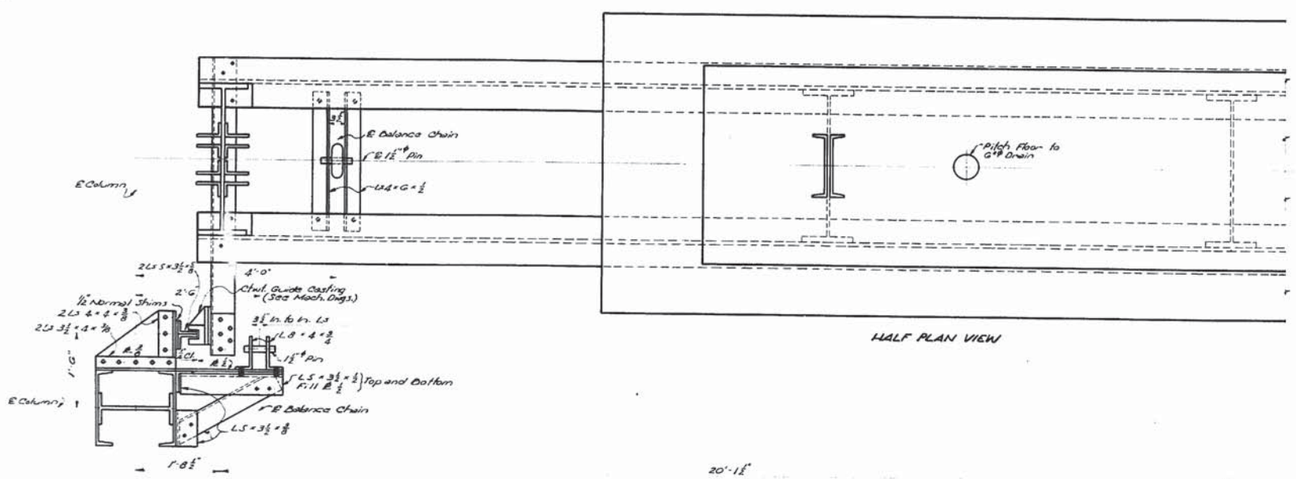

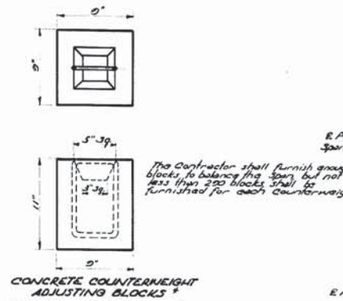

BALANCE CHAINS:
(4) Balance chains required, (2) per counterweight, each approx. 85' long. Balance Chains to be 2⅞" NS Alloy X-1 Grade Iron Chains as listed in Woodward, Wright & Co. Cat. N° 90, or approved equal. Desired weight of chain is 27.7 lbs. per ft. throughout; the weight per foot of chain shall be not more than 28 lbs. and not less than 26 lbs.
Balance chains are to be galvanized.

Approx. wt. of (4) chains = 9478 Lbs.
Balance Chains will be paid for per lump sum.

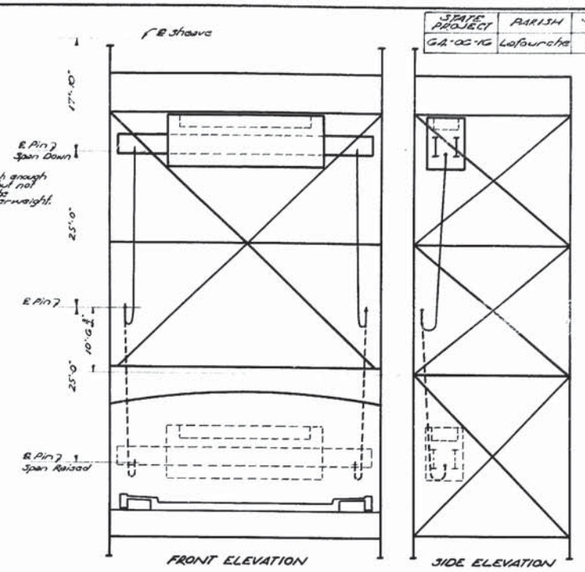

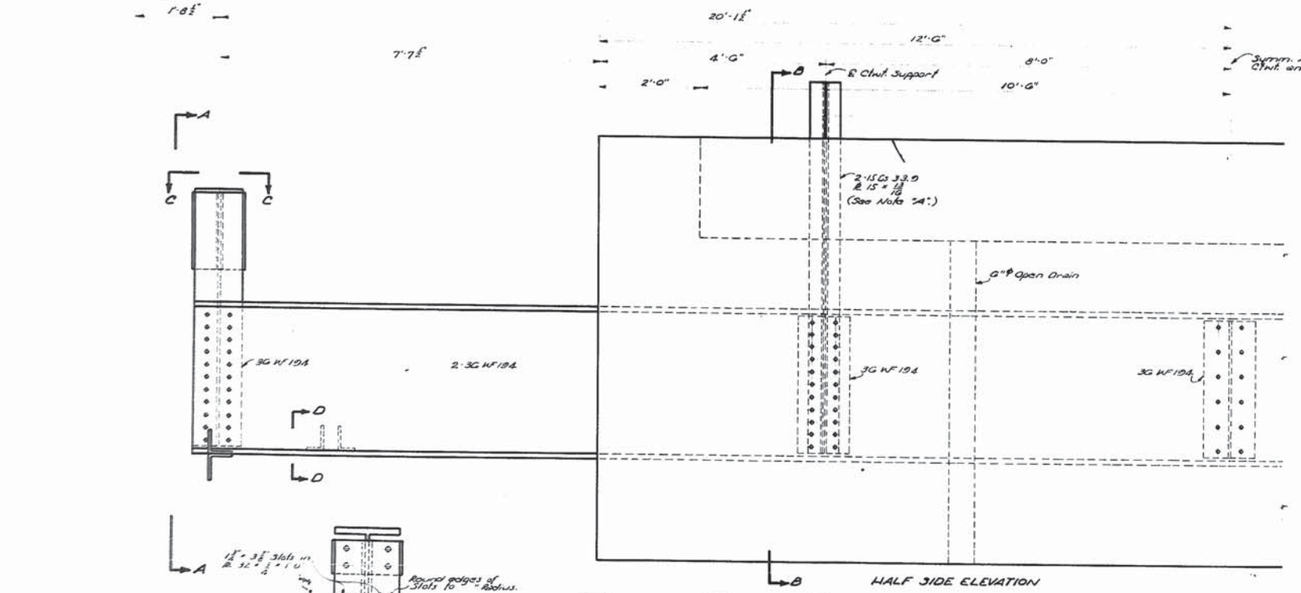

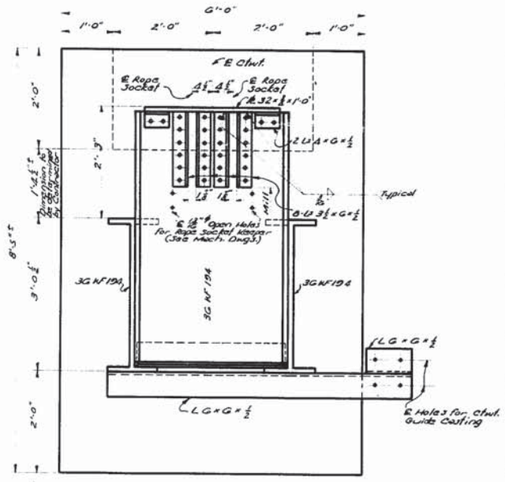

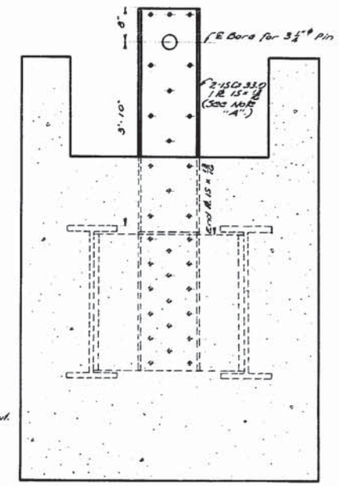

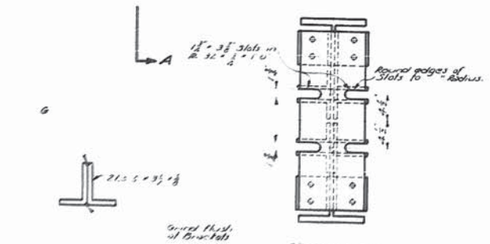

WELDING DETAIL FOR COUNTERWEIGHT GUIDE L's

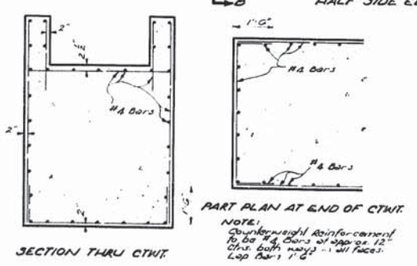

SECTION THRU CTWT.

PART PLAN AT END OF CTWT.

NOTE:
Counterweight Reinforcement to be ½" ϕ Bars at spac. 12" Ctwt. both ways in all faces. Lap Bars 1'-6"

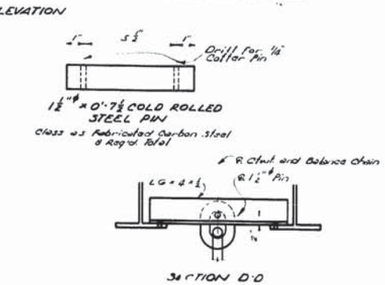

	SPAN CLOSED	SPAN RAISED
Wt. of Span	385.5 Kips	385.5 Kips
Wt. of 50' of Ropes	3.4	3.4
	388.9 Kips	388.5 Kips
Wt. of 2 Ctwts.	380.2 Kips	380.2 Kips
Wt. of 50' of Ropes	3.4	3.4
Wt. of Balance Chains	6.8	6.8
	387.0 Kips	389.6 Kips

NOTE "A":
This material is classified as erection material and no direct payment will be made for same. See Sheet of Counterweight, Erection Details also.

COUNTERWEIGHT DETAILS

STANDARD PLAN
150' VERTICAL LIFT SPAN
LIVE LOAD H20-S16-44
28'-0" ROADWAY — 5'-0" SIDEWALKS
45'-0" LIFT — OPEN STEEL GRID FLOOR
DATED April 16, 1951

STATE OF LOUISIANA
DEPARTMENT OF HIGHWAYS
DESIGNED [illegible] TRACED [illegible]
CHECKED S.L.P. CHECKED S.L.P. CHIEF ENG. S.L.P.
BRIDGE DESIGN SECTION

DATE DESIGNER REVISIONS

SHEET 9 OF 26

SL 50-150-28

AS BUILT PLANS

123

STATE PROJECT	PARISH	SHEET NO.
64-00-16	Lafourche	34

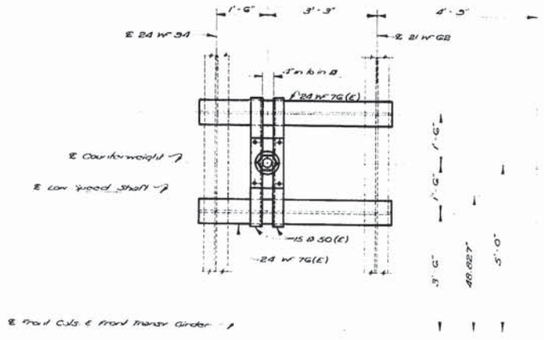

PLAN VIEW AT SUPPORTING DEVICE

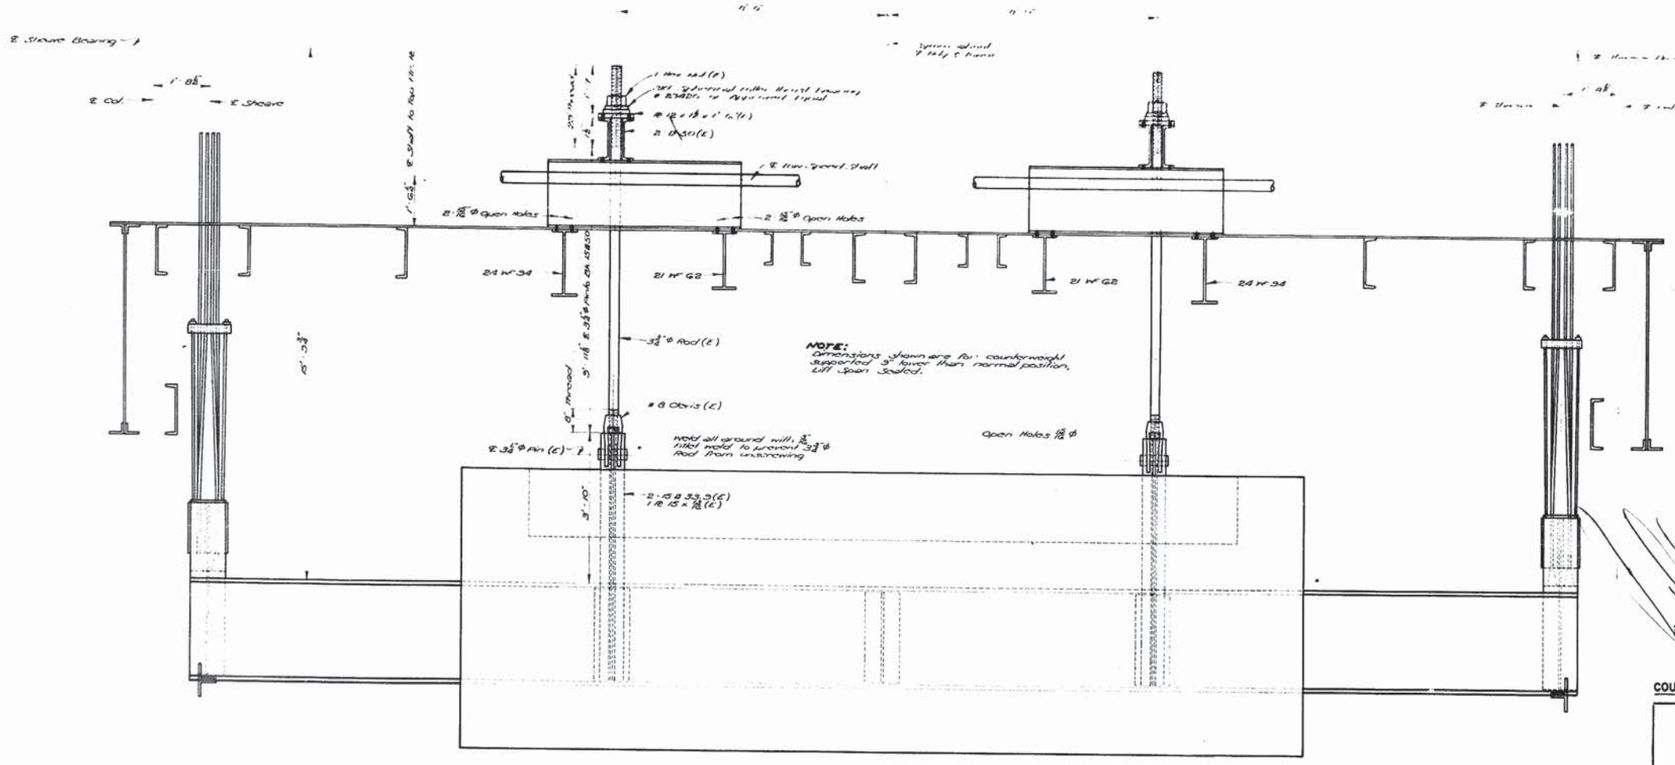

SUGGESTED METHOD OF SUPPORTING COUNTERWEIGHT DURING ERECTION

NOTES:

The method of supporting the counterweight in the event the contractor elects to float in the completed lift span is suggestive only, and the contractor may use any other satisfactory method of his choice. All items marked (E) are classified as erection material.

No direct payment will be made for erection material, and all material so classified, with the exception of 6 @ 33.3 and 15 × ⅞ permanently fixed to counterweight, shall remain the property of the contractor.

COUNTERWEIGHT ERECTION DETAILS

STANDARD PLAN
150' VERTICAL LIFT SPAN
LIVE LOAD H20-S16-44
26'-0" ROADWAY 5'-0" SIDEWALKS
45'-0" LIFT OPEN STEEL GRID FLOOR
DATED May 3 , 1957

STATE OF LOUISIANA
DEPARTMENT OF HIGHWAYS

DESIGNED	DETAILED	TRACED
CHECKED	CHECKED	CHECKED

BRIDGE DESIGN SECTION

DATE	DESCRIPTION	BY

REVISIONS

SHEET 10 OF 26

SL50-150-28

SIZE SHEET N. S. 15" "APPROX."

AS BUILT PLANS

HAER No. LA-32

124

STATE PROJECT	PARISH	SHEET NO.
658-06-16	Lafourche	35

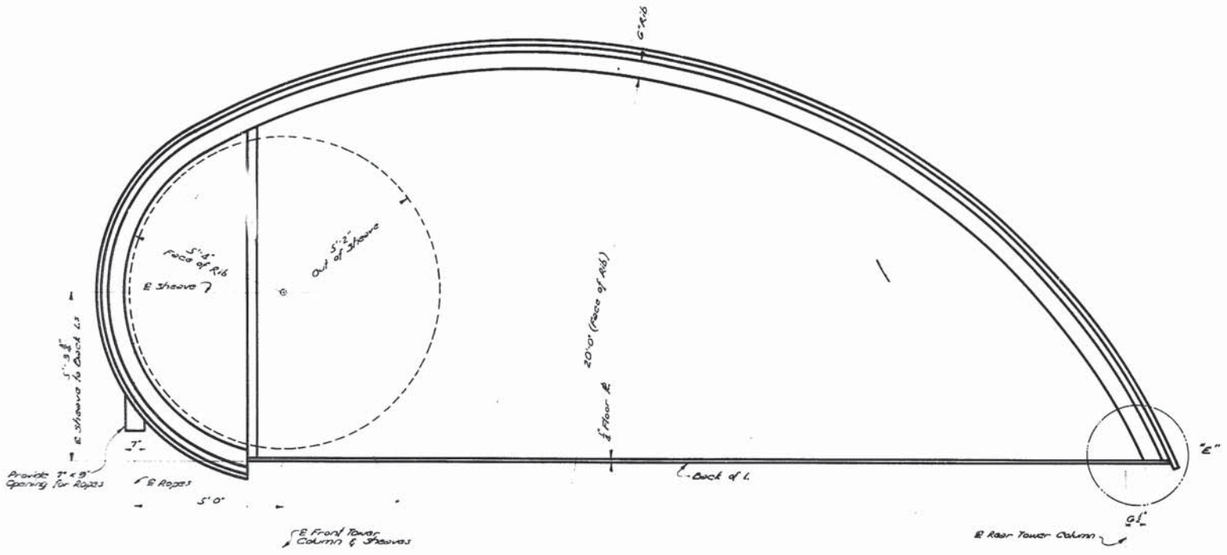

OUTLINE DIMENSIONS
SCALE: 1/4" = 1'-0"

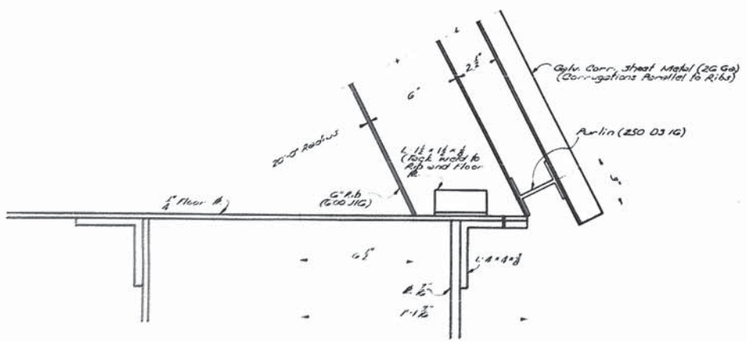

SECTION "E"

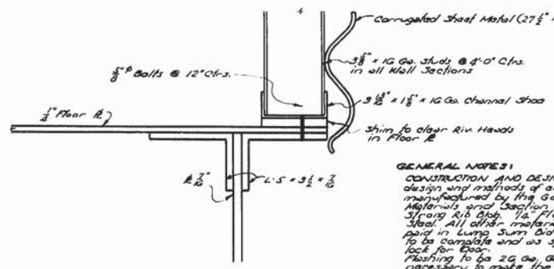

SIDE WALL CONNECTION DETAIL

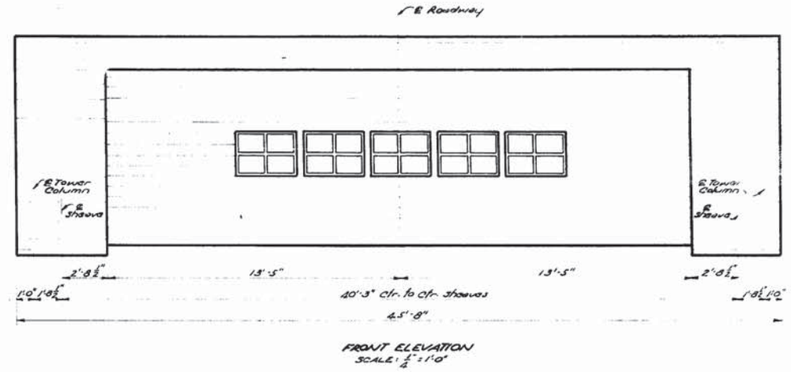

FRONT ELEVATION
SCALE: 1/4" = 1'-0"

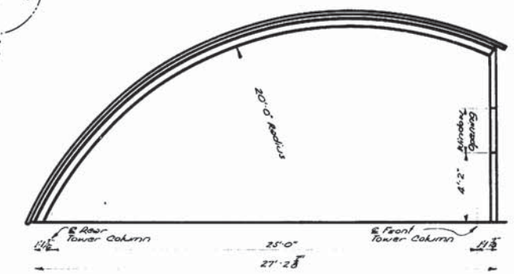

SECTION ALONG E ROADWAY
SCALE: 1/4" = 1'-0"

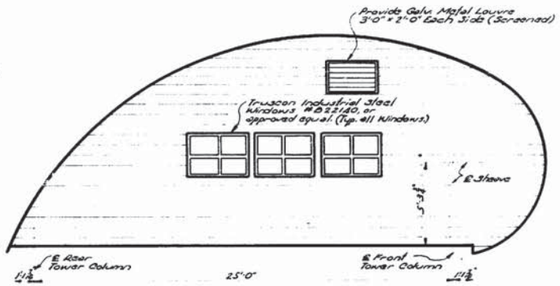

SIDE ELEVATION
SCALE: 1/4" = 1'-0"

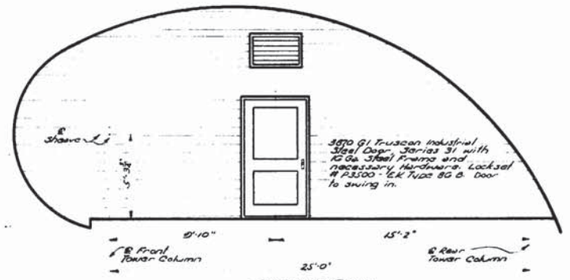

SIDE ELEVATION
SCALE: 1/4" = 1'-0"

GENERAL NOTES:

CONSTRUCTION AND DESIGN SPECIFICATIONS: According to the latest design and methods of erection of the "80 STRONG RIB BLDG.", as manufactured by the Gordon-Taylor Steel Co. or an approved equal. Materials and Section to be the equivalent, or better than this 40' Strong Rib Bldg. Ia. Floor & to be paid for as Fabricated Carbon Steel. All other materials necessary to complete house are to be paid in Lump Sum Bid for "Machinery House". Door and windows to be complete and as specified, or an approved equal. Provide lock for Door.

Flashing to be 26 Ga. Galv. Sheet Metal, and provided where necessary to make the house substantially watertight.

Doors and Windows to be glazed with polished wire glass.

Provide necessary bracing in walls and ceiling.

Galv. Surfaces to receive two field coats of aluminum paint. All foreign material shall be removed from surfaces before painting. The Contractor will not be required to treat Galv. Surfaces with solution stipulated in Specifications "Painting of Metal Surfaces" Art. 4.13, Part 5, Div. II, 31st. Specs.

MACHINERY HOUSES

STANDARD PLAN
150' VERTICAL LIFT SPAN
LIVE LOAD H20-S16-44
28'-0" ROADWAY 5'-0" SIDEWALKS
45'-0" LIFT OPEN STEEL GRID FLOOR
DATED May 8 1957

STATE OF LOUISIANA
DEPARTMENT OF HIGHWAYS

DESIGNED	DETAILED	TRACED
CHECKED	CHECKED	CHECKED

BRIDGE DESIGN SECTION

DATE	DESCRIPTION	BY
	REVISIONS	

SHEET 11 OF 26

SL50-150-28

AS BUILT PLANS

HAER No. LA-32

125

STATE PROJECT	PARISH	SHEET NO.
66-06-16	Lafourche	35

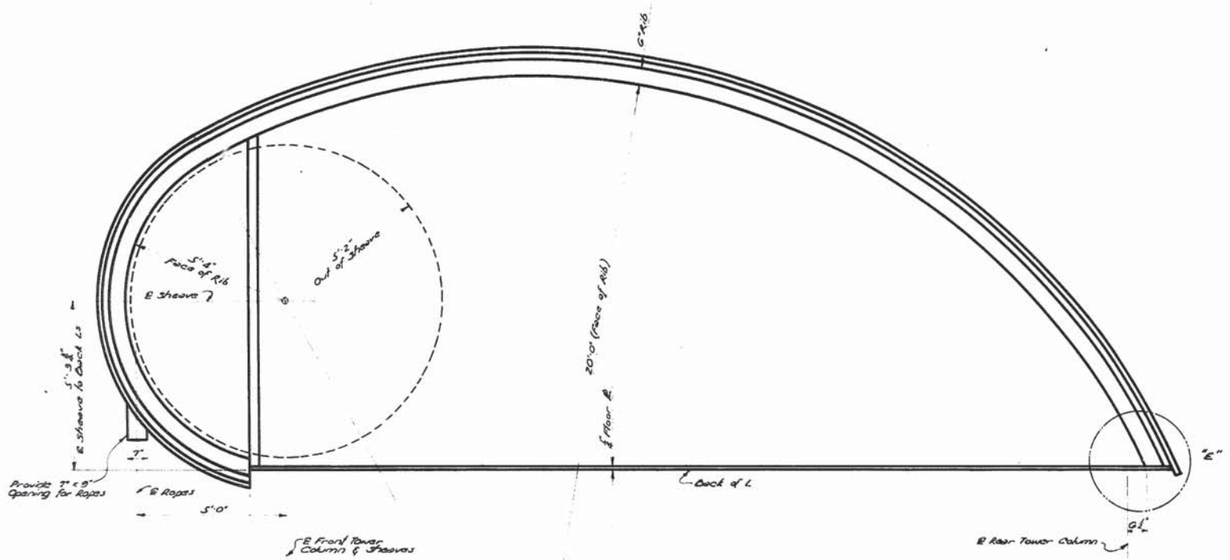

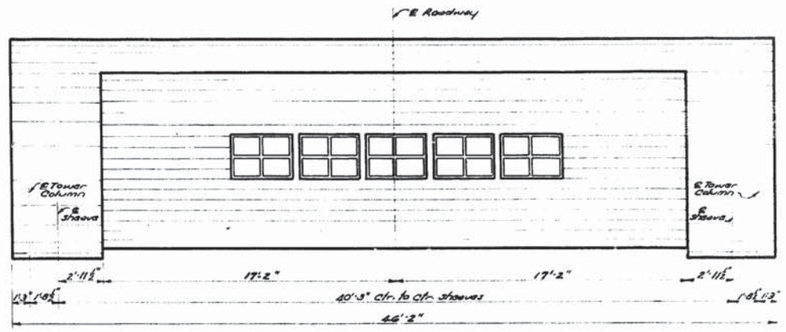

FRONT ELEVATION
SCALE: ½" = 1'-0"

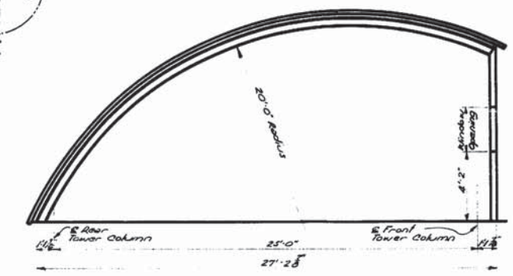

SECTION ALONG E ROADWAY
SCALE: ½" = 1'-0"

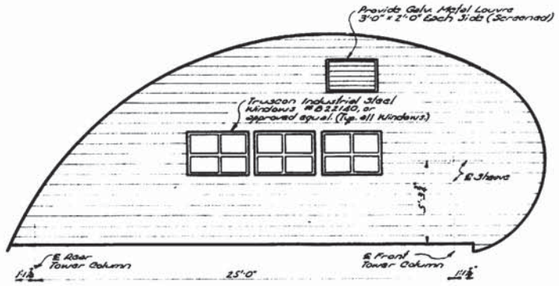

SIDE ELEVATION
SCALE: ½" = 1'-0"

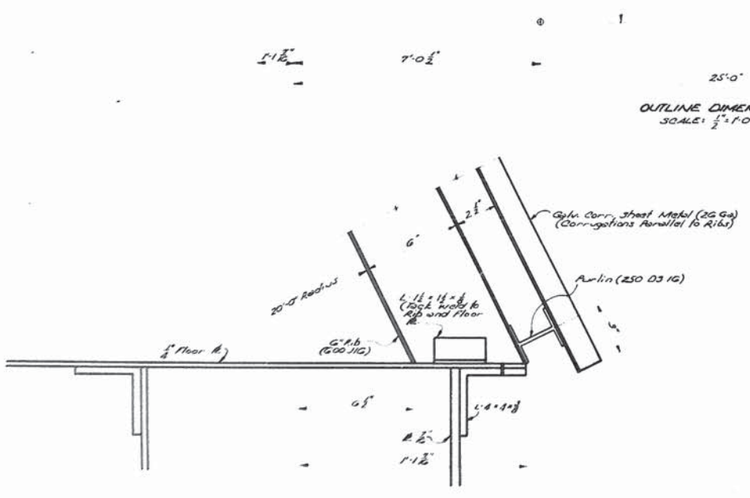

OUTLINE DIMENSIONS
SCALE: ½" = 1'-0"

SECTION "E"

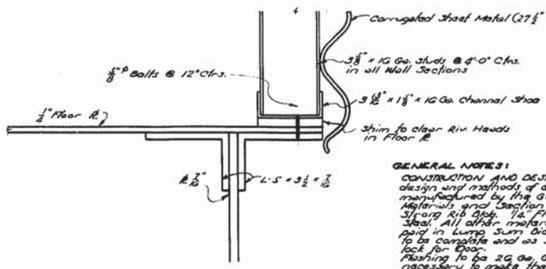

SIDE WALL CONNECTION DETAIL

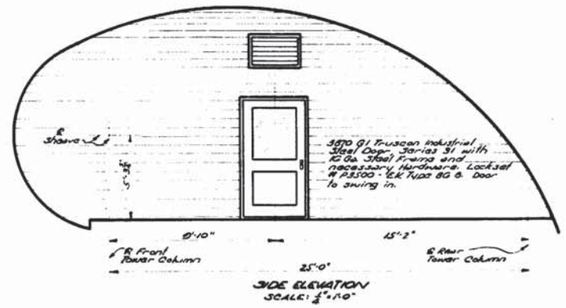

SIDE ELEVATION
SCALE: ½" = 1'-0"

GENERAL NOTES:
CONSTRUCTION AND DESIGN SPECIFICATIONS: According to the latest design and methods of erection of the "40' STRONG RIB BLDG.", as manufactured by the Gaston Taylor Steel Co. or an approved equal. Materials and section to be the equivalent of, or better than the 40' Strong Rib Bldg. ¼" Floor R. to be paid for as Fabricated Carbon Steel. All other materials necessary to complete house are to be paid in Lump Sum bid for "Machinery House". Door and windows to be complete and as specified, or an approved equal. Provide lock for Door.
Flashing to be 26 Ga. Galv. Sheet Metal, and provided where necessary to make the house substantially watertight.
Doors and Windows to be glazed with polished wire glass.
Provide necessary bracing in walls and ceiling.
Galv. Surfaces to receive two field coats of aluminum paint. All foreign material shall be removed from surface before painting. The Contractor will not be required to treat Galv. Surfaces with solution stipulated in "Specifications "Painting of Metal Surfaces" Art 4.13, Part 5, Div. II, 31st. Specs.

MACHINERY HOUSES

STANDARD PLAN
150' VERTICAL LIFT SPAN
LIVE LOAD H20-S16-44
28'-0" ROADWAY 5'-0" SIDEWALKS
45'-0" LIFT OPEN STEEL GRID FLOOR
DATED May 6, 1957

STATE OF LOUISIANA
DEPARTMENT OF HIGHWAYS

DESIGNED	DETAILED	TRACED M. MONCRIEF
CHECKED	CHECKED	CHECKED

BRIDGE DESIGN SECTION

DATE	DESCRIPTION	BY
3.5.59	Dimens. Front elev.	RG/EN

REVISIONS

SHEET 11 OF 28

SI.50-150-28

AS BUILT PLANS

HAER No. LA-32

126

STATE PROJECT	PARISH	SHEET NO.
64-06-16	Lafourche	36

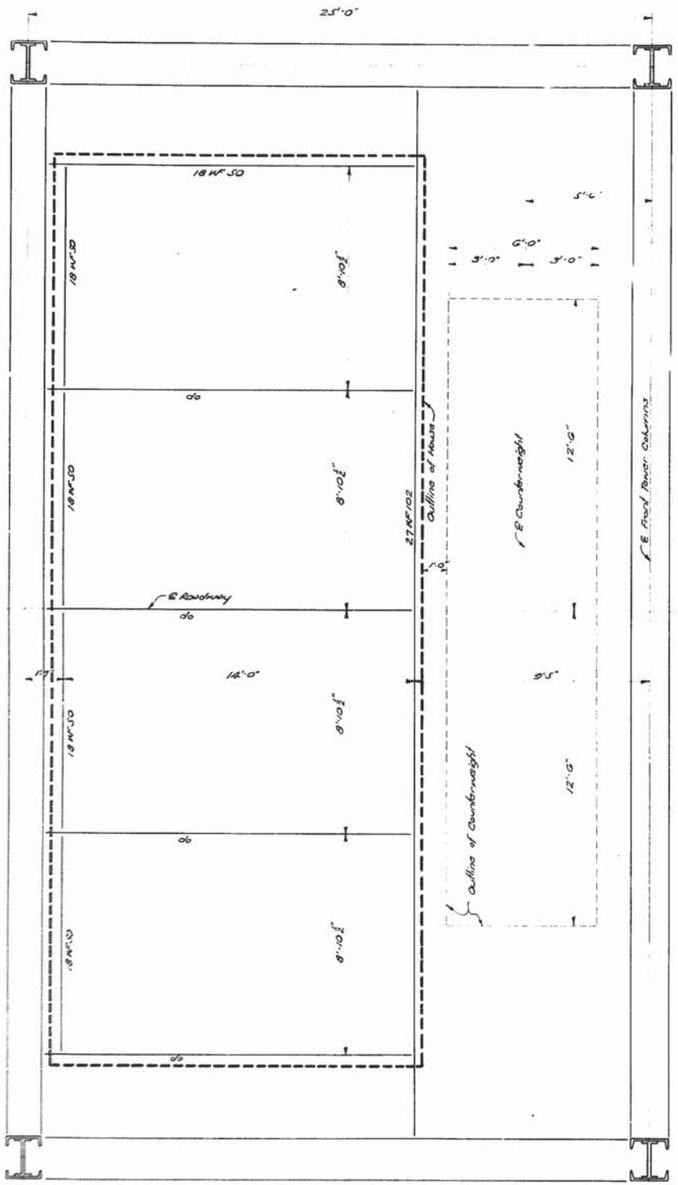

PLAN
SHOWING HOUSE LOCATION AND STRUCTURAL STEEL LOCATION
SCALE: 1/8" = 1'-0"

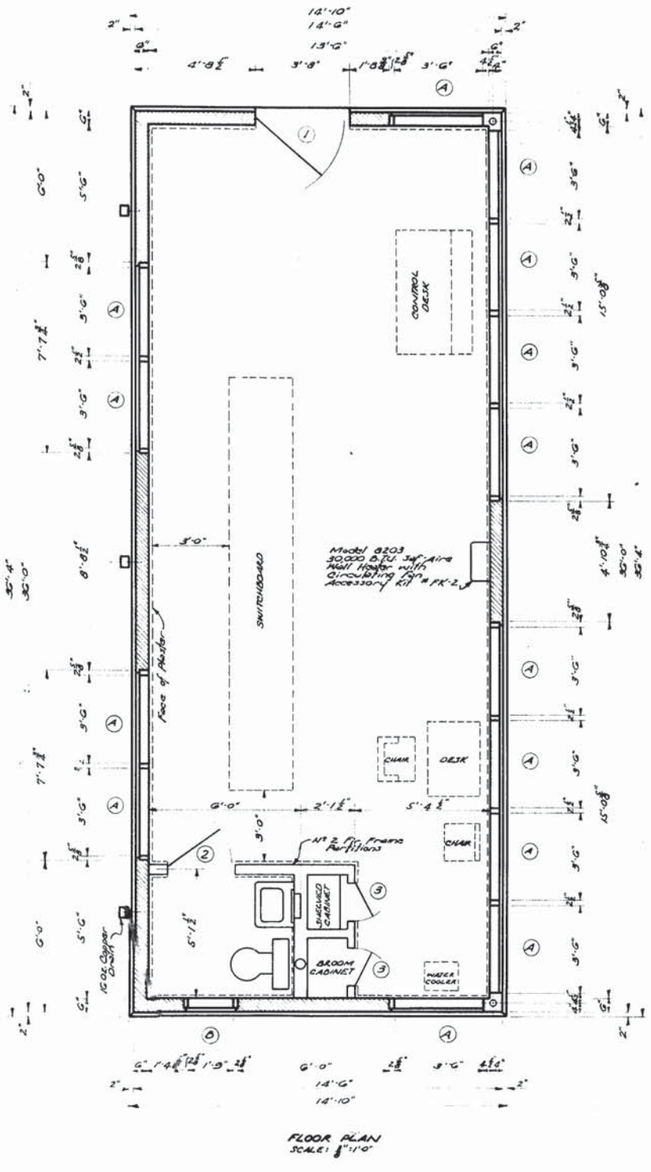

FLOOR PLAN
SCALE: 1/4" = 1'-0"

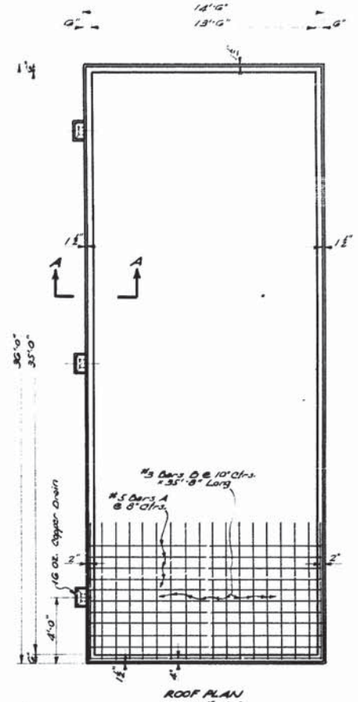

ROOF PLAN
SCALE: 1/4" = 1'-0"

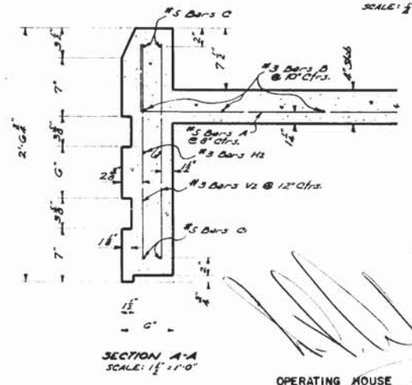

SECTION A-A

NOTE:
All Aluminum surfaces to be placed in contact with or fastened to, steel members shall be thoroughly coated with an approved aluminum impregnated caulking compound. All Aluminum surfaces to be placed in contact with concrete shall be given a heavy coat of an approved alkali-resistant bituminous paint, or a coat of zinc chromate paint and allowed to dry before placing on the concrete.

OPERATING HOUSE

DOOR AND WINDOW SCHEDULE

MARK	SIZE	TYPE	STYLE	REMARKS
1	3'-4" × 7'-0" × 1¾"	Jalousie	42 Glass	Aluminum Frame
2	2'-6" × 6'-8" × 1¾"	Flush	Steel	Steel Metal Frame
3	1'-6" × 6'-8" × 1¾"	Flush	Steel	Steel Metal Frame
A	3'-6" × 6'-1⅝"	Jalousie	65 Glass	Aluminum Frame G33-T5
B	1'-9" × 2'-2½"	Jalousie	65 Glass	Aluminum Frame G33-T5

FINISH SCHEDULE

ITEM	WALLS		CEILING	FLOOR	BASE	TRIM	ROOF	WAINSCOT
	OUTSIDE	INSIDE						
House	Rubbed	Tile & Plaster	Plaster	Tile	Tile	Metal	Tar & Gravel	38" Above Floor
Toilet	-	Tile & Plaster	Plaster	Tile	Tile	Metal	-	30 Above Floor
Cabinets	Plaster	¼" Plywood	Plaster	Tile	-	Metal	-	

STANDARD PLAN
150' VERTICAL LIFT SPAN
LIVE LOAD H20-S16-44
28'-0" ROADWAY 5'-0" SIDEWALKS
45'-0" LIFT OPEN STEEL GRID FLOOR
DATED May 13 1957

STATE OF LOUISIANA
DEPARTMENT OF HIGHWAYS

CHIEF ENGR.	DETAILED	TRACED & MONCRIEF
SUPERVISOR	CHECKED P.C. LAW	CHECKED P.C. LAW

BRIDGE DESIGN SECTION

DATE DESCRIPTION REVISIONS

SHEET 12 OF 28

SL50-150-28

AS BUILT PLANS

127

STATE PROJECT NO. 451314 SHEET NO. 37
GALVEZ, Lafourche

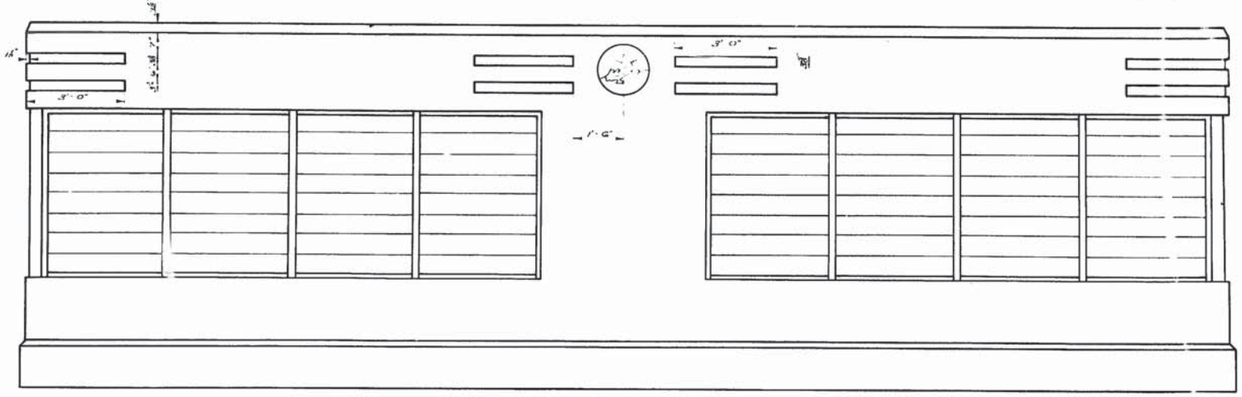

FRONT ELEVATION
SCALE: 1/8" = 1'-0"

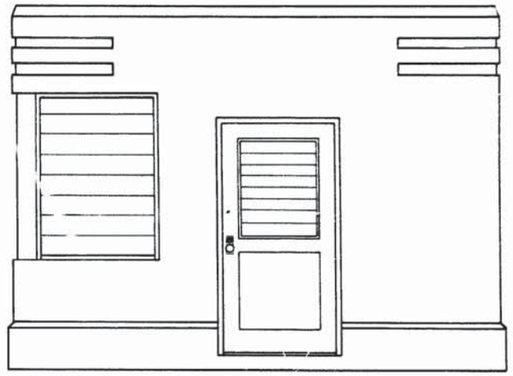

SIDE ELEVATION
SCALE: 1/8" = 1'-0"

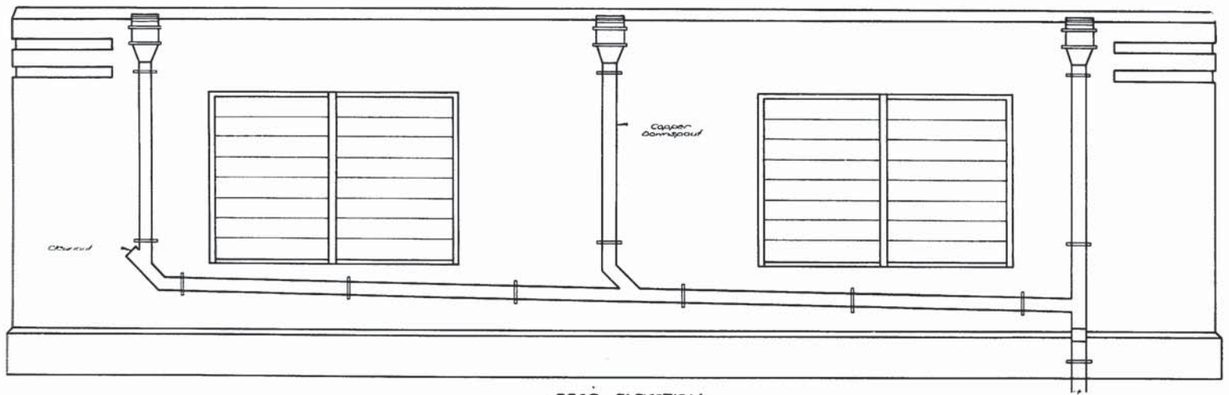

REAR ELEVATION
SCALE: 1/8" = 1'-0"

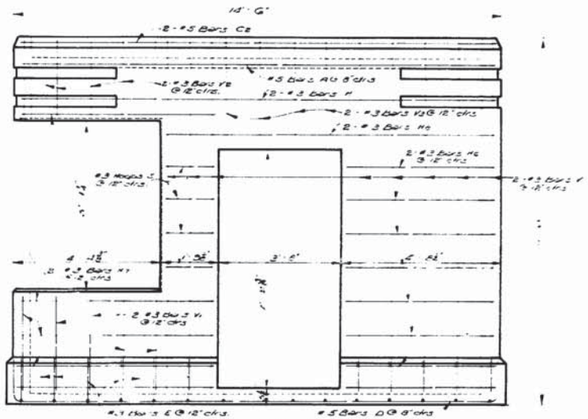

SIDE ELEVATION
SCALE: 1/8" = 1'-0"

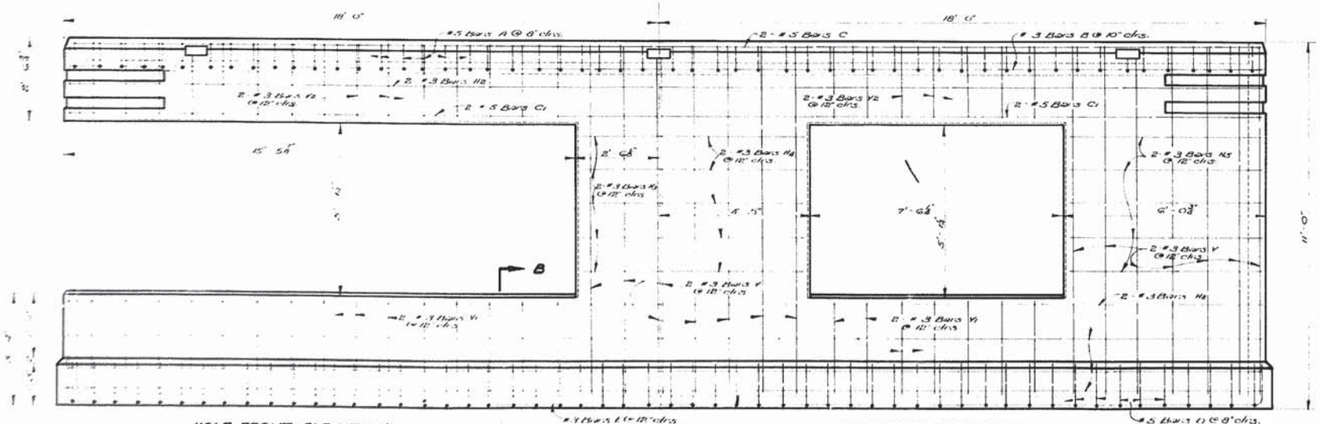

HALF FRONT ELEVATION
SHOWING REINFORCING
SCALE: 1/8" = 1'-0"

HALF REAR ELEVATION
SHOWING REINFORCING
SCALE: 1/8" = 1'-0"

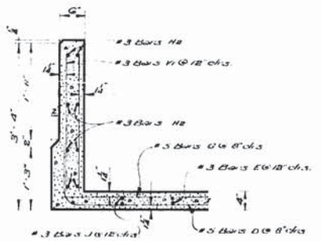

SECTION B-B
SCALE: 1/4" = 1'-0"

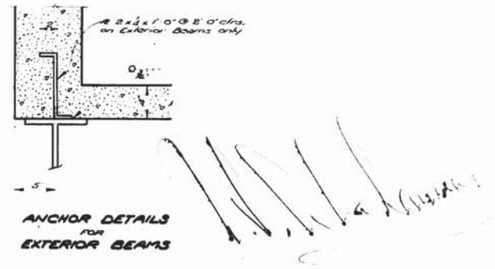

ANCHOR DETAILS FOR EXTERIOR BEAMS

OPERATING HOUSE

STANDARD PLAN
150' VERTICAL LIFT SPAN
LIVE LOAD H20-S16-44
28'-0" ROADWAY 5'-0" SIDEWALKS
45'-0" LIFT OPEN STEEL GRID FLOOR
DATED May 13, 1957

STATE OF LOUISIANA
DEPARTMENT OF HIGHWAYS

DESIGNED Mem	DETAILED Mem	TRACED O. Anders
CHECKED	CHECKED R. E. Land	CHECKED R. E. Land

BRIDGE DESIGN SECTION.

DATE	DESCRIPTION	BY

REVISIONS

SHEET 13 OF 26

SL50-150-28

AS BUILT PLANS

HAER No. LA-32

128

STATE PROJECT	PARISH	SHEET NO
041-06-16	Lafourche	38

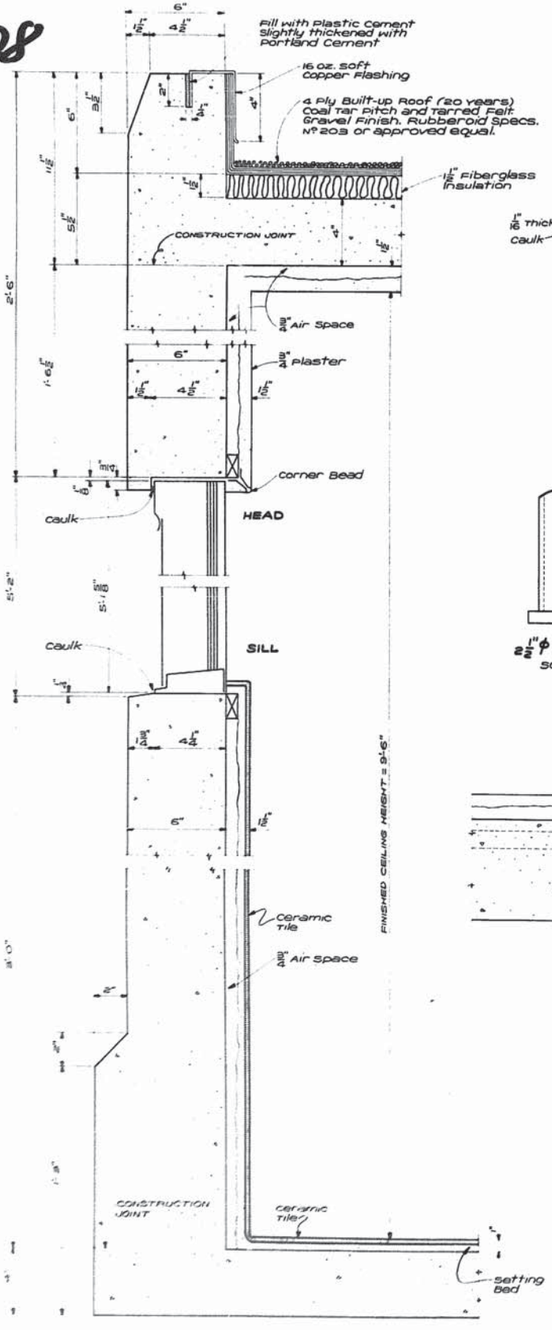

TYPICAL WALL SECTION
SCALE: 1/4" = 1"

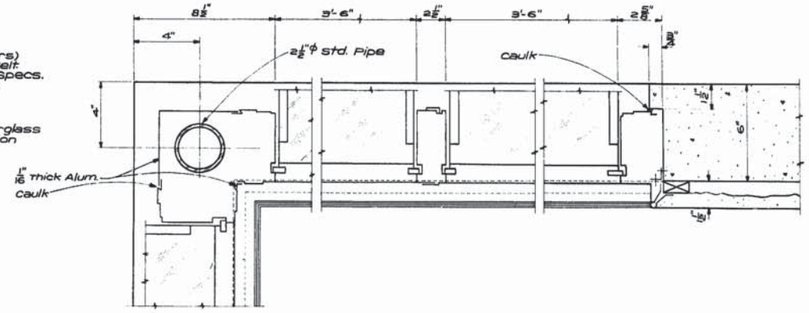

WINDOW MULLION AND JAMB DETAILS
SCALE: 1/4" = 1"

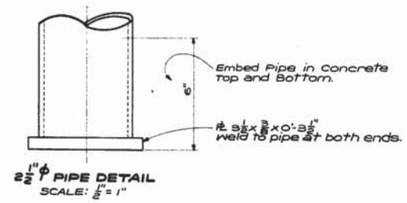

SCALE: 1/2" = 1"

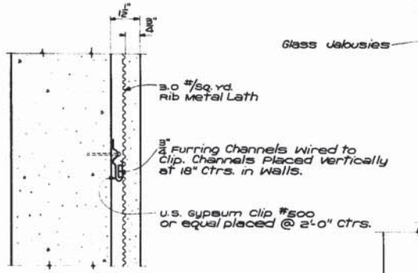

LATHING DETAILS
SCALE: 1/4" = 1"

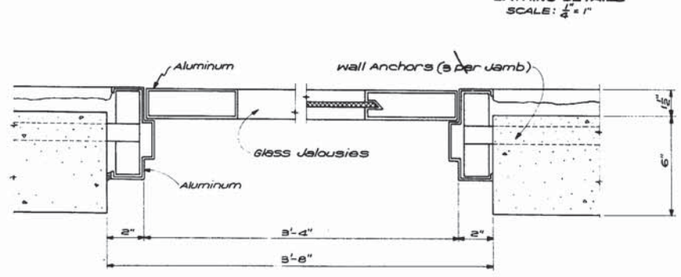

EXTERIOR DOOR JAMB DETAILS
SCALE: 1/4" = 1"

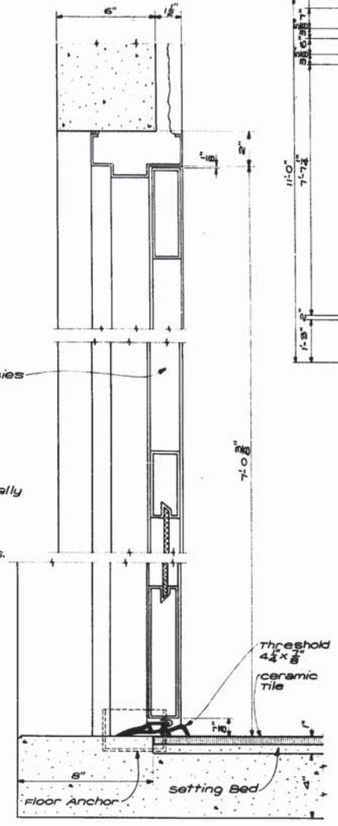

DOOR DETAILS
SCALE: 1/4" = 1"

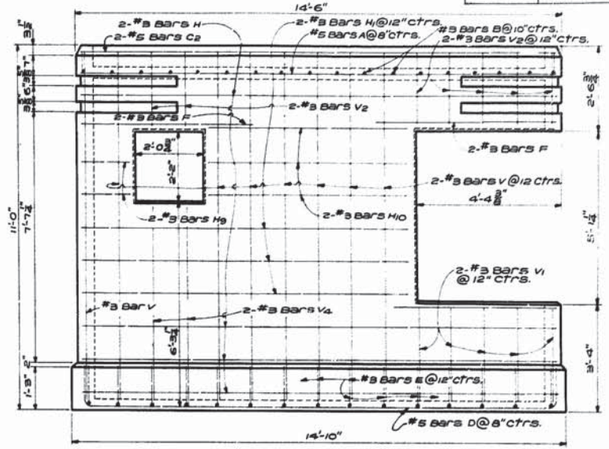

SIDE ELEVATION
SHOWING REINFORCING
SCALE: 1/4" = 1'-0"

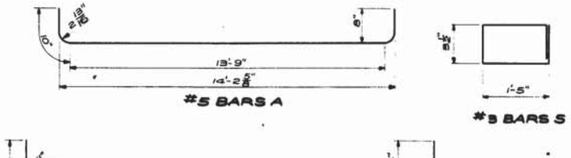

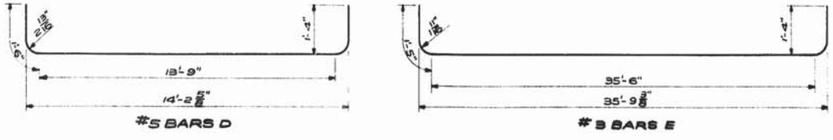

BILL OF REINFORCING STEEL

BAR	SIZE	Nº	UNIT LENGTH	TOTAL LENGTH	LOCATION
A	5	54	15'-6"	882'-6"	short Span in Roof Slab
C	5	4	35'-8"	142'-8"	Horiz. in Front and Rear Walls (TOP)
C1	5	4	35'-8"	142'-8"	Horiz. in Front & Rear Walls over Windows
C2	5	4	14'-2"	56'-8"	Horiz. in Side Walls (TOP)
D	5	54	16'-9"	904'-6"	short Span in Floor Slab (Bottom)
G	5	54	14'-6"	788'-0"	short Span in Floor Slab (TOP)
Total #5 bars = 2862'-0" = 2985 Lbs.					
B	8	18	35'-8"	642'-0"	Long Span in Roof Slab
E	8	15	36'-4"	545'-0"	Long Span in Floor Slab (Bottom)
F	8	2	5'-3"	10'-6"	Horiz. in Side Wall over Toilet Window
H	8	10	14'-2"	141'-8"	Horiz. in Side Walls
H1	8	6	9'-10"	59'-0"	Horiz. in Side Wall below Toilet Window
H2	8	20	35'-8"	713'-4"	Horiz. in Front and Rear Walls
H3	8	10	4'-8"	46'-8"	Horiz. in Front Wall between Windows
H4	8	10	8'-6"	85'-0"	Horiz. in Rear Wall between Windows
H5	8	20	5'-8"	113'-4"	Horiz. in Rear Wall at Ends
H6	8	14	4'-4"	60'-8"	Horiz. in Wall near door
H7	8	8	5'-9"	46'-0"	Horiz. in Wall near door
H8	8	2	9'-9"	19'-6"	Horiz. in Wall over door
H9	8	4	1'-6"	6'-0"	Horiz. in Side Wall near Toilet Window
H10	8	6	5'-9"	34'-6"	Horiz. in Side Wall near Toilet Window
J	8	15	36'-0"	468'-0"	Long Span in Floor Slab (TOP)
S	8	4	3'-8"	14'-8"	Hoops in Wall near door
V	8	84	10'-6"	882'-0"	vertical in Walls
V1	8	108	2'-10"	306'-0"	vertical in Walls below Windows
V2	8	112	2'-2"	242'-8"	vertical in Walls above Windows
V3	8	8	3'-0"	24'-0"	vertical in Walls above door
V4	8	4	5'-9"	23'-0"	vert in Side Wall below Toilet Window
Total #8 Bars = 4513'-6" = 1697 Lbs.					

OPERATING HOUSE

STANDARD PLAN
150' VERTICAL LIFT SPAN
LIVE LOAD H20-S16-44
28'-0" ROADWAY 5'-0" SIDEWALKS
45'-0" LIFT OPEN STEEL GRID FLOOR
DATED MAY 14 -87

STATE OF LOUISIANA
DEPARTMENT OF HIGHWAYS

DESIGNED	DETAILED	TRACED
CHECKED	CHECKED	CHECKED
ENGINEER	BRIDGE DESIGN SECTION	

DATE	DESCRIPTION REVISIONS

SHEET 4 OF 26

SL50-150-28

AS BUILT PLANS

HAER No. LA-32

129

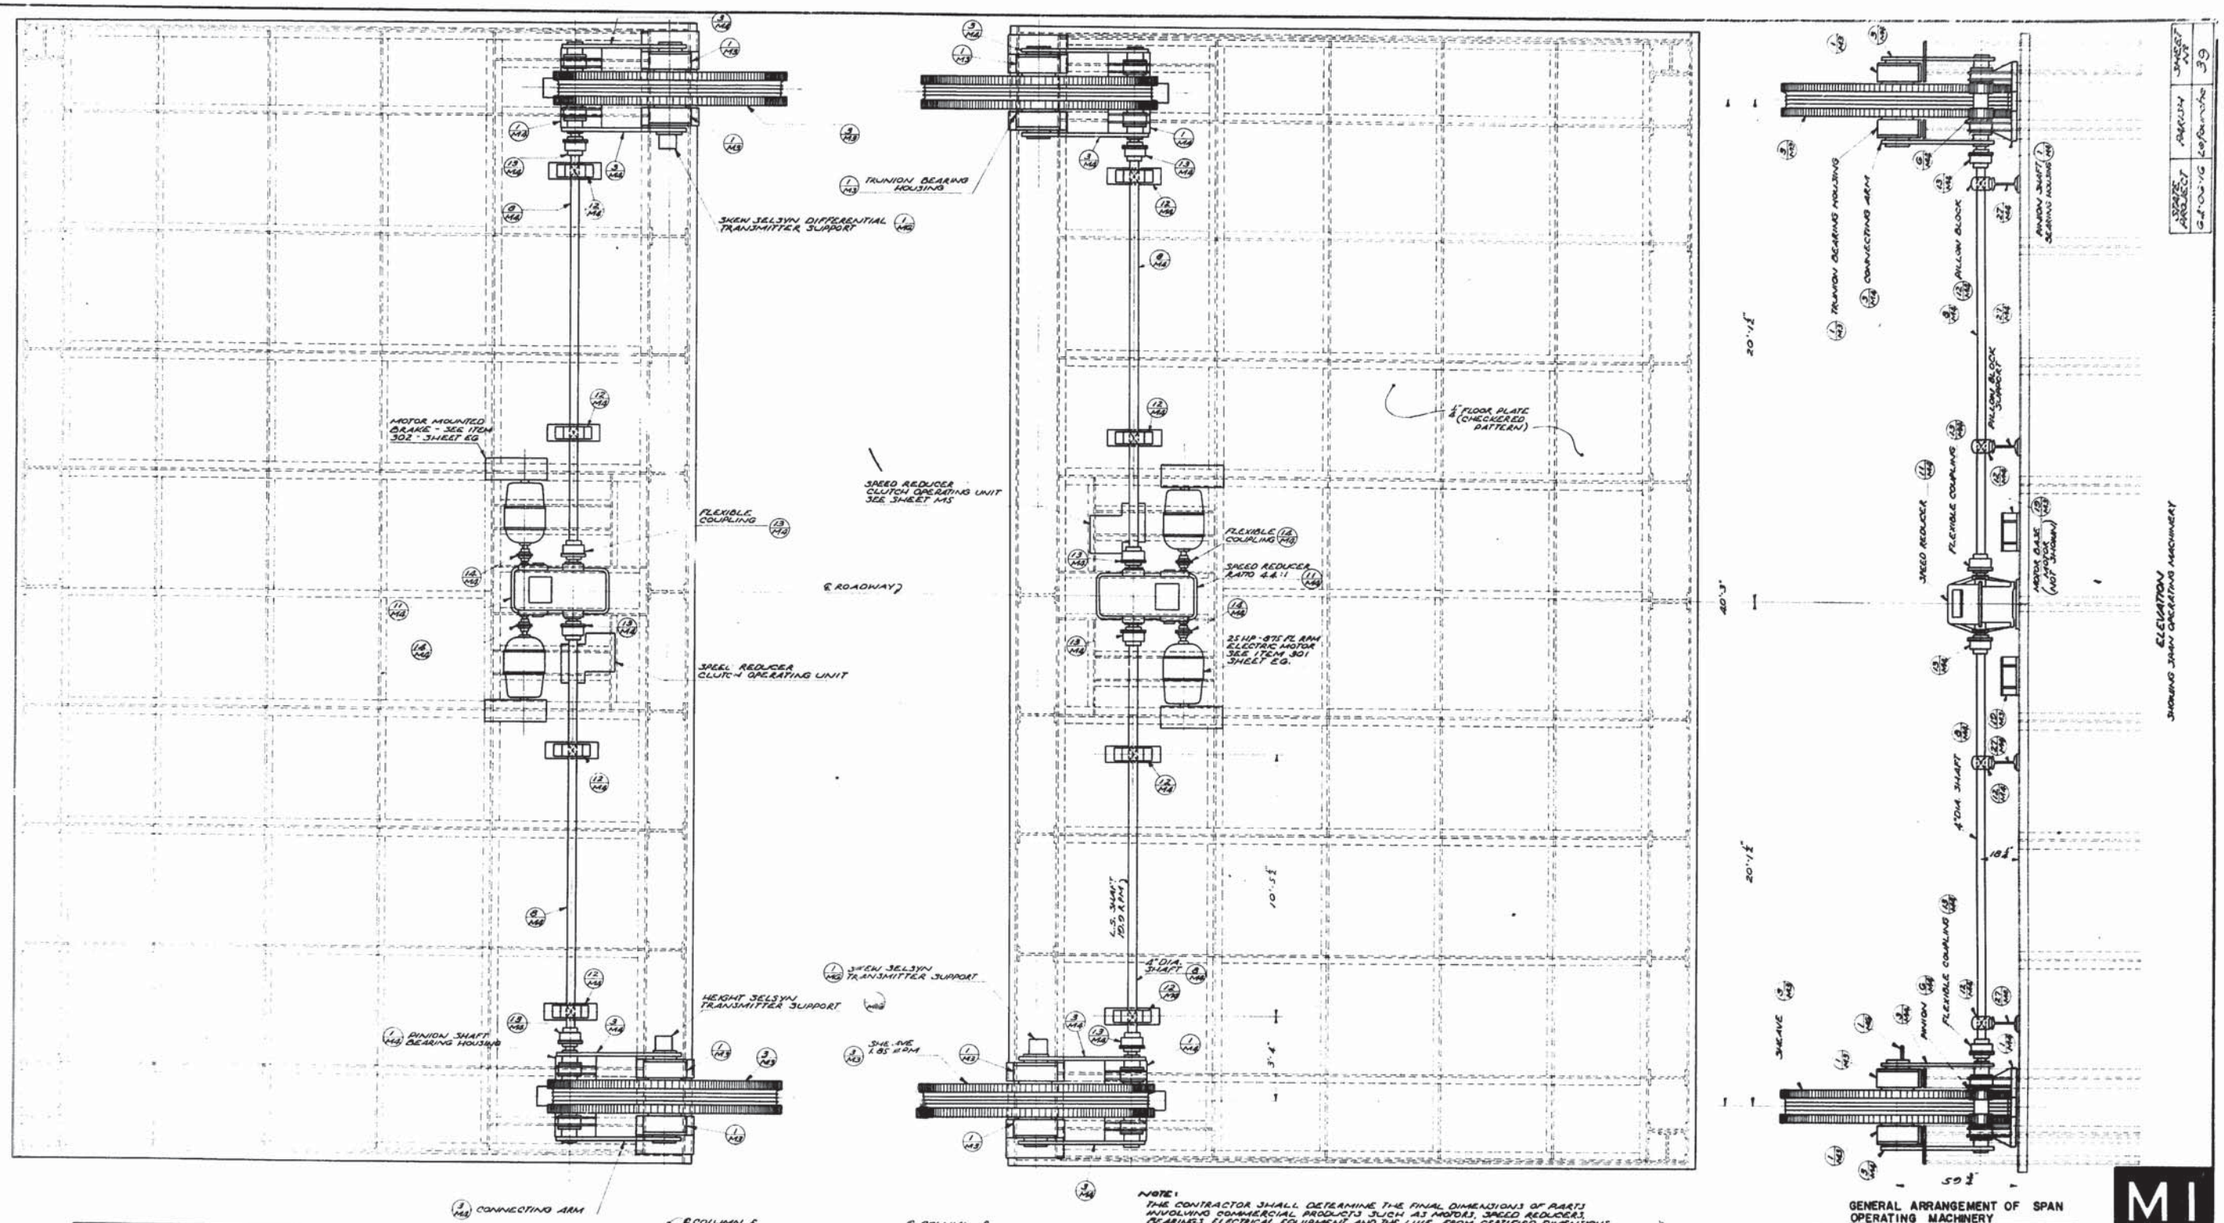


39

ELEVATION

THICKNESS OF SHIMS	1/32	1/16	1/8
1/8	2	2	3
1/4	4	2	4
3/8	6	5	5

THICKNESS AND No OF SHIMS TO BE FURNISHED

NOTE:
THE CONTRACTOR SHALL DETERMINE THE FINAL DIMENSIONS OF PARTS INVOLVING COMMERCIAL PRODUCTS SUCH AS MOTORS, SPEED REDUCERS, BEARINGS, ELECTRICAL EQUIPMENT AND THE LIKE, FROM CERTIFIED DIMENSIONS OUTLINES OF THE COMMERCIAL PRODUCTS BEFORE MAKING SHOP DRAWINGS OF THE PARTS INVOLVED.

PAINTING NOTE:
ALL UNFINISHED SURFACES OF MACHINERY SHALL BE PAINTED ONE SHOP COAT OF RED LEAD AND OIL. ALL FINISHED SURFACES SHALL BE COATED WITH WHITE LEAD AND TALLOW BEFORE SHIPMENT AND SHALL BE PROTECTED BY WOODEN LAGGING.

LUBRICATION NOTE:
UNLESS OTHERWISE SHOWN ON DETAIL DRAWINGS
LUBRICANT SHALL BE AS FOLLOWS OR APPROVED EQUAL:

GENERAL ARRANGEMENT OF SPAN OPERATING MACHINERY

M1

STANDARD PLAN
150' VERTICAL LIFT SPAN
LIVE LOAD H20-S16-44
28'-0" ROADWAY 5'-0" SIDEWALKS
45'-0" LIFT OPEN STEEL GRID FLOOR
DATE APRIL 25 1957

STATE OF LOUISIANA
DEPARTMENT OF HIGHWAYS
BRIDGE DESIGN SECTION

DESIGNED KUZEL	DETAILED Brewer	TRACED MANCRIEF
CHECKED Brewer	CHECKED KUZEL	APPROVED Brewer

NO.	DATE	DESCRIPTION
2457		Added 3 Shim Thickness to A.B.

REVISIONS

SHEET 15 OF 26

SL50-150-28

AS BUILT PLANS

HAER No. LA-32

130

STATE PROJECT	PARISH	SHEET NO.
58-02-15	Lafourche	45

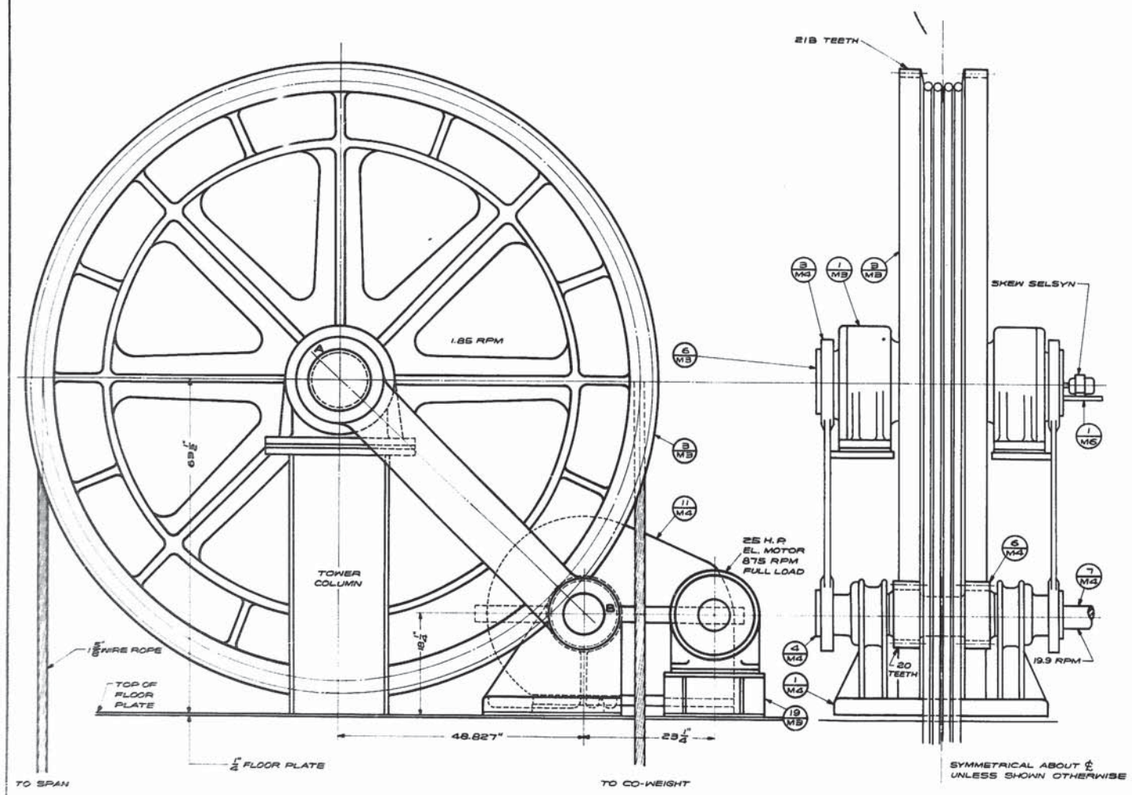

GENERAL ARRANGEMENT OF BRIDGE MACHINERY
ON DWG. # M1

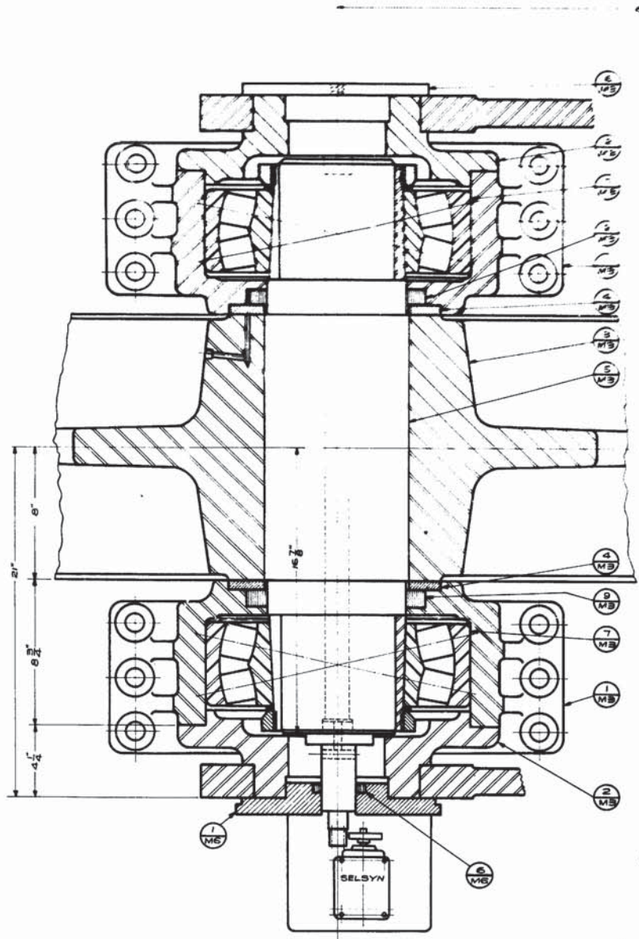

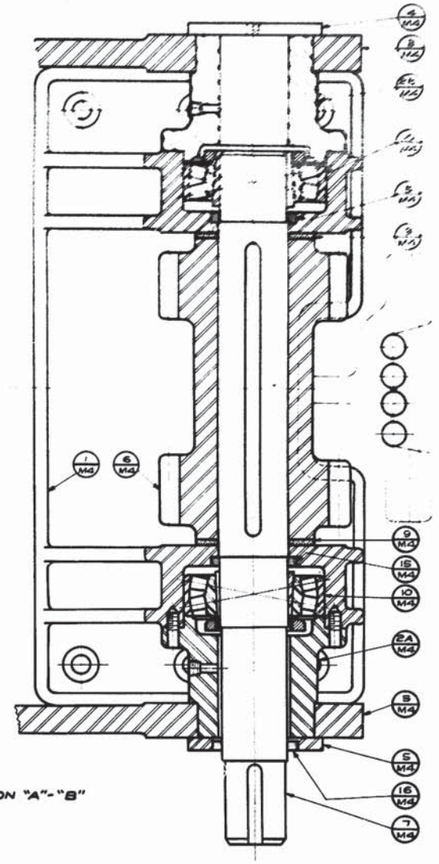

SECTION "A"-"B"

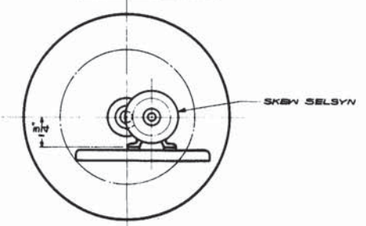

SELSYN MOUNTINGS AND GEARS ON DWG. M6

NOTE:
FOR REMOVING PINION SHAFT (7 M4) REMOVE CAPS, BEARINGS AND GREASE SEALS FROM BOTH ENDS OF THE ASSEMBLY. ROTATE THE PINION SPACER (9 M4) NEAREST THE COUPLING END OF THE SHAFT UNTIL ITS KEY SLOT IS IN LINE WITH THE KEY SLOT IN THE BORE OF THE HOUSING (1 M4) ROTATE THE SHAFT UNTIL THE KEYS ARE STRAIGHT DOWN. LIFT IT UPWARD AGAINST THE TOP OF THE BORE AND PRESS IT OUT IN THE DIRECTION OF THE COUPLING END.

NOTE:
THE CONTRACTOR SHALL DETERMINE THE FINAL DIMENSIONS OF PARTS INVOLVING COMMERCIAL PRODUCTS SUCH AS MOTORS, SPEED REDUCERS, BEARINGS, ELECTRICAL EQUIPMENT AND THE LIKE, FROM CERTIFIED DIMENSIONS OUTLINES OF THE COMMERCIAL PRODUCTS BEFORE MAKING SHOP DRAWINGS OF THE PARTS INVOLVED.
UNLESS OTHERWISE SHOWN ON DETAIL DRAWING LUBRICANT SHALL BE AS FOLLOWS OR APPROVED EQUAL:
PILLOW BLOCKS, COUPLINGS & TRUNION BEARINGS - ESSO FIBRE GREASE "C"
EXPOSED TEETH - MEDIUM HARD GREASE.
ENCLOSED SPEED REDUCERS - STD. OIL "TERESSO 95" VISC SAE 90.
WIRE ROPE - STD. OIL CO. SURRETTE COMPOUND Nº 1600.
ALL UNFINISHED SURFACES OF MACHINERY SHALL BE PAINTED ONE SHOP COAT OF RED LEAD AND OIL.
ALL FINISHED SURFACES SHALL BE COATED WITH WHITE LEAD AND TALLOW BEFORE SHIPMENT AND SHALL BE PROTECTED BY WOODEN LAGGING.

ASSEMBLY OF GEAR TRAIN FOR SHEAVE DRIVE

M2

STANDARD PLAN
150' VERTICAL LIFT SPAN
LIVE LOAD H20-S16-44
28'-0" ROADWAY 5'-0" SIDEWALKS
45'-0" LIFT OPEN STEEL GRID FLOOR
DATED FEB. 22 1957

STATE OF LOUISIANA
DEPARTMENT OF HIGHWAYS

DESIGNED Kuzel	DETAILED Kuzel	TRACED Q. Carlson
CHECKED Brewer	CHECKED Brewer	CHECKED Brewer

BRIDGE DESIGN SECTION

DATE	REVISIONS	BY
4-9-58	REV. PART Nº [illegible]	A.R.K.

SHEET 16 OF 26

SL50-150-28

AS BUILT PLANS

131

STATE PROJECT	PARISH	SHEET NO.
G.A. 06-16	Lafourche	41

BILL OF MATERIAL FOR ONE SPAN

PART NO.	QUAN.	DESCRIPTION		
1	8	TRUNION BEARING HOUSING	ST. CAST ASTM-A27-GR 65-35	
2	8	HOUSING COVER	ST. CAST ASTM-A27-GR 65-35	
3	4	SHEAVE	ST. CAST ASTM-A27-GR 65-115	
4	8	SHEAVE THRUSTWASHER	BRONZE	
5	4	TRUNION	ST. FORG'G. ASTM-A235-CL. G	
6	5	CONN. ARM RETAINER	STEEL	
7	8	TRUNION BEARING SKF #22338 CK+SNH/I OR TORR #190SD23A		COMM.
8	16	1" DIA. PIN - 4" LONG	STEEL	
9	8	GARLOCK SEAL #51-3510		COMM.
10	64	1-10 NC. CAPSCREW - 2¼" LG.	STEEL	
11	64	1" SHAKEPROOF LOCKWASHER		COMM.
12	32	1-11 NC. CAPSCREW - 1½" LG.	STEEL	
13	32	1" SHAKEPROOF LOCKWASHER		COMM.
14	12	⅝-16 NC. CAPSCREW - 1" LONG	STEEL	
15	12	⅝" SHAKEPROOF LOCKWASHER		COMM.
16	21	ALEMITE HYDRAULIC FITTING		COMM.
17	16	¼" COUNTERSUNK PLUG	BRASS	COMM.
18	48	TURNED BOLT COMPL.	STEEL	
19	4	MOTOR BASE	STEEL WELDM.	
20	16	MOTOR BOLT COMPL.	STEEL	
21	6	BASE FOR REDUCER	STEEL C.P. 1½" x 3"	
22	12	BOLT FOR REDUCER - COMPL.	STEEL	

GENERAL NOTES:

ALL PARTS FURNISHED BY THE CONTRACTOR SHALL BE AS SHOWN OR APPROVED EQUAL. ALL PARTS LISTED ON THIS SHEET TO BE INCLUDED IN ITEM 5:8:1 MOVABLE BRIDGE MACHINERY, INCLUDING ALL NECESSARY SHIMS. ALL BOLTS TO HAVE ONE NUT AND ONE HEAVY SAE LOCKWASHER, UNLESS NOTED, OR OTHER MEANS OF LOCKING NUT ARE SHOWN ON DETAILS. THE CONTRACTOR SHALL DETERMINE THE FINAL DIMENSIONS OF PARTS INVOLVING COMMERCIAL PRODUCTS SUCH AS MOTORS, SPEED REDUCERS, BEARINGS, ELECTRICAL EQUIPMENT AND THE LIKE, FROM CERTIFIED DIMENSIONS OUTLINES OF THE COMMERCIAL PRODUCTS BEFORE MAKING SHOP DRAWINGS OF THE PARTS INVOLVED.

DETAILS OF SHEAVE & SHEAVE DRIVE

M3

STANDARD PLAN
150' VERTICAL LIFT SPAN
LIVE LOAD H20-S16-44
28'-0" ROADWAY — 5'-0" SIDEWALKS
45'-0" LIFT — OPEN STEEL GRID FLOOR
FEB. 16 56

STATE OF LOUISIANA
DEPARTMENT OF HIGHWAYS
Kuzel — Kuzel — A. Chatman
Brewer — Brewer — Kuzel
BRIDGE DESIGN SECTION

9-24-57 TRUNION BEARING HOUSING — REVISIONS

SHEET 17 OF 26

SL50-150-28

AS BUILT PLANS

HAER No. LA-32

132

STATE PROJECT	PARISH	SHEET NO
64-06-16	Lafourche	42

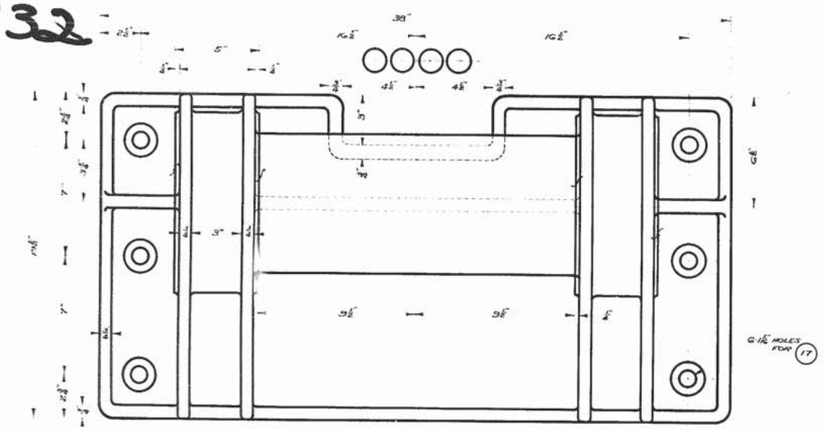

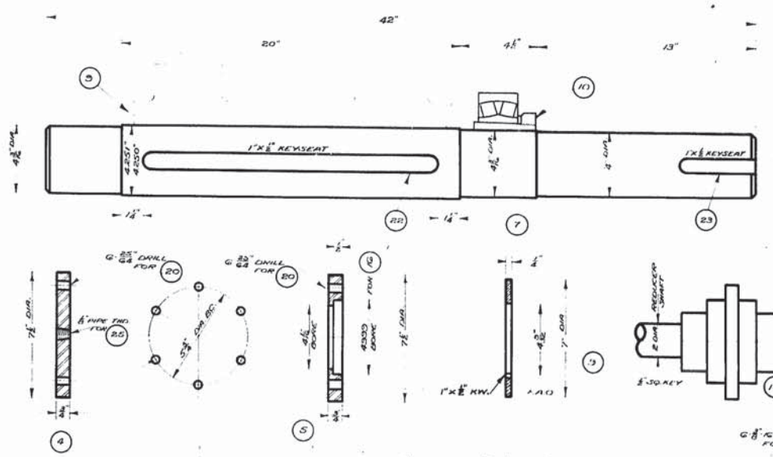

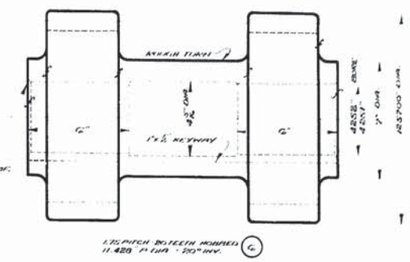

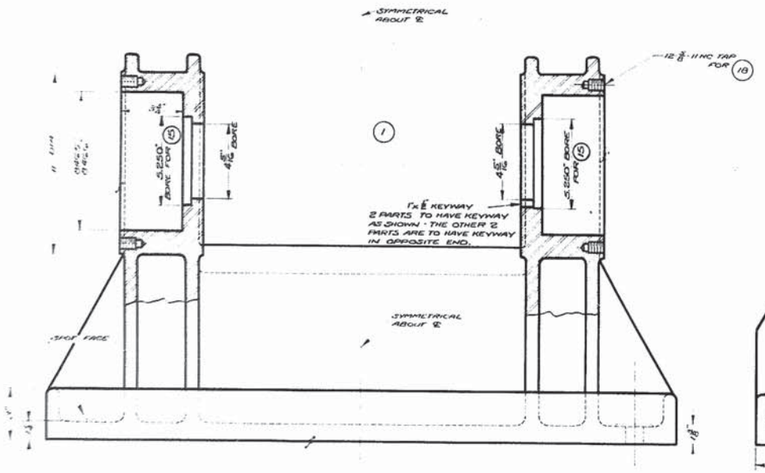

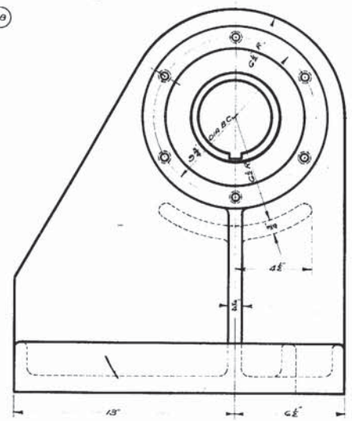

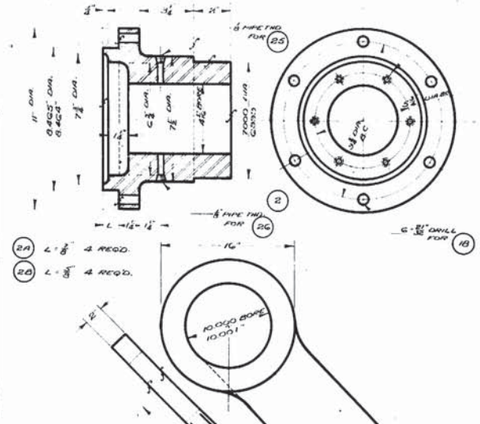

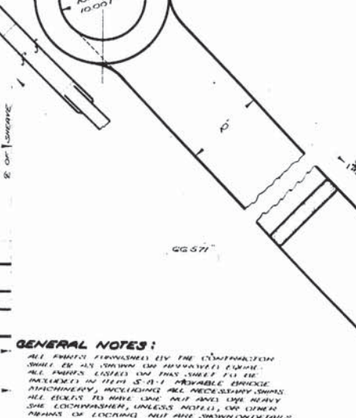

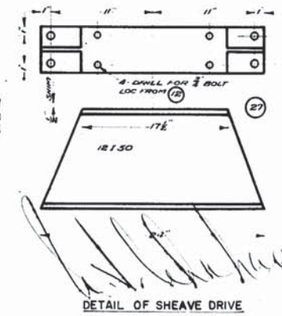

DETAIL OF SHEAVE DRIVE

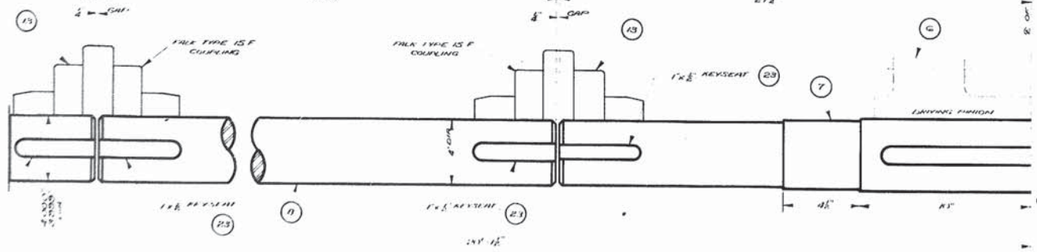

BILL OF MATERIAL FOR ONE SPAN

PART	QUAN.	DESCRIPTION	MATERIAL
1	4	PINION SHAFT BEARG. HOUSING	ST. CAST'G. ASTM A27 GR G.S.-35
2	8	HOUSING COVER	ST. CAST'G. ASTM A27 GR G.S.-35
3	8	CONNECTING ARM	ST. CAST'G. ASTM A27 GR G.S.-35
4	4	CONN. ARM RETAINER	STEEL
5	4	CONN. ARM RETAINER	STEEL
6	4	PINION	ST. FORG'G. ASTM-A235-CL.G
7	4	PINION SHAFT	STEEL ASTM-A107-GR 1045
8	4	INTERMEDIATE SHAFT	STEEL ASTM-A108
9	8	PINION SHAFT SPACER	BRASS
10	8	PINION SHAFT BEARG. SKF #22224 CK (SPHR GR ROLLR #30311.22 A COMM	
11	2	SPEED REDUCER SNGL. GEAR CO® G.E. O.D. SPECIAL LG® GMSE E24 COMM	
12	8	PILLOW BLOCK SKF - SAF 22522 A FOR 4" SHAFT	COMM.
13	8	COUPLING TALK # 15 F	COMM.
14	4	COUPLING TALK # 8 F	COMM.
15	8	GARLOCK SEAL # 53-2G30	COMM.
16	4	GARLOCK SEAL # 53-2537	COMM.
17	24	TURNED BOLT COMPL.	STEEL
18	48	⅞"-11 NC C SCREW - 2½ LONG	STEEL
19	48	⅞" SHAKEPROOF LOCKWASHER	COMM.
20	48	⅞"-9 NC C SCREW - 2½ LONG	STEEL
21	48	⅝" SHAKEPROOF LOCKWASHER	COMM.
22	4	1"-39 KEY - 17½ LONG	STEEL - KEYSTOCK
23	12	1"-39 KEY - 5" LONG	STEEL - KEYSTOCK
24	32	⅝"-10 NC MACH BOLT COMPL. 3½ LG.	STEEL
25	12	⅛" ALEMITE HYDRAULIC FITTING	COMM.
26	8	⅛" PIPE PLUG	BRASS COMM.
27	8	SUPPORT FOR PILLOW BLOCK	STEEL

GENERAL NOTES:

ALL PARTS FURNISHED BY THE CONTRACTOR SHALL BE AS SHOWN OR REVISED HEREIN. ALL PARTS LISTED ON THIS SHEET TO BE INCLUDED IN ITEM S.A.-1 MOVABLE BRIDGE MACHINERY, INCLUDING ALL NECESSARY SPANS ALL BOLTS TO HAVE ONE NUT AND ONE HEAVY SHE LOCKWASHER, UNLESS NOTED, OR OTHER MEANS OF LOCKING NUT ARE SHOWN OTHERWISE. THE CONTRACTOR SHALL DETERMINE THE FINAL DIMENSIONS OF PARTS INVOLVING COMMERCIAL PRODUCTS SUCH AS MOTORS, SPEED REDUCERS, BEARINGS, ELECTRICAL EQUIPMENT AND THE LIKE, FROM CERTIFIED DIMENSIONS OUTLINES OF THE COMMERCIAL PRODUCTS BEFORE MAKING SHOP DRAWINGS OF THE PARTS INVOLVED.

M4

STANDARD PLAN
150' VERTICAL LIFT SPAN
LIVE LOAD H20-S16-44
28'-0" ROADWAY — 5'-0" SIDEWALKS
45'-0" LIFT — OPEN STEEL GRID FLOOR
1 May 1957

STATE OF LOUISIANA
DEPARTMENT OF HIGHWAYS

DESIGNED	DETAILED	TRACED
Kuzel	Kuzel	J.D. Hanks
CHECKED	CHECKED	
Brewer	Brewer	Kuzel

BRIDGE DESIGN SECTION

4-3-58 REV. MAST NOS. 15 16 17 A.R.K.
DATE — REVISIONS

SHEET 18 OF 26

SL50-150-28

AS BUILT PLANS

HAER No. LA-32

136

STATE PROJECT	PARISH	SHEET NO.
C.A.-206-6	Lafourche	46

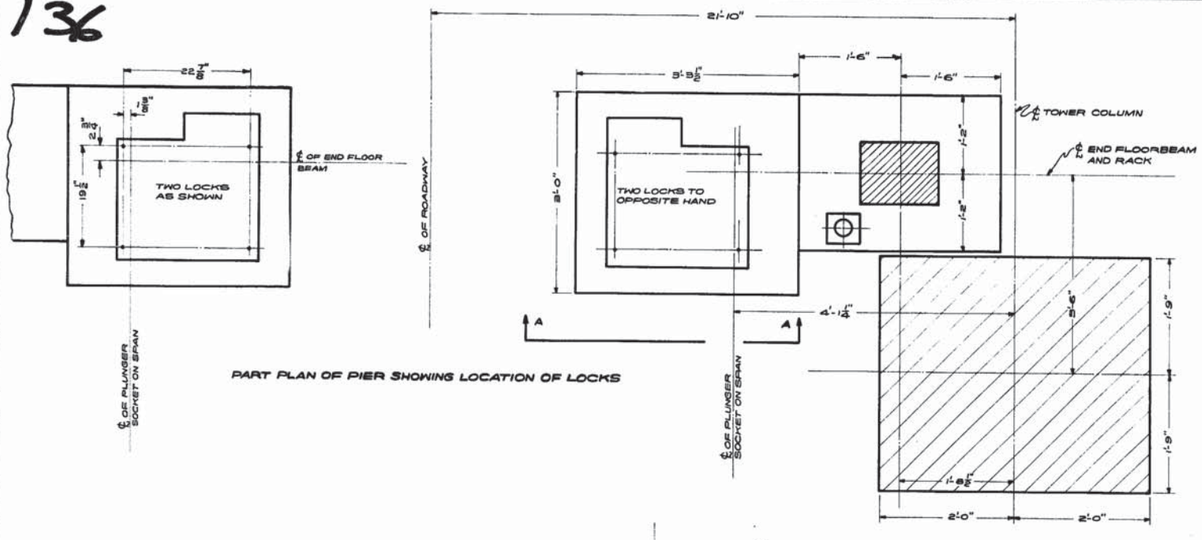

PART PLAN OF PIER SHOWING LOCATION OF LOCKS

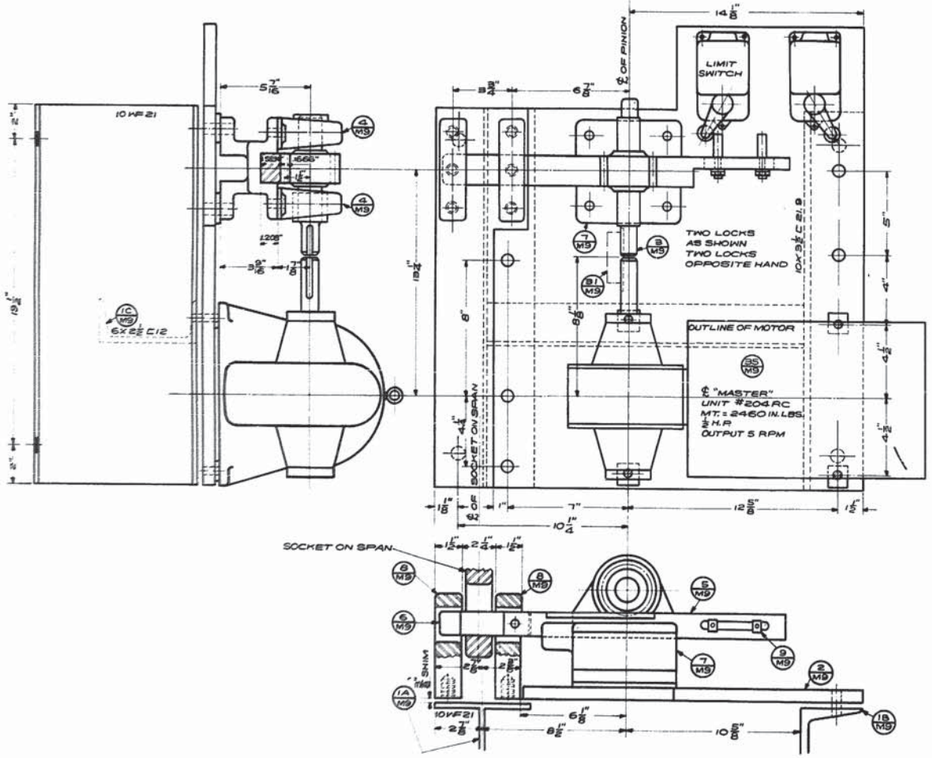

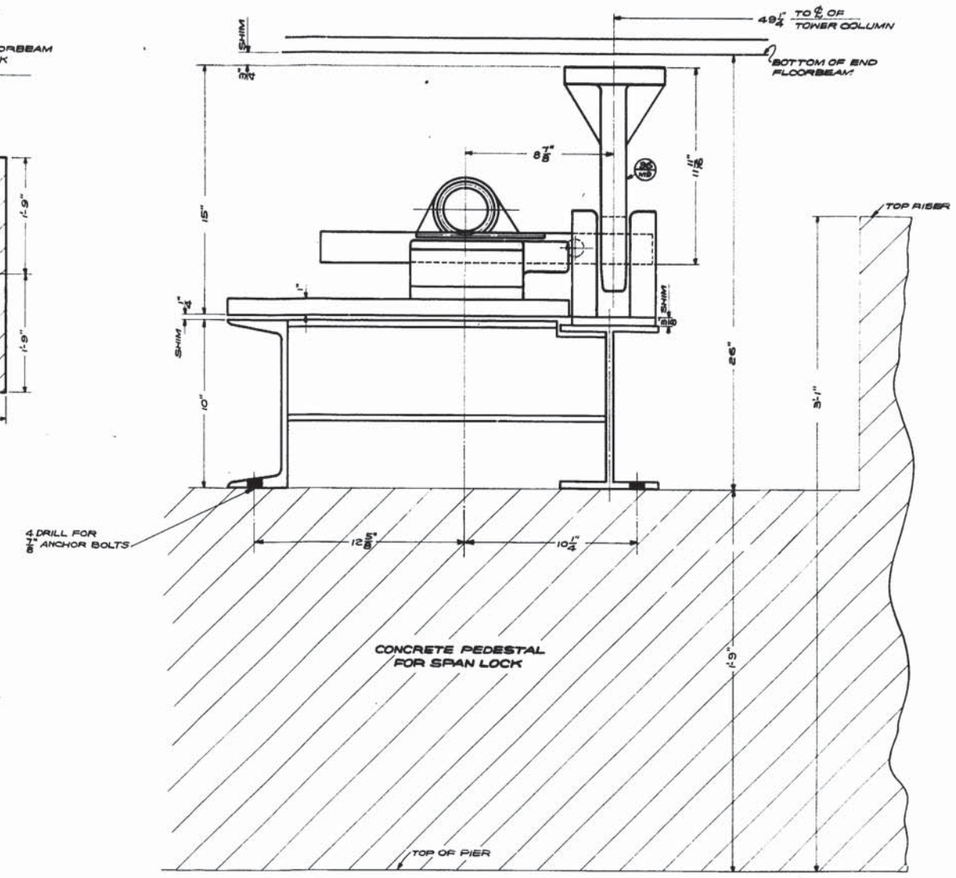

VIEW A-A

NOTE:
THE CONTRACTOR SHALL DETERMINE THE FINAL DIMENSIONS OF PARTS INVOLVING COMMERCIAL PRODUCTS SUCH AS MOTORS, SPEED REDUCERS, BEARINGS, ELECTRICAL EQUIPMENT AND THE LIKE, FROM CERTIFIED DIMENSIONS, OUTLINES OF THE COMMERCIAL PRODUCTS BEFORE MAKING SHOP DRAWINGS OF THE PARTS INVOLVED.
ALL UNFINISHED SURFACES OF MACHINERY SHALL BE PAINTED ONE SHOP COAT OF RED LEAD AND OIL.
ALL FINISHED SURFACES SHALL BE COATED WITH WHITE LEAD AND TALLOW BEFORE SHIPMENT AND SHALL BE PROTECTED BY WOODEN LAGGING.
UNLESS OTHERWISE SHOWN ON DETAIL DRAWING LUBRICANT SHALL BE AS FOLLOWS OR APPROVED EQUAL:
PILLOW BLOCKS, COUPLINGS & TRUNION BEARINGS- ESSO FIBRE GREASE "C."
EXPOSED TEETH- MEDIUM HARD GREASE.
ENCLOSED SPEED REDUCERS- STD. OIL "TERESSO 65" VISC SAE 30.
WIRE ROPE- STD. OIL CO. SURRETTE COMPOUND Nº 1500.

ASSEMBLY OF SPAN LOCK

M8

STANDARD PLAN
150' VERTICAL LIFT SPAN
LIVE LOAD H20-S16-44
28'-0" ROADWAY 5'-0" SIDEWALKS
45'-0" LIFT OPEN STEEL GRID FLOOR
DATED MAY 1 1957

STATE OF LOUISIANA
DEPARTMENT OF HIGHWAYS

DESIGNED Kuzel	DETAILED Kuzel	TRACED A. Chapman
CHECKED Brewer	CHECKED Brewer	PITCHED Brewer

BRIDGE DESIGN SECTION

DATE	DESCRIPTION	BY
	REVISIONS	

SHEET 22 OF 26

SL50-150-28

AS BUILT PLANS

HAER No. LA-32

137

STATE PROJECT	PARISH	SHEET NO.
G.4.00.16	Lafourche	47

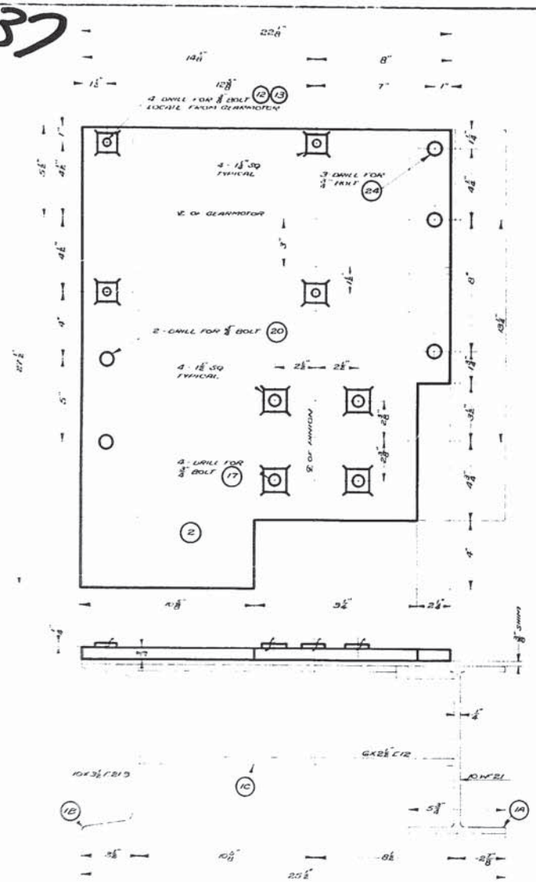

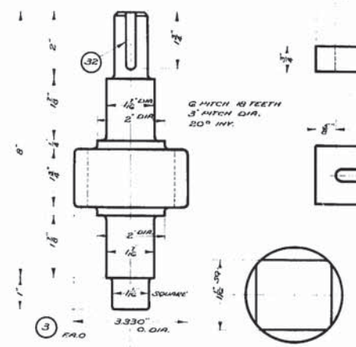

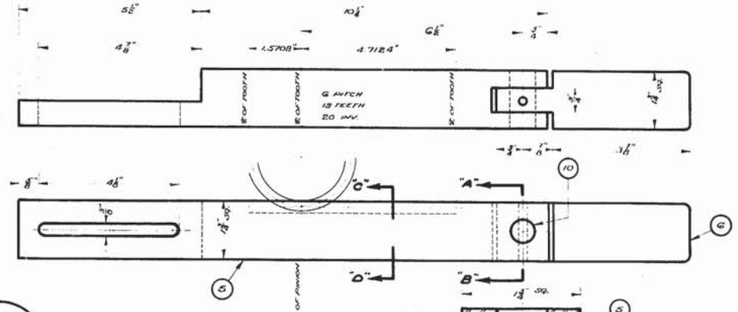

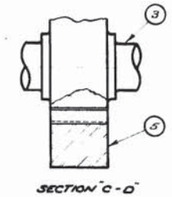

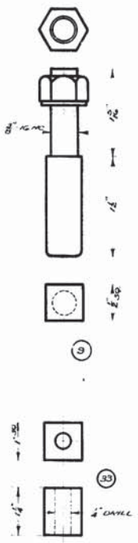

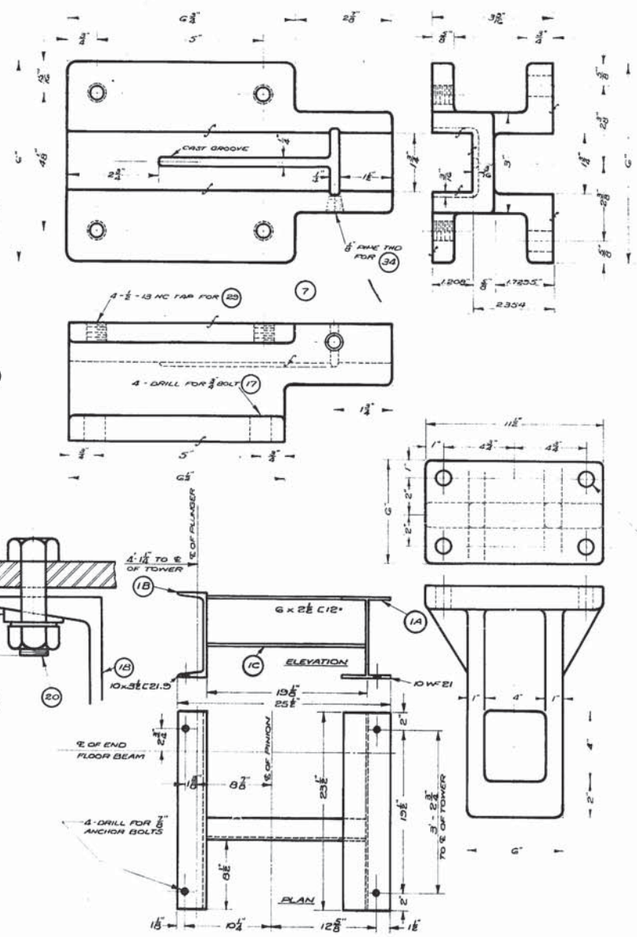

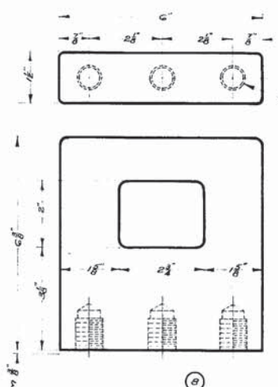

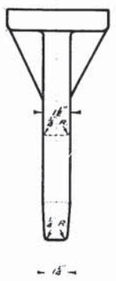

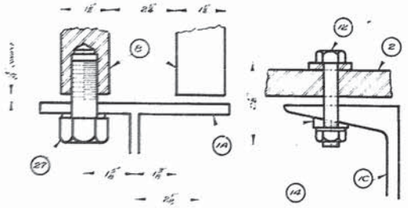

BILL OF MATERIAL FOR ONE SPAN LOCK

PART #	QUAN	DESCRIPTION	MATERIAL	
1	1	SUPPORT FOR LOCK ASS'Y	STEEL WELDM.	
1A	1	10 WF 21 - 23½" LONG	STEEL	
1B	1	10 X 4⅛" I. 21½" W.M.	STEEL	
1C	1	6 X 2½" L. 13" LONG	STEEL	
2	1	BASE PLATE	STEEL	
3	1	PINION	STEEL	
4	2	PINION BEARING	SKF SY 107	COMM.
5	1	RACK	STEEL C.I.	
6	1	RACK EXTENSION	STEEL	
7	1	RACK HOUSING	C.I.	
8	2	SOCKET ON LOCK	STEEL	
9	2	LIMIT SWITCH ACTUATOR COMM.	BRASS	
10	1	⅝" PIN - 13⅜" LONG	STEEL	
11	1	⅝" PIN - 1¾" LONG	STEEL	
12	3	⅞" - 16 NC MACH BOLT 2½" LONG	STEEL	
13	1	⅞" - 16 NC MACH BOLT - 1¾" LONG	STEEL	
14	3	⅞" BEVEL WASHER		COMM.
15	4	⅞" - 16 NC STD. NUT	STEEL	
16	4	⅞" SHAKEPROOF LOCKWASHER		COMM.
17	4	¾" - 10 NC MACH BOLT - 2¾ LONG	STEEL	
18	4	¾" - 10 NC STD. NUT	STEEL	
19	4	¾" SHAKEPROOF LOCKWASHER		COMM.
20	2	¾" - 10 NC MACH BOLT - 2½" LONG	STEEL	
21	2	¾" -10 NC STD. NUT	STEEL	
22	2	¾" BEVEL WASHER		COMM.
23	2	¾" SHAKEPROOF LOCKWASHER		COMM.
24	3	¾" - 10 NC MACH. BOLT - 2¾" LONG	STEEL	
25	3	¾" - 10 NC STD. NUT	STEEL	
26	3	¾" SHAKEPROOF LOCKWASHER		COMM.
27	6	¾" - 10 NC MACH BOLT - 1¾" LONG	STEEL	
28	6	¾" SHAKEPROOF LOCKWASHER		COMM.
29	4	⅝" 13 NC MACH BOLT - 1¼" LONG	STEEL	
30	4	⅝" SHAKEPROOF LOCKWASHER		COMM.
31	1	COUPLING - MORSE DSC #4 - 1G		COMM.
32	1	⅜" SQ KEY - 1¾" LONG	STEEL - KEYSTOCK	
33	6	SPACER	BRASS	
34	1	⅝ ALEMITE HYDR. FITTING		COMM.
35	1	MASTER ELECTRIC UNIT FR 7204 RC 2460 IN LBS TORQUE ⅝ HP - OUTPUT SHAFT 3 RPM		
36	1	SOCKET ON SPAN	STD STEEL ASTM A27 GRADE 35	
37	4	TURNED BOLT COMPL	STEEL	

FOUR LOCKS REQUIRED FOR ONE SPAN
TWO LOCKS AS SHOWN
TWO LOCKS TO OPPOSITE HAND

GENERAL NOTES:

- ALL PARTS FURNISHED BY THE CONTRACTOR SHALL BE AS SHOWN OR APPROVED EQUAL.
- ALL PARTS LISTED ON THIS SHEET TO BE INCLUDED IN ITEM 5.18.1 MOVABLE BRIDGE MACHINERY, INCLUDING ALL NECESSARY SHIMS.
- ALL BOLTS TO HAVE ONE NUT AND ONE HEAVY SAE LOCKWASHER, UNLESS NOTED, OR OTHER MEANS OF LOCKING NUT ARE SHOWN ON DETAILS.
- THE CONTRACTOR SHALL DETERMINE THE FINAL DIMENSIONS OF PARTS INVOLVING COMMERCIAL PRODUCTS SUCH AS MOTORS, SPEED REDUCERS, BEARINGS, ELECTRICAL EQUIPMENT AND THE LIKE, FROM CERTIFIED DIMENSIONS OUTLINES OF THE COMMERCIAL PRODUCTS BEFORE MAKING SHOP DRAWING OF THE PARTS INVOLVED.

DETAIL OF SPAN LOCK

M9

STANDARD PLAN
150' VERTICAL LIFT SPAN
LIVE LOAD H20-S16-44
28'-0" ROADWAY — 5'-0" SIDEWALKS
45'-0" LIFT — OPEN STEEL GRID FLOOR
DATE May 1 -57

STATE OF LOUISIANA
DEPARTMENT OF HIGHWAYS

DESIGNED	DETAILED	CHECKED	APPROVED
Ruzzell	Ruzzell	D Hinderis	
Brewer	Brewer	Brewer	

BRIDGE DESIGN SECTION

DATE | DESCRIPTION | REVISIONS

SHEET 23 OF 26

SL50-150-28

FOUNDATION PLAN FOR SPAN LOCK

AS BUILT PLANS

138

STATE PROJECT	PARISH	SHEET NO.
64-06-16	Lafourche	48

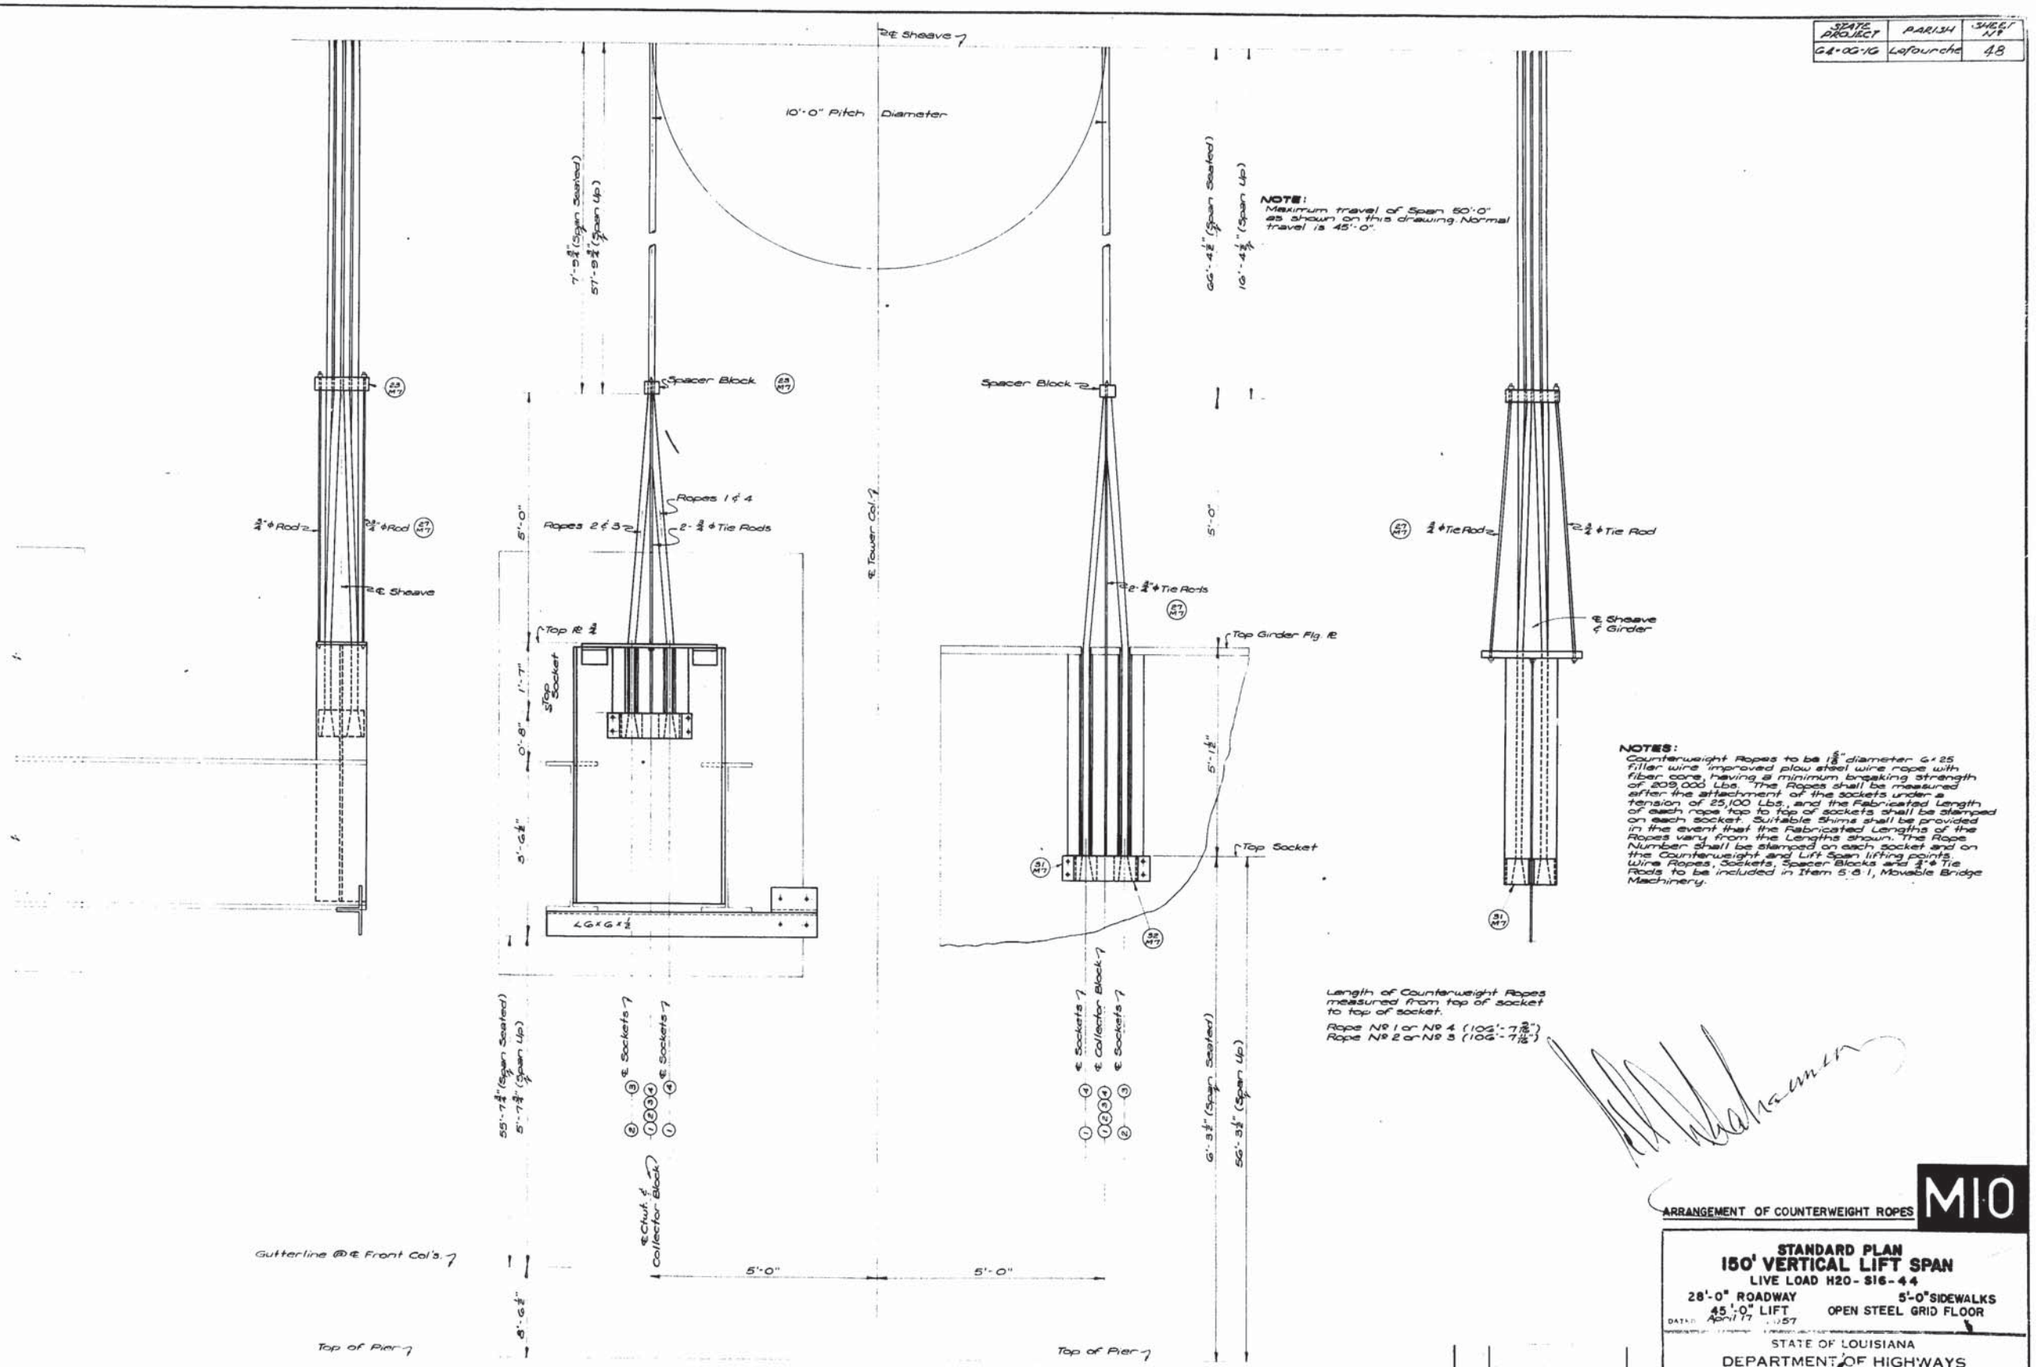

NOTE:
Maximum travel of Span 50'-0" as shown on this drawing. Normal travel is 45'-0".

NOTES:
Counterweight Ropes to be 1⅛" diameter 6 x 25 Filler wire improved plow steel wire rope with fiber core, having a minimum breaking strength of 209,000 Lbs. The Ropes shall be measured after the attachment of the sockets under a tension of 25,100 Lbs, and the Fabricated Length of each rope top to top of sockets shall be stamped on each socket. Suitable Shims shall be provided in the event that the Fabricated Lengths of the Ropes vary from the Lengths shown. The Rope Number shall be stamped on each socket and on the Counterweight and Lift Span lifting points. Wire Ropes, Sockets, Spacer Blocks and ¾" ℄ Tie Rods to be included in Item 5.8.1, Movable Bridge Machinery.

Length of Counterweight Ropes measured from top of socket to top of socket.

Rope № 1 or № 4 (104'-7[illegible]")
Rope № 2 or № 3 (104'-7[illegible]")

ARRANGEMENT OF COUNTERWEIGHT ROPES **M10**

STANDARD PLAN
150' VERTICAL LIFT SPAN
LIVE LOAD H20-S16-44
28'-0" ROADWAY 5'-0" SIDEWALKS
45'-0" LIFT OPEN STEEL GRID FLOOR
DATE: April 77 1957

STATE OF LOUISIANA
DEPARTMENT OF HIGHWAYS

DESIGNED	DETAILED	TRACED
CHECKED S.L.P.	CHECKED S.L.P.	CHECKED S.L.P.

BRIDGE DESIGN SECTION

DATE	DESCRIPTION	BY
	REVISIONS	

SHEET 24 OF 26

SL50-150-28

AS BUILT PLANS

HAER No. LA-32

139

STATE PROJECT	PARISH	SHEET NO.
66-00-16	Lafourche	48

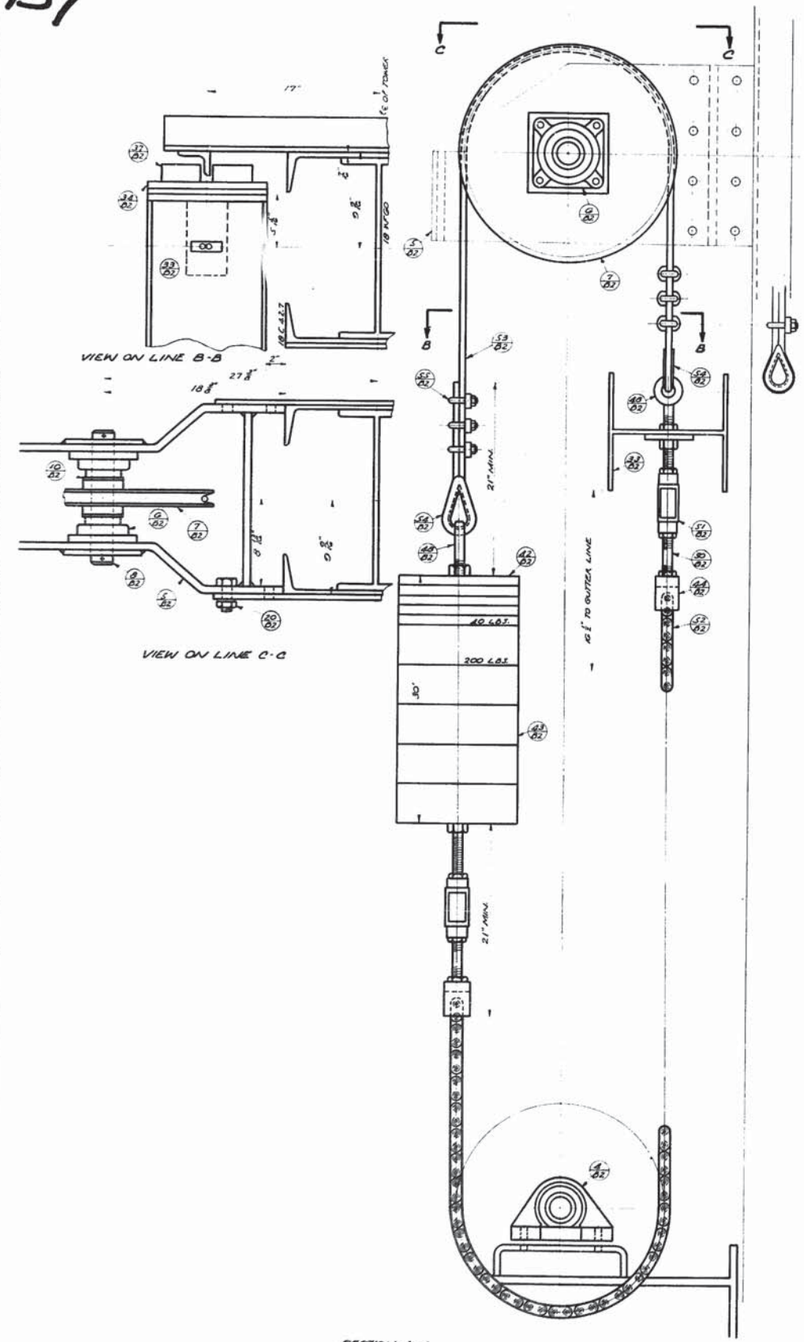

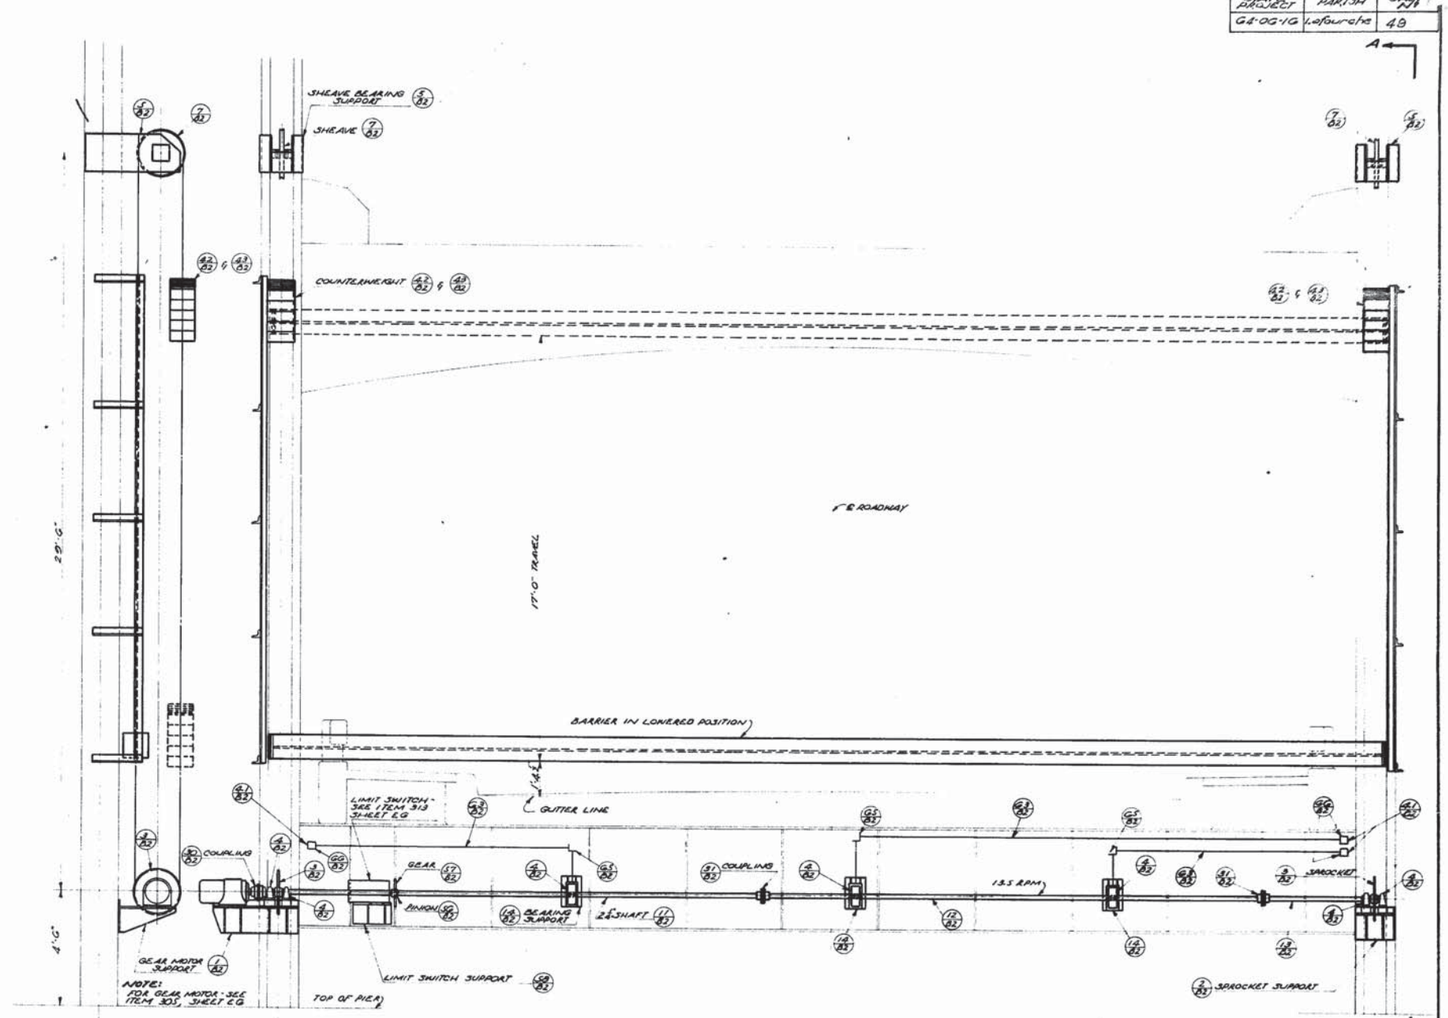

PART SIDE ELEVATION OF TOWER SHOWING BARRIER

PART REAR ELEVATION OF TOWER SHOWING BARRIER OPERATING MACHINERY

THICKNESS / SIZE NORMAL SHIM	½"	¼"	⅛"
½	1	2	4

NOTE:
THE CONTRACTOR SHALL DETERMINE THE FINAL DIMENSIONS OF PARTS INVOLVING COMMERCIAL PRODUCTS SUCH AS MOTORS, SPEED REDUCERS, BEARINGS, ELECTRICAL EQUIPMENT AND THE LIKE, FROM CERTIFIED DIMENSIONS OUTLINES OF THE COMMERCIAL PRODUCTS BEFORE MAKING SHOP DRAWINGS OF THE PARTS INVOLVED.

PAINTING NOTE:
ALL UNFINISHED SURFACES OF MACHINERY SHALL BE PAINTED ONE SHOP COAT OF RED LEAD AND OIL. ALL FINISHED SURFACES SHALL BE COATED WITH WHITE LEAD AND TALLOW BEFORE SHIPMENT AND SHALL BE PROTECTED BY WOODEN LAGGING.

LUBRICATION NOTE:
UNLESS OTHERWISE SHOWN ON DETAIL DRAWING, LUBRICANT SHALL BE AS FOLLOWS OR APPROVED EQUAL:
PILLOW BLOCKS, COUPLINGS, & TRUNION BEARINGS - E330 FIBRE GREASE "O".
EXPOSED TEETH - MEDIUM HARD GREASE.
ENCLOSED SPEED REDUCERS - STD. OIL "TERES 330 95° VI.3C SAE 30.
WIRE ROPE - STD. OIL CO. "JUARETTE COMPOUND N° 1500.

DATE	DESCRIPTION	BY
	REVISIONS	

GENERAL ARRANGEMENT OF TRAFFIC BARRIER

BI

STANDARD PLAN
150' VERTICAL LIFT SPAN
LIVE LOAD H20-S16-44
28'-0" ROADWAY 5'-0" SIDEWALKS
45'-0" LIFT OPEN STEEL GRID FLOOR
DATED MAY 1 1957

STATE OF LOUISIANA
DEPARTMENT OF HIGHWAYS

DESIGNED Kuzel	DETAILED Brewer	TRACED A.J. Mouchet
CHECKED Brewer	CHECKED Kuzel	CHECKED Brewer

BRIDGE DESIGN SECTION

SHEET 25 OF 26

SL50-150-28

AS BUILT PLANS

Mead & Hunt, Inc.

Job No. _____ Sheet _____ of _____
Job Name 000930
Task Rail Details
Calculated by _____ Date _____
Checked by _____ Date _____

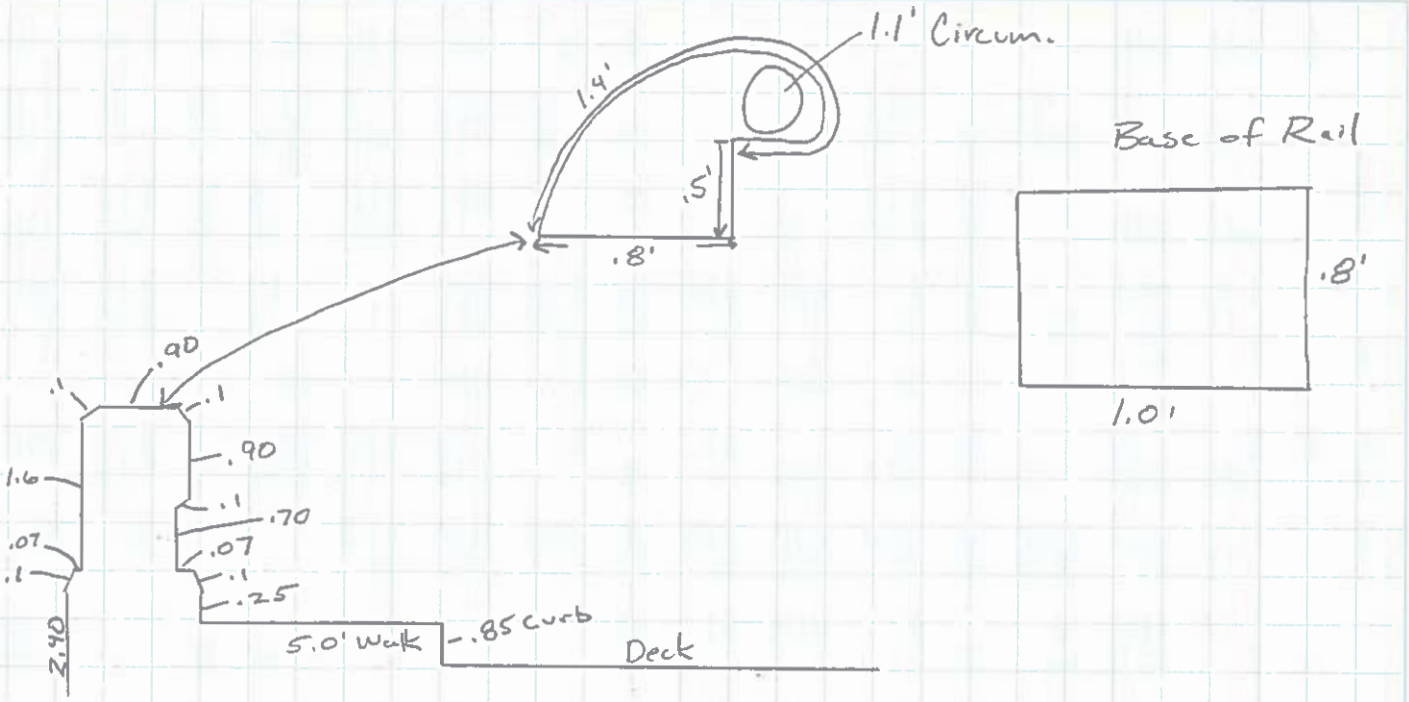

Mead & Hunt, Inc.

Job No. _____ Sheet _____ of _____
Job Name 000930
Task Rail Details
Calculated by _____ Date _____
Checked by _____ Date _____

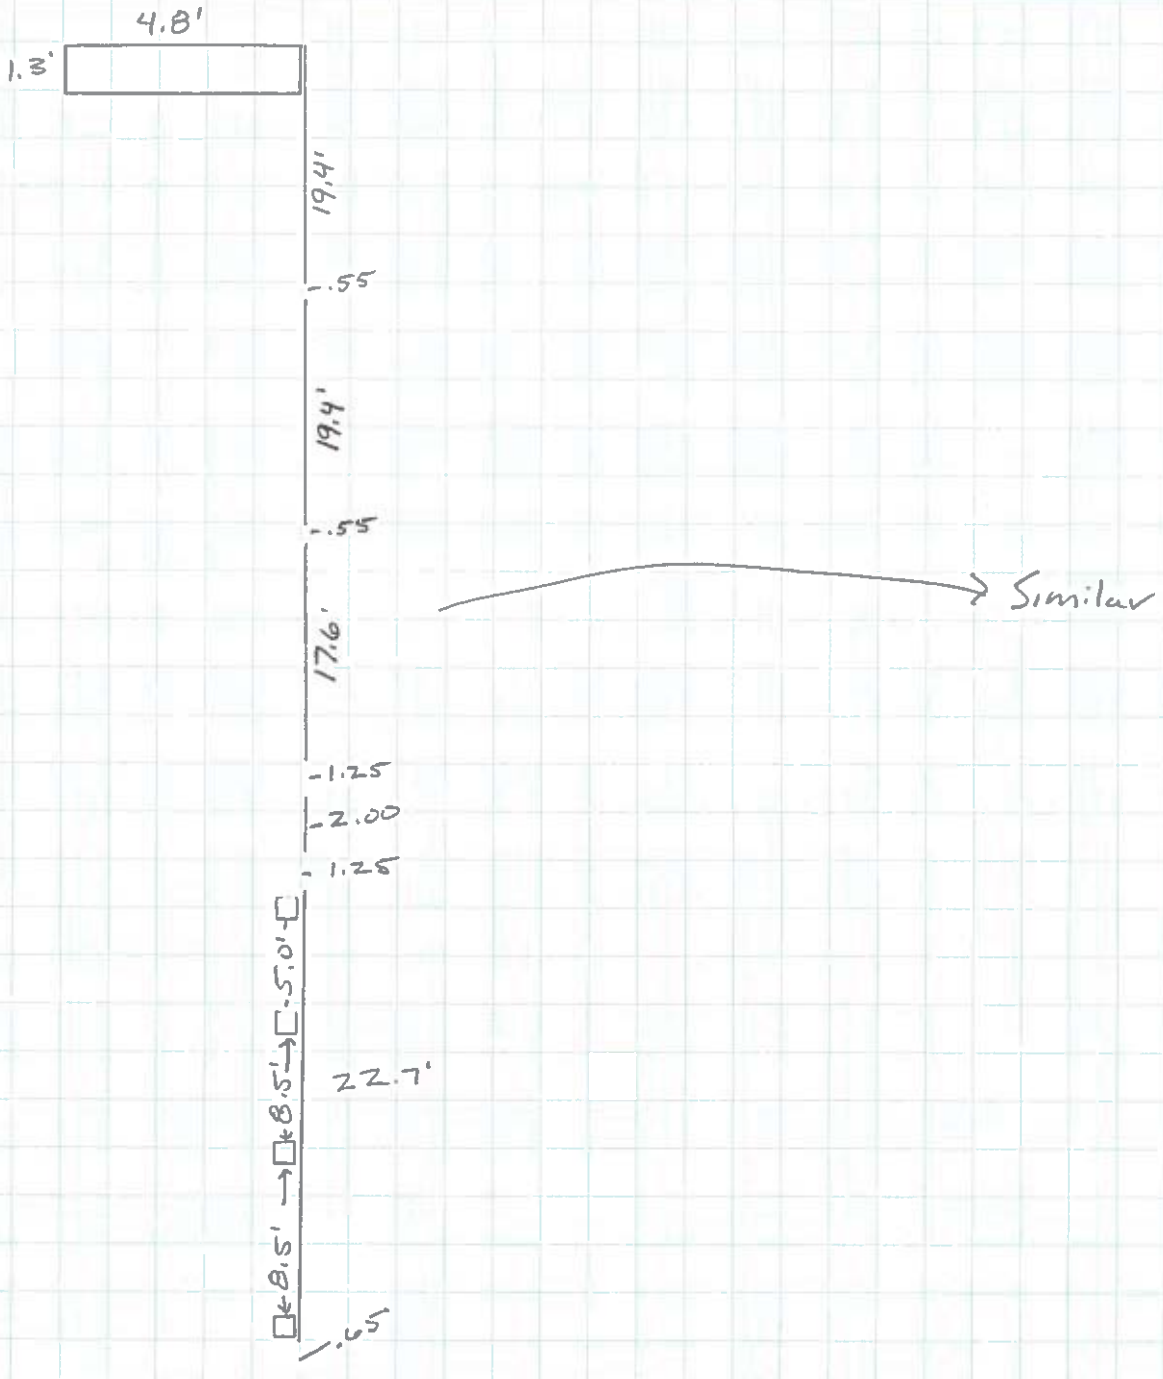

Mead & Hunt, Inc.

Job No. _____ Sheet _____ of _____
Job Name 000930
Task Rail Details
Calculated by _____ Date _____
Checked by _____ Date _____

Bayou

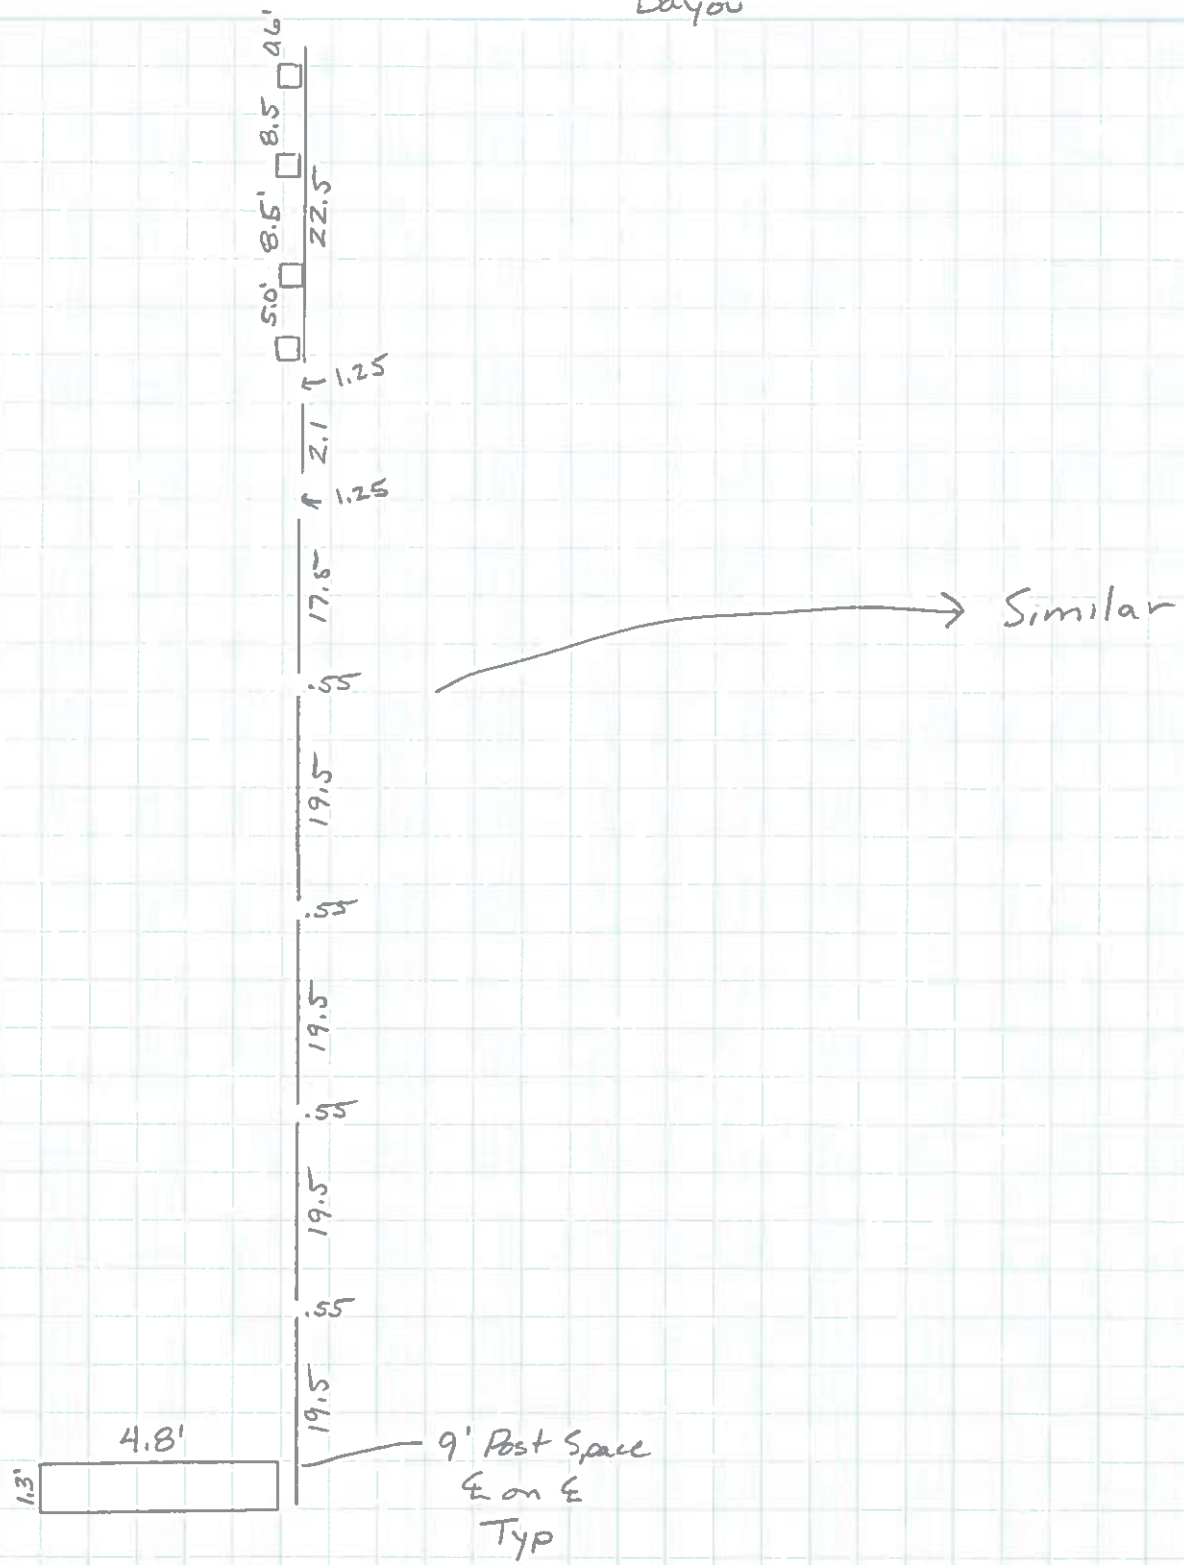

Mead & Hunt, Inc.

Job No. _____ Sheet _____ of _____
Job Name 000930
Task Equipment Room
Calculated by _____ Date _____
Checked by _____ Date _____

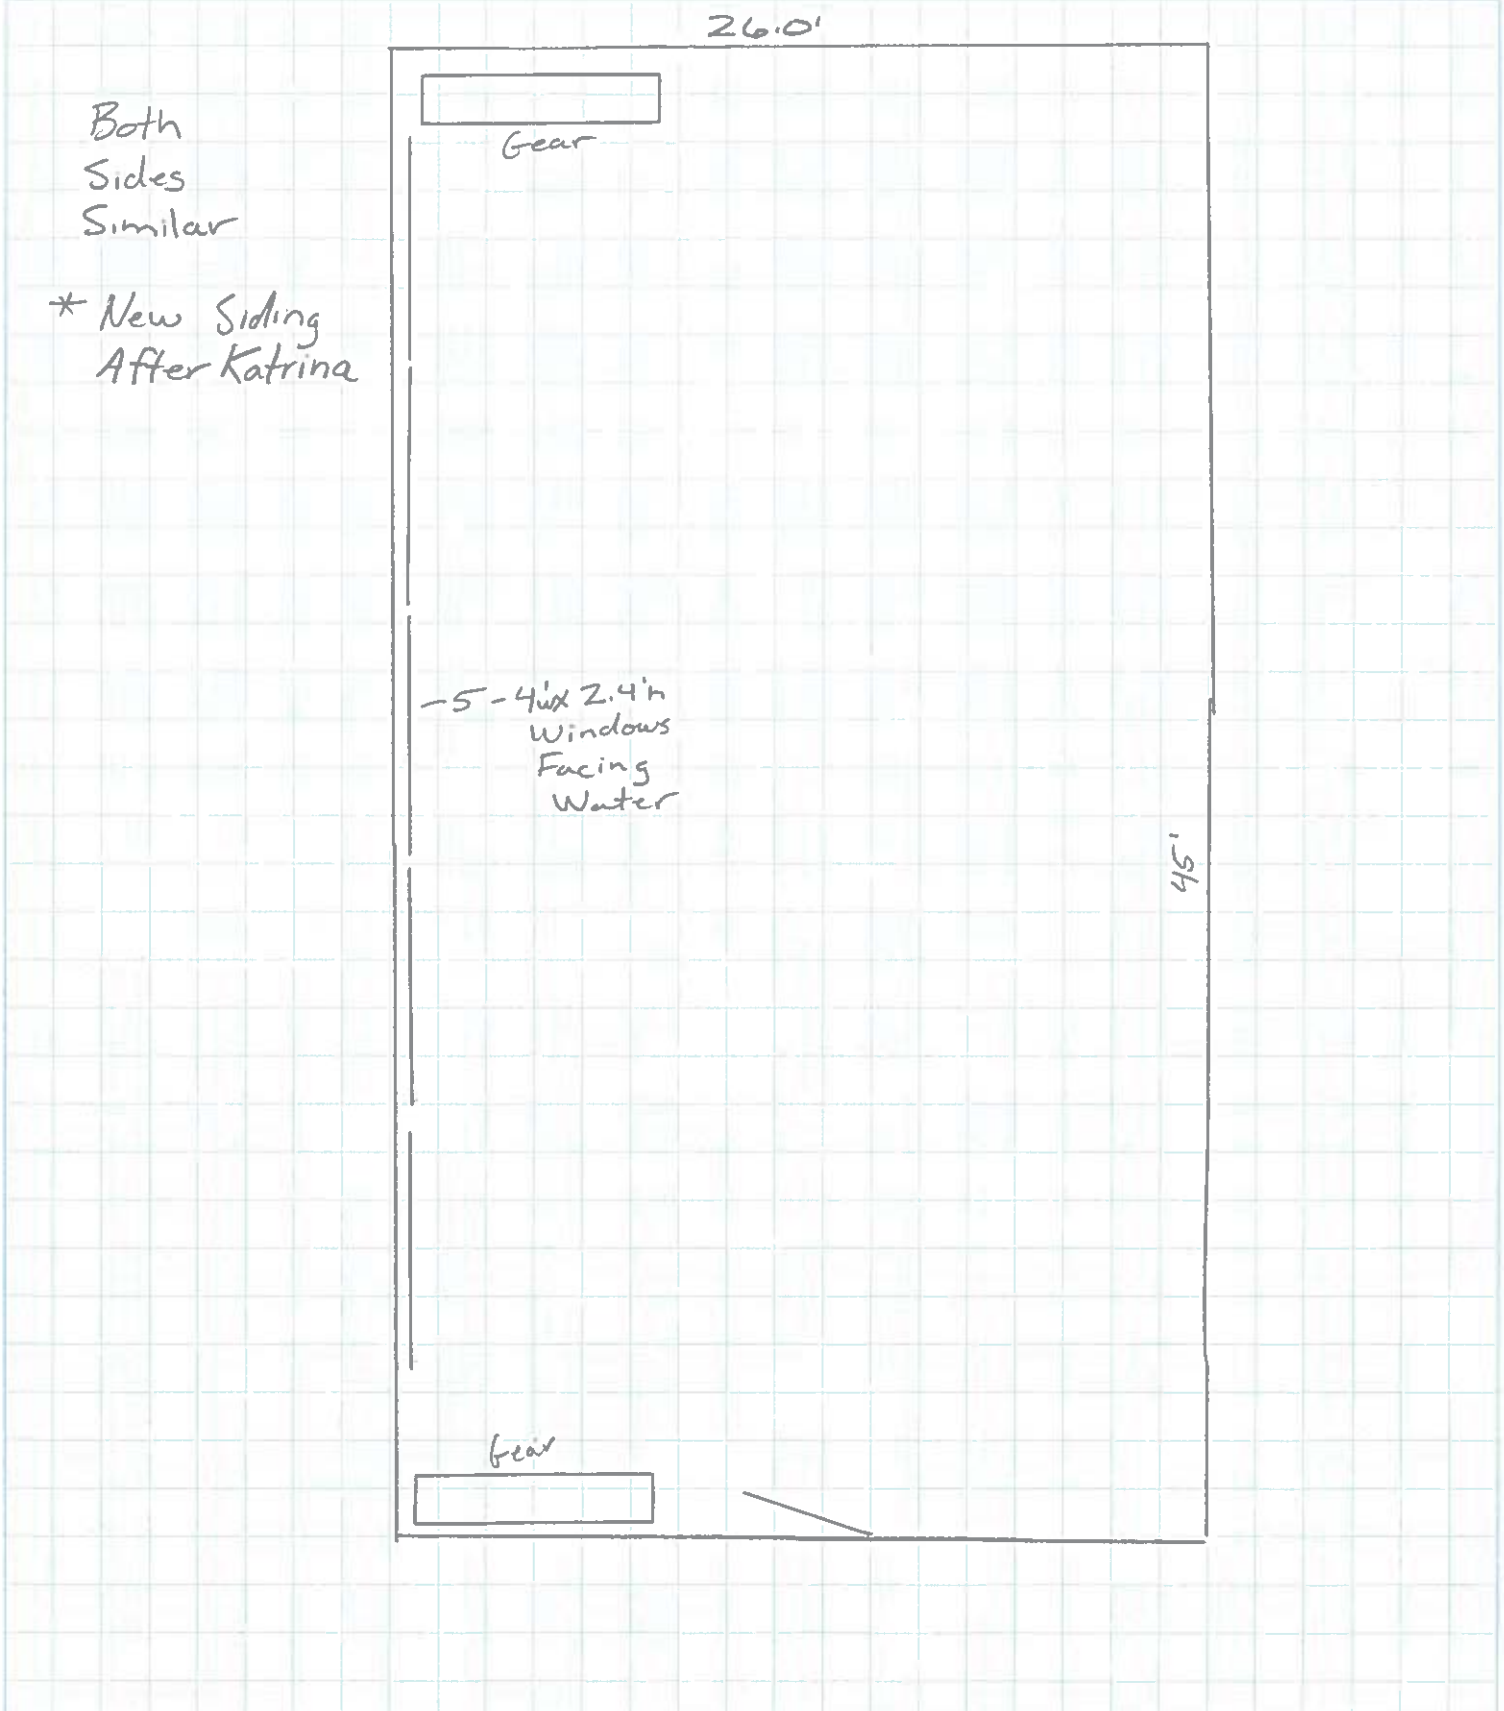

Mead & Hunt, Inc.

Job No. _____ Sheet _____ of _____
Job Name 000930
Task Equipment Room Roof Beams
Calculated by _____ Date _____
Checked by _____ Date _____

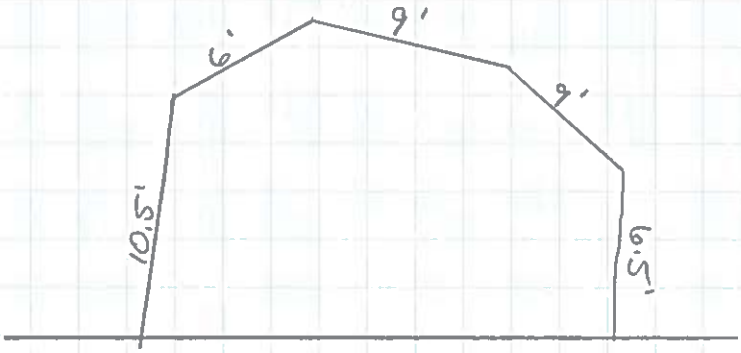

83

INDEX TO SHEETS

SHEET NO.	DESCRIPTION
1	Title Page and Layout Map
2-2a 2b-2e	Typical Section & Details
3-13	Plan & Profile
14-15	Summary Sheets
16-17	Summary of Drainage Structures
18-19	Detail of Intersections & Turnouts
20	General Bridge Plan
21	Detail of Bents
22-23	Detail of Piers
24	Detail of Spans
25-50	Detail of 180' Vertical Lift Span (Std. Plan SL-VL-180-28)
51	Modified Details for Aluminum Railings
52	Concrete Approach Slab
53	Fender System
54	Summary of Bridge Quantities and Camber Detail
55-68	Electrical System
70-71	Bridge Borings

	Standard Plans	Rev. Date
SC1	C-M-95	11-30-54
SC2	[illegible]	[illegible]
SC3	[illegible]	[illegible]
SC4	[illegible]	[illegible]
SC5	[illegible]	[illegible]
SC6	C-P-170	1-23-58
SC7	[illegible]	
SC8	[illegible]	
SC9	[illegible]	
SC10	[illegible]	
SC11	[illegible]	
SC12	[illegible]	
SC13	[illegible]	
SC14	[illegible]	
SC15	R-CT 75	

X-1 X-55 Cross Sections

Total Sheets without X-Sections 89
Total Sheets with X-Sections 124

STATE OF LOUISIANA

DEPARTMENT OF HIGHWAYS

PLANS OF PROPOSED

STATE HIGHWAY

S-253(3)

STATE PROJECT NO. 64-06-16

LOCKPORT RELOCATION

LAFOURCHE PARISH

La 1

S	STATE PROJECT	PARISH	SHEET NO.
253(3)	64-06-16	Lafourche	1

LaFourche Parish
Bridge 000930
Tower Vertical Lift

Sheet 1 of 17

Test Bridge
Section 106 in Process

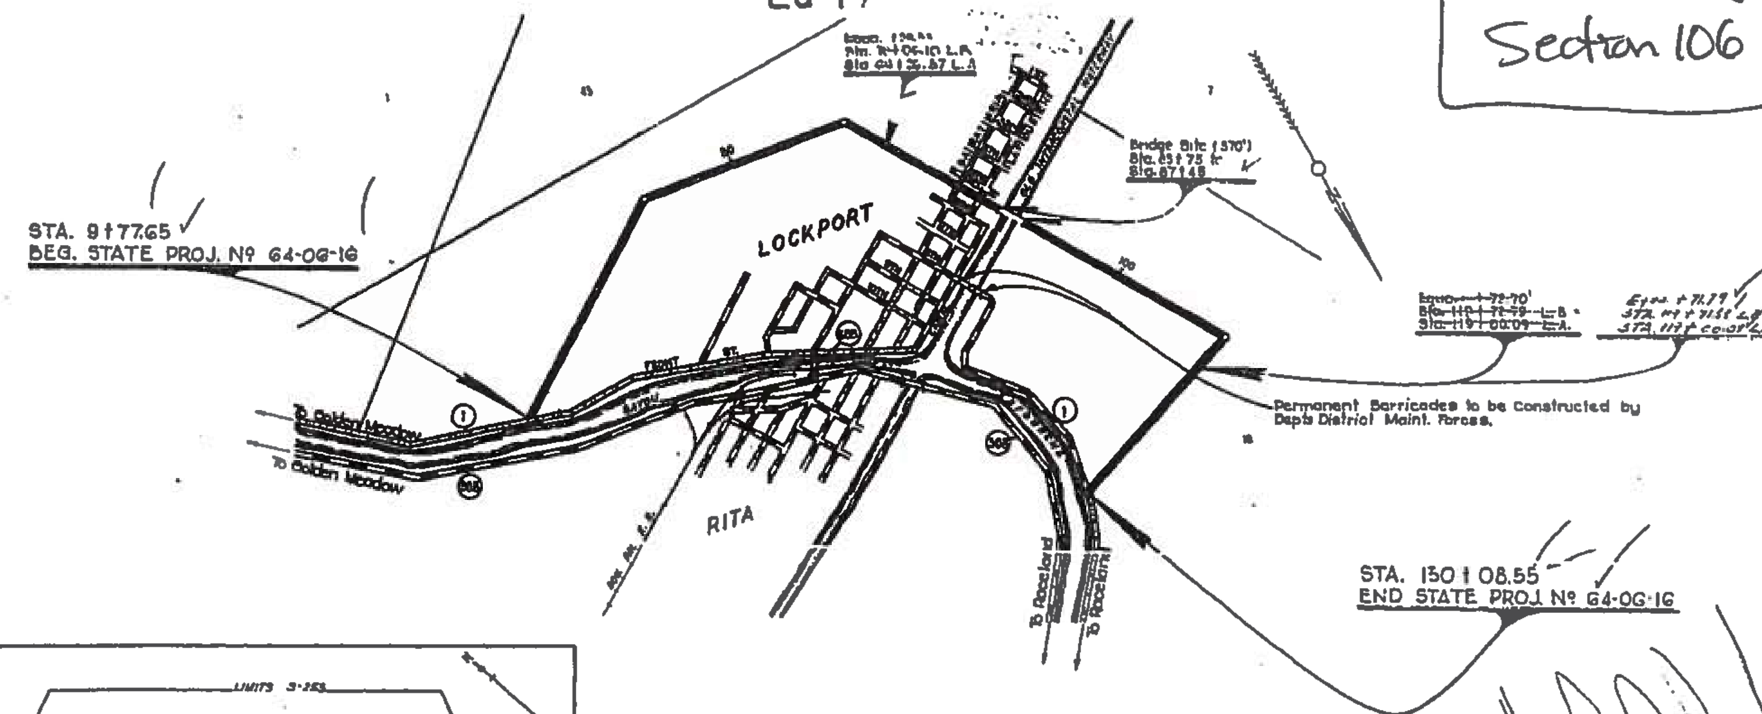

SCHEDULE OF REVISIONS

DATE	REVISION	DATE	RECOMMENDED	DATE	APPROVED
[illegible]	Sheets [illegible]				

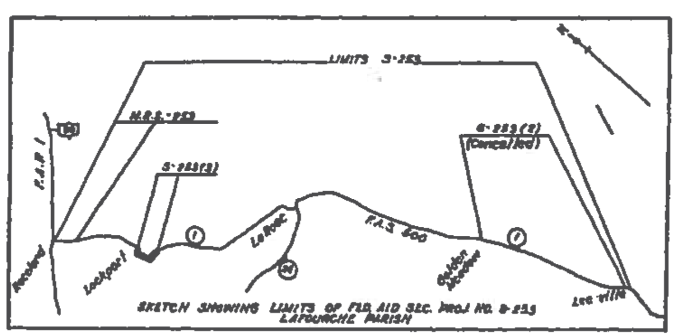

DATUM USED: U.S.G.S. (1932)
MAG. VAR.: 6°-46' E
BEARINGS ARE True
TRANSIT BOOKS: 36-271
LEVEL BOOKS: 36-491
SCALES PLAN: 1"= 40'
PROFILE: HOR. 1"= 40'
VERT. 1"= 4'

TYPE OF CONSTRUCTION: Portland Cement Concrete Pavement

DELIVERY POINTS: Lockport on Sou. Pac. R. R. and by Barge.

LAYOUT MAP

SCALE: 1 INCH 1000 FEET

LENGTH OF PROJECT

DESCRIPTION		ALGEBRAIC SUM OF ALL EQUATIONS	GROSS LENGTH	EXCEPTION	BRIDGE LENGTH		ROADWAY LENGTH	
STA.	TO STA.	FEET	FEET	FEET	FEET	MILES	FEET	MILES
9+77.65	130+08.55	1102.23	12133.15		370	0.070	11763.15	2.227
		[illegible]	[illegible]				[illegible]	
TOTAL LENGTH OF BRIDGES					370	0.070		
TOTAL LENGTH OF ROADWAY							11763.15	2.227
TOTAL MILES					2.297			

RECOMMENDED FOR APPROVAL
TRAFFIC & PLANNING ENGINEER

RECOMMENDED FOR APPROVAL
ROAD DESIGN ENGINEER 11-7-57

RECOMMENDED FOR APPROVAL
BRIDGE DESIGN ENGINEER 11-7-57

APPROVED
CHIEF ENGINEER 11-7-57

RECOMMENDED FOR APPROVAL DATE
[redacted]
DISTRICT ENGINEER
DEPARTMENT OF COMMERCE
BUREAU OF PUBLIC ROADS

APPROVED DATE
[redacted]
DIVISION ENGINEER
DEPARTMENT OF COMMERCE
BUREAU OF PUBLIC ROADS

109

000930
Sheet 2 of 17

OK
INTRACOASTAL
OK
5'0" Walk
MAYEAUX

Deck | Walk
.85 curb

measure all basic dimensions of superstructure: length, width, sidewalks, railings, curbs, etc.

26.7'
156'-5"
26.6'
60'
100.0'

55.29

PIER N° 1
PIER N° 2

GENERAL BRIDGE PLAN
INTRACOASTAL WATERWAY
LOCKPORT
LA. ROUTE N° 1
STATE OF LOUISIANA
DEPARTMENT OF HIGHWAYS

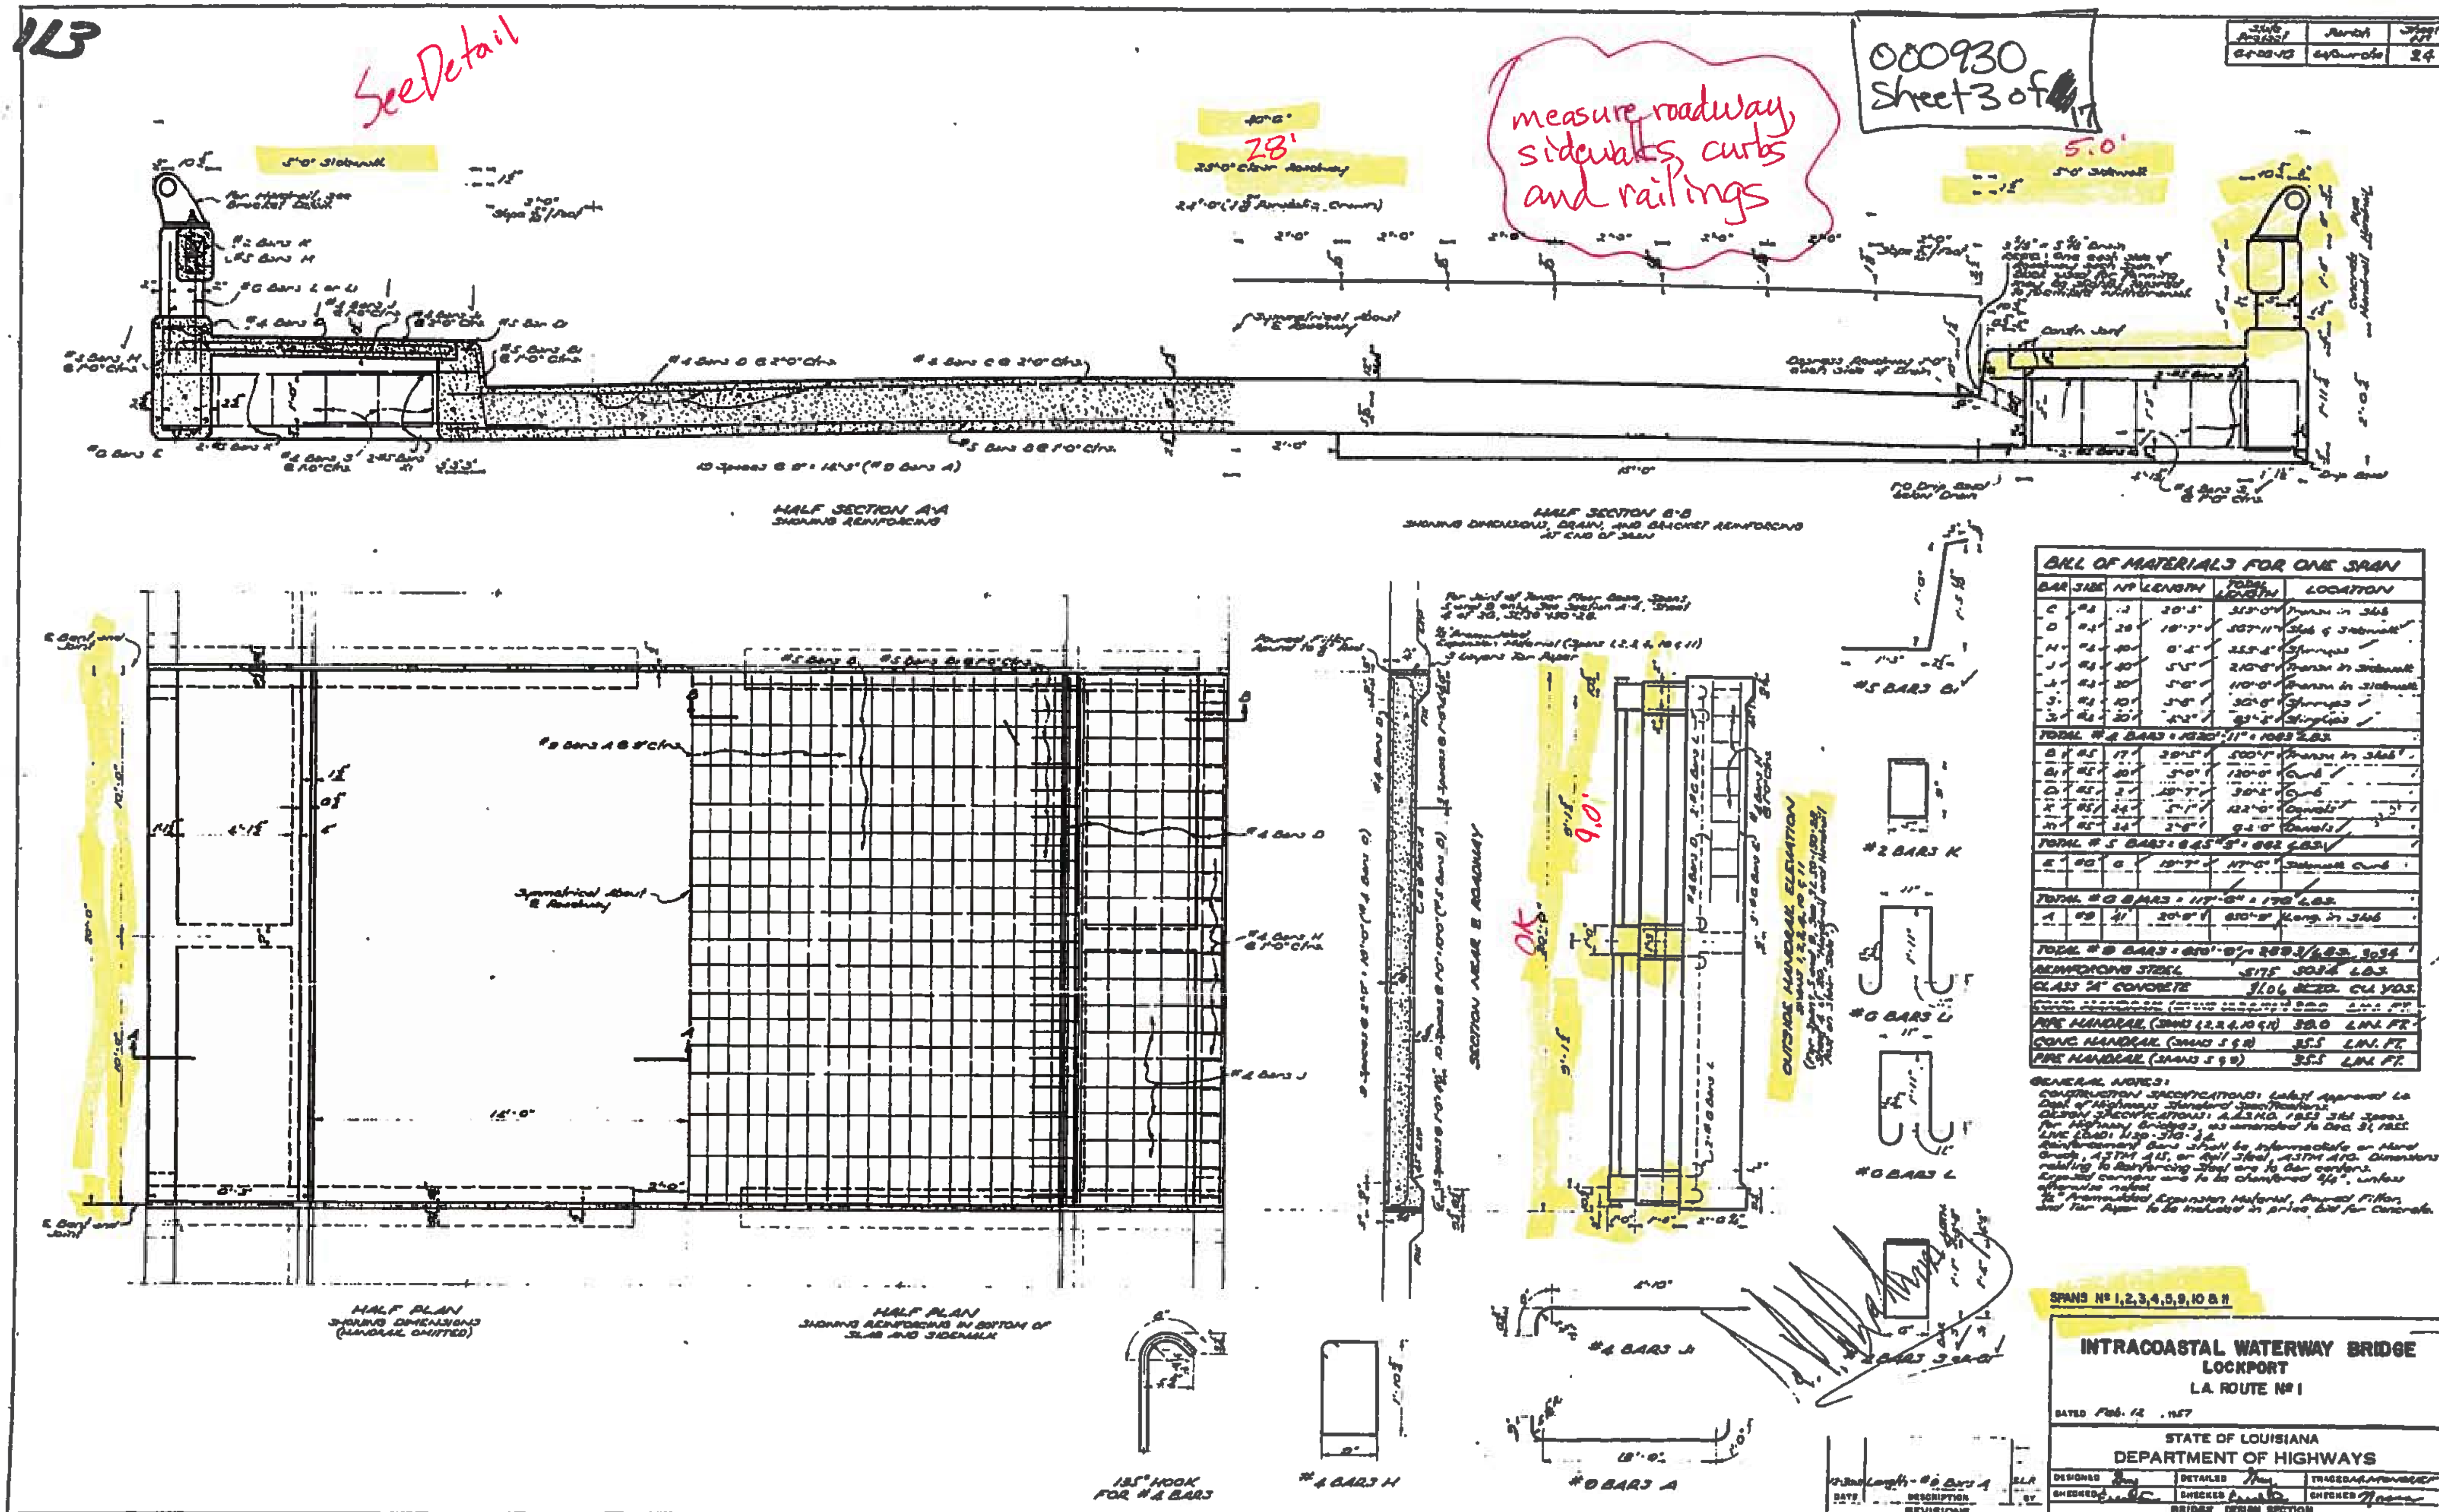
123
See Detail
measure roadway, sidewalks, curbs and railings
000930
Sheet 3 of 17
28'
5.0'
9.0'
OK
5'-0" Sidewalk
28'-0" Clear Roadway
HALF SECTION A-A
SHOWING REINFORCING
HALF SECTION B-B
SHOWING DIMENSIONS, DRAIN, AND BRACKET REINFORCING AT END OF SPAN
HALF PLAN
SHOWING DIMENSIONS (HANDRAIL OMITTED)
HALF PLAN
SHOWING REINFORCING IN BOTTOM OF SLAB AND SIDEWALK
SECTION NEAR ℄ ROADWAY
OUTSIDE HANDRAIL ELEVATION
BILL OF MATERIALS FOR ONE SPAN
GENERAL NOTES:
135° HOOK FOR #4 BARS
#4 BARS H
#8 BARS A
#4 BARS J
#5 BARS B
#2 BARS K
#6 BARS L
SPANS № 1,2,3,4,5,9,10 & 11
INTRACOASTAL WATERWAY BRIDGE
LOCKPORT
LA. ROUTE № 1
DATED Feb. 12, 1957
STATE OF LOUISIANA
DEPARTMENT OF HIGHWAYS
BRIDGE DESIGN SECTION
REVISIONS

000930 17
Sheet 4 of 16

see notes on Sheet 3 of 16

HALF SECTION THRU ROADWAY AT FLOORBEAM

LIFTING HEAD FOR WIRE ROPES
For complete Assembly, See Machinery Drawings

PLAN VIEW AT FIXED END OF SPAN
SHOWING SPAN GUIDE AND BUFFER CONN.
(detail at exp. end same except for span guide casting)

WELDING DETAIL
FOR SPAN GUIDE ANGLES

SIDEWALK CLIP ⅜ TYP.
FOR ALL TRANSV. STIFFN'RS.
AT INT. FLOORBEAMS

SIDEWALK CLIP L TYP.
FOR TRANSV. STIFFN'R.
AT ALT. SPLICE

SIDEWALK CLIP L TYP.
FOR ALL TRANSVERSE
STIFFN'RS. BETWEEN
FLOORBEAMS

SIDEWALK CLIP ⅜ TYP.
FOR TRANSVERSE
STIFFENERS @ END
FLOORBEAMS

SECTION A-A
grid deck not shown

SHOE FOR LIFT SPAN
(4 reqd total)

Swivel may be left blank and drilled in field after parts have been set to correct alignment and adjustment or subpunched or drilled smaller and reamed to size in field after erection

ELEVATION E-E

CONNECTION DETAIL AT TOWER

PLAN OF SIDEWALK
AT FLOORBEAM

SECTION B-B

CONNECTION DETAIL FOR LATERAL
BRACING AT ODD FLOORBEAMS

CONNECTION DETAIL FOR LAT'L
BRACING AT EVEN FLOORBEAMS

SECTION C-C

SECTION D-D

SPAN BEARING B
(4 reqd. total)(shall be either steel casting or weldment)

SECTION THRU SIDEWALK
BETWEEN FLOORBEAMS

MOMENTS AND REACTIONS FOR STRINGERS & FLOORBEAMS

	EXTERIOR STRS.		INTERIOR STRS.		FLOORBEAMS	
	M(K-FT)	R (K)	M(K-FT)	R (K)	M(K-FT)	R (K)
D	6.9	1.4	8.1	1.1	155.6	13.0
D+L	11.4	2.4	0.0	0.0	98.2	8.2
L	48.2	10.5	58.7	20.1	646.1	47.0
I	14.8	4.1	17.6	6.0	198.9	14.1
T	81.0	21.4	81.4	27.8	1081.7	76.0

STANDARD PLAN
150' VERTICAL LIFT SPAN
LIVE LOAD H20-S16-44
28'-0" ROADWAY 5'-0" SIDEWALKS
46'-0" LIFT OPEN STEEL GRID FLOOR
DATE MARCH 16 1957
STATE OF LOUISIANA
DEPARTMENT OF HIGHWAYS
BRIDGE DESIGN SECTION

REVISIONS

SHEET 2 OF 26

SL50-150-28

112

000930
Sheet 5 of 6

See notes on Sheet 3 of 6

0.85'

HALF SECTION THRU TOWER SPAN AT REAR FLOOR BEAM
SHOWING TYPICAL SIDEWALK AND HANDRAIL REINFORCEMENT

HALF SECTION THRU TOWER SPAN AT FRONT FLOOR BEAM
SHOWING TYPICAL SIDEWALK AND HANDRAIL DIMENSIONS

BILL OF MATERIAL (ONE SPAN)

BAR	SIZE	NO	LENGTH	TOTAL LENGTH	LOCATION
A	#8	92	42'-3"	4026'-6"	Length in Slab
TOTAL WT @ 3.400 = 4026'-6" = 6702 Lbs.					
N	#8	8	25'-1"	200'-0"	Length in Slab Beam
TOTAL WT @ 3.400 = 680' = 2312 Lbs.					
B	#5	28	30'-0"	840'-0"	Bottom Bolt of Slab
E	#5	30	3'-3"	97'-6"	Top of Slab @ Curb Line
F	#5	58	3'-6"	203'-0"	Curb
J	#5	8	4'-10"	38'-8"	Diaphragm
K	#5	8	3'-8"	29'-4"	Diaph. to Slab Dowels
TOTAL WT @ 1.043 = 1349'-8" = 1408 Lbs.					
C	#4	12	30'-0"	360'-0"	Bottom of Top of Slab
D	#4	30	29'-3"	877'-6"	Length Top Slab @ Slab
G	#4	22	3'-6"	77'-0"	Top of Curb Bottom of Slab
H	#4	24	6'-3"	150'-0"	Diagonals in Slab Beam
L	#4	30	4'-2"	125'-0"	Diagonals in Diaph.
TOTAL WT @ 0.668 = 2134'-2" = 1426 Lbs.					
TOTAL REINFORCING STEEL =					9886 Lbs.
TOTAL CLASS "A" CONCRETE =					49.2 CU. YDS.
GALVANIZED CARBON STEEL =					377 Lbs.
CONCRETE HANDRAIL					41.20 LIN. FT.
PIPE HANDRAIL					41.20 LIN. FT.

#8 BARS A

#8 BARS N

#5 BARS F #4 BARS K #4 BARS R

HALF PLAN
SHOWING HANDRAIL ON SIDE OPPOSITE STAIRS AND REINFORCEMENT AS NOTED

HALF PLAN
SHOWING HANDRAIL SPACING ON SPAN SIDE

#8 BARS B

SECTION ALONG E ROADWAY

SECTION A-A

SECTION B-B

SECTION SHOWING DRAIN

#4 BARS L2

DETAIL OF REINF. IN HANDRAIL POST AT CONSTRUCTION JOINT

#2 BARS H

HANDRAIL AND HANDRAIL POST ON SPAN SIDE
OTHER SIDE SIMILAR BUT OPPOSITE HAND

HANDRAIL AND HANDRAIL POST REINFORCEMENT

#8 BARS L1 #8 BARS L

TOWER SPAN

STANDARD PLAN
150' VERTICAL LIFT SPAN
LIVE LOAD H20-S16-44
28'-0" ROADWAY 5'-0" SIDEWALKS
45'-0 LIFT OPEN STEEL GRID FLOOR
DATED FEB. 28, 1947

STATE OF LOUISIANA
DEPARTMENT OF HIGHWAYS

DESIGNED	DETAILED	TRACED AND CHECKED
CHECKED	CHECKED	CHECKED

BRIDGE DESIGN SECTION

REVISIONS

DATE	DESCRIPTION	BY

SHEET 4 OF 26

SL50-150-28

000930
Sheet 5 of 17

25

THICKNESS AND Nº OF SHIMS TO BE FURNISHED			
SHIMS / BEARING SHIMS	1/16"	1/8"	1/4"
3/8"	2	2	2
1/2"	4	2	4
3/4"	6	3	3

check/measure whatever you can safely get to; take photos

NOTE:
THE CONTRACTOR SHALL DETERMINE THE FINAL DIMENSIONS OF PARTS INVOLVING COMMERCIAL PRODUCTS SUCH AS MOTORS, SPEED REDUCERS, BRAKES, ELECTRICAL EQUIPMENT AND THE LIKE, FROM CERTIFIED DIMENSIONAL OUTLINES OF THE COMMERCIAL PRODUCTS BEFORE MAKING SHOP DRAWINGS OF THE PARTS INVOLVED.

PAINTING NOTE:
ALL UNFINISHED SURFACES OF MACHINERY SHALL BE PAINTED ONE SHOP COAT OF RED LEAD AND OIL. ALL FINISHED SURFACES SHALL BE COATED WITH WHITE LEAD AND TALLOW BEFORE SHIPMENT AND SHALL BE PROTECTED BY WOODEN CASING.

LUBRICATION NOTE:
UNLESS OTHERWISE SHOWN ON DETAIL DRAWINGS
BUSHINGS SHALL BE AS FOLLOWS OIL IMPREGNATED BRONZE BUSHINGS SHALL BE USED FOR ALL PULLEY BLOCKS, COUPLINGS & TRUNION BEARINGS - E.320 FOR GREASE "G".
SPURRED TEETH - MEDIUM HARD BRONZE.
ENCLOSED SPEED REDUCERS - STD OIL TEXACO 85" VISC SAE 90.
WIRE ROPE - STD OIL CO. LUBRITE COMPOUND Nº 1500.

DATE	DESCRIPTION	BY
	REVISIONS	

GENERAL ARRANGEMENT OF SPAN
OPERATING MACHINERY

M1

STANDARD PLAN
150' VERTICAL LIFT SPAN
LIVE LOAD H20-S16-44
28'-0" ROADWAY 6'-0" SIDEWALKS
45'-0" LIFT OPEN STEEL GRID FLOOR
DATE APRIL 25, 1927

STATE OF LOUISIANA
DEPARTMENT OF HIGHWAYS

DESIGNED	DETAILED	TRACED	CHECKED
Kurrus	Brewster	Brewster	Kurrus

BRIDGE DESIGN SECTION

SHEET 15 OF 26

SL50-150-28

000930
Sheet 7 of 17

EAST ELEVATION

SECTIONAL SOUTH ELEVATION
LOOKING SOUTH

SECTIONAL WEST ELEVATION
LOOKING WEST

NORTH ELEVATION

ORLEANS MATERIALS & EQUIPMENT CO., INC.
NEW ORLEANS, LA.

PRINTS

NO.	DATE	PER
1	7-10-58	C

STRUCTURE INTRACOASTAL WATERWAY BRIDGE
LOCATION LAFOURCHE BAYOU, LOUISIANA
ARCHITECT LABORDE, OLIVA & SCHWARTZ
CONTRACTOR AMERICAN BRIDGE CO.
DETAIL OF ERECTION PLANS - TOWER LEGS
FINISH

DRAWN	DATE	SCALE
Q	7-10-58	5081
CHECKED	O.K. DATE	DRAWING
H		588

SOUTH TOWER ELEVATIONS

000930
Sheet 8 of 17

EAST ELEVATION

SECTIONAL SOUTH ELEVATION
LOOKING SOUTH

SECTIONAL WEST ELEVATION
LOOKING WEST

NORTH ELEVATION

NORTH TOWER ELEVATIONS

ORLEANS MATERIALS & EQUIPMENT CO. INC.
NEW ORLEANS, LA.

PRINTS

NO.	DATE	BY

PERIOD

SHEET NO.	DRAWING NO.
9	5081
DATE	
7-10-36	
SCALE	SPEC. NO.
	320

118

No Vehicle Hits

000930
Sheet 9 of 17

		29

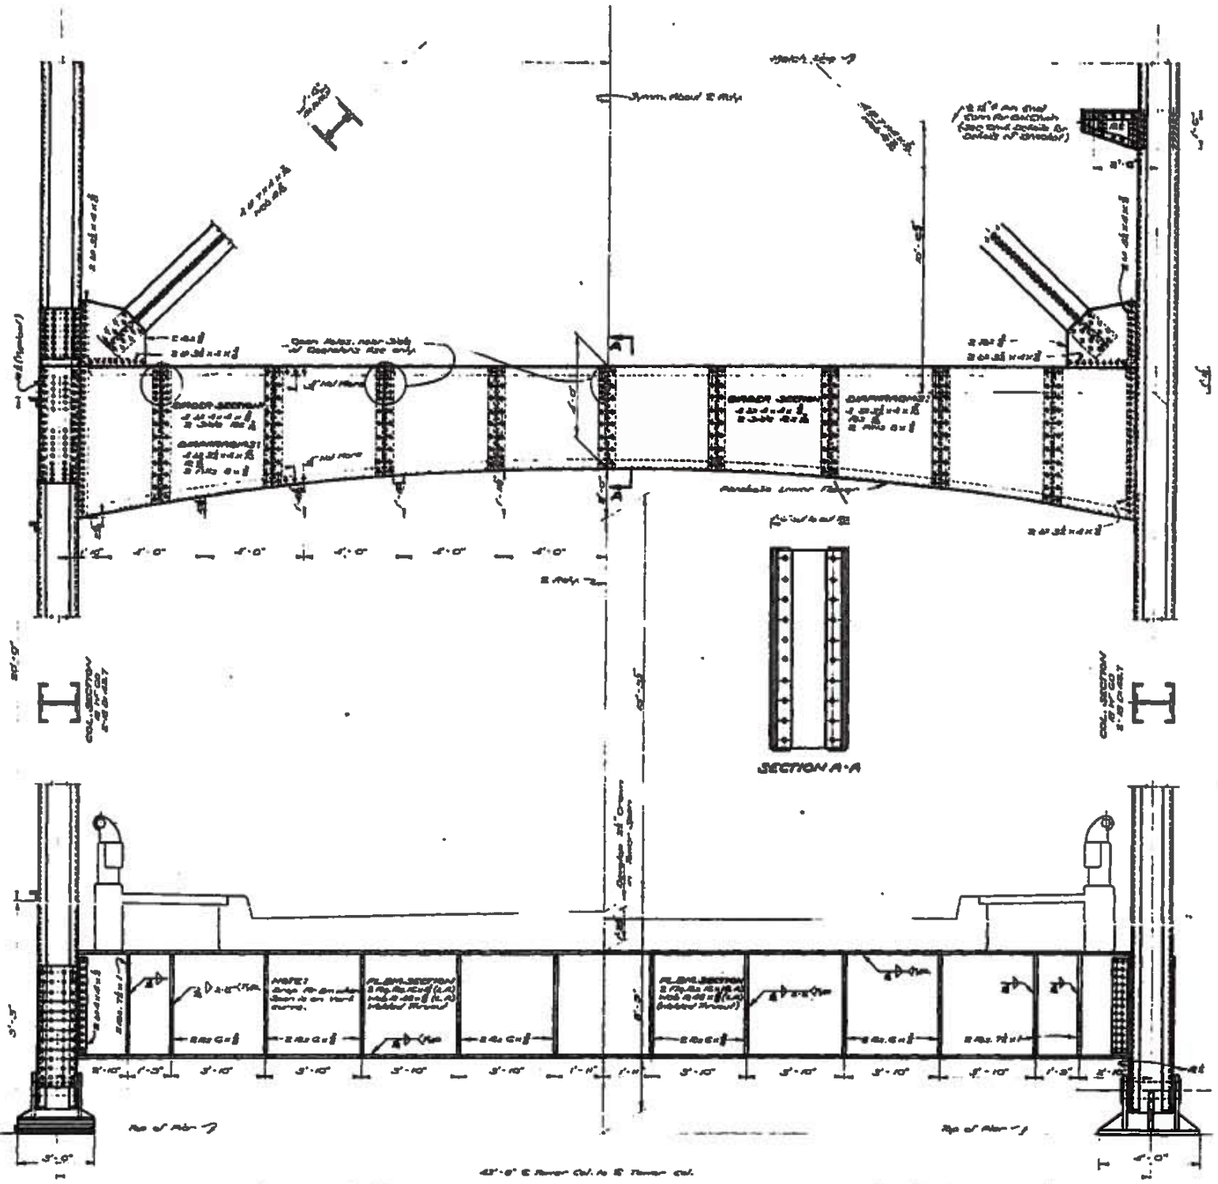

SECTION A-A

HALF ELEVATION AT REAR OF TOWER

HALF ELEVATION AT FRONT OF TOWER

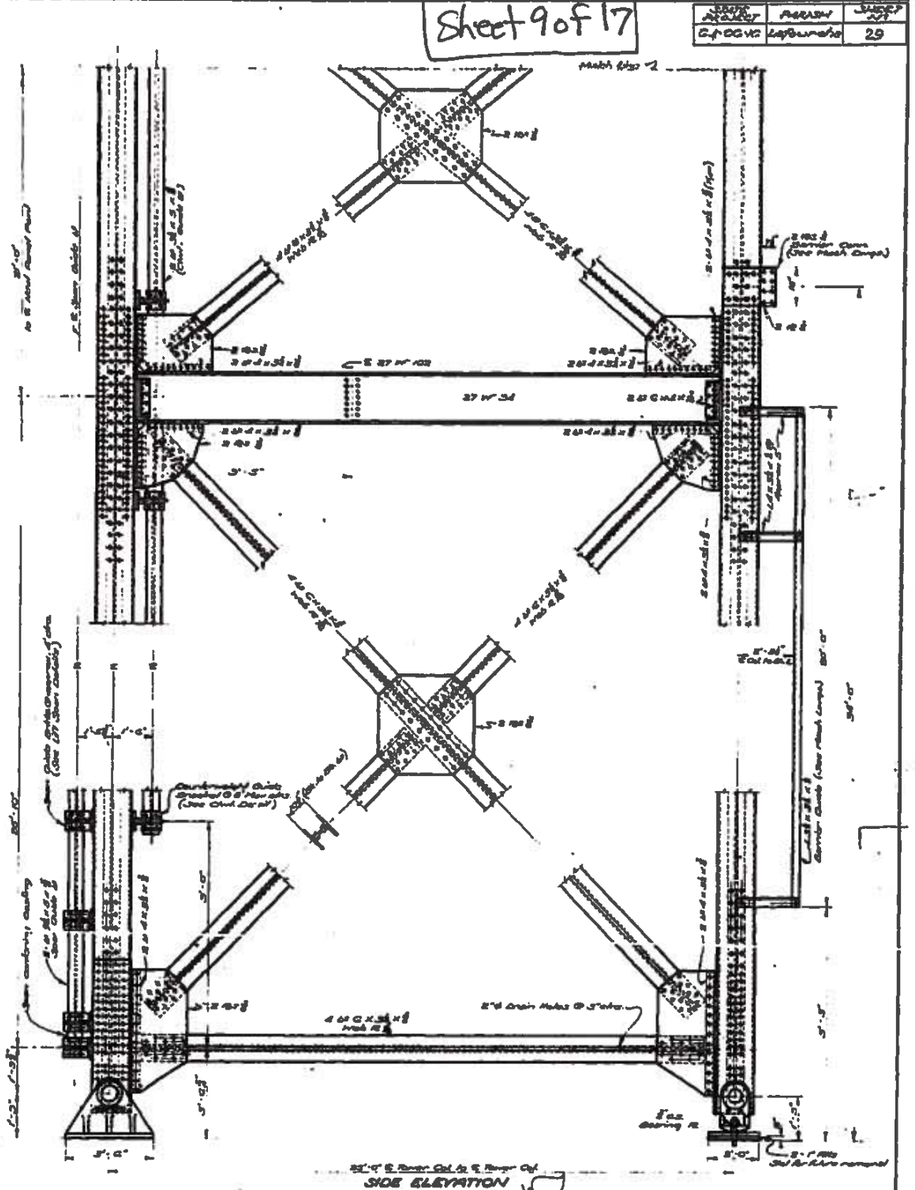

SIDE ELEVATION

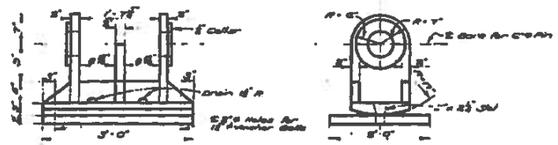

CAST STEEL EXPANSION SHOE FOR REAR TOWER COLUMNS
2 REQ'D. EACH TOWER

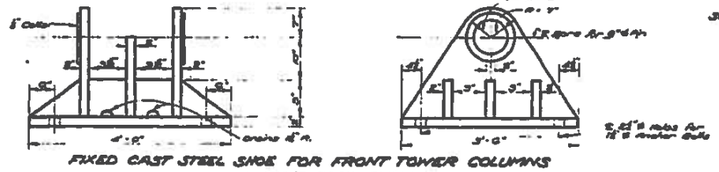

FIXED CAST STEEL SHOE FOR FRONT TOWER COLUMNS
2 REQ'D EACH TOWER

SURFACE FINISHES:

TOWER DETAILS

STANDARD PLAN
150' VERTICAL LIFT SPAN
LIVE LOAD H20-S16-44
28'-0" ROADWAY
46'-0" LIFT
5'-0" SIDEWALKS
OPEN STEEL GRID FLOOR
DATED: April 1, 1957

STATE OF LOUISIANA
DEPARTMENT OF HIGHWAYS

DESIGNED	DETAILED	TRACED
CHECKED S.L.P.	CHECKED S.L.P.	CHECKED S.L.P.

BRIDGE DESIGN SECTION

DATE	DESCRIPTION	BY
	REVISIONS	

SHEET 8 OF 26

SL50-150-28

119

000930
Sheet 10 of 17

HALF ELEVATION AT REAR OF TOWER

HALF ELEVATION AT FRONT OF TOWER

SIDE ELEVATION

SECTION THRU TYPICAL OPTIONAL COLUMN SPLICE

NOTE: SEE SHEET Nº 7 OF 26 FOR SECTION B-B, C-C, D-D, E-E AND F-F

TOWER DETAILS

STANDARD PLAN
150' VERTICAL LIFT SPAN
LIVE LOAD H20-S16-44
28'-0" ROADWAY 5'-0" SIDEWALKS
45'-0" LIFT OPEN STEEL GRID FLOOR

DATE APRIL 28 67

STATE OF LOUISIANA
DEPARTMENT OF HIGHWAYS

BRIDGE DESIGN SECTION

SHEET 6 OF 26

SL50-150-28

121

PLAN LANDING AT GENERATOR'S HOUSE

SECTION B-B

SECTION D-D

TYPICAL BRACKET DETAIL AT INTERMEDIATE LANDINGS

TYPICAL CONN. DETAIL I2 ∠ TO BRACING

000930
Sheet 11 of 17

NOTES FOR STAIRWAYS & LANDINGS:

SIDE ELEVATION

REAR ELEVATION

DETAIL OF TREAD SPACING

VIEW A-A

SECTION C-C

SECTION E-E

PLAN LANDING AT MACK HOUSE

LADDER DETAIL

TOWER STAIRWAY DETAILS

STANDARD PLAN
150' VERTICAL LIFT SPAN
LIVE LOAD H20-S16-44
26'-0" ROADWAY 5'-0" SIDEWALKS
45'-0" LIFT OPEN STEEL GRID FLOOR
DATED April 24, 1957

STATE OF LOUISIANA
DEPARTMENT OF HIGHWAYS
DESIGNED DETAILED TRACED
CHECKED CHECKED CHECKED
BRIDGE DESIGN SECTION

DATE DESCRIPTION BY
REVISIONS

SHEET 8 OF 26

SL50-150-28

122

000930
Sheet 12 of 17

STATE PROJECT	PARISH	SHEET NO.
66-00 VG	Lafourche	33

HALF PLAN VIEW

CONCRETE COUNTERWEIGHT ADJUSTING BLOCKS *

* To be included in place "A" Concrete in Counterweight.

The Contractor shall furnish enough blocks to balance span, but not less than 350 blocks, that is furnished for each counterweight.

BALANCE CHAINS:

(4) Balance Chains consist of (2) pair counterweight chains of 2 1/2" dia. Galvanized Chain to be 2 1/2" nominal or Standard Iron Chain, as listed in Steelcraft, weight 6 lbs. per ft. or approved equal. Counterweight chains 1 3/4" dia. (2) pair operating chains, weight 4 lbs. per ft. (2) operating chains shall be of such length that span shall not be more than 60 ft. from floor when span is fully raised. Balance Chains are to be galvanized.

Approx. wt. of (4) Chains = 9470 Lbs. Balance Chains will be paid for per lump sum.

FRONT ELEVATION

SIDE ELEVATION

HALF SIDE ELEVATION

SECTION A-A

SECTION B-B

SECTION C-C

SECTION THRU CTWT.

PART PLAN AT END OF CTWT.

NOTE:
Counterweight Reinforcement to be #5 Bars at Approx. 12" Other Each Way) - All Bends Lap Bars 1'-0"

SECTION D-D

1 1/8" x 0'-7 1/2" COLD ROLLED STEEL PIN
Class 45 Heat-treated Carbon Steel
6 Rqrd. Total

WELDING DETAIL FOR COUNTERWEIGHT GUIDE L2

	SPAN CLOSED	SPAN RAISED
wt. of Span	382.5 Kips	382.5 Kips
wt. of 30' of Span	3.6	3.6
	386.0 Kips	386.1 Kips
wt. of 2 Chains	380.2 Kips	380.2 Kips
wt. of 30' of Span	3.6	3.6
wt. of Balance Chains	6.8	3.6
	3870 Kips	3873.6 Kips

NOTE "A":
This material is classified as excavation material and no direct payment will be made for same. See Sheet of Counterweight, Erection Details also.

COUNTERWEIGHT DETAILS

STANDARD PLAN
150' VERTICAL LIFT SPAN
LIVE LOAD H20-S16-44
28'-0" ROADWAY 5'-0" SIDEWALKS
45'-0" LIFT OPEN STEEL GRID FLOOR
DATED April 18, 1977

STATE OF LOUISIANA
DEPARTMENT OF HIGHWAYS

DESIGNED	DETAILED	TRACED BY
CHECKED	CHECKED	

BRIDGE DESIGN SECTION

REVISIONS

SHEET 8 OF 26

SL 50-150-28

124

000930
Sheet 13 of 17

STATE PROJECT	PARISH	SHEET NO.
04-00-16	Lafourche	35

* Resided after Katrina.

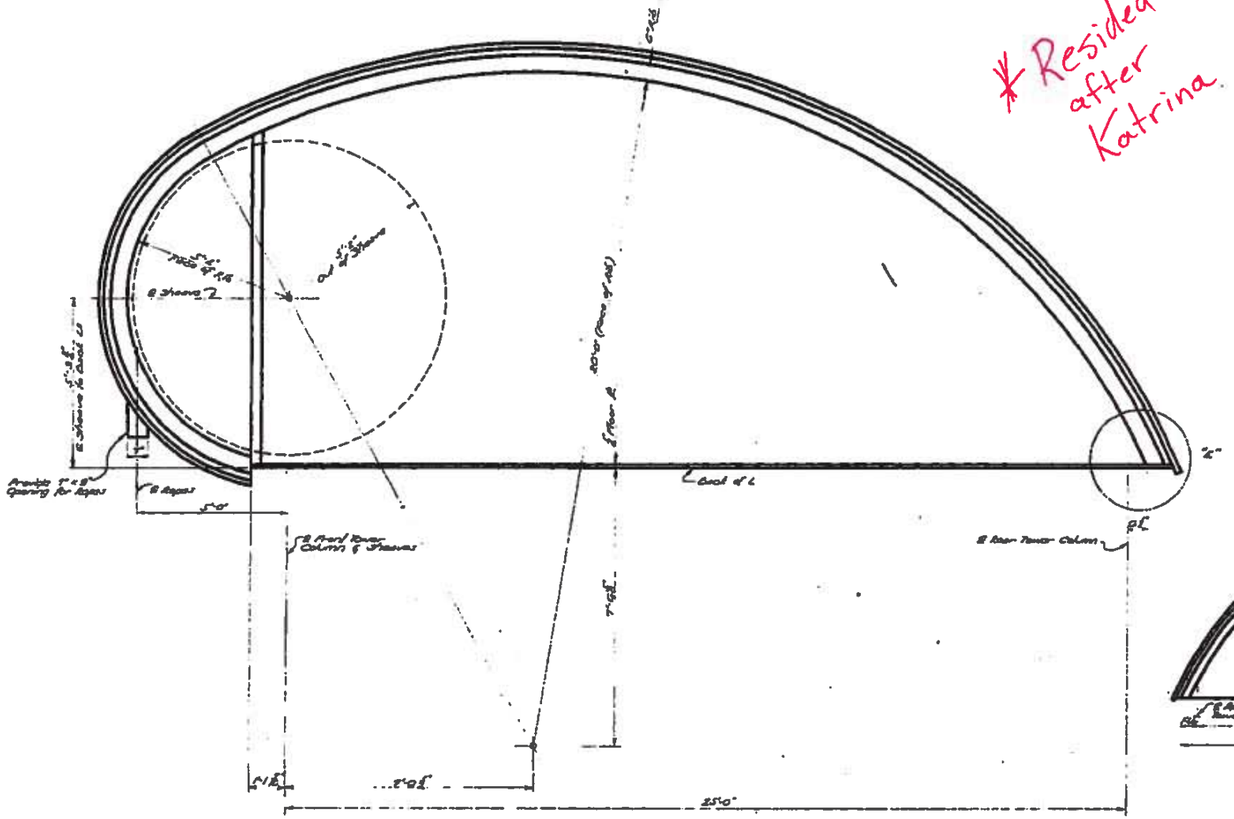

OUTLINE DIMENSIONS
SCALE: 1" = 1'-0"

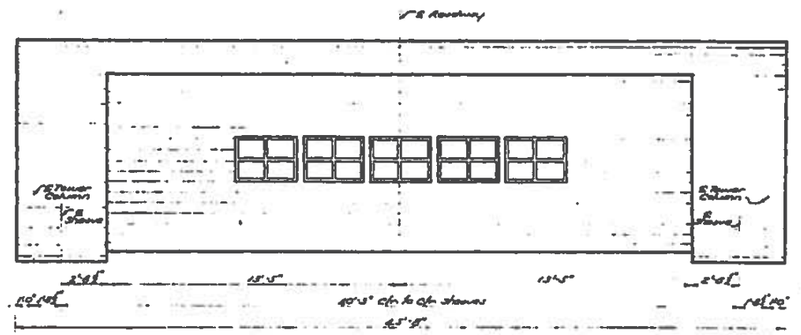

FRONT ELEVATION
SCALE: 1" = 1'-0"

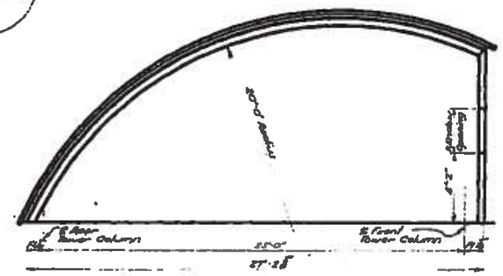

SECTION ALONG ℄ ROADWAY
SCALE: 1" = 1'-0"

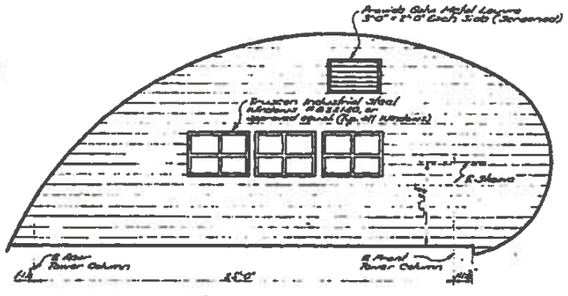

SIDE ELEVATION
SCALE: 1" = 1'-0"

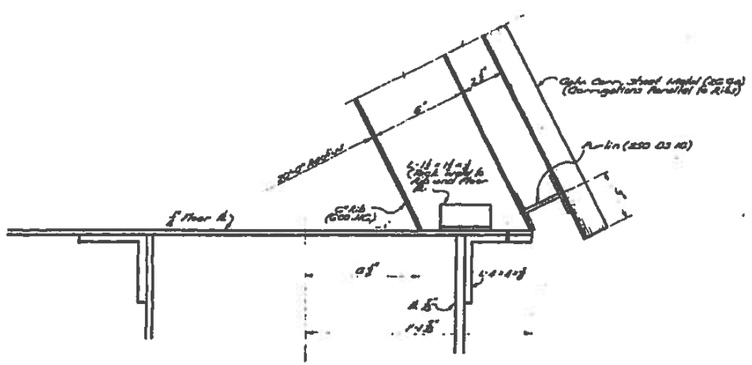

SECTION "E"

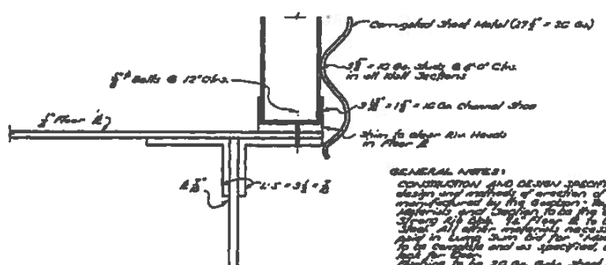

SIDE WALL CONNECTION DETAIL

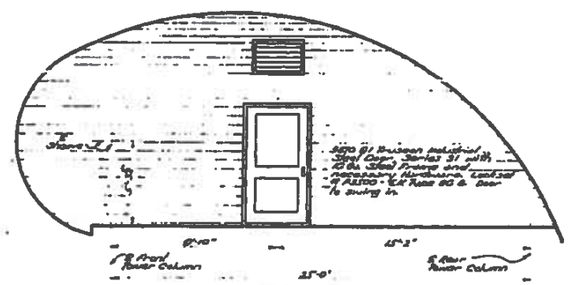

SIDE ELEVATION
SCALE: 1" = 1'-0"

GENERAL NOTES:
CONSTRUCTION AND DESIGN SPECIFICATIONS: According to the latest design and methods of erection of the "40' Steel H15 Bridge", as manufactured by the Gordon-Ryan Steel Co. or an approved equal, differently dated October 15 as the drawing(s), or design "Span H15 40' Steel H15 Bridge, 15' Roadway" to be paid for as "Fabricated Corrugated Steel" which, however, necessarily is to include those and to be used in Lump Sum Bid for "Machinery Houses". Steel and materials to be complete and as specified, or an approved equal. Provide roof for Engine Roofing to be 22 Ga. Galv. Steel metal, roof provided where necessary to make the Engine House weather tight. Doors and windows to be glazed with polished wired glass. Provide necessary bracing in walls and roofs.
Paint: Surfaces to receive two (two) coats of aluminum paint. All finished structural steel to be painted (unless otherwise specified) by the Contractor and not to be required to have any surfaces painting. The Contractor shall be required to furnish also, surfaces painted with colors specified in Specifications "Painting of Metal Surfaces" M-1.4.13, Part I, Div. II, 31st Specs.

MACHINERY HOUSES

STANDARD PLAN
150' VERTICAL LIFT SPAN
LIVE LOAD H20-S16-44
28'-0" ROADWAY 5'-0" SIDEWALKS
45'-0" LIFT OPEN STEEL GRID FLOOR
DATED May 6 1937

STATE OF LOUISIANA
DEPARTMENT OF HIGHWAYS

DESIGNED	DETAILED	TRACED
CHECKED	CHECKED	CHECKED

BRIDGE DESIGN SECTION

DATE	DESCRIPTION	BY
	REVISIONS	

SHEET 11 OF 26

SL50-150-28

DIETZGEN N. O. 120 "IMPERIAL"

126

000930
Sheet 14 of 17

15.0' O/O

34' inside

PLAN
SHOWING HOUSE LOCATION AND STRUCTURAL STEEL LOCATION
SCALE: 1/8"=1'-0"

FLOOR PLAN
SCALE: 1/4"=1'-0"

ROOF PLAN
SCALE: 1/8"=1'-0"

SECTION A-A
SCALE: 1/2"=1'-0"

OPERATING HOUSE

NOTE:
All aluminum surfaces to be placed in contact with or fastened to, steel members shall be thoroughly coated with an approved aluminum impregnated coating compound. All aluminum surfaces to be placed in contact with concrete shall be given a heavy coat of an approved alkali resistant bituminous paint, or a coat of zinc chromate paint and allowed to dry before placing in the concrete.

DOOR AND WINDOW SCHEDULE

MARK	SIZE	TYPE	STYLE	REMARKS
1	3'-6" x 7'-0" x 1 3/4"	Jalousie	41 Glass	Aluminum Frame
2	2'-0" x 6'-8" x 1 3/8"	Flush	Steel	Steel Metal Frame
3	1'-0" x 6'-8" x 1 3/8"	Flush	Steel	Steel Metal Frame
4	3'-6" x 5'-1"	Jalousie	8 Glass	Aluminum Frame 633-15
5	1'-8" x 2'-3"	Jalousie	8 Glass	Aluminum Frame 633-15

FINISH SCHEDULE

ITEM	WALLS		CEILING	FLOOR	BASE	TRIM	ROOF	WAINSCOT
	OUTSIDE	INSIDE						
House	Rubbed	Tile & Plaster	Plaster	Tile	Tile	Metal	Tar & Gravel	48" above Floor
Toilet	-	Tile & Plaster	Plaster	Tile	Tile	Metal	-	48" above Floor
Cabinets	Plaster	3/4 Plywood	Plaster	Tile	-	Metal	-	-

STANDARD PLAN
150' VERTICAL LIFT SPAN
LIVE LOAD H20-S16-44
28'-0" ROADWAY 5'-0" SIDEWALKS
45'-0" LIFT OPEN STEEL GRID FLOOR
DATED May 13 1927

STATE OF LOUISIANA
DEPARTMENT OF HIGHWAYS
DESIGNED [illegible] DRAWN [illegible] TRACED AS NOTED
CHECKED [illegible] CHECKED [illegible]
BRIDGE DESIGN SECTION

SHEET 12 OF 26

SL50-150-28

127

000930
Sheet 15 of 17

FRONT ELEVATION

SIDE ELEVATION

REAR ELEVATION

SIDE ELEVATION

HALF FRONT ELEVATION
SHOWING REINFORCING

HALF REAR ELEVATION
SHOWING REINFORCING

SECTION B-B

ANCHOR DETAILS FOR EXTERIOR BEAMS

OPERATING HOUSE

STANDARD PLAN
150' VERTICAL LIFT SPAN
LIVE LOAD H20-S16-44
26'-0" ROADWAY 5'-0" SIDEWALKS
46'-0" LIFT OPEN STEEL GRID FLOOR
DATED May 13, 1937

STATE OF LOUISIANA
DEPARTMENT OF HIGHWAYS
DESIGNED Nelson DETAILED Nelson TRACED G. Archer
CHECKED CHECKED E.D.Law CHECKED E.D.Law
BRIDGE DESIGN SECTION

DATE DESCRIPTION BY
REVISIONS

SHEET 13 OF 26

SL50-150-28

130

000930
Sheet 16 of 17

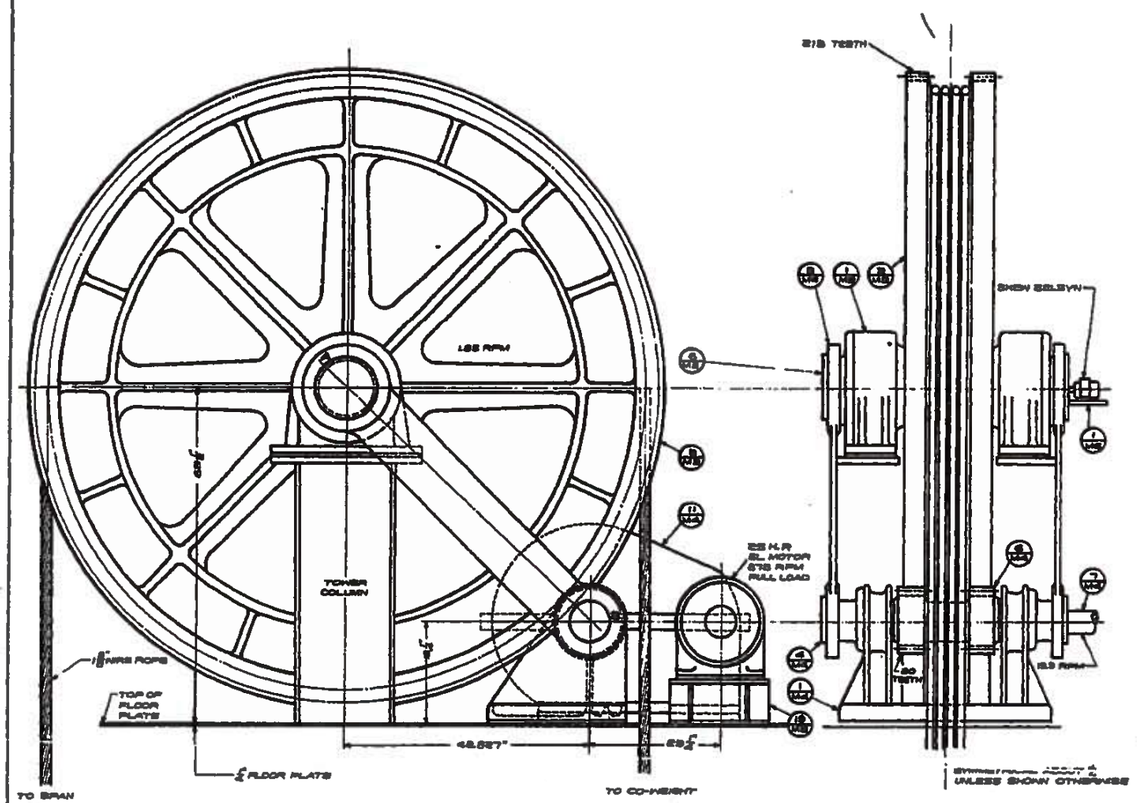

GENERAL ARRANGEMENT OF BRIDGE MACHINERY
ON DWG. # M1

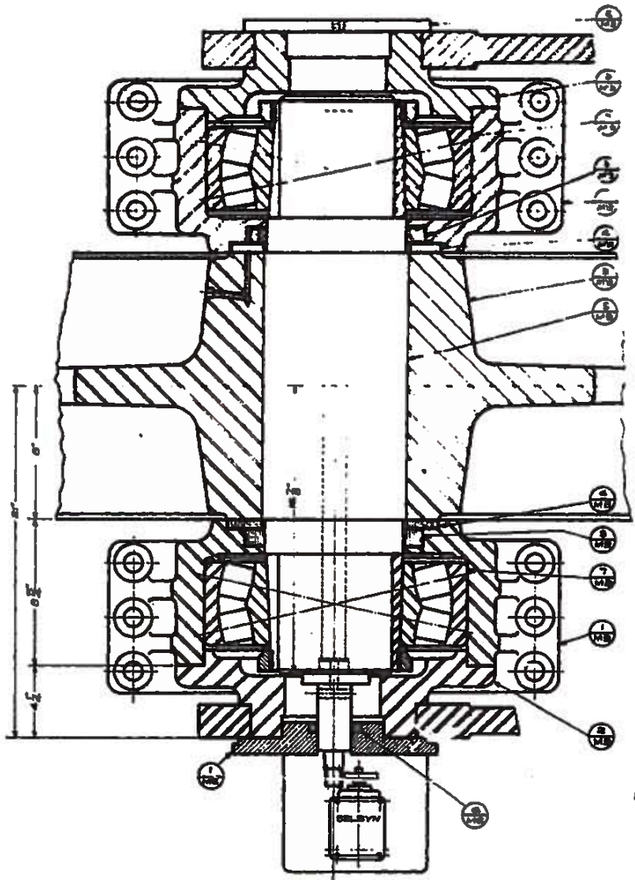

SELSYN MOUNTING AND GEARS ON DWG. M6

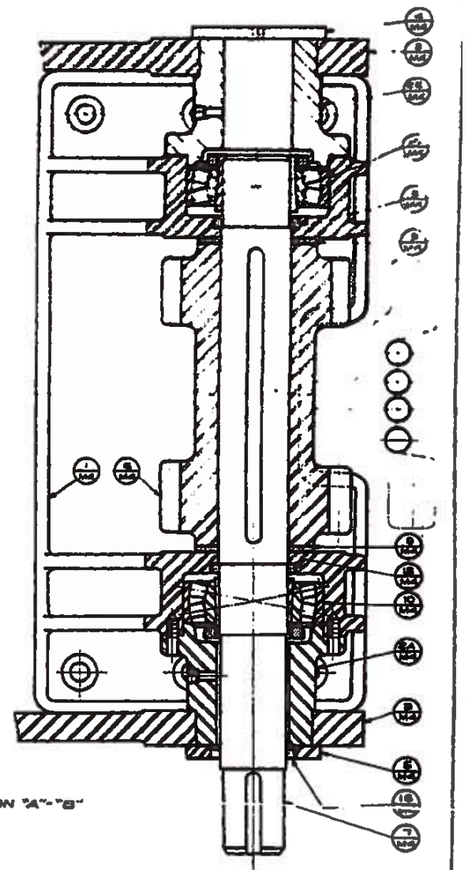

SECTION "A"-"B"

NOTE:
FOR REMOVING PINION SHAFT (7) REMOVE CAPS, BEARINGS AND GREASE SEALS FROM BOTH ENDS OF THE ASSEMBLY.
ROTATE THE PINION SPACER (6) TO ALIGN THE COUPLING END OF THE SHAFT UNTIL ITS KEY SLOT IS IN LINE WITH THE KEY SLOT IN THE BORE OF THE HOUSING (1).
ROTATE THE SHAFT UNTIL THE KEYS ARE STRAIGHT DOWN. LIFT IT UPWARD AGAINST THE TOP OF THE BORE AND PRESS IT OUT IN THE DIRECTION OF THE COUPLING END.

NOTE:
THE CONTRACTOR SHALL DETERMINE THE FINAL DIMENSIONS OF PARTS INVOLVING COMMERCIAL PRODUCTS SUCH AS MOTORS, SPEED REDUCERS, BEARINGS, ELECTRICAL EQUIPMENT AND THE LIKE, FROM CERTIFIED DIMENSIONS OUTLINES OF THE COMMERCIAL PRODUCTS BEFORE MAKING SHOP DRAWINGS OF THE PARTS INVOLVED.
UNLESS OTHERWISE SHOWN ON DETAIL DRAWING LUBRICANT SHALL BE AS FOLLOWS OR APPROVED EQUAL:
PILLOW BLOCKS, COUPLINGS & TRUNION BEARINGS- ESSO FIBRE GREASE "C"
EXPOSED TEETH- MEDIUM HARD GREASE.
ENCLOSED SPEED REDUCERS- STD. OIL "TERESSO 65" VISC SAE 90.
WIRE ROPE- STD. OIL CO. SURRETTE COMPOUND N° 1500.
ALL UNFINISHED SURFACES OF MACHINERY SHALL BE PAINTED ONE SHOP COAT OF RED LEAD AND OIL.
ALL FINISHED SURFACES SHALL BE COATED WITH WHITE LEAD AND TALLOW BEFORE SHIPMENT AND SHALL BE PROTECTED BY WOODEN LAGGING.

ASSEMBLY OF GEAR TRAIN FOR SHEAVE DRIVE

M 2

STANDARD PLAN
150' VERTICAL LIFT SPAN
LIVE LOAD H20-S16-44
28'-0" ROADWAY 5'-0" SIDEWALKS
45'-0" LIFT OPEN STEEL GRID FLOOR
DATED FEB. 22 1957

STATE OF LOUISIANA
DEPARTMENT OF HIGHWAYS
DESIGNED Kuzel DETAILED Kuzel TRACED O. Chatman
CHECKED Brewer CHECKED Brewer CHECKED Brewer
BRIDGE DESIGN SECTION

DATE	DESCRIPTION	BY
4-8-58	REVISED PART OF (7) (8) (9) (10)	A.B.K.

REVISIONS

SHEET 16 OF 28

SL50-150-28

139

000930
Sheet 17 of 17

BRIDGE PROJECT	PARISH	SHEET NO.
66-02 V3	Lafourche	48

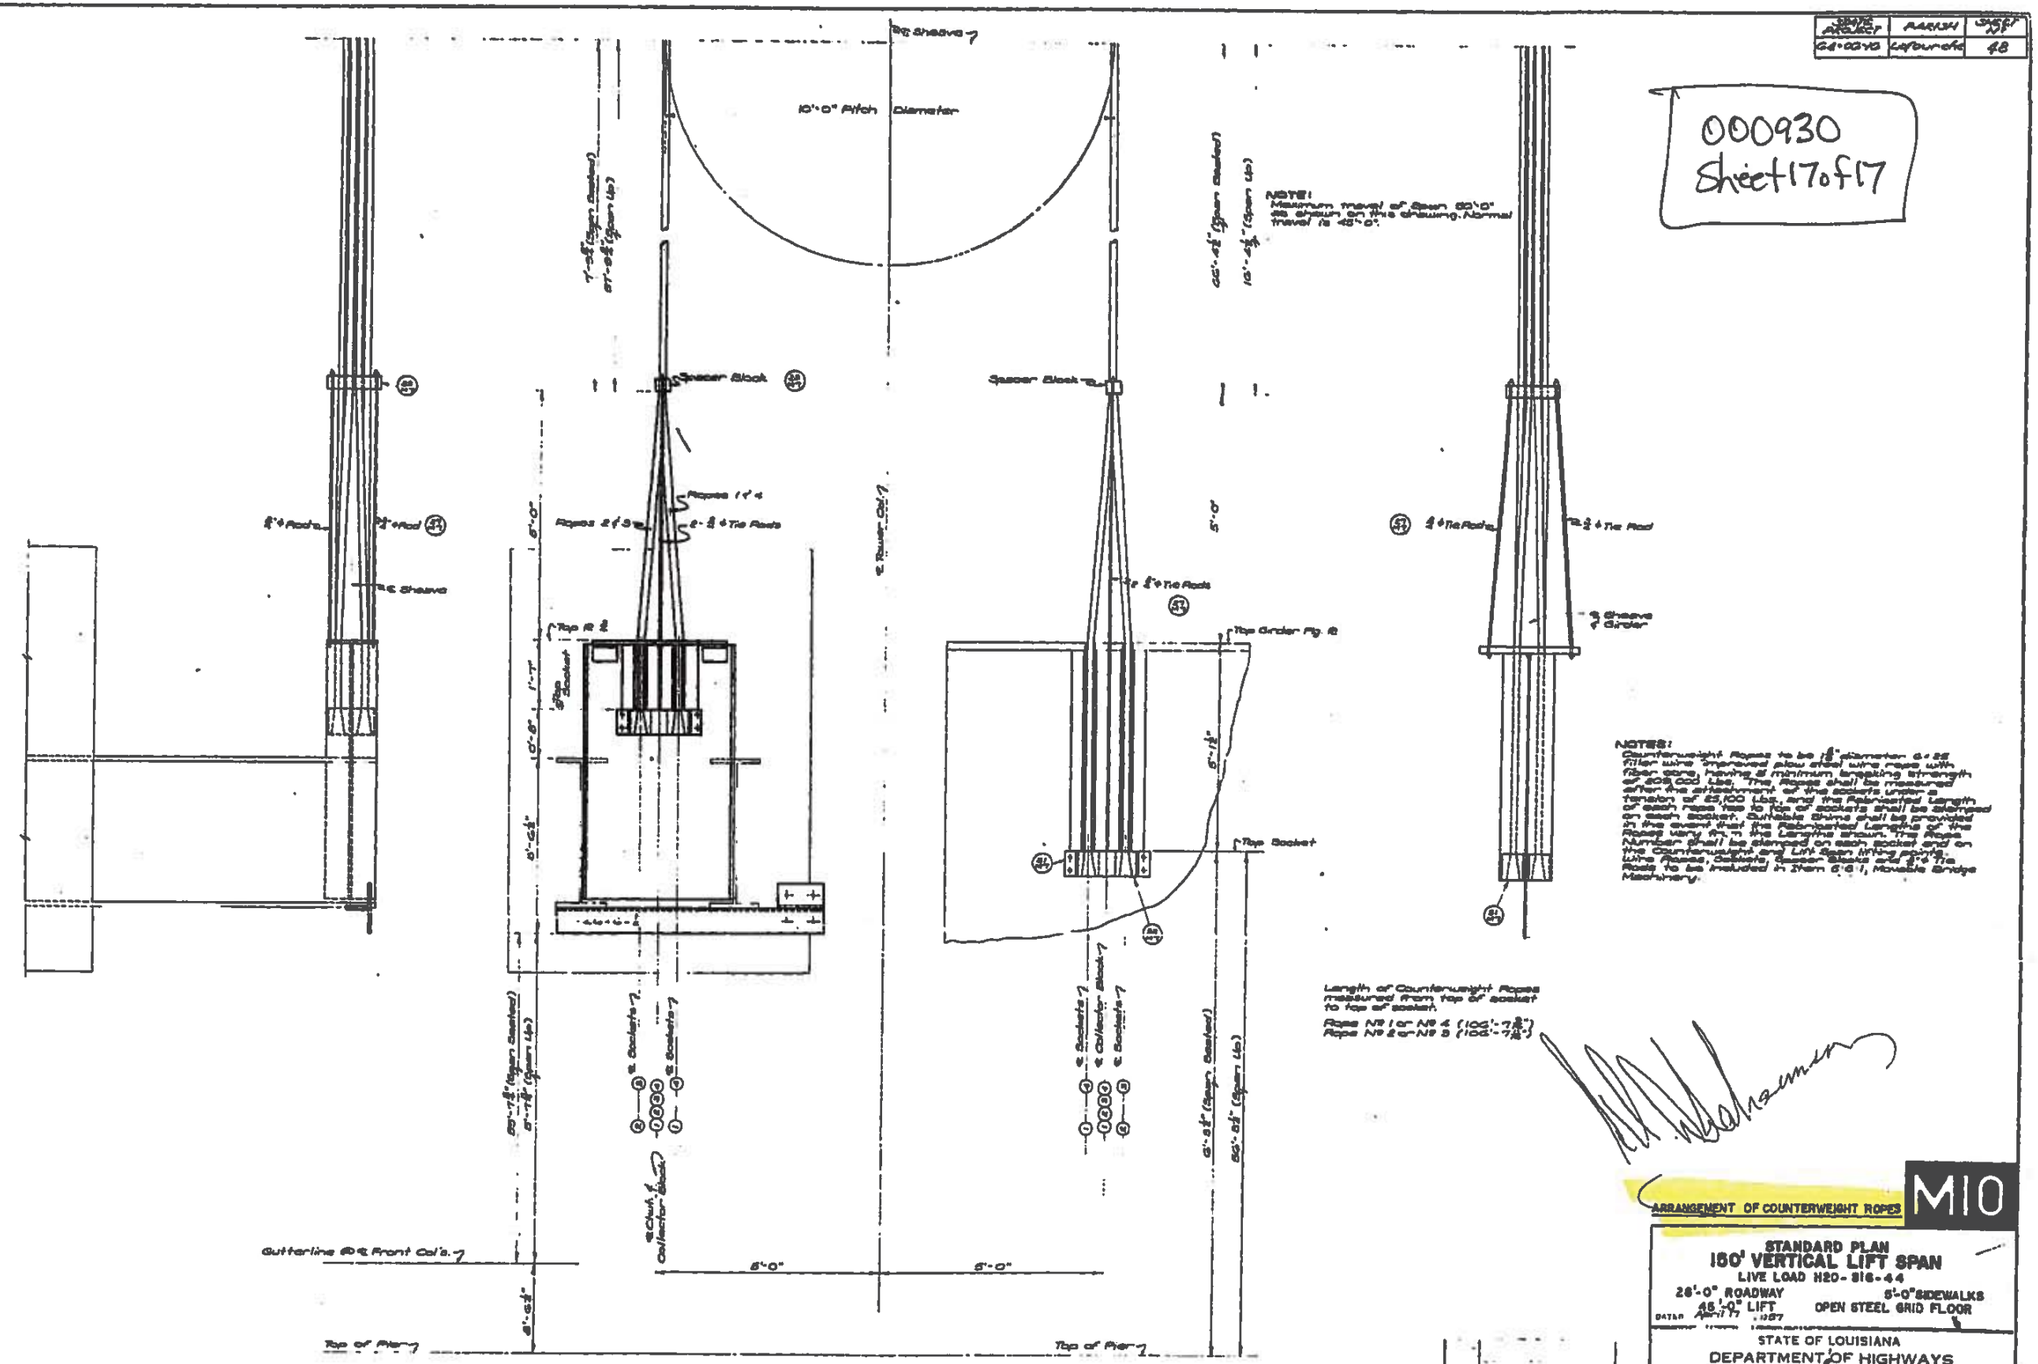

NOTE:
Maximum travel of Span 65'-0" as shown on this drawing. Normal travel is 45'-0".

NOTES:
Counterweight Ropes to be 1 1/4" diameter 6 x 25 Filler wire improved plow steel wire rope with fiber core, having a minimum breaking strength of 209,000 lbs. The Ropes shall be measured after the application of the specified load in tension of 83,100 Lbs. and the Reinforced Length of each Rope from to top of sockets shall be stamped on each Socket. Suitable shims shall be provided in the event that the Reinforced Lengths of the Ropes vary from the Lengths shown. The Ropes Number shall be stamped on each Socket and on the Counterweight and Lift Span lifting points. Tie Rods, Sockets, Spacer Blocks and Pin for Rods to be included in Item 6(a) 1, Movable Bridge Machinery.

ARRANGEMENT OF COUNTERWEIGHT ROPES

M10

STANDARD PLAN
150' VERTICAL LIFT SPAN
LIVE LOAD H20-S16-44
26'-0" ROADWAY 5'-0" SIDEWALKS
DATUM 45'-0" LIFT OPEN STEEL GRID FLOOR
April 17, 1927

STATE OF LOUISIANA
DEPARTMENT OF HIGHWAYS

DESIGNED	DETAILED	TRACED
CHECKED S.L.R.	CHECKED S.L.R.	CHECKED S.L.R.

BRIDGE DESIGN SECTION

DATE	DESCRIPTION	BY
	REVISIONS	

SHEET 24 OF 28

SL50-150-28

137


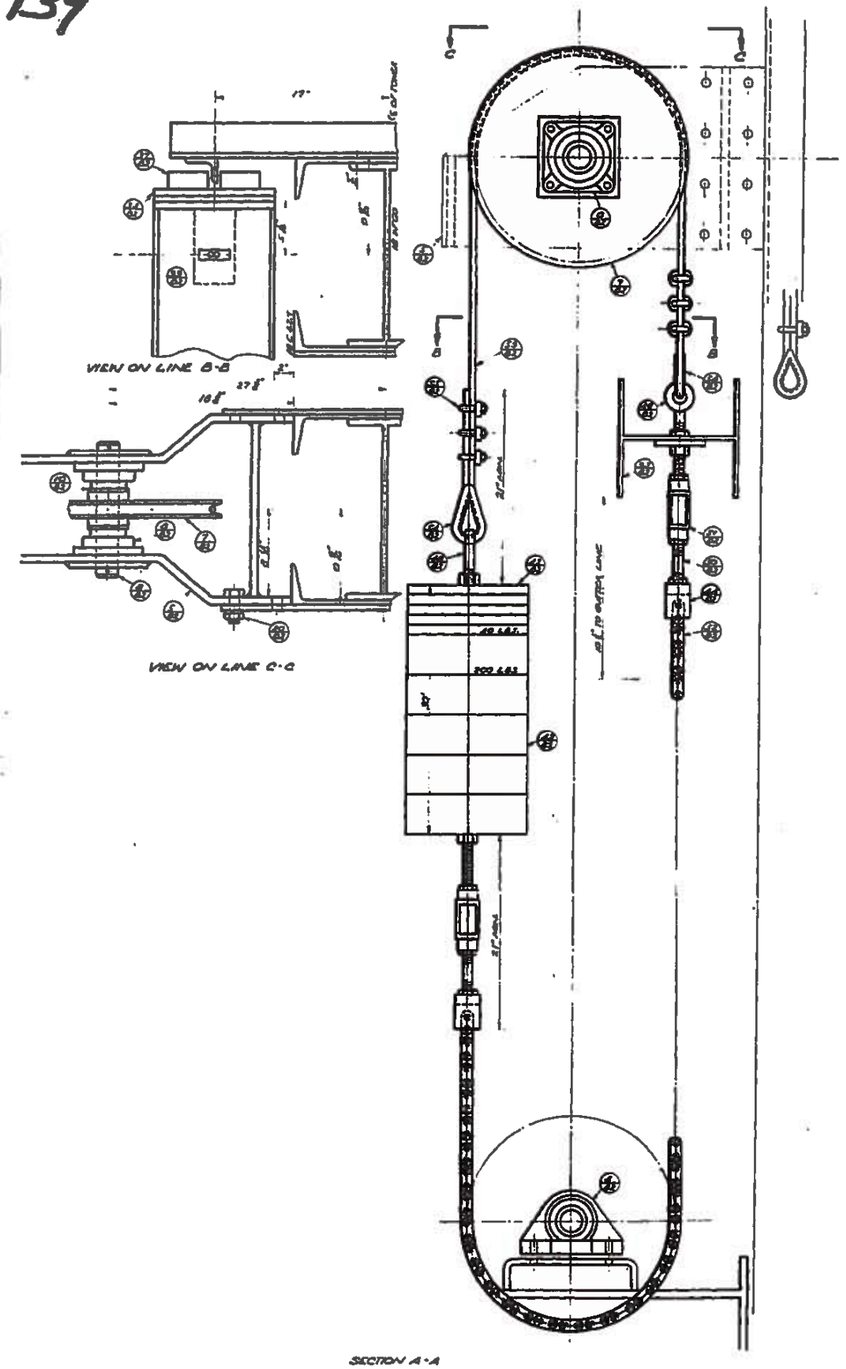

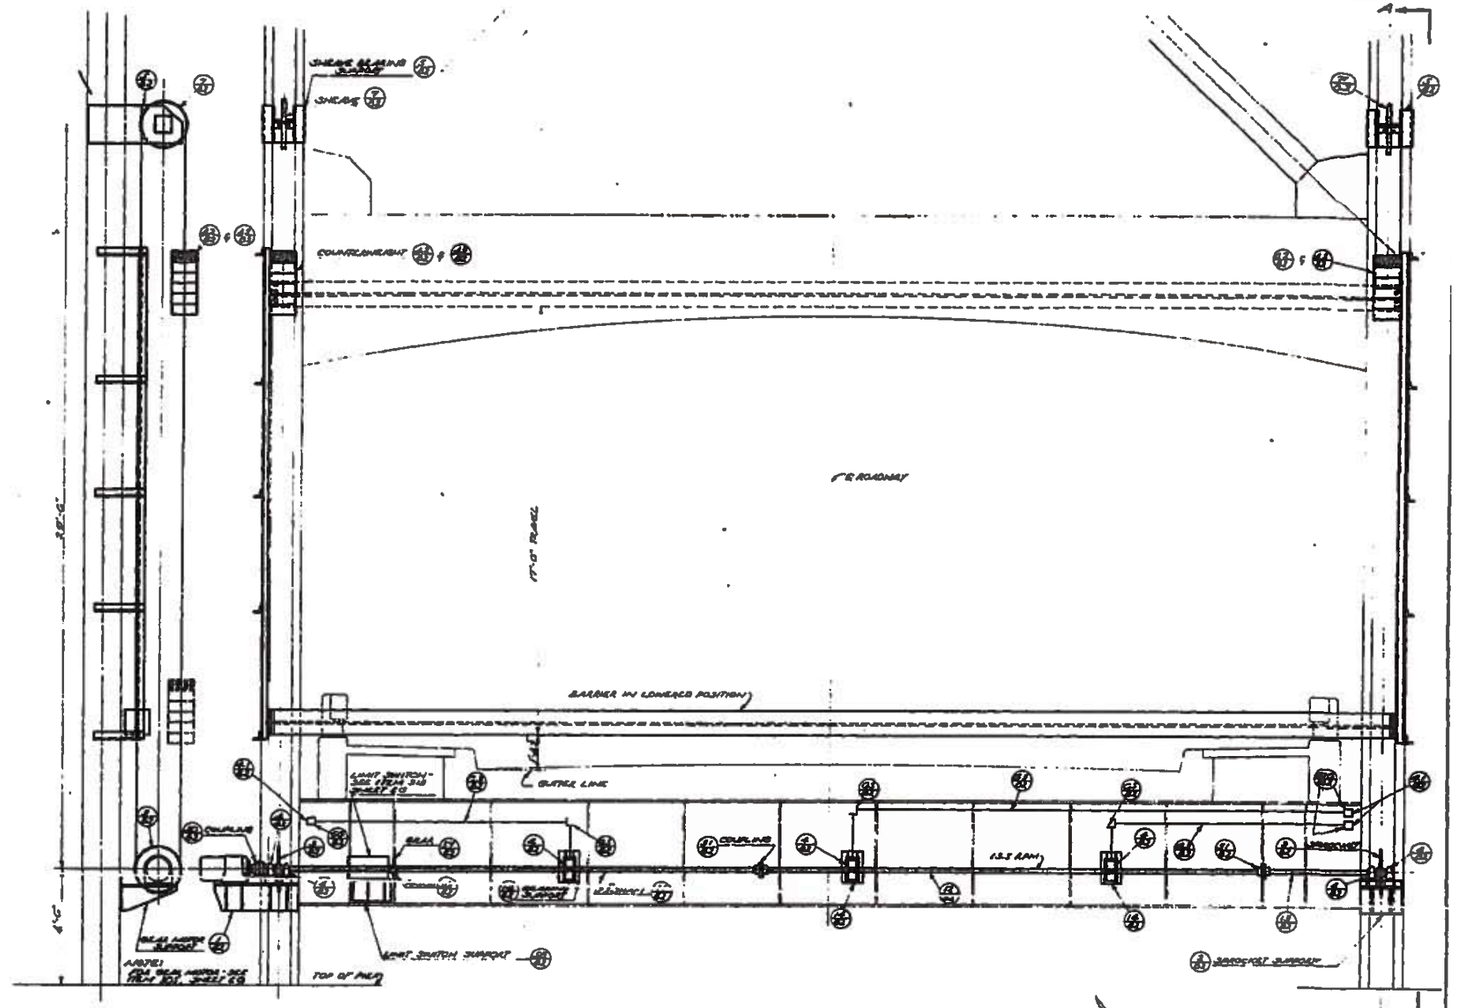

PART SIDE ELEVATION OF TOWER SHOWING BARRIER

PART REAR ELEVATION OF TOWER SHOWING BARRIER OPERATING MACHINERY

THICKNESS / BAR REINFORCING SPACING	6"	8"	9"
	4	3	4

NOTE:
THE CONTRACTOR SHALL DETERMINE THE FINAL DIMENSIONS OF PARTS INVOLVING COMMERCIAL ARTICLES SUCH AS MOTORS, SPEED REDUCERS, BEARINGS, ELECTRICAL EQUIPMENT AND THE LIKE, FROM CERTIFIED DIMENSIONAL OUTLINES OF THE COMMERCIAL PRODUCTS BEFORE MAKING SHOP DRAWINGS OF THE PARTS INVOLVED.

PAINTING NOTE:
ALL UNFINISHED SURFACES OF MACHINERY SHALL BE PAINTED ONE SHOP COAT OF RED LEAD AND OIL. ALL FINISHED SURFACES SHALL BE COATED WITH WHITE LEAD AND TALLOW BEFORE SHIPMENT AND SHALL BE PROTECTED BY WOODEN CASINGS.

LUBRICATION NOTE:
UNLESS OTHERWISE SHOWN ON DETAIL DRAWINGS, LUBRICANT SHALL BE AS FOLLOWS OR APPROVED EQUAL:
PILLOW BLOCKS, COUPLINGS, & BUSHING BEARINGS - 6330 FIBER GREASE "C".
ENCLOSED TEETH - MEDIUM MAG GREASE.
ENCLOSED SPEED REDUCERS - STD. OIL "TEXACO 85" VISC. SAE 30.
WIRE ROPE - STD. OIL CO. GARRETTE COMPOUND N°1508.

GENERAL ARRANGEMENT OF TRAFFIC BARRIER

B1

STANDARD PLAN
150' VERTICAL LIFT SPAN
LIVE LOAD H20-S16-44
28'-0" ROADWAY 5'-0" SIDEWALKS
46'-0" LIFT OPEN STEEL GRID FLOOR
DATED MAY 1 1957

STATE OF LOUISIANA
DEPARTMENT OF HIGHWAYS

DESIGNED Kessel	DETAILED Brewer	TRACED M. Mouchet
CHECKED Brewer	CHECKED Kessel	CHECKED Brewer

BRIDGE DESIGN SECTION

DATE	DESCRIPTION	BY

REVISIONS

SHEET 25 OF 26

SL50-150-28

DIETZGEN N. O. 139 "IMPERIAL"